

CONSTRUCTION REPORT - CERTIFICATION YEAR

Wisconsin Department of Transportation

DT-102 (4) (Replaces DP-10) s M 302 Wis Stat.

See definitions below and instructions on back.

County: **Grant** Town, City, Village: **Hazel Green** Date: **10-1-97** Sheet: **1** of **2**

ROADS-NEW, RESURFACED AND RECONSTRUCTED

TOWN ROAD NAME & NUMBER OR ST. STREET NAME	LOCATION (From - To, Grid, Sect., Etc.)	LENGTH (M. FL.)	A TRAVEL LANES	SURFACE		CONST. YEAR	RIGHT OF WAY	D PARK PERMIT	E CURBS	SHOULDERS				REMARKS	MANT. SEAL COAT, CRACK FILLING, ETC.
				B TYPE	C Width					F Type	G L Width	F R Type	G R Width		
Example: Lien Road 14-1	E Washington Ave to Droster	1.4 mi	2	2	24'	'94	66'	3	0	3	10'	3	10'	Resurfaced - 2" Bil. Mat	H (See Below)
West 21st St	Hwy 80 to Oak St	1129'	2	2	28'	'97	40'	3	3	0				Reconstructed 3" Bit Mat	
15th St	Main east to Birch	758'	2	2	28'	'97	40'	3	3	0				Reconstructed 3" Bit Mat	
16th St	Main east to Birch	719'	2	2	28'	'97	40'	3	3	0				Reconstructed 3" Bit Mat	
17th St	Main east to Birch	779'	2	2	28'	'97	40'	3	3	0				Reconstructed 3" Bit Mat	
18th St	Main east to Scramble Creek Drive	1066'	2	2	28'	'97	40'	3	3	0				Reconstructed 3" Bit Mat	
19th St	Main east to Birch	607'	2	2	28'	'97	40'	3	3	0				Reconstructed 3" Bit Mat	
Birch St	19th St south to 14th	1156'	2	2	22'	'97	30'	0	3	0				Reconstructed 3" Bit Mat	
Church St	19th south to 17th	426'	2	2	16'	'97	16'	0	3	0				Reconstructed 3" Bit Mat	
Lilac St	19th south to 17th	346'	2	2	16'	'97	16'	0	3	0				Reconstructed 3" Bit Mat	
Evergreen St	16th south to 15th	360'	2	2	20'	'97	40'	0	3	0				Reconstructed 3" Bit Mat	
22nd St	Hwy 80 east to Main End of	245'	2	2	28'	'96	40'	3	3	0				Reconstructed 3" Bit Mat	

BRIDGES (OVER 20 CLEAR SPAN) - NEW OR RECONSTRUCTED

TOWN ROAD NAME & NUMBER OR ST. STREET NAME	LOCATION SECTION - TOWN - RANGE	LENGTH BETWEEN ABUT. (Clear Span)	ROADWAY WIDTH (Between Curbs/Railings)	BRIDGE NUMBER		REMARKS
				OLD	NEW	

DEFINITIONS AND CODES

A. Travel Lanes: Exclude parking lanes.

C. Surface Width: Curb to curb OR inside edge of shoulder to inside edge of shoulder.

E. Curbs
0 = None
1 = Right Side
2 = Left Side
3 = Both Sides

G. Shoulder Width: If no shoulders exist and curbs are present, enter that in the curb column - see E.

B. Surface Types by number

- (1) Portland Cement Concrete
- (2) High Type Bituminous (Plant Mix)
- (3) Low Type Bituminous (Road Mix)
- (4) Graveled Surface
- (5) Grated and Drained
- (6) Unimproved

D. Parking Permitted

- 0 = None
- 1 = Right Side
- 2 = Left Side
- 3 = Both Sides
- 4 = Rural

F. Shoulder Types
0 = None
1 = Grass
2 = Gravel
3 = Paved

H. Maintenance: Report this if you wish, but it is not required.

CONSTRUCTION REPORT - CERTIFICATION YEAR

Wisconsin Department of Transportation

DT-1022 (15) (Replaces PP-119) s 88 302 Wis Stats.

See definitions below and instructions on back.

County: Grant Town, City, Village: Hazel Green Date: 10-1-97 Sheet: 2 of 2

ROADS-NEW, RESURFACED AND RECONSTRUCTED

TOWN, ROAD NAME & NUMBER OR ST. STREET NAME	LOCATION (From - To, Grid, Sect., Etc.)	LENGTH (M. FT.)	A TRAVEL LANES	SURFACE		CONST YEAR	RIGHT OF WAY	D PARK PERMIT	E CURBS	SHOULDERS				REMARKS	MAINT. SEAL COAT CRACK FILLING, ETC.
				B Type	C Width					F Type	G L Width	F Type	G R Width		
Example: Lien Road 14-1	E Washington Ave to Droster to end of	1.4 mi	2	2	24'	'94	66'	3	0	3	10'	3	10'	Resurfaced - 2" Bit. Mat	H (See Below)
23rd St	Hwy 80 east Main	175'	2	2	27'	'96	40'	3	3	0				Reconstructed 3" Bit Mat	
Church St.	City W north to 21 th	160'	2	2	35'	'96	40'	3	3	0				Reconstructed 3" Bit Mat	
Church St.	21st St North to 24 th	630'	2	2	29'	'96	40'	3	3	0				Reconstructed 3" Bit Mat	
22nd St.	Main to Church	223'	2	2	28'	'96	40'	3	3	0				Reconstructed 3" Bit Mat	
22nd St.	Church to east end	220'	2	2	26'	'96	40'	3	3	0				Reconstructed 3" Bit Mat	
23rd St.	Main to Church	225'	2	2	26'	'96	40'	3	3	0				Reconstructed 3" Bit Mat	
23rd St.	Church to east end	225'	2	2	24'	'96	40'	3	3	0				Reconstructed 3" Bit Mat	
Hwy 80 Percival St.	North Village Limits to South Lim. + 5	1.4 mi	2	2	36'	'97			3	0				Reconstructed 5 1/2" Bit Mat	
Hwy 11 Fairplay St	Hwy 80 west	1/2 mi	2	2	40'	'97			3	3	0			Reconstructed	

BRIDGES (OVER 20' CLEAR SPAN) - NEW OR RECONSTRUCTED

TOWN, ROAD NAME & NUMBER OR ST. STREET NAME	LOCATION SECTION - TOWN - RANGE	LENGTH BETWEEN ABUT. (Clear Span)	ROADWAY WIDTH (Between Curbs/Railings)	BRIDGE NUMBER		REMARKS
				OLD	NEW	

DEFINITIONS AND CODES

- A. Travel Lanes: Exclude parking lanes.
- B. Surface Types by number
 - (1) Portland Cement Concrete
 - (2) High Type Bituminous (Plant Mix)
 - (3) Low Type Bituminous (Road Mix)
 - (4) Graveled Surface
 - (5) Graded and Drained
 - (6) Unimproved
- C. Surface Width: Curb to curb OR inside edge of shoulder to inside edge of shoulder.
- D. Parking Permitted
 - 0 = None
 - 1 = Right Side
 - 2 = Left Side
 - 3 = Both Sides
 - 4 = Rural
- E. Curbs
 - 0 = None
 - 1 = Right Side
 - 2 = Left Side
 - 3 = Both Sides
- F. Shoulder Types
 - 0 = None
 - 1 = Grass
 - 2 = Gravel
 - 3 = Paved
- G. Shoulder Width: If no shoulders exist and curbs are present, enter that in the curb column - see E.
- H. Maintenance: Report this if you wish, but it is not required.

GRANT

VILLAGE OF
HAZEL GREEN
 TOWN: HAZEL GREEN & BENTON
 COUNTY: GRANT & LAFAYETTE
 (22-136 - GRANT)
 (33-136 - LA.)

DATE	MILEAGE FOR LOCAL ROADS/STREETS	LOCAL ROADS/STREETS Certified in accordance with sec. 86.30 Wis. stat.
1) 4-1-96	6.00	Signature: <i>Carol Stagnan</i> Date: <i>9-11-97</i> Title: <i>Clerk-Treasurer</i>
2) 1-1-98	.	
3) 4-1-98	.	

- 1) THIS DATA REPRESENT THE LAST CERTIFIED MILEAGE AS CORRECTED BY THE DISTRICT WHICH MAY HAVE BEEN USED FOR PAST TRANSPORTATION AIDS.
- 2) THE TOWN CHAIRMAN OR CITY/VILLAGE CLERK IS TO FILL IN THE MILEAGE TO BE CERTIFIED AS OPEN TO THE PUBLIC AS OF THE FOLLOWING JANUARY, INCLUDING THE NEW CHANGES THAT ARE MADE ON THE PLAT.
- 3) THIS DATA REPRESENTS MILEAGE ADJUSTMENTS MADE BY THE D.O.T. DISTRICT DUE TO FIELD VERIFICATION, INVENTORY, ANNEXATION, ETC. TRANSPORTATION AIDS PAYMENTS MAY BE MADE BASED ON THIS FIGURE.

Legend

Railroad	++++
Bridge	—/—
School	■
Cemetery	+
City, Village Town Hall	▲
Airport	✈
Unincorporated	○

LEGEND							
STATE TRUNKS	CONN. HIGHWAY	COUNTY TRUNKS	LOCAL ROAD/STREETS	RUSTIC ROAD	Non-pay ROAD/STREETS	CORPORATE LIMITS	COUNTY BOUNDARY
—+—+—+—	—●—●—	—+—+—	==	—Y—	—+—+—	—+—+—	— · — · —

Year of last complete inventory - 1987
 The last assigned road number is 00133


LAFAYETTE

DATE	MILEAGE FOR LOCAL ROADS/STREETS	LOCAL ROADS/STREETS Certified in accordance with sec. 86.30 Wis. stat.
(1) 4-1-96	0.03	Signature: <i>Carol Stagnan</i> Date: <i>9-11-97</i> Title: <i>Clerk-Treasurer</i>
(2) 1-1-98	.	
(3) 4-1-98	.	


- (1) THIS DATA REPRESENT THE LAST CERTIFIED MILEAGE AS CORRECTED BY THE DISTRICT WHICH MAY HAVE BEEN USED FOR PAST TRANSPORTATION AIDS.
- (2) THE TOWN CHAIRMAN OR CITY/VILLAGE CLERK IS TO FILL IN THE MILEAGE TO BE CERTIFIED AS OPEN TO THE PUBLIC AS OF THE FOLLOWING JANUARY, INCLUDING THE NEW CHANGES THAT ARE MADE ON THE PLAT.
- (3) THIS DATA REPRESENTS MILEAGE ADJUSTMENTS MADE BY THE D.O.T. DISTRICT DUE TO FIELD VERIFICATION, INVENTORY, ANNEXATION, ETC. TRANSPORTATION AIDS PAYMENTS MAY BE MADE BASED ON THIS FIGURE.

LEGEND							
STATE TRUNKS	CONN. HIGHWAY	COUNTY TRUNKS	LOCAL ROAD/STREETS	RUSTIC ROAD	Non-pay ROAD/STREETS	CORPORATE LIMITS	COUNTY BOUNDARY
—+—+—+—	—●—●—	—+—+—	==	—Y—	—+—+—	—+—+—	— · — · —

Year of last complete inventory - 1986
 The last assigned road number is 00100

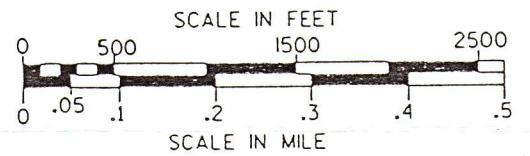

SEND TO COUNTY CLERK

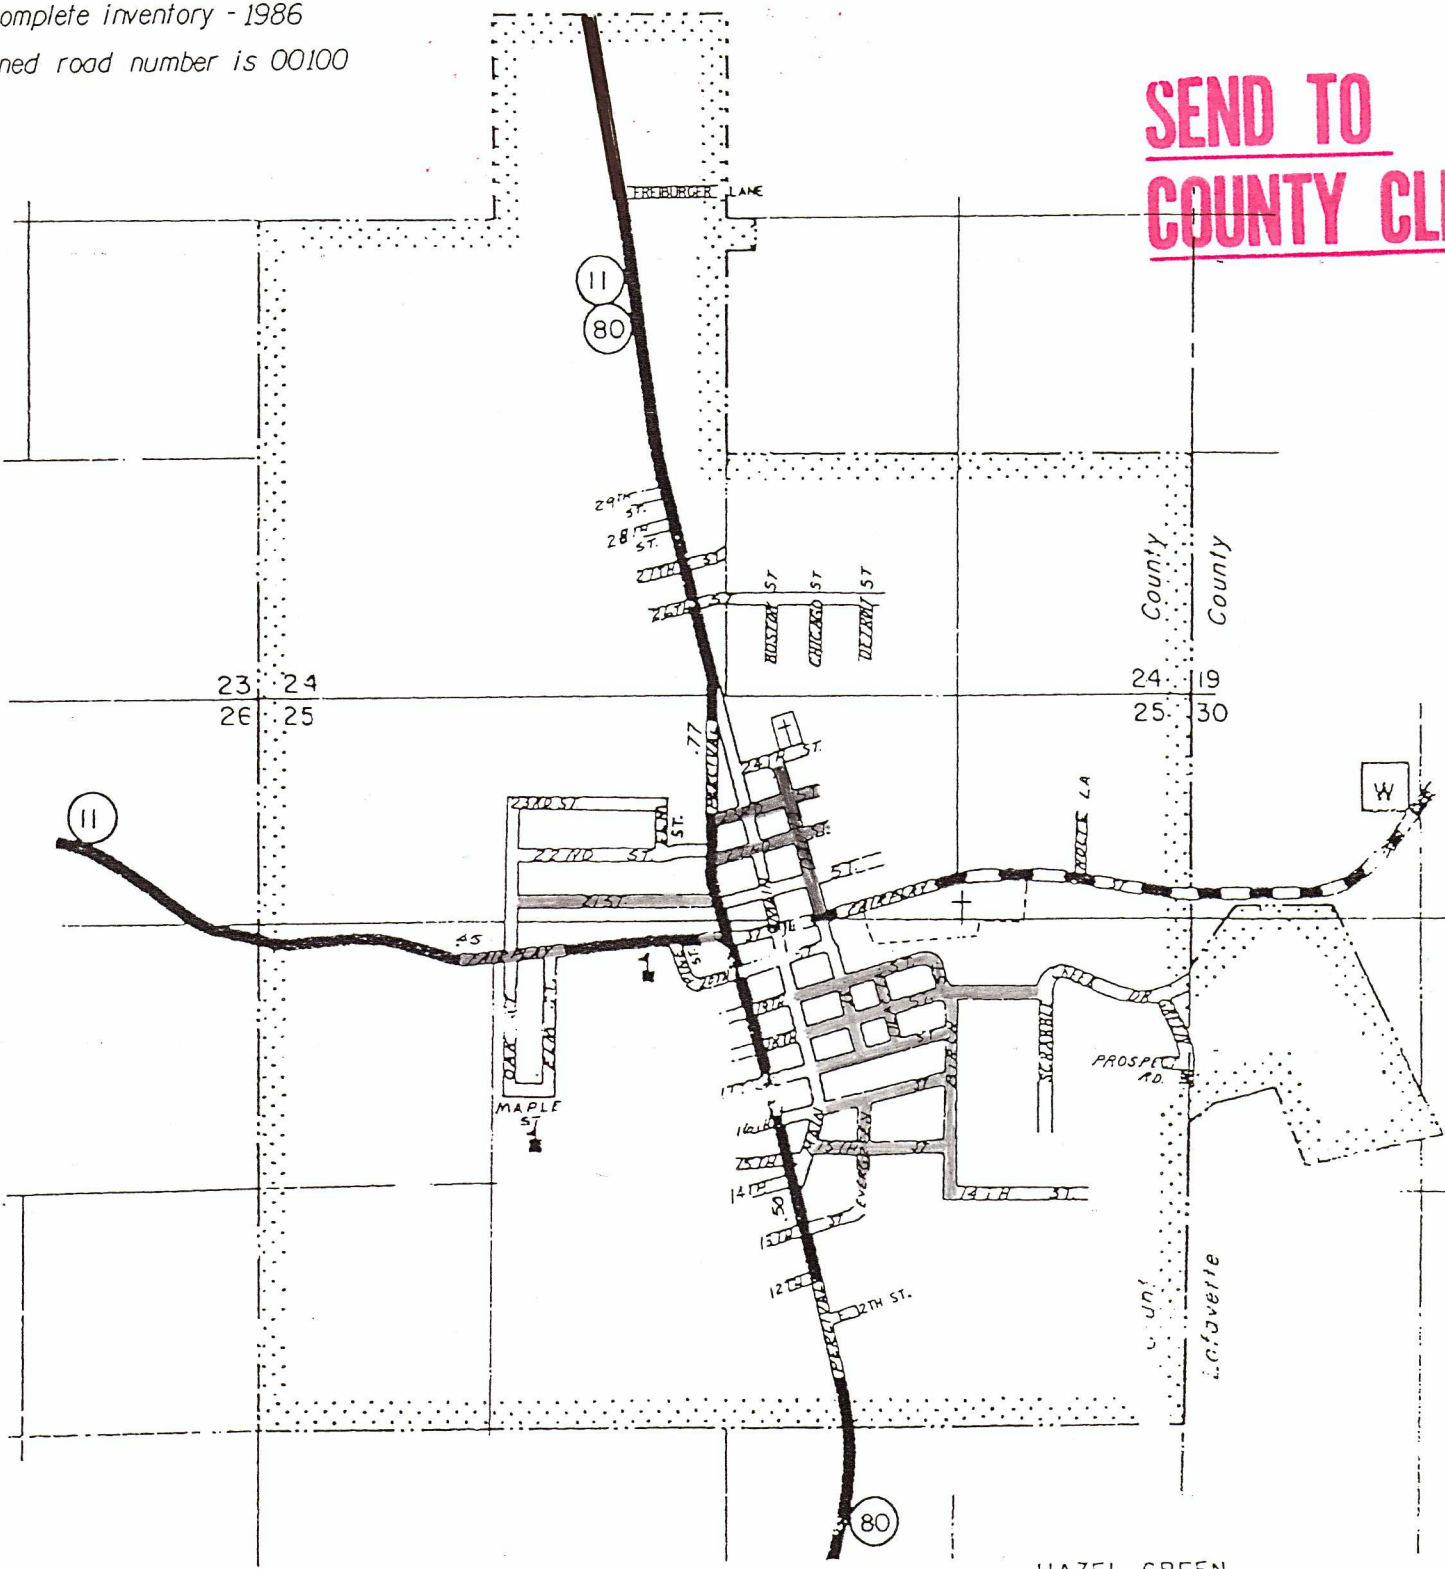

HAZEL GREEN