
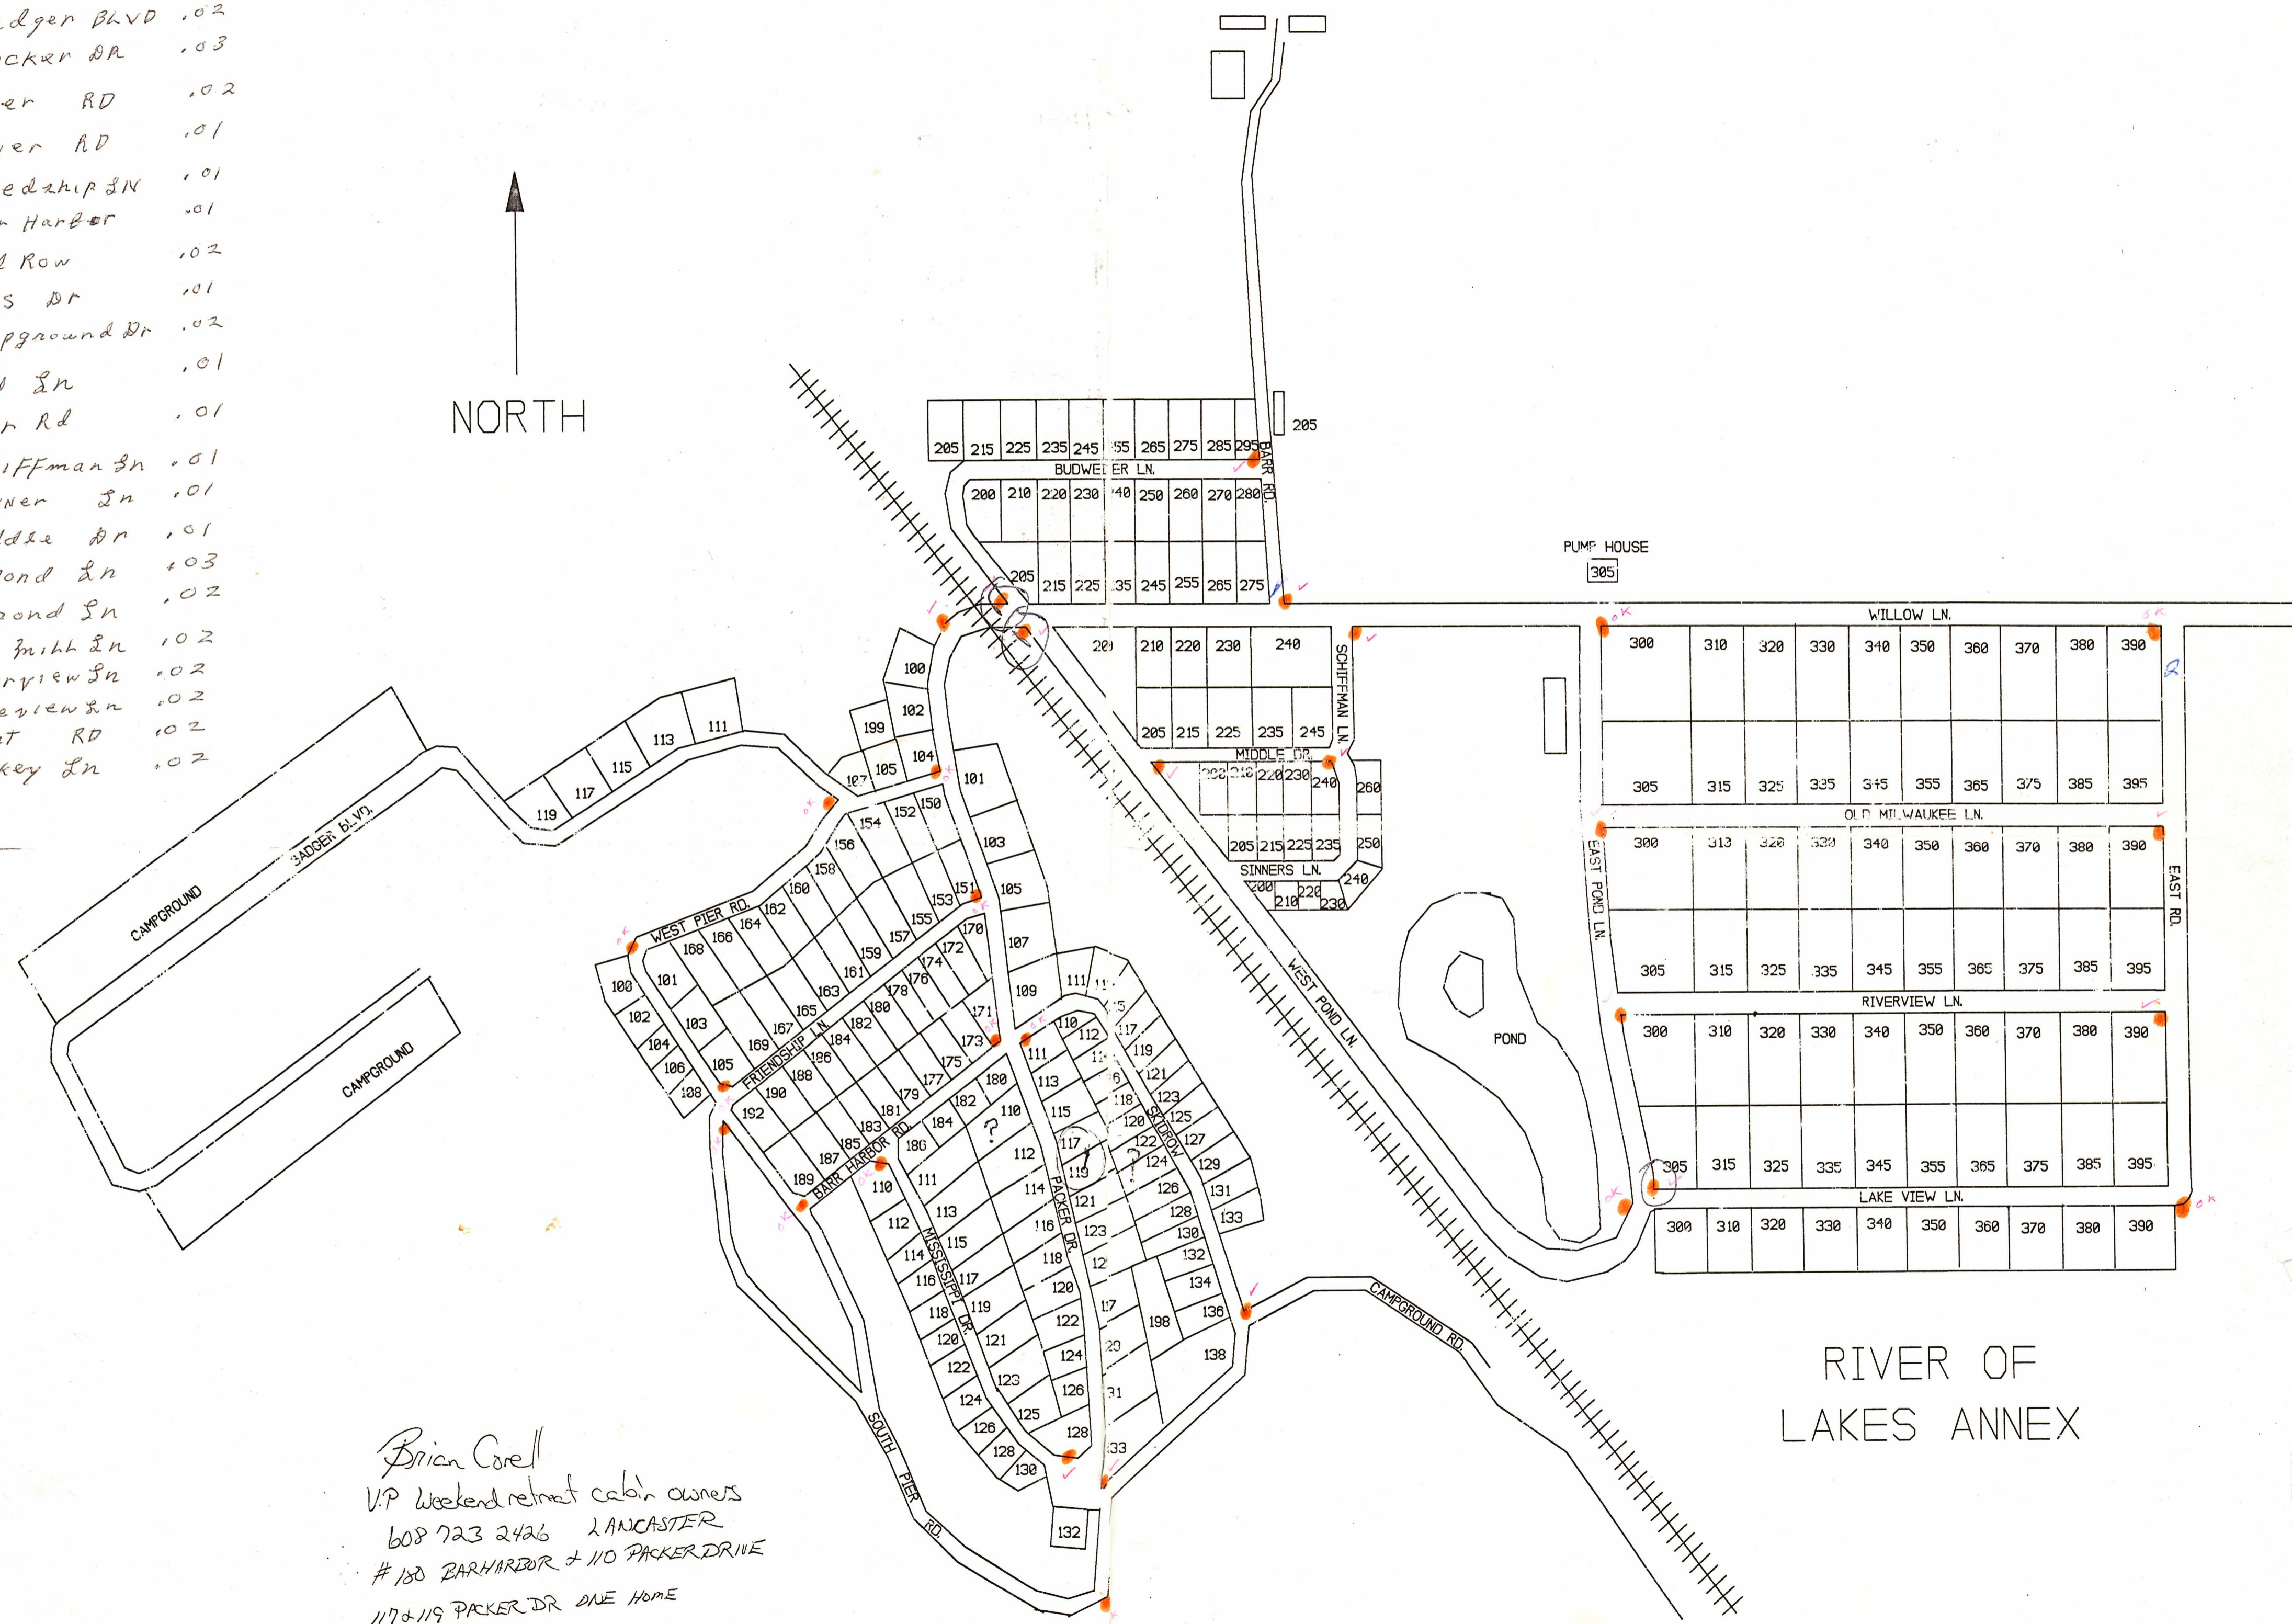


all of Streets below are new streets in Bagley  
will be blacktoped 1995

- Badger Blvd .02
- Packer Dr .03
- S-pier Rd .02
- W-pier Rd .01
- Friendship Ln .01
- Barr Harbor .01
- Skid Row .02
- Miss Dr .01
- Campground Dr .02
- Bud Ln .01
- Barr Rd .01
- Schiffman Ln .01
- Sinner Ln .01
- Middle Dr .01
- W-pond Ln .03
- E-pond Ln .02
- Old Mill Ln .02
- Riverview Ln .02
- Lakeview Ln .02
- East Rd .02
- Jackey Ln .02

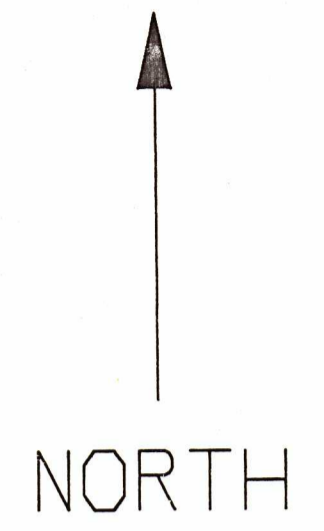

RIVER OF  
LAKES ANNEX

Brian Corell  
V.P Weekend retreat cabin owners  
608 723 2426 LANCASTER  
#180 BARR HARBOR + 110 PACKER DRIVE  
117 & 119 PACKER DR ONE HOME  
122 & 124 SKID ROW ONE HOME  
118 & 120 SKID ROW ONE HOME?  
131 & 133 SKID ROW ONE HOME