



State Highway Commission of Wisconsin

STATE OFFICE BUILDING
1 WEST WILSON STREET
MADISON, WISCONSIN 53702

CENTRAL OFFICE

August 16, 1965

Mr. Edward J. Nickson, Commissioner
Grant County Highway Department
Box 150
Lancaster, Wisconsin 53813

Mildred Krohn
Grant County Clerk
Courthouse, Box 191
Lancaster, Wisconsin 53813

Dear Sir and Madam:

Project T 0335(2)
Mt. Hope-Woodman Road
S.T.H. 132
Grant County

The Highway Commission deems it necessary to make certain revisions on a previously approved right of way plat and to acquire certain lands and interests in lands according to such revisions, for the proper improvement or maintenance of the above-designated project and highway. The revised relocation order of the Commission and the map showing the highway as laid out and established and the lands and interests to be acquired are transmitted herewith.

The enclosed relocation order provides that the State Highway Commission shall make the necessary acquisitions of lands and interests not previously acquired, pursuant to Section 84.09(1) or (2), Wisconsin Statutes.

Very truly yours,

A handwritten signature in cursive script, reading "B. O. Binney".

B. O. Binney
Vice Chairman

BOB:MH
CC:DE#1
RVL
Enc.

RELOCATION ORDER
BY STATE HIGHWAY COMMISSION OF WISCONSIN

* * * * *

THE STATE HIGHWAY COMMISSION FINDS AND DETERMINES THAT:

The proper establishing, laying out, widening, enlarging, extending, constructing, reconstructing, improving, or maintaining a portion of the highway now designated as State Trunk Highway 132, from a point 605 feet east of the southwest corner of Section 15, Township 7 North, Range 4 West, easterly to a point 960 feet north of the northeast corner of the southwest quarter of Section 14, Township 7 North, Range 4 West,

and on roads or lands in and about and along and leading to same, requires certain relocation or change and the acquisition of lands or interests in lands as shown on the map or copy thereof marked

"PLAT OF RIGHT OF WAY REQUIRED, PROJECT T 0335(2),"

for the Mt. Hope - Woodman Road,

S.T. H. 132, Grant County, dated July 14, 1965,

the same being sheet No. 4 and 4.1 of the plans for said project, and

Pursuant to its authority under Sections 84.02 (3) and 84.09, Wisconsin Statutes,

THE STATE HIGHWAY COMMISSION HEREBY ORDERS THAT:

(1) The said highway is hereby laid out and established to the lines and widths as shown on the said plat.

(2) The required lands or interests in lands as shown on the plat shall be acquired ~~by the County Highway Committee of the county in which the lands are situated, pursuant to the provisions of Section 84.09 (2), Wisconsin Statutes. However, said County Highway Committee shall have no authority to settle or compromise any action or proceeding which might arise because of acts done by it in complying with this order without prior written approval~~ by the State Highway Commission, in the name of the State of Wisconsin, pursuant to Section 84.09(1) or (2), Wisconsin Statutes.

~~(3) Buildings, fixtures or chattels acquired incident to the acquisition of lands or rights in lands under this order and to be removed shall, subject to approval of the Highway Commission, be sold by the County Highway Committee at public or private sale to the highest bidder, and the net proceeds of such sale paid into the state highway fund.~~

(4) This order supersedes and amends the previous order issued by the Commission on June 2, 1965.

* * * * *

The foregoing order was issued by the State Highway Commission and entered in the minutes of its meeting on August 13, 1965.


 Secretary, State Highway Commission of Wisconsin

Vice Chairman



The State of Wisconsin

HIGHWAY COMMISSION

STATE OFFICE BUILDING

MADISON 2

April 28, 1950

Mr. Eugene Croft
Grant County Highway Commissioner
Lancaster, Wisconsin

✓ Mr. Alonzo Aupperle
County Clerk, Grant County
Lancaster, Wisconsin

Gentlemen:

SUBJECT: Project T 0335(1)
Mount Hope-Boscobel Road
S.T.H. 132
Grant County

The Highway Commission deems it necessary to make certain revisions on a previously approved right-of-way plat and to acquire certain lands and interests in lands according to such revisions, for the proper improvement or maintenance of the above-designated project and highway. The revised relocation order of the Commission and the map showing the highway as laid out and established and the lands and interests to be acquired are transmitted herewith.

The enclosed relocation order provides that the county highway committee shall make the necessary acquisitions of lands and interests not previously acquired, pursuant to Section 84.09(3), Wisconsin Statutes.

Very truly yours

STATE HIGHWAY COMMISSION OF WISCONSIN

William P. Ward

William P. Ward
Secretary

WPW:MO
CC:DE#9
WBB
Enc.

Filed May 1 1950
Alonzo Aupperle
County Clerk

SCHEDULE OF LANDS AND INTERESTS REQUIRED			
PARCEL NUMBER	OWNER	INTERESTS REQUIRED	ACRES
1	ORVILLE HILL	SE 1/4	36.1
2	THOMAS MOONEY	"	12.6
3	WIRIL L. FRY ET AL.	"	0.6

END RELOCATION ORDER
PROJECT T035(12) STA. 511+00
STA. 511+00, PROJECT T035(11),
BRO. N. OF THE NE COR. OF THE SW 1/4
OF SEC. 16, T7N, R4W.

EQUATIONS
STA. B.K. STA. A.H.
426+02.9 = 426+06.2
432+13.3 = 432+16.8
433+47.3 = 433+50.8
434+47.3 = 434+50.8
435+16.5 = 435+19.8
437+32.3 = 437+35.8
487+08.2 = 487+11.5
491+08.2 = 491+11.5
501+31.6 = 501+35.0

A. = 7'-30"
D. = 2'-00"
T. = 161.8'
L. = 316.0'
R. = 2863.0'

BEGIN RELOCATION ORDER
PROJECT T035(12) STA.
420+75 STA. 420+75,
END OF THE CORNER
OF SEC. 16, T7N, R4W.



A. = 10'-00"
D. = 4'-00"
T. = 125.3'
L. = 250.0'
R. = 1432.5'

A. = 89'-55"
D. = 15'-00"
T. = 367.6'
L. = 562.0'
R. = 358.1'
P.C. = 426+51.3
P.T. = 422+18.8

A. = 4'-20"
D. = 1'-00"
T. = 216.8'
L. = 433.3'
R. = 5730.0'

A. = 5'-00"
D. = 2'-00"
T. = 125.1'
L. = 250.0'
R. = 2863.0'

STANDARD ABBREVIATIONS
S = GARAGE
H = HOUSE
C = COTTAGE

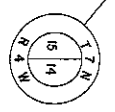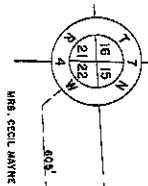

REVISION DATE 7/14/55	STATE HIGHWAY COMMISSION OF WISCONSIN PLAT OF RIGHT OF WAY REQUIRED PROJECT T035(12) MT. HOPE - WOODMAN ROAD GRANT COUNTY
LENGTH 1.708 MILES	SCALE 0 400 FEET DATED MAY 24/1966

COUNTY	ROUTE	CLASS AND AGREEMENT	B. P. R.	SHEET	TOTAL
AND	SECTION	STATE	FEDERAL	DIVISION	NUMBER
22.2	335.0	21.2	4	4	4
COUNT PROJECT					



A horizontal scale bar with the word "SCALE" written vertically above it. The bar has tick marks at 0, 200, and 400 feet, with the word "FEET" written vertically below the 200 mark.