

Wisconsin Department of Transportation



TRANSPORTATION DISTRICT 1
2101 Wright Street
Madison, WI 53704-2583

Telephone (608) 246-5357
FAX (608) 246-3819

November 25, 2005

Chris Carl
Grant County Clerk
PO BOX 529
Lancaster, WI 53813

SUBJECT: Project ID 5205-03-23
Potosi - Cassville Road
(CTH N - Cassville)
STH 133
Grant County

Dear Ms. Carl:

The Department of Transportation deems it necessary to make certain revisions to a previously approved Right-of-Way Plat and to acquire certain lands and interests therein, according to such revisions, for the proper improvement or maintenance of the above-designated project and highway.

Sections 84.09(1) and 32.05(1)(a) of Wisconsin Statutes state, in part, that a copy of the Department's Relocation Order and Right-of-Way Plat shall be filed, within 20 days after its issue, with the county clerk and county highway committee of each county in which such lands or interests are required. It is the intent of this submittal to comply with that law and provide you with a copy to file of the Relocation Order and Right-of-Way Plat for the project. The Relocation Order also indicates by whom the right-of-way will be acquired.

The original of this approved Relocation Order will be retained in this office.

Sincerely,

Bob Rogers

Bob Rogers
Real Estate Agent

Enclosure

cc: County Highway Commissioner
Central Office Real Estate

PROJECT COST ALLOCATION

DT1532 9/2003 (Replaces RE 3021)

Wisconsin Department of Transportation

To: Bureau of State Highway Programs (BSHP)
Program Finance Section, Room #901

From: Real Estate Management District 1

Project
5205-03-23
Potosi - Cassville Road
(CTH N - Cassville)
STH 133
Grant County

BSHP Approval

BHRE Finance Unit Use Only:

Order Number Assigned

3375700

Initials

Date

11/18/04

☐ Original

☒ Revision # 1

☐ Final

☐ Phased Project ID _____

☐ 5550 - State

☐ 5526 - County

☐ 5531 - Local

NON-DELIVERY

1. Estimated right of way costs of all parcels (exclusive of reimbursable utilities.) See attached Parcel Cost Estimate.
\$ _____ \$0.00
2. Estimated relocation assistance and moving costs.
\$ _____ \$0.00
3. Amount to be encumbered. (Total of Lines 1 & 2)
\$ _____ \$0.00
4. Other contracts for razing, site clearance (encumbered separately).
\$ _____ \$0.00

DELIVERY

- 5a. Estimated Labor Costs
\$ _____ \$0.00
- 5b. Contracts (Title, Appraisals, etc.)
\$ _____ \$0.00
- 5c. Total Delivery
\$ _____ \$0.00
- 5d. Percent of delivery (5c. divided by Line 3)
_____ 0.00 %

6. Total Acquisition Cost Estimate: (Total of Lines 3, 4 & 5c) \$ _____ \$0.00

7. Total number of parcels on project.	Previous	54
	+ or - Revised	-1
	Total	53

8. Project Concepts

To record several plat changes.

There are 4 utility parcels in addition to the above.

(District Planning Section)

(Date)

(District Real Estate Representative)

(Date)

RELOCATION ORDER

Wisconsin Department of Transportation
DT1708 2000 (Replace RE3006)

Project	Name of Road	Highway	County
5205-03-23	Potosi - Cassville Road	STH 133	Grant
Right of Way Plat Date	Plat Sheet Numbers	Date of Previously Approved Relocation Order	
11/11/05	4.1 - 4.22	11/11/04	

Description of Termini of Project

Beginning at a point 2413.27 feet South of and 16.36 feet East of the North quarter corner of Section 27, Town 3 North, Range 4 West, thence continuing to a point 1793.32 feet South of and 2769.78 feet West of the North quarter corner of Section 28, Town 3 North, Range 5 West.

To properly establish, lay out, widen, enlarge, extend, construct, reconstruct, improve, or maintain a portion of the highway designated above, it is necessary to relocate or change and acquire certain lands or interests in lands as shown on the right of way plat for the above project.

To effect this change, pursuant to authority granted under Sections 84.02(3) and 84.09, Wisconsin Statutes, the Department of Transportation orders that:

1. The said highway is laid out and established to the lines and widths as shown on the plat.
2. The required lands or interests in lands as shown on the plat shall be acquired by the Wisconsin Department of Transportation in the name of the State of Wisconsin, pursuant to the provisions of Section 84.09(1) or (2), Wisconsin Statutes.
3. This order supersedes and amends any previous order issued by the Department.

(Regd Estate Manager)

(Date)

Relocation Order Revision Form (RORF)

Project I.D. 5205-03-23
Potosi – Cassville Road
STH 133
Grant County

<u>Page</u>	<u>Parcel</u>	<u>Item</u>
All		Add Revision Date (November 11, 2005)
4.2	7, 8, 22, 57, 71, 72 & 74	Change Owner's Name
	8, 13, 16, 19	Revise Fee and TI
	9	Remove TI
	17, 18, 21	Revise Fee
	22, 26	Revise Fee and TI
	23	Revise Total Acres / Revise Fee
	24	Revise Fee, TI and Add PLB
	27, 34	Revise Fee
	28	Remove Parcel
	39	Revise TI
	43, 46	Revise Fee
	53, 54, 56 & 57	Revise TI and Add PLB
	50	Add Parcel
	51	Revise TI

<u>Page</u>	<u>Parcel</u>	<u>Item</u>
4.4	28	Remove Parcel
4.5	22	Revise Parcel
	50	Add Parcel
4.6	71, 72	Change Utility Names
4.7	7	Change Owner's Name
	71, 72	Change Utility Names
4.8	7, 8	Change Owner's Name
	71, 72	Change Utility Name
4.9	8	Revise Station Out PT 2035
	8	Change Owner's Name, Revise Fee and TI
	9	Remove TI
	71, 72	Change Utility Names
4.10	71, 72	Change Utility Names
4.11	13	Remove Building from Topography
	13	Revise Fee At Revised Chapel Hollow Road Intersection
	16	Revise Fee
	71, 72	Change Utility Names
4.12	17, 18, 19	Revise Fee
	71, 72	Revise Utility Name

<u>Page</u>	<u>Parcel</u>	<u>Item</u>
4.13	22	Change Owner Name and Revise Fee
	17, 21	Revise Fee
	71, 72, 74	Change Utility Name
4.14	22	Revise Fee and TI, Add Sign E-3, Change Owner Name
	24	Revise Fee
	71, 72, 74	Change Utility Name
4.15	24	Revise Fee and TI
	26	Revise Fee
	27	Add TI
	71, 72, 74	Change Utility Name
4.16	27	Revise Fee, Add Sign E-4
	28	Remove Parcel
	71, 72	Change Utility Name
4.17	33	Add Sign E-5
	34	Revise Fee, TI and Owner's Name
	71, 72	Change Utility Name
4.18	34	Revise Fee
	36	Add Sign 36-2
	37	Add TI
	71, 72	Change Utility Name

<u>Page</u>	<u>Parcel</u>	<u>Item</u>
4.19	42	Change Station-Offset for Points 4177 and 4178
	71, 72	Change Utility Name
	43	Change Owner Sign E-2
4.20	39	Revise TI
	43, 46	Revise Fee
	71, 72	Change Utility Name
	43	Add Sign 43-1
4.21	50	Add Parcel
	51	Revise Parcel and TI
	53, 54, 56	Revise TI and Add PLE
	57	Revise Owner Name, TI and Add PLE
	71, 72, 73	Change Utility Name
4.22	57	Revise Owner Name, TI and Add PLE
	72, 73	Change Utility Name

CONVENTIONAL SIGNS AND ABBREVIATIONS

STATE LINE	COUNTY LINE	TOWNSHIP AND RANGE LINES	SECTION LINE	QUARTER LINE	SIXTEENTH LINE	NEW REFERENCE LINE	NEW R/W LINE	EXISTING R/W LINE	PROPERTY LINE	CORPORATE LIMITS	LOT, TIE AND OTHER MINOR LINES	SLOPE INTERCEPTS	UNDERGROUND FACILITY (GAS, TELEPHONE, ELECTRIC, ETC.)	FENCE	TEMPORARY INTEREST	PERMANENT LIMITED EASEMENT	BEAM GUARD TRANSMISSION STRUCTURE AND LINE	PEDESTAL	MEANDER SECTION CORNER	PRIVATE DRIVE	ACRES	AHEAD AND OTHERS	BACK	BARN	CENTERLINE	CENTRAL ANGLE	CONCRETE CORNER	GARAGE	HOUSE LENGTH	LONG CHORD OVERHEAD UTILITIES	FORCE MAIN	LIMITED HIGHWAY EASEMENT
			SECTION CORNER	NOTATION FOR COMBUSTIBLE FLUIDS	BRIDGE	STREAM OR RIVER	LAKE	CULVERT (BOX, PIPE OR CATTLE PASS)	RAIL LINE	SIGN	FOUNDATION OR RUN BUILDING	CEMETERY	R/W MONUMENT NON-MONUMENTED	IRON PIN VALVE WINDMILL	SILO, MANHOLE, VENT, SEPTIC VENT, WELL, ETC.	GAS PUMPS BUSHES	(DECIDUOUS) TREES (CONIFEROUS)	WOODS	ENCROACHING SIGN	POWER POLE TELEPHONE POLE	NO ACCESS (BY ACQUISITION)	NO ACCESS (BY STATUTORY AUTHORITY)	NO ACCESS (BY PREVIOUS PROJECT)	STORM SEWER LONG CHORD BEARING MONUMENT PARKER-KALON FASTENER PROPERTY LINE RADIUS RIGHT OF WAY SECTION SHED SQUARE FEET STATION TANGENT TEMPORARY INTEREST TRANSIT LINE OVERHEAD ELECTRIC SANITARY SEWER	SS LCB MON PK PL R R/W SEC S SF STA T TI TL OHE SAN	END STA 1793.3 THE N SECTION						

NOTES

DIMENSIONING FOR THE NEW R/W IS MEASURED ALONG AND PERPENDICULAR TO THE NEW REFERENCE LINES.

GOVERNMENTAL LAND LINE AND REFERENCE LINE ARE NOT COINCIDENTAL.

DISTANCES FROM REFERENCE LINE ARE

$\overleftrightarrow{XX'}$
 R

DISTANCES FROM GOVERNMENTAL LAND LINE ARE $\overleftrightarrow{XX'}$ OR $XX' G$

EXISTING HIGHWAY RIGHT OF WAY SHOWN HEREIN IS BASED ON THE FOLLOWING POINTS OF

REFERENCE AS SPECIFIED ON
9536-D, 9536-C & 9536-B.

COORDINATES AND BEARINGS ON THIS PLAT ARE ORIENTED TO THE WISCONSIN COORDINATE SYSTEM SOUTH ZONE, NAD 83(19), ALL PLAT DISTANCES ARE GROUND LENGTH AND MAY BE CONVERTED TO GRID LENGTH BY MULTIPLYING THE DISTANCE BY THE GRID FACTOR PROVIDED ON THE DETAIL SHEETS).

RIGHT OF WAY MONUMENTS ARE TYPE 2 AND ARE PLACED PRIOR TO OR AT THE TIME OF LAND TITLE TRANSFER.

RIGHT OF WAY BOUNDARIES ARE DEFINED WITH COURSES OF THE PERIMETER OF THE HIGHWAY LANDS REFERENCED TO THE U.S. PUBLIC LAND SURVEY OR OTHER "SURVEYS OF PUBLIC RECORDS".

REVISION DATE: NOV. 11, 2005 (INC.)

FILE NAME :

ORIGINATOR :

PLOT NAME :

PLOT SCALE :

PLOT DATE: 16 AUG 2004

WISDOT/CADDS SHEET 50

PLAT OF RIGHT OF WAY REQUIRED FOR
POTOSI - CASSVILLE ROAD

HIGHWAY:	STH 133
COUNTY:	GRANT

R/W PROJECT NUMBER:	5205-03-233
FEDERAL PROJECT NUMBER:	

SHEET NUMBER:	4.1	E
TOTAL SHEETS:	33	

TOTAL NET LENGTH OF CENTERLINE = 8.941 MI.

LAYOUT
SCALE 0 1.0 MI.

ORIGINAL PLAT MANAGED BY L.J.B. - DISTRICT 1 - DESIGN	STATE OF W
LAYOUT SCALE	

2.0

1

STATE OF WISCONSIN
DEPARTMENT OF TRANSPORTATION


DATE: 8/31/04
Jenny / Best

SHEET NUMBER: 4.1

	4.1
TOTAL SHEETS:	22

END RELOCATION ORDER
STA. 853+75
1793.32' SOUTH OF AND 2769.78' W
THE NORTH 1/4 CORNER,
SECTION 28, T3N, R5W.


BEGIN RELOCATION ORDER
STA. 398+88
2413.27 SOUTH OF AND 16.36 EAST OF
THE NORTH 1/4 CORNER, SECTION 27, T3N, R4W,

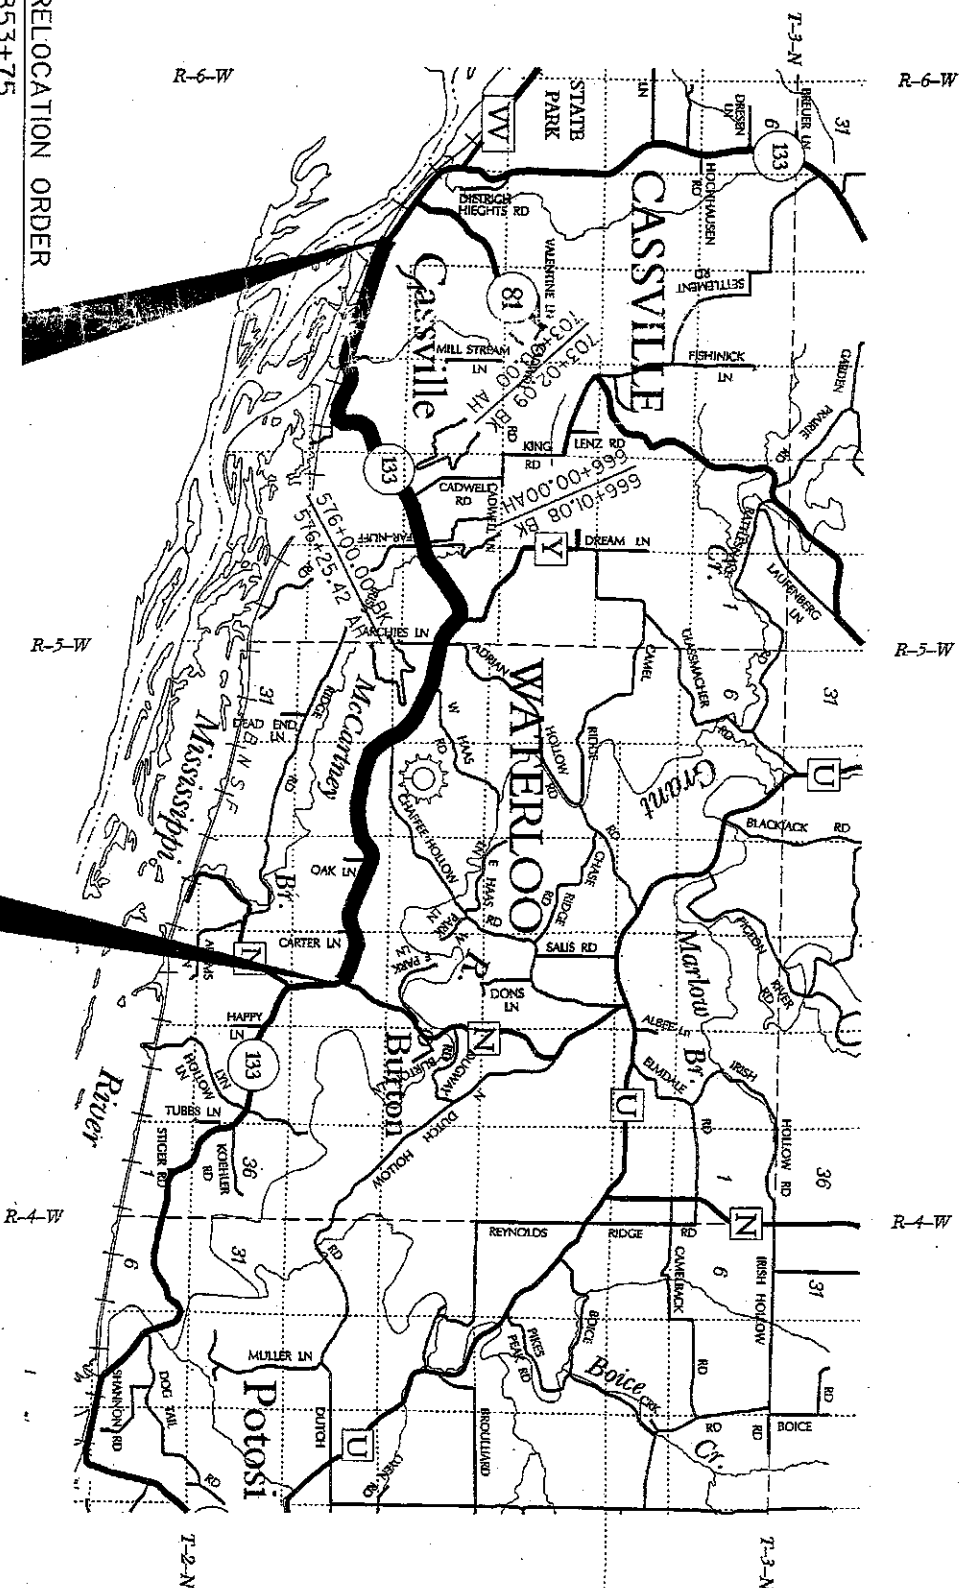

KL Engineering
Transportation • Material • Environmental • Services

HEREBY CERTIFY THAT THIS PLAT WAS
MADE FOR THE WISCONSIN DEPARTMENT
OF TRANSPORTATION AND IS CORRECT
TO THE BEST OF MY KNOWLEDGE AND
BELIEF.



August 27, 2009

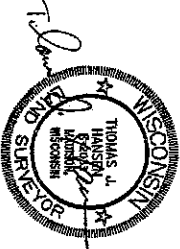

SCHEDULE OF LANDS & INTERESTS REQUIRED


PARCEL NUMBER	SHEET	OWNER (S)	INTEREST	TOTAL ACRES	R/W ACRES REQUIRED	NEW EXISTING	TOTAL ACRES REM.	TOTAL ACRES	PLE
2	4.6, 4.7	CHARLES E. AND LINDA A. TOMASZEWSKI	FEE, TI	158.56	7.90	1.98	9.88	148.68	0.33
3	4.7	ROXANNE KARTMAN	FEE	52.59	1.47	1.52	2.99	49.60	---
4	4.7, 4.8	HAROLD & JUDY SCHUPPNER	FEE, TI	194.00	0.54	1.32	1.86	192.14	0.05
5									
6	4.7	TALARCZYK COMPANY #1 LLC	FEE	323.61	0.04	0.02	0.06	323.55	---
7	4.7, 4.8	HELEN M. PROESSL, IRREVOCABLE TRUST, DATED APRIL 8, 2005, VENDOR STEVEN F. RETALLICK, PURCHASER	FEE, PLE, TI	158.38	4.31	5.38	9.69	148.69	0.18
8	4.8, 4.9	STEVEN F. RETALLICK	FEE, TI	149.24	4.63	5.33	9.96	139.28	0.68
9	4.9, 4.10	CHESTER & MARVIN HAAS	FEE	307.80	1.92	2.53	4.45	303.35	---
10		WALTER J. & MARGARET C. HAUKE, VENDOR WILLIAM J. & AMY J. HAUKE, PURCHASER	FEE, TI	245.80	1.83	4.03	5.86	239.94	0.45
11	4.10, 4.11	LEROY H. & PATRICIA J. SCHAUFF, VENDOR MICHAEL J. & DARLENE F. SCHAUFF, PURCHASER	FEE, TI	252.67	2.32	3.99	6.31	246.36	0.49
14	4.11	DENNIS & DIANE WIELAND	FEE	1.20	0.13	0.30	0.43	0.77	---
15	4.12	MARTIN J. & MARY K. MUMM	FEE, TI	6.53	0.07	0.50	0.57	5.96	0.01
16	4.11, 4.12	CARL F. & ELIZABETH A. ABING	FEE, TI	480.34	4.02	2.53	6.55	473.79	0.09
17	4.11, 4.12	KENNETH NEHLS & CHRISTINE RUSSELL	FEE	68.60	2.39	3.85	6.25	62.36	---
18	4.12	RONALD & SALLY K. KIRSCHBAUM	FEE	9.86	0.13	0.33	0.46	9.40	---
19	4.12, 4.13	ELEANOR MUMM	FEE, TI	313.39	1.38	2.94	4.32	309.07	0.25
20	4.12, 4.13	SEVENTH DAY ADVENTIST CHURCH	TI	1.29	---	---	1.29	---	0.02
21	4.13	MARTIN J. MUMM	FEE	2.56	0.09	0.49	0.58	1.98	---
22	4.13, 4.14	BERNARD G. BAUSCH	FEE, TI	162.50	9.47	4.39	13.86	148.64	0.09
23	4.13, 4.14	PATRICK B. BAUSCH	FEE	116.50	0.19	0.79	0.98	115.52	---
24	4.14, 4.15	BERNARD & RUTH C. BAUSCH, SELLER DENNIS C. & KAREN S. BAUSCH, BUYER	FEE, PLE, TI	217.21	4.48	6.48	10.96	206.25	0.46
25									
26	4.15	LEONE J. RICHTER	FEE, TI	0.79	0.04	0.15	0.19	0.60	0.26
27	4.15, 4.16	JAMES J. & SHARON A. REYNOLDS	FEE, PLE, TI	319.13	2.75	6.76	9.51	309.61	0.33
28									
29	4.16, 4.17	JACOB VOGT	FEE, TI	1.12	0.15	0.49	0.64	0.48	0.06
30	4.17	IVERSON CONSTRUCTION TRUST	FEE	10.07	1.11	---	1.11	8.96	---
31	4.16, 4.17	CASSVILLE CONSERVATION CLUB, INC.	FEE	39.25	0.19	0.75	0.94	38.31	---
32	4.17	DAVID C. & CINDY A. RITTER	FEE, TI	6.50	0.52	1.25	1.77	4.73	0.16
33	4.17, 4.18	LARC LAND CO., LLC	FEE	134.91	1.31	3.00	4.31	130.60	---
40	4.20	HAROLD & JOAN M. LENZ	FEE	1.00	0.01	0.42	0.43	0.57	---
41	4.19	GRANT COUNTY HIGHWAY DEPARTMENT	FEE	1.60	0.07	0.45	0.52	1.08	---
42	4.19	KENNETH J. & SHARON A. SCHAUFF	FEE, TI	30.00	0.32	2.03	2.35	27.65	0.25
43	4.19, 4.20	KOWALSKI-KEILER, INC.	FEE	35.50	1.32	3.16	4.48	31.02	---
44	4.19, 4.20	CASSVILLE ECONOMIC DEVELOPMENT CORPORATION	FEE	5.00	0.19	1.12	1.31	3.69	---
45									
46	4.20	RIVER VALLEY COMMUNITY CHURCH, INC.	FEE	1.76	0.08	0.52	0.60	1.16	---
47	4.20	CHARLES J. RAUCH	FEE, TI	0.55	0.09	0.11	0.20	0.35	0.05
48	4.20, 4.21	ROBERT J. & ROSE M. SCHNORRENBURG	TI	0.69	---	---	---	0.69	0.23
49	4.21	ROBERT D. & GLORIA C. HUDSON	TI	0.66	---	---	---	0.66	0.26
50	4.21	DAVID G. & MARY ANN ECKSTEIN	TI	0.36	---	---	---	0.36	0.09
51	4.21	DAVID G. ECKSTEIN	TI	0.36	---	---	---	0.36	0.11
52	4.21	DONALD T. RUSSELL	TI	8.00	---	---	---	8.00	0.73
53	4.21	MICHAEL F. WUNDERLIN & SUE MINOR	PLE, TI	0.40	---	---	---	0.40	0.08
54	4.21	LACHLAN C. & KAREN L. HOLZWARTH	PLE, TI	0.21	---	---	---	0.21	0.03
55									
56	4.21	JEROME C. & SUSAN M. WANSLEY	PLE, TI	0.60	---	---	---	0.60	0.02
57	4.21, 4.22	JEFFERY J. & MARY K. GLASS	PLE, TI	1.47	---	---	---	1.47	0.09
58	4.22	MARK J. & KATHLEEN A. MEIER	TI	0.69	---	---	---	0.69	0.08
59	4.22	SHELDON J. RALPH	TI	0.57	---	---	---	0.57	0.03
60									
61	4.20-4.22	BURLINGTON NORTHERN RAILROAD COMPANY	PLE	NA	---	---	---	NA	3.49
62	4.22	ANNE K. HOCHAUSEN	TI	NA	---	---	---	NA	0.12
71	4.06-4.21	SCENIC RIVERS ELECTRIC COOPERATIVE	RELEASE OF RIGHTS						
72	4.06-4.22	TDS-FARMERS TELEPHONE COMPANY	RELEASE OF RIGHTS						
73	4.21, 4.22	BURLINGTON NORTHERN RAILROAD COMPANY	RELEASE OF RIGHTS						
74	4.13-4.15	AMERICAN TRANSMISSION COMPANY	RELEASE OF RIGHTS						

BEGIN RELOCATION ORDER
STA. 398+88

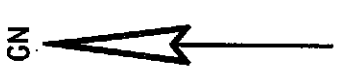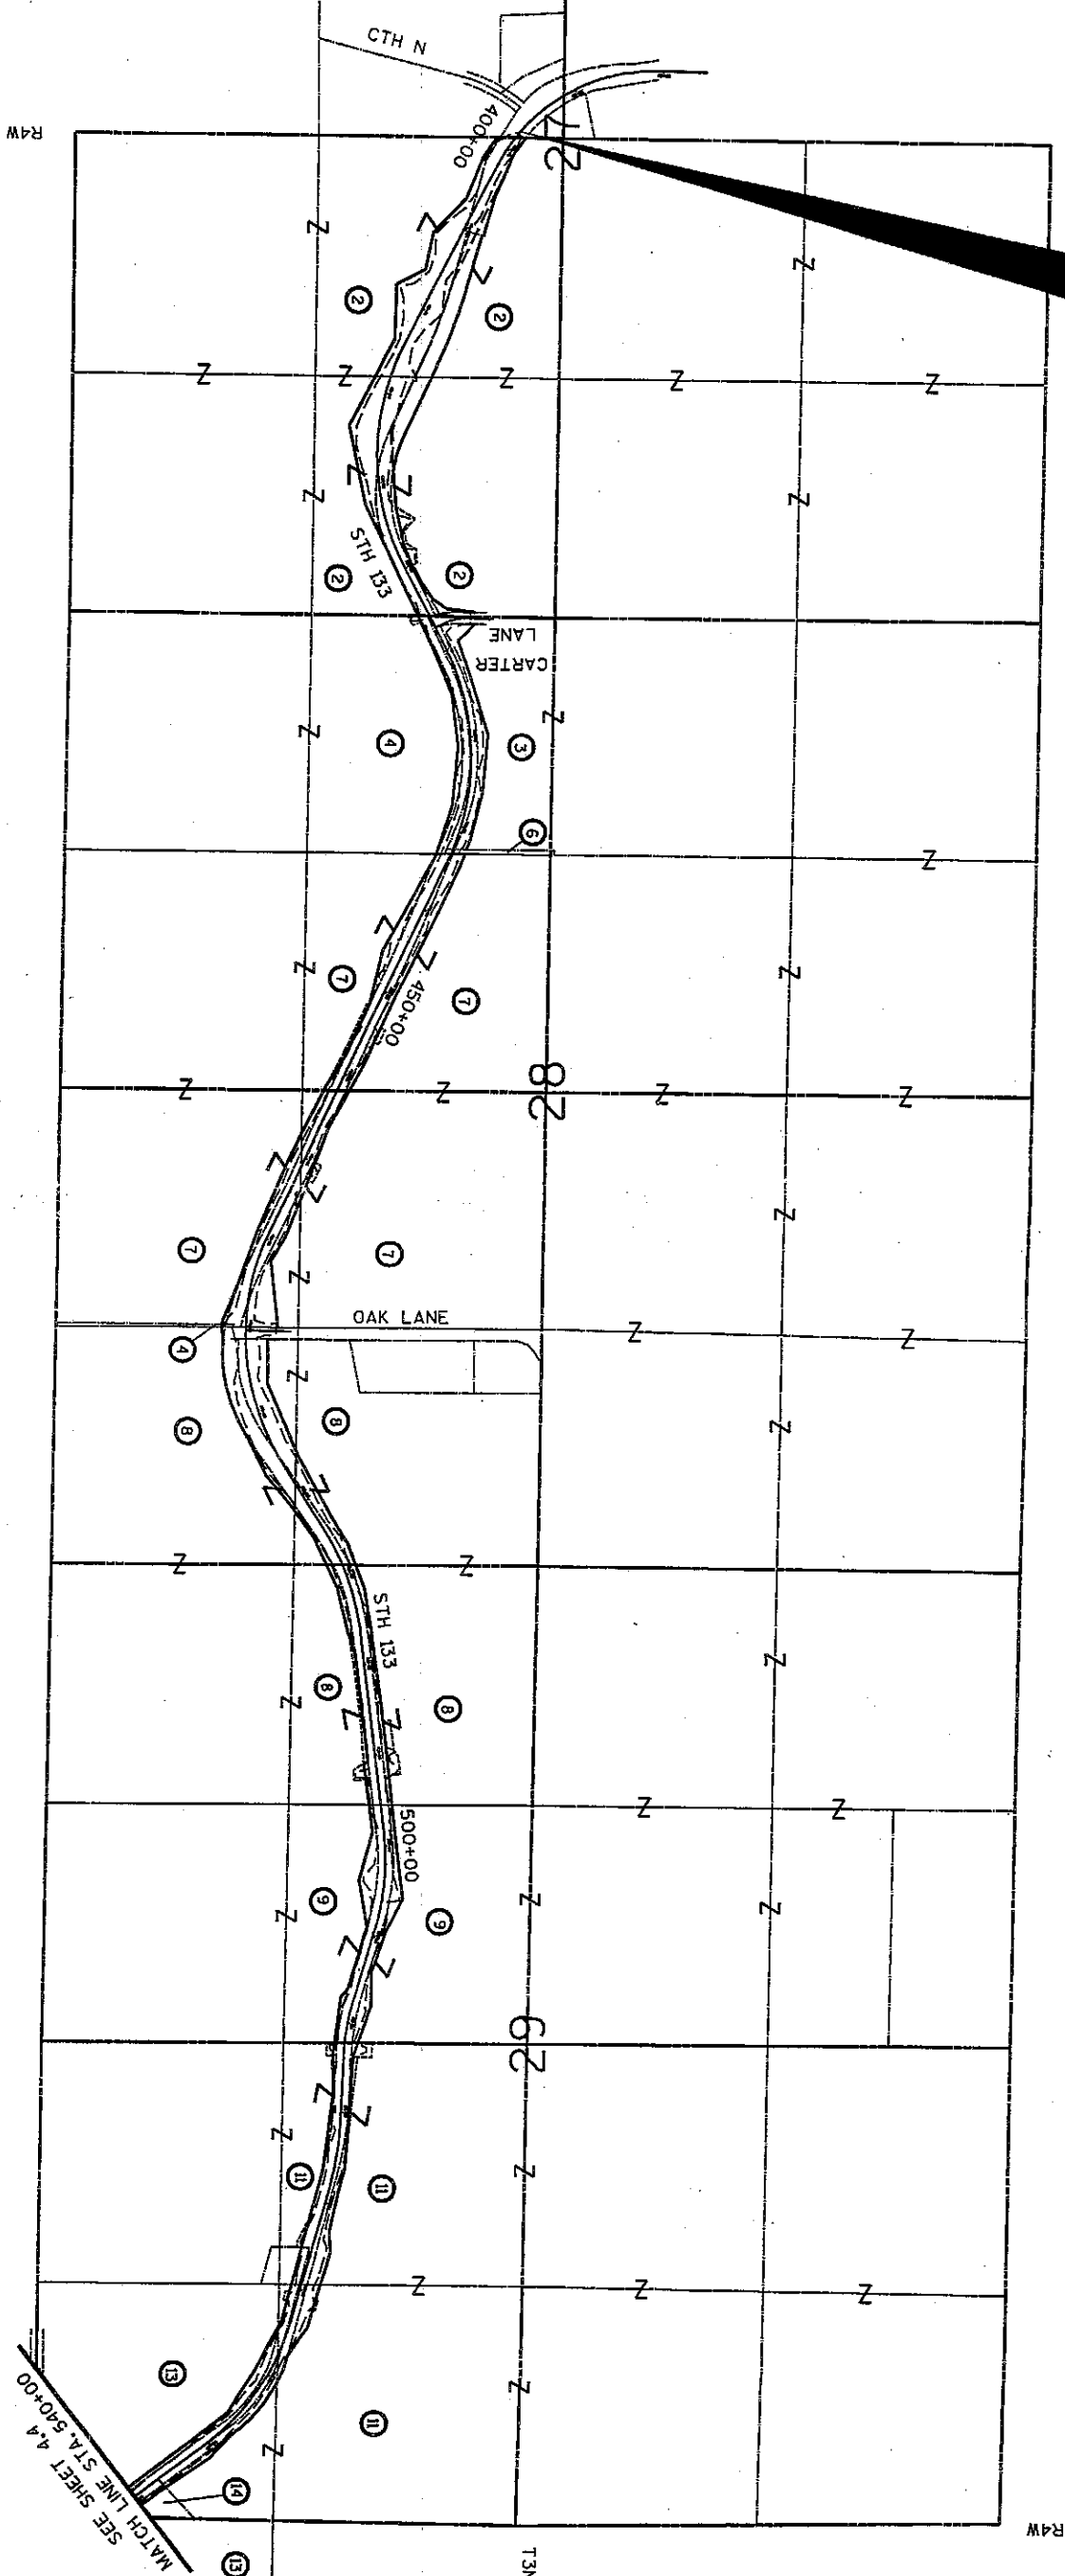


TOWN OF WATERLOO

REVISION DATE NOV. 11, 2005(NC)		DATE AUG. 27, 2004		NOT TO SCALE		HWY: STH 133		STATE R/W PROJECT NUMBER 5205-03-23		PLAT SHEET NO: 4.3	
COUNTY: GRANT		CONSTRUCTION PROJECT NUMBER		PLOT DATE : 10 NOV 2005		PLOT BY : KL Engineering		PLOT NAME :		PS&E SHEET	
FILE NAME : Q:\F07H\FY109941\FW\941-FW403.dgn		PLOT SCALE :		WISDOT/CADDS SHEET 70		E					

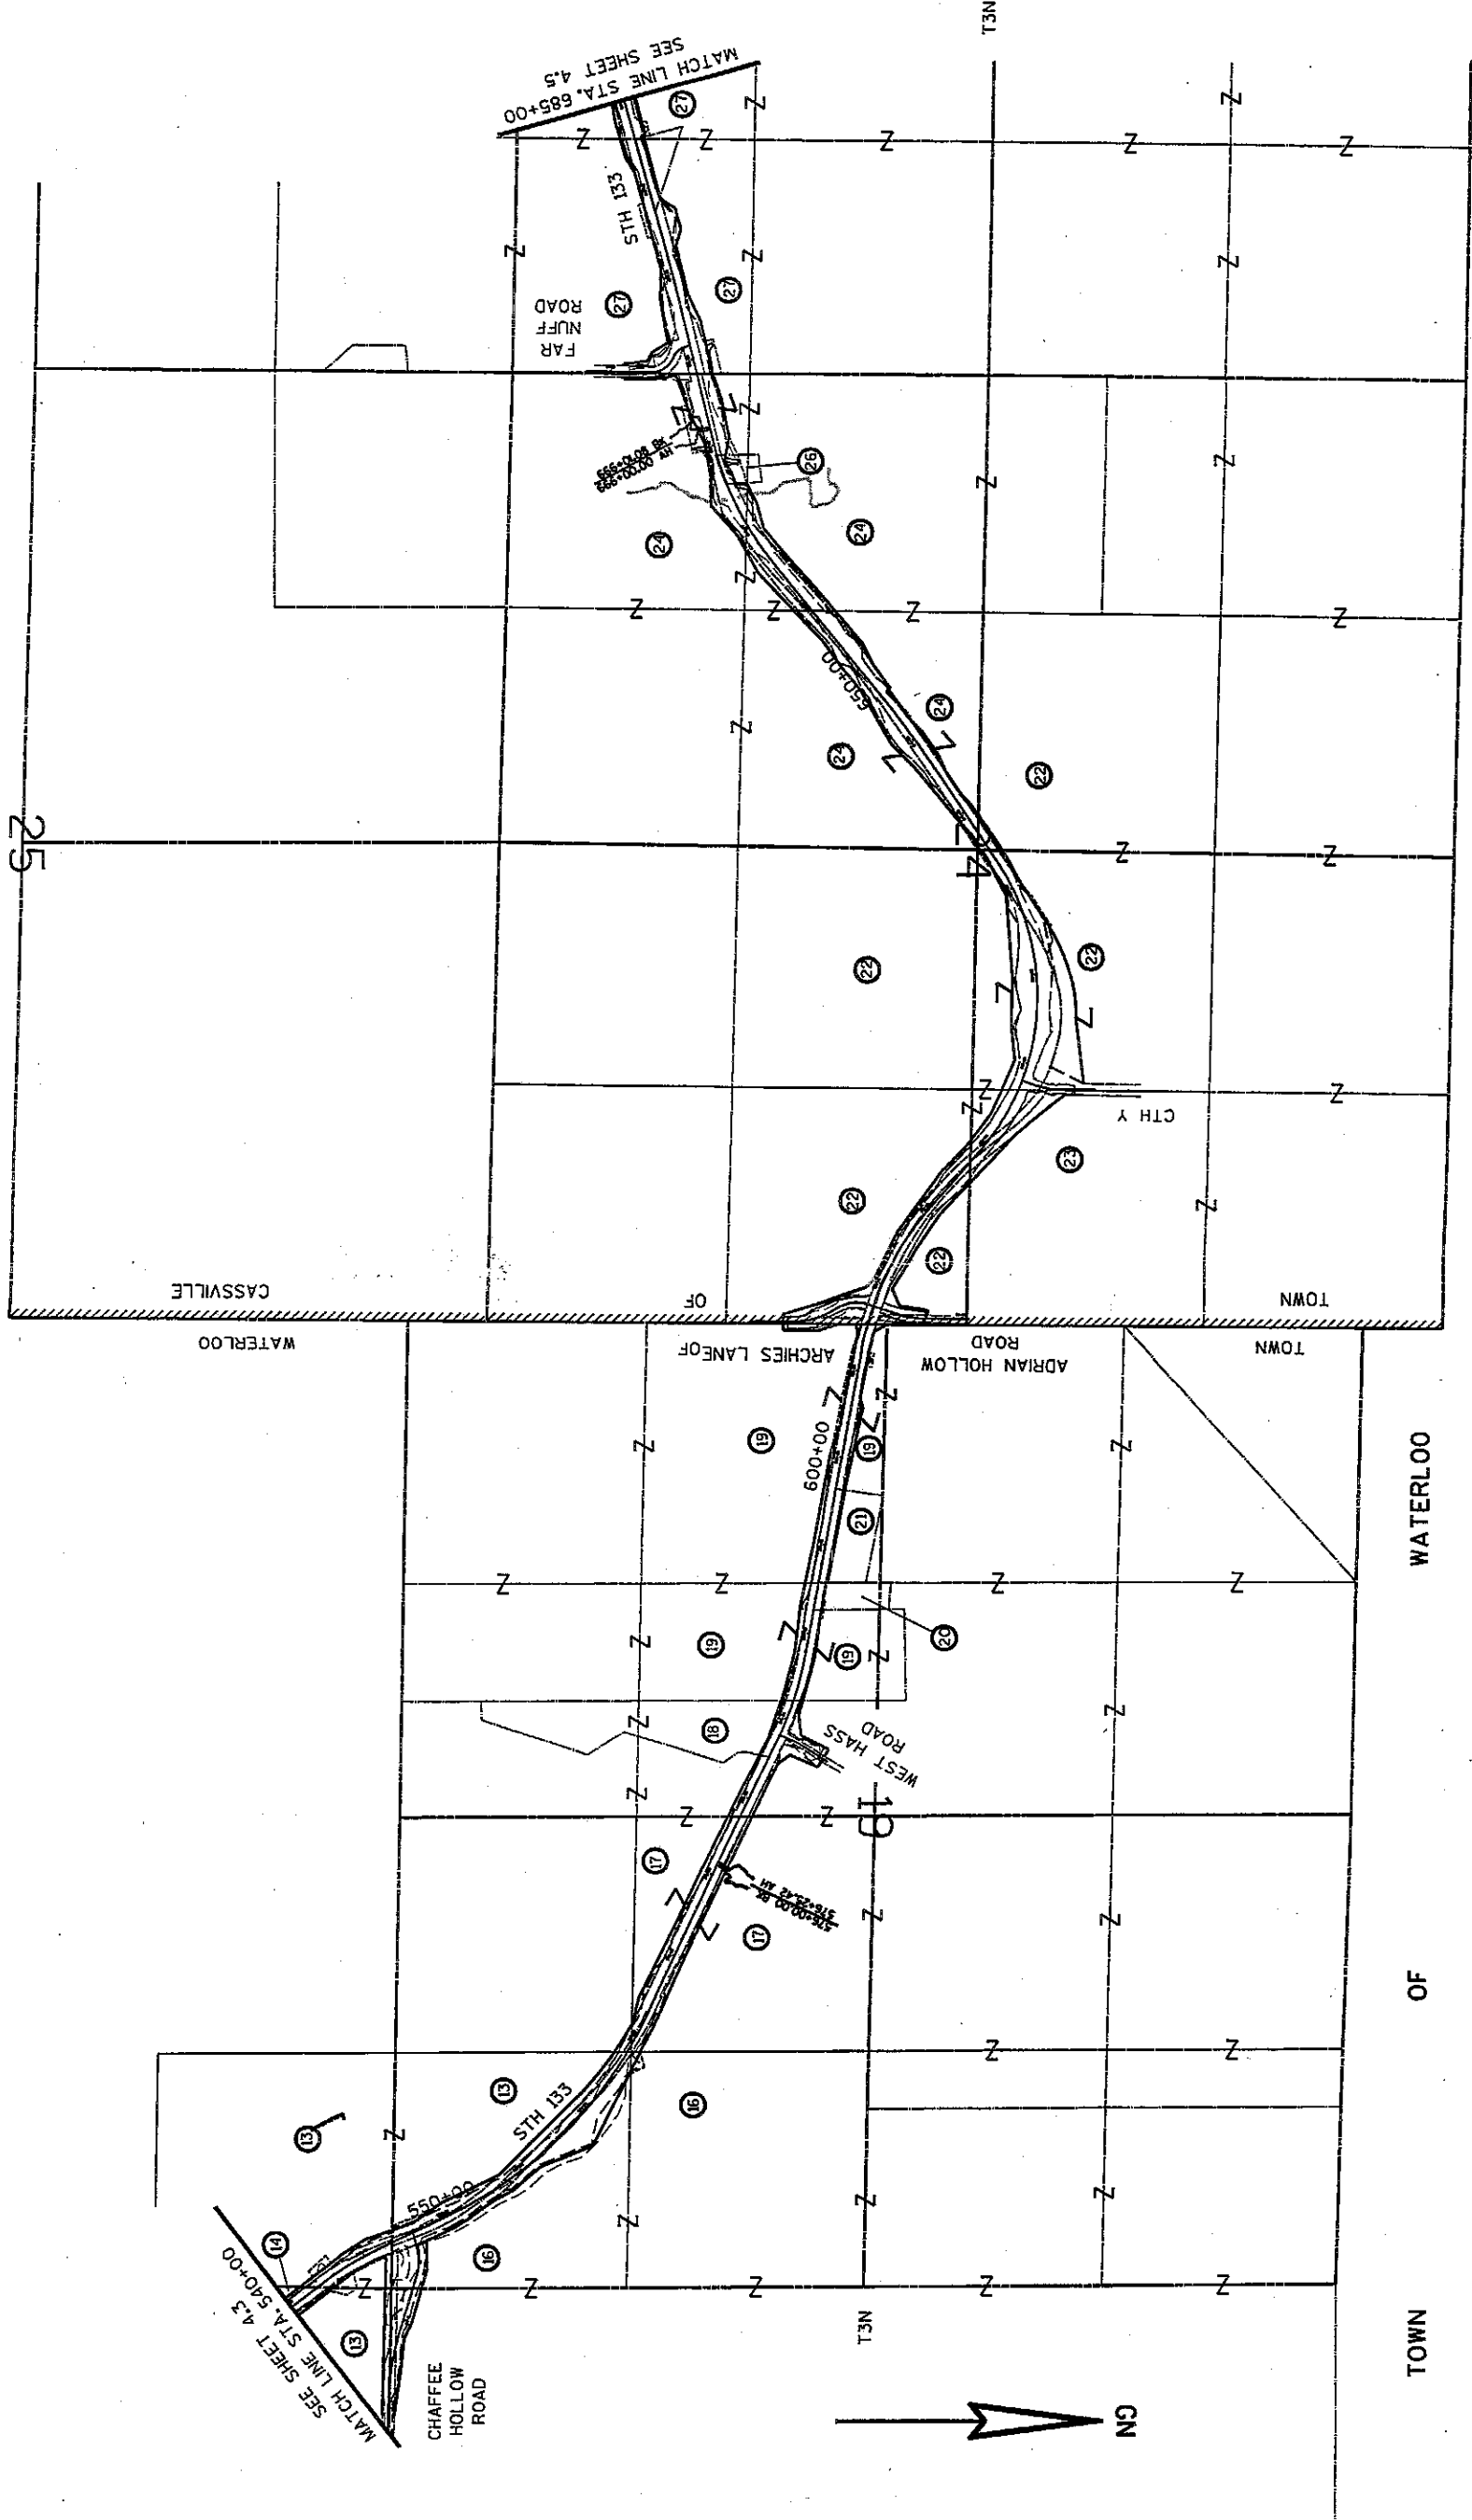

REVISION DATE NOV. 11, 2005	DATE AUG. 27, 2004	NOT TO SCALE	HWY: STH 133	STATE R/W PROJECT NUMBER 5205-03-23	PLAT SHEET NO: 4.4
			COUNTY: GRANT	CONSTRUCTION PROJECT NUMBER	PS&E SHEET
			PLOT NAME :		E
FILE NAME : g:\f0th\F2109941\W\A941r\w404.dgn			PLOT DATE : 10 NOV 2005	PLOT BY : KL Engineering	WISDOT/CADDs SHEET 70
			PLOT SCALE :		

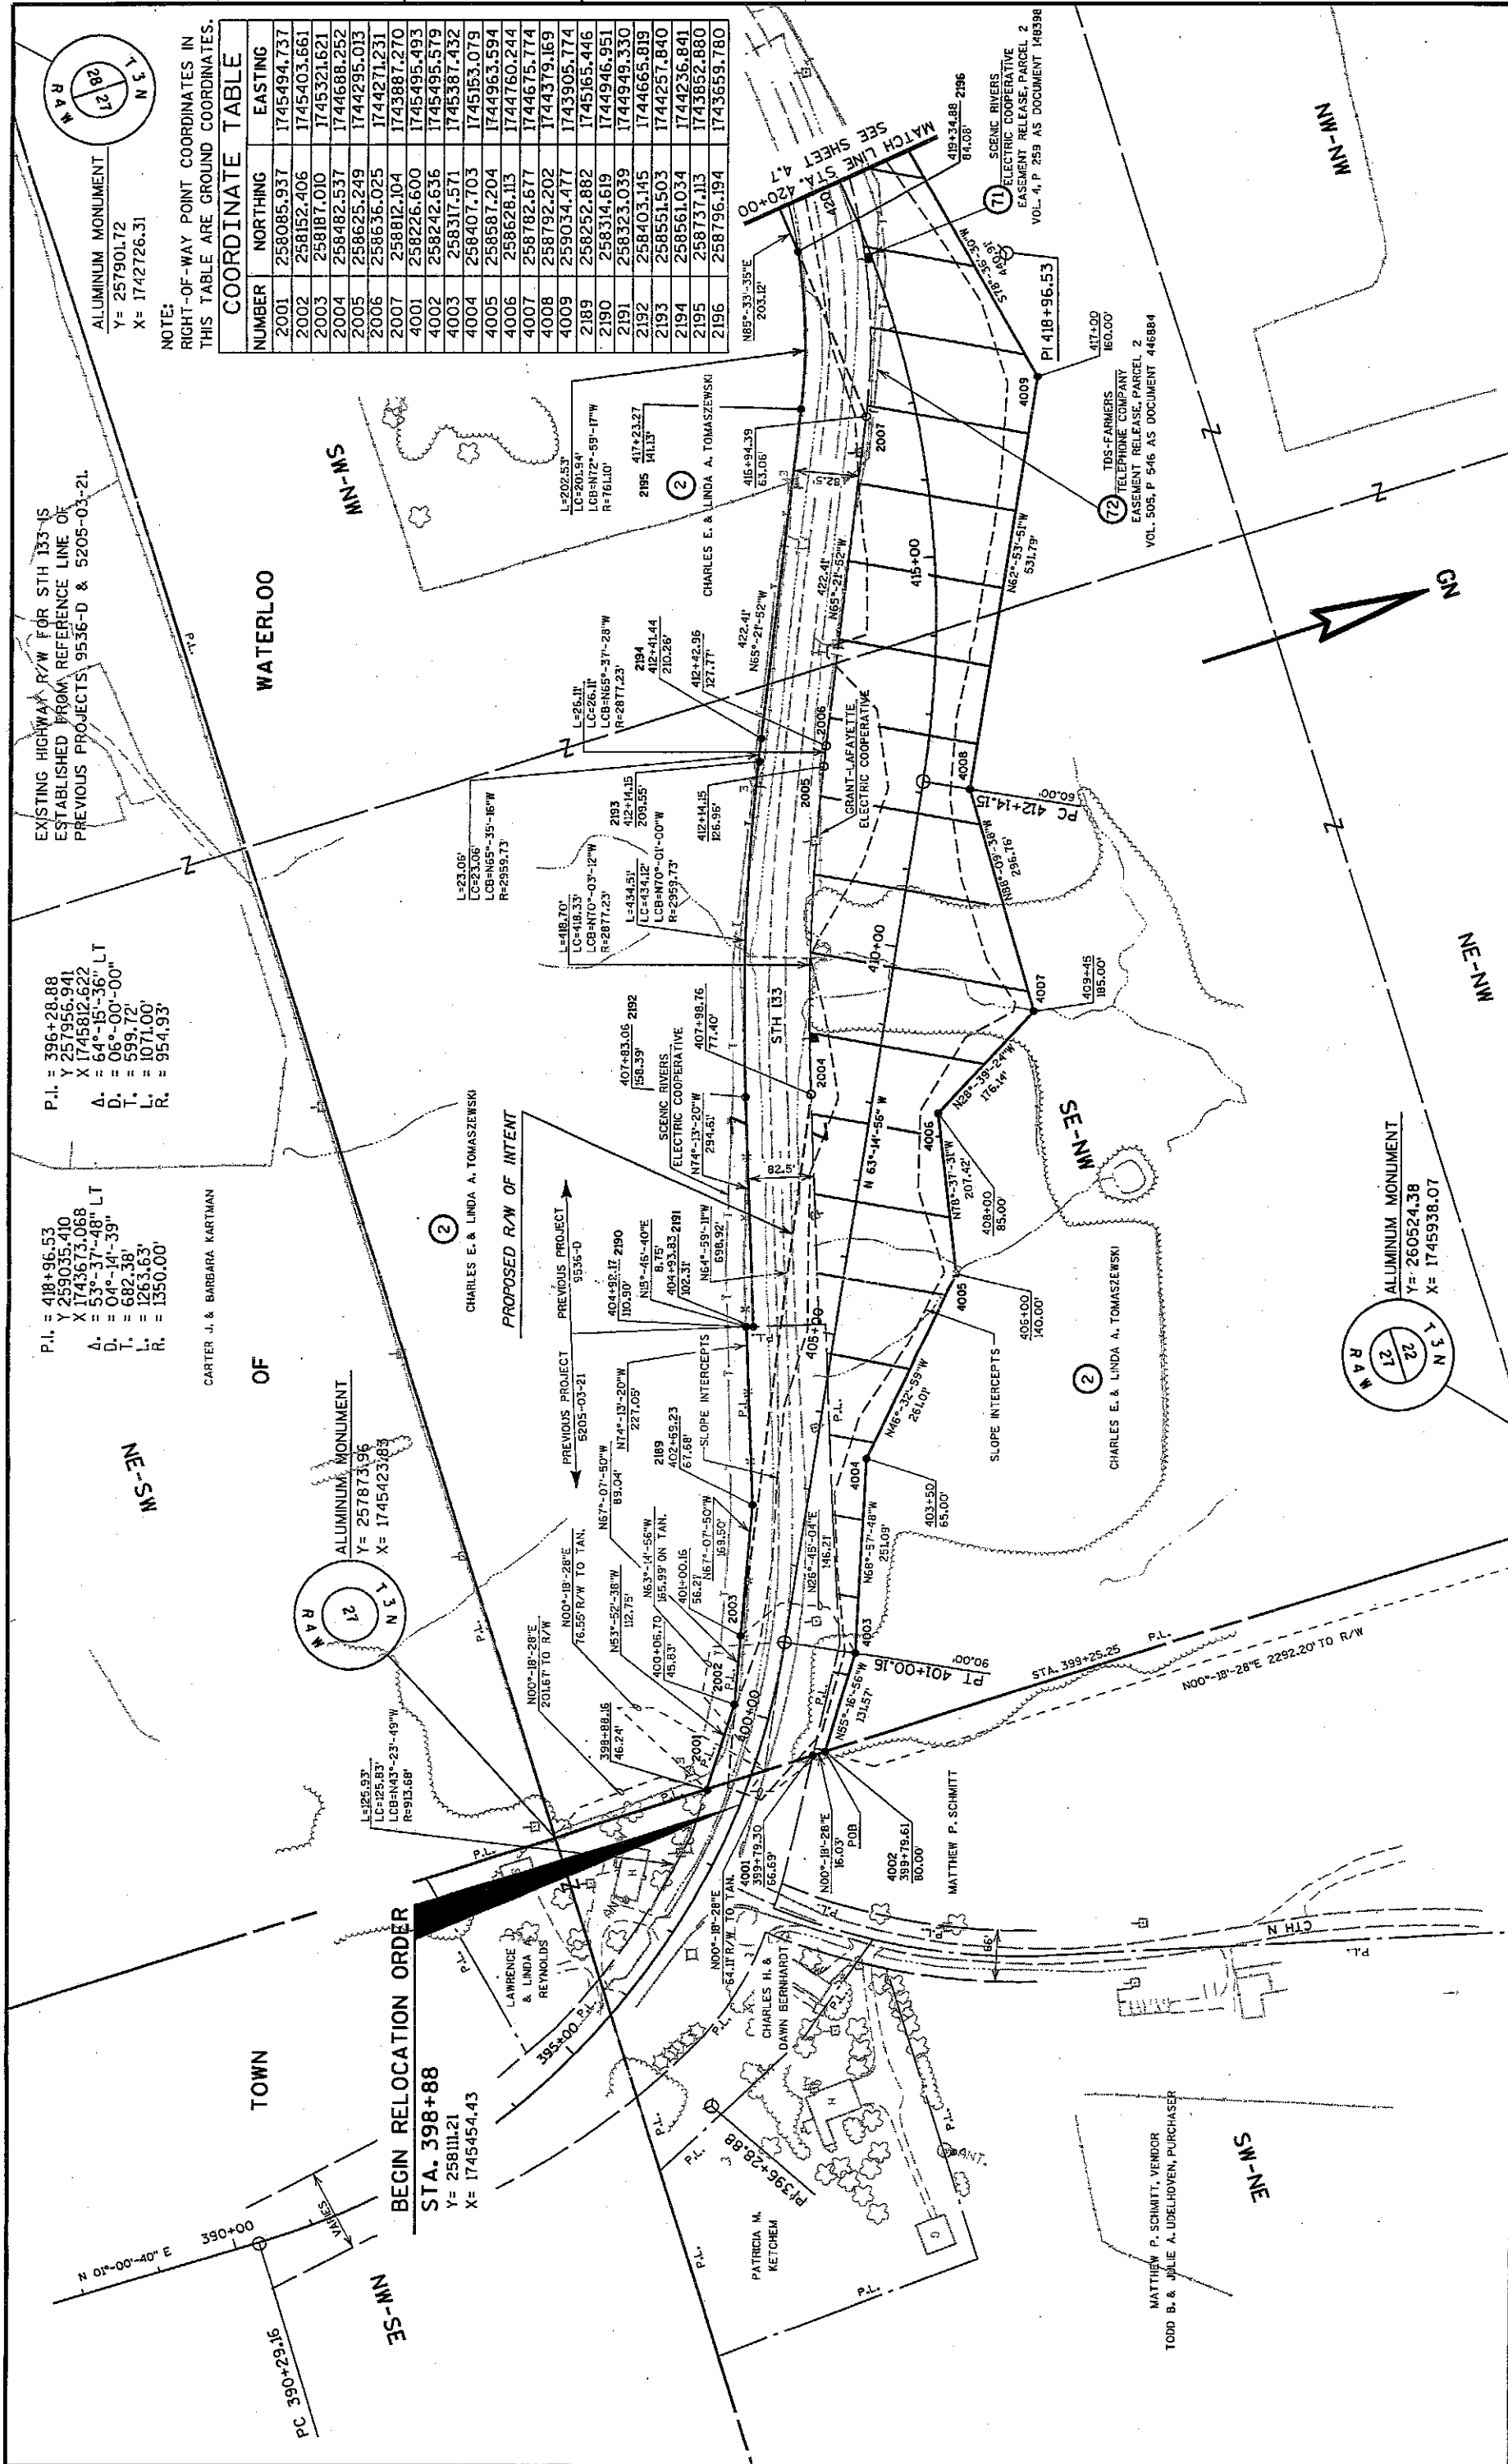

NOTE: RIGHT-OF-WAY POINT COORDINATES IN THIS TABLE ARE GROUND COORDINATES.

COORDINATE TABLE		
NUMBER	NORTHING	EASTING
2001	258085.937	1745494.737
2002	258152.406	1745403.661
2003	258187.010	1745321.621
2004	258482.537	1744688.252
2005	258625.249	1744295.013
2006	258636.025	1744271.231
2007	258812.104	1743887.270
4001	258226.600	1745495.493
4002	258242.636	1745495.579
4003	258317.571	1745387.432
4004	258407.703	1745153.079
4005	258587.204	1744963.594
4006	258628.113	1744760.244
4007	258782.677	1744675.774
4008	258792.202	1744379.169
4009	259034.477	1743905.774
2189	258252.882	1745165.446
2190	258314.619	1744946.951
2191	258323.039	1744949.330
2192	258403.145	1744665.819
2193	258551.503	1744257.840
2194	258561.034	1744236.841
2195	258737.113	1743852.880
2196	258796.194	1743659.780

P.I. = 396+28.88
Y = 257901.72
X = 1742726.31
A. = 64°-15'-36" LT
D. = 06°-00'-00" LT
T. = 599.72
L. = 1071.00
R. = 954.93

P.I. = 418+96.53
Y = 257901.72
X = 1742726.31
A. = 64°-15'-36" LT
D. = 06°-00'-00" LT
T. = 599.72
L. = 1071.00
R. = 954.93

CARTER J. & BARBARA KARTMAN

OF

ALUMINUM MONUMENT
Y = 257873.96
X = 1745423.83

BEGIN RELOCATION ORDER
STA. 398+88
Y = 258111.21
X = 1745454.43

PROPOSED R/W OF INTENT

PREVIOUS PROJECT

PREVIOUS PROJECT

REVISION DATE NOV. 11, 2005	DATE AUG. 27, 2004	SCALE, FEET 0 100 200	HWY: STH 133	STATE R/W PROJECT NUMBER 5205-03-23	PLAT SHEET NO: 4.6
GRID FACTOR 0.99996			COUNTY: GRANT	CONSTRUCTION PROJECT NUMBER	PS&E SHEET
FILE NAME : g:\work\109941\w941r\w405.dgn			PLOT DATE : 10 NOV 2005		
PLOT BY : KL Engineering			PLOT SCALE :		
WISDOT/CADDs SHEET 75			E		

EXISTING HIGHWAY R/W FOR STH 133 IS ESTABLISHED FROM
REFERENCE LINE OF PREVIOUS PROJECT 9536-D.

NOTE:
RIGHT-OF-WAY POINT COORDINATES IN
THIS TABLE ARE GROUND COORDINATES.

COORDINATE TABLE		
NUMBER	NORTHING	EASTING
2008	258780.468	1743457.272
2009	258735.843	1743251.112
2010	258699.354	1743153.376
2011	258641.866	1743045.487
2012	258577.991	1742948.612
2013	258504.148	1742893.402
2014	258346.450	1742873.558
2015	258347.887	1742807.574
2016	258438.263	1742715.229
2017	258381.230	1742552.627
2018	258272.056	1742198.161
2019	258299.011	1741880.449
2020	258362.197	1741625.202
2021	258420.113	1741467.178
2022	258585.269	1741113.380
2023	258763.525	1740755.156
4010	258947.391	1743473.550
4011	258805.540	1743110.004
4012	258778.299	1743113.362
4013	258655.184	1742650.897
4014	258469.491	1742419.038
4015	258433.074	1742136.232
4016	258463.691	1741807.340
4017	258552.156	1741528.817
4018	258932.971	1741008.291

WATERLOO

3S-MN

3S-EN

OF

ALUMINUM MONUMENT
Y = 257901.72
X = 1742776.31

TOWN

CARTER, A. & BARBARA KARTMAN

P.L.

MS-MN

3S-EN

OF

ALUMINUM MONUMENT
Y = 257901.72
X = 1742776.31

TOWN

CARTER, A. & BARBARA KARTMAN

P.L.

MS-MN

3S-EN

OF

ALUMINUM MONUMENT
Y = 257901.72
X = 1742776.31

TOWN

CARTER, A. & BARBARA KARTMAN

P.L.

MS-MN

3S-EN

OF

ALUMINUM MONUMENT
Y = 257901.72
X = 1742776.31

TOWN

CARTER, A. & BARBARA KARTMAN

P.L.

NOTE:
RIGHT-OF-WAY POINT COORDINATES IN
THIS TABLE ARE GROUND COORDINATES.

COORDINATE TABLE	
NUMBER	EASTING
2034	259069.347
2035	259004.917
2036	258911.432
2037	258872.396
2038	258823.156
2039	258796.281
2040	258742.587
2041	258698.052
2042	258788.142
2043	258864.986
4032	259187.948
4033	259059.978
4034	258936.501
4035	258960.253
4036	258887.691
4037	258911.248
4038	258861.727
4039	258932.472
4040	258890.421

82 62

12 02

N 4 R

N 4 R

1" IRON BAR

Y = 257962.76

X = 1737562.91

P.I. = 485+36.91

Y 258957.706

X 1737482.166

A. = 25°-14'-12" RT

D. = 04°-14'-39"

T. = 302.22'

L. = 594.63'

R. = 1350.00'

P.I. = 501+90.89

Y 258758.983

X 1735830.985

A. = 23°-00'-39" RT


D. = 04°-14'-39"

T. = 274.80'

L. = 542.17'

R. = 1350.00'

WATERLOO

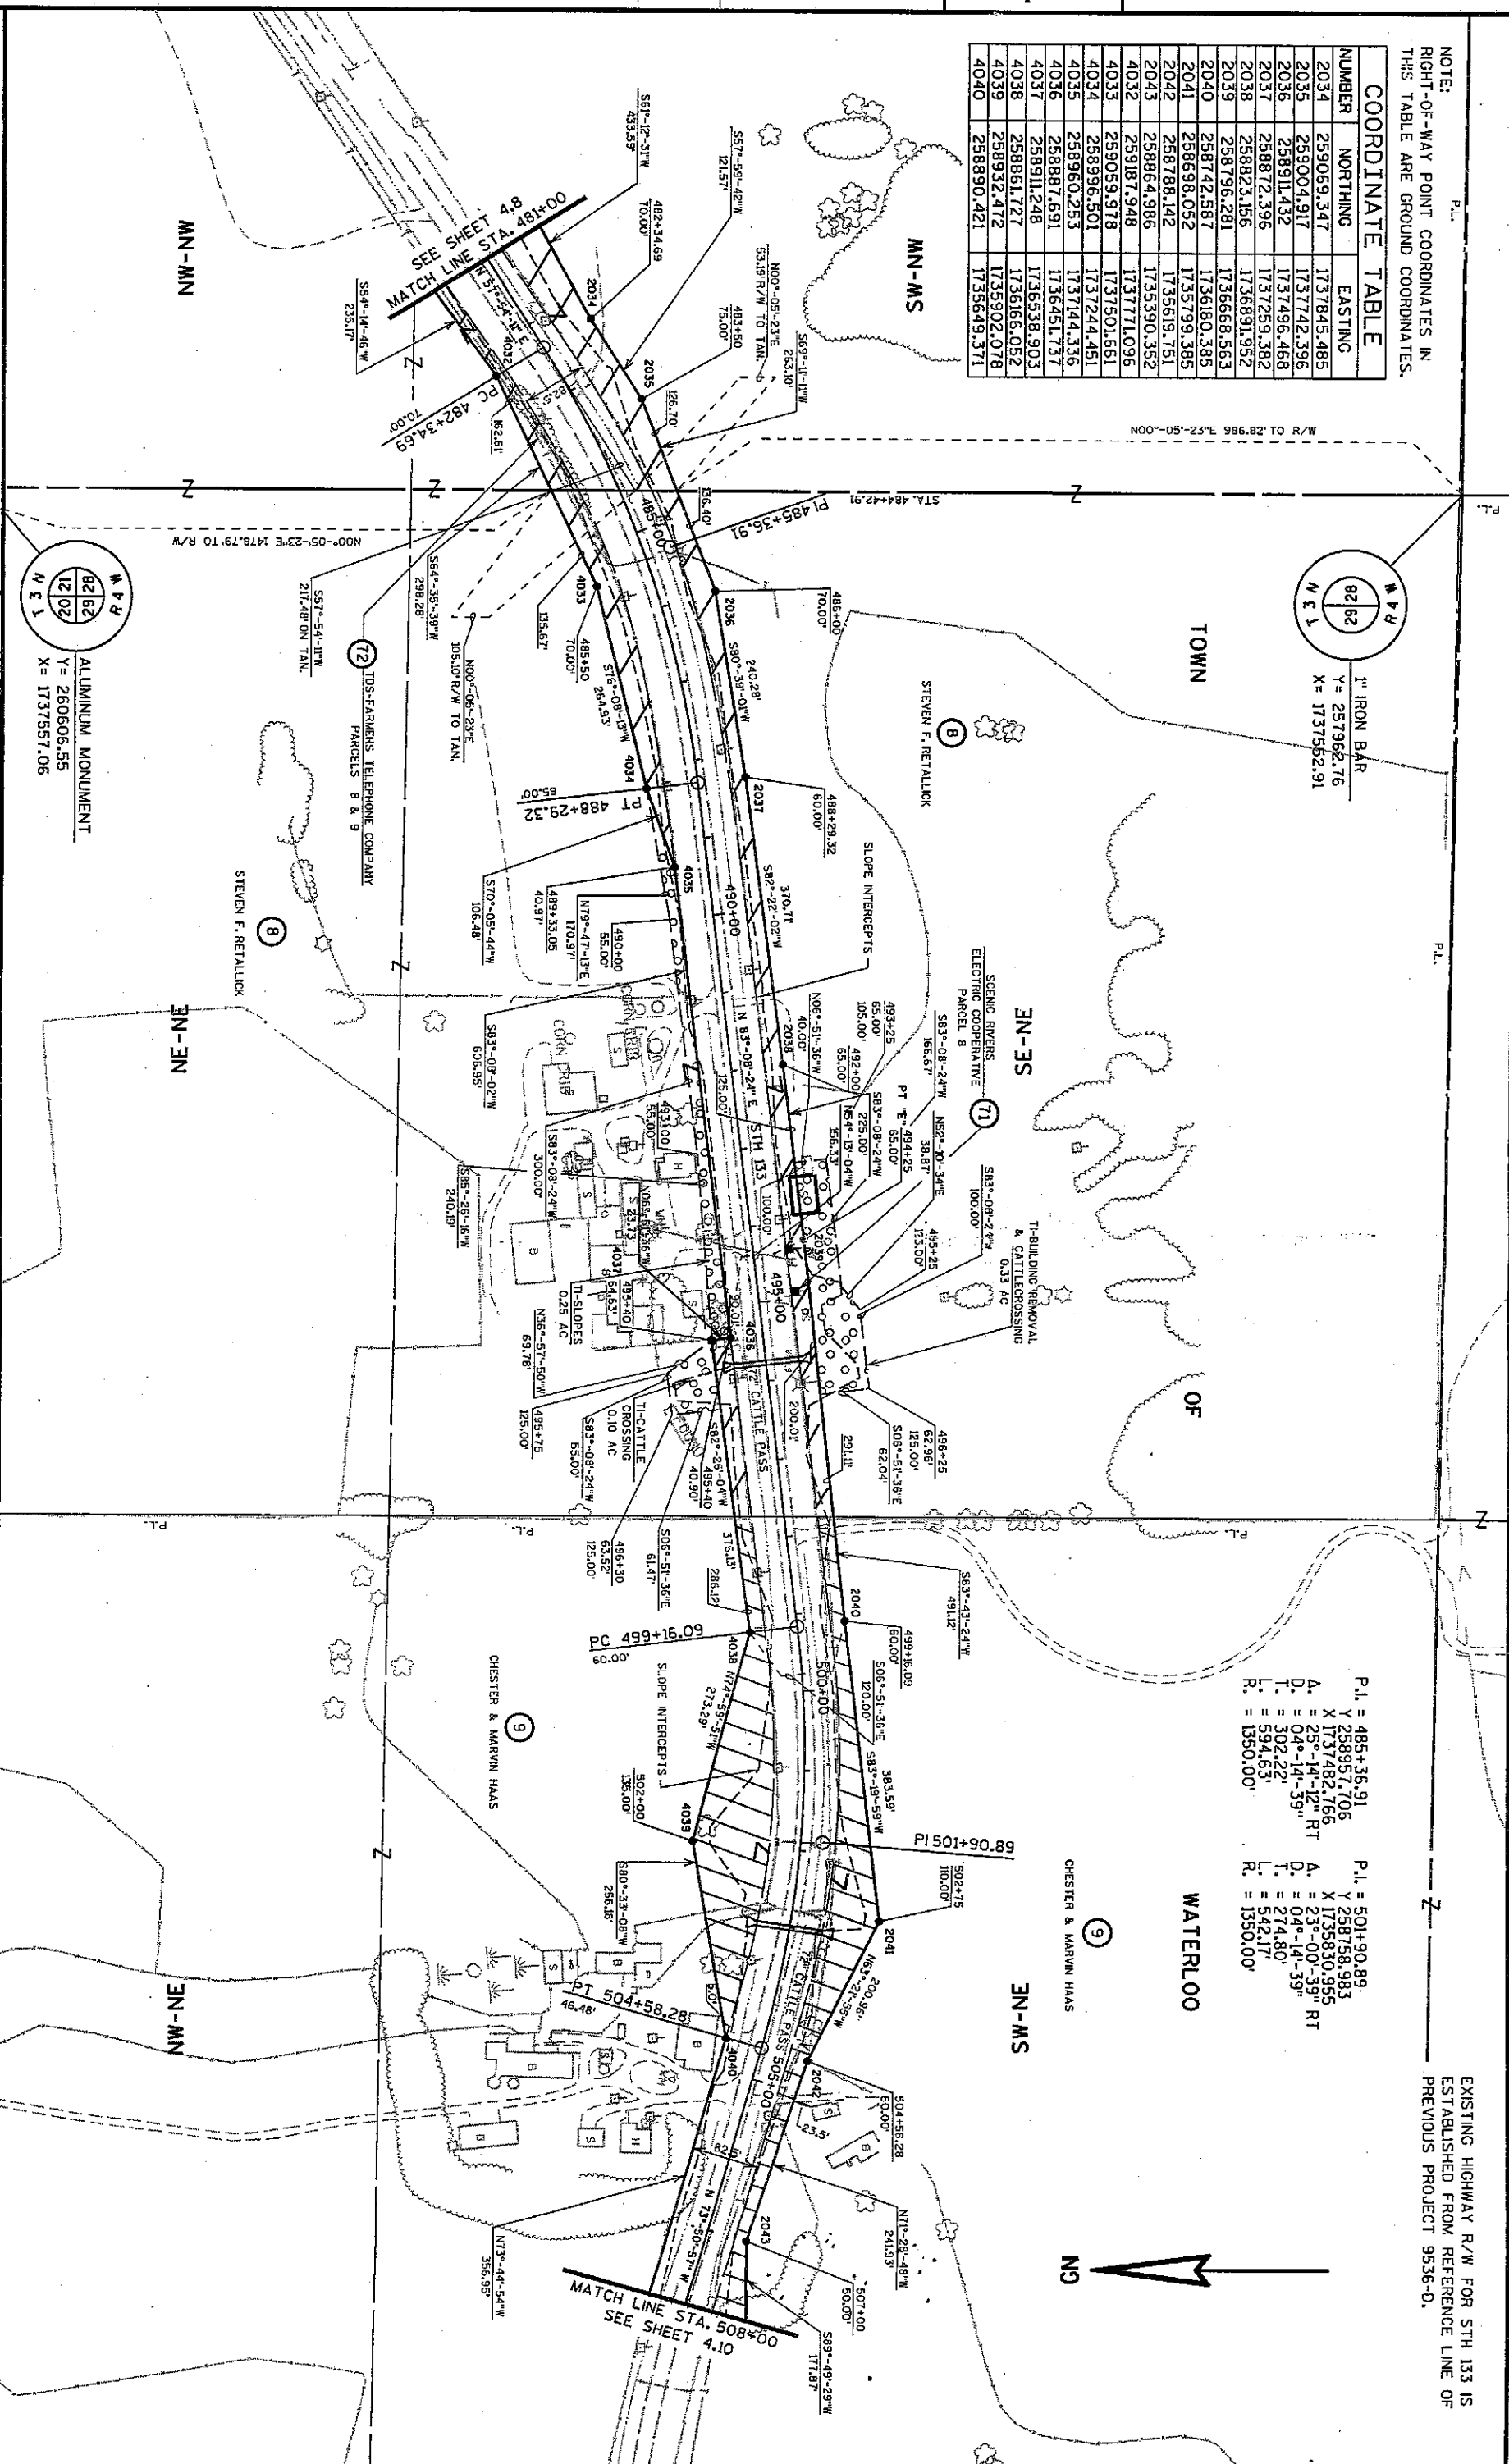

REVISION DATE
NOV. 11, 2005

DATE AUG. 27, 2004

GRID FACTOR 0.99996

SCALE, FEET
0 100 200

HWY: STH 133

COUNTY: GRANT

STATE R/W PROJECT NUMBER 5205-03-23

CONSTRUCTION PROJECT NUMBER

PLAT SHEET NO: 4.9

PS&E SHEET

E

FILE NAME : g:\north\109941\w\941r\w409.dgn

PLOT DATE : 10 NOV 2005

PLOT BY : KL Engineering

PLOT NAME :


PLOT SCALE :

WISDOT/CADDs SHEET 75


EXISTING HIGHWAY R/W FOR STH 133 IS ESTABLISHED FROM REFERENCE LINE OF PREVIOUS PROJECT 9536-D.

NOTE:
RIGHT-OF-WAY POINT COORDINATES IN THIS TABLE ARE GROUND COORDINATES.

COORDINATE TABLE		
NUMBER	NORTHING	EASTING
2044	258854.442	1735212.483
2045	258962.224	1734928.296
2046	258972.718	1734713.804
2047	258985.365	1734557.616
2048	259006.718	1734307.584
2049	259042.304	1734183.243
2050	259089.852	1733962.980
2051	259083.770	1733857.206
2052	259208.902	1733438.919
2053	259314.892	1733281.231
2054	259610.968	1732840.257
2055	259734.181	1732703.793
4041	258990.316	1735306.684
4042	259027.733	1735259.771
4043	259072.092	1734933.671
4044	259067.604	1734718.446
4045	259090.239	1734562.746
4046	259123.923	1734307.378
4047	259149.112	1734213.866
4048	259347.176	173478.568
4049	259486.055	1733213.202
4050	259632.350	1732966.751
4051	259819.040	1732815.147

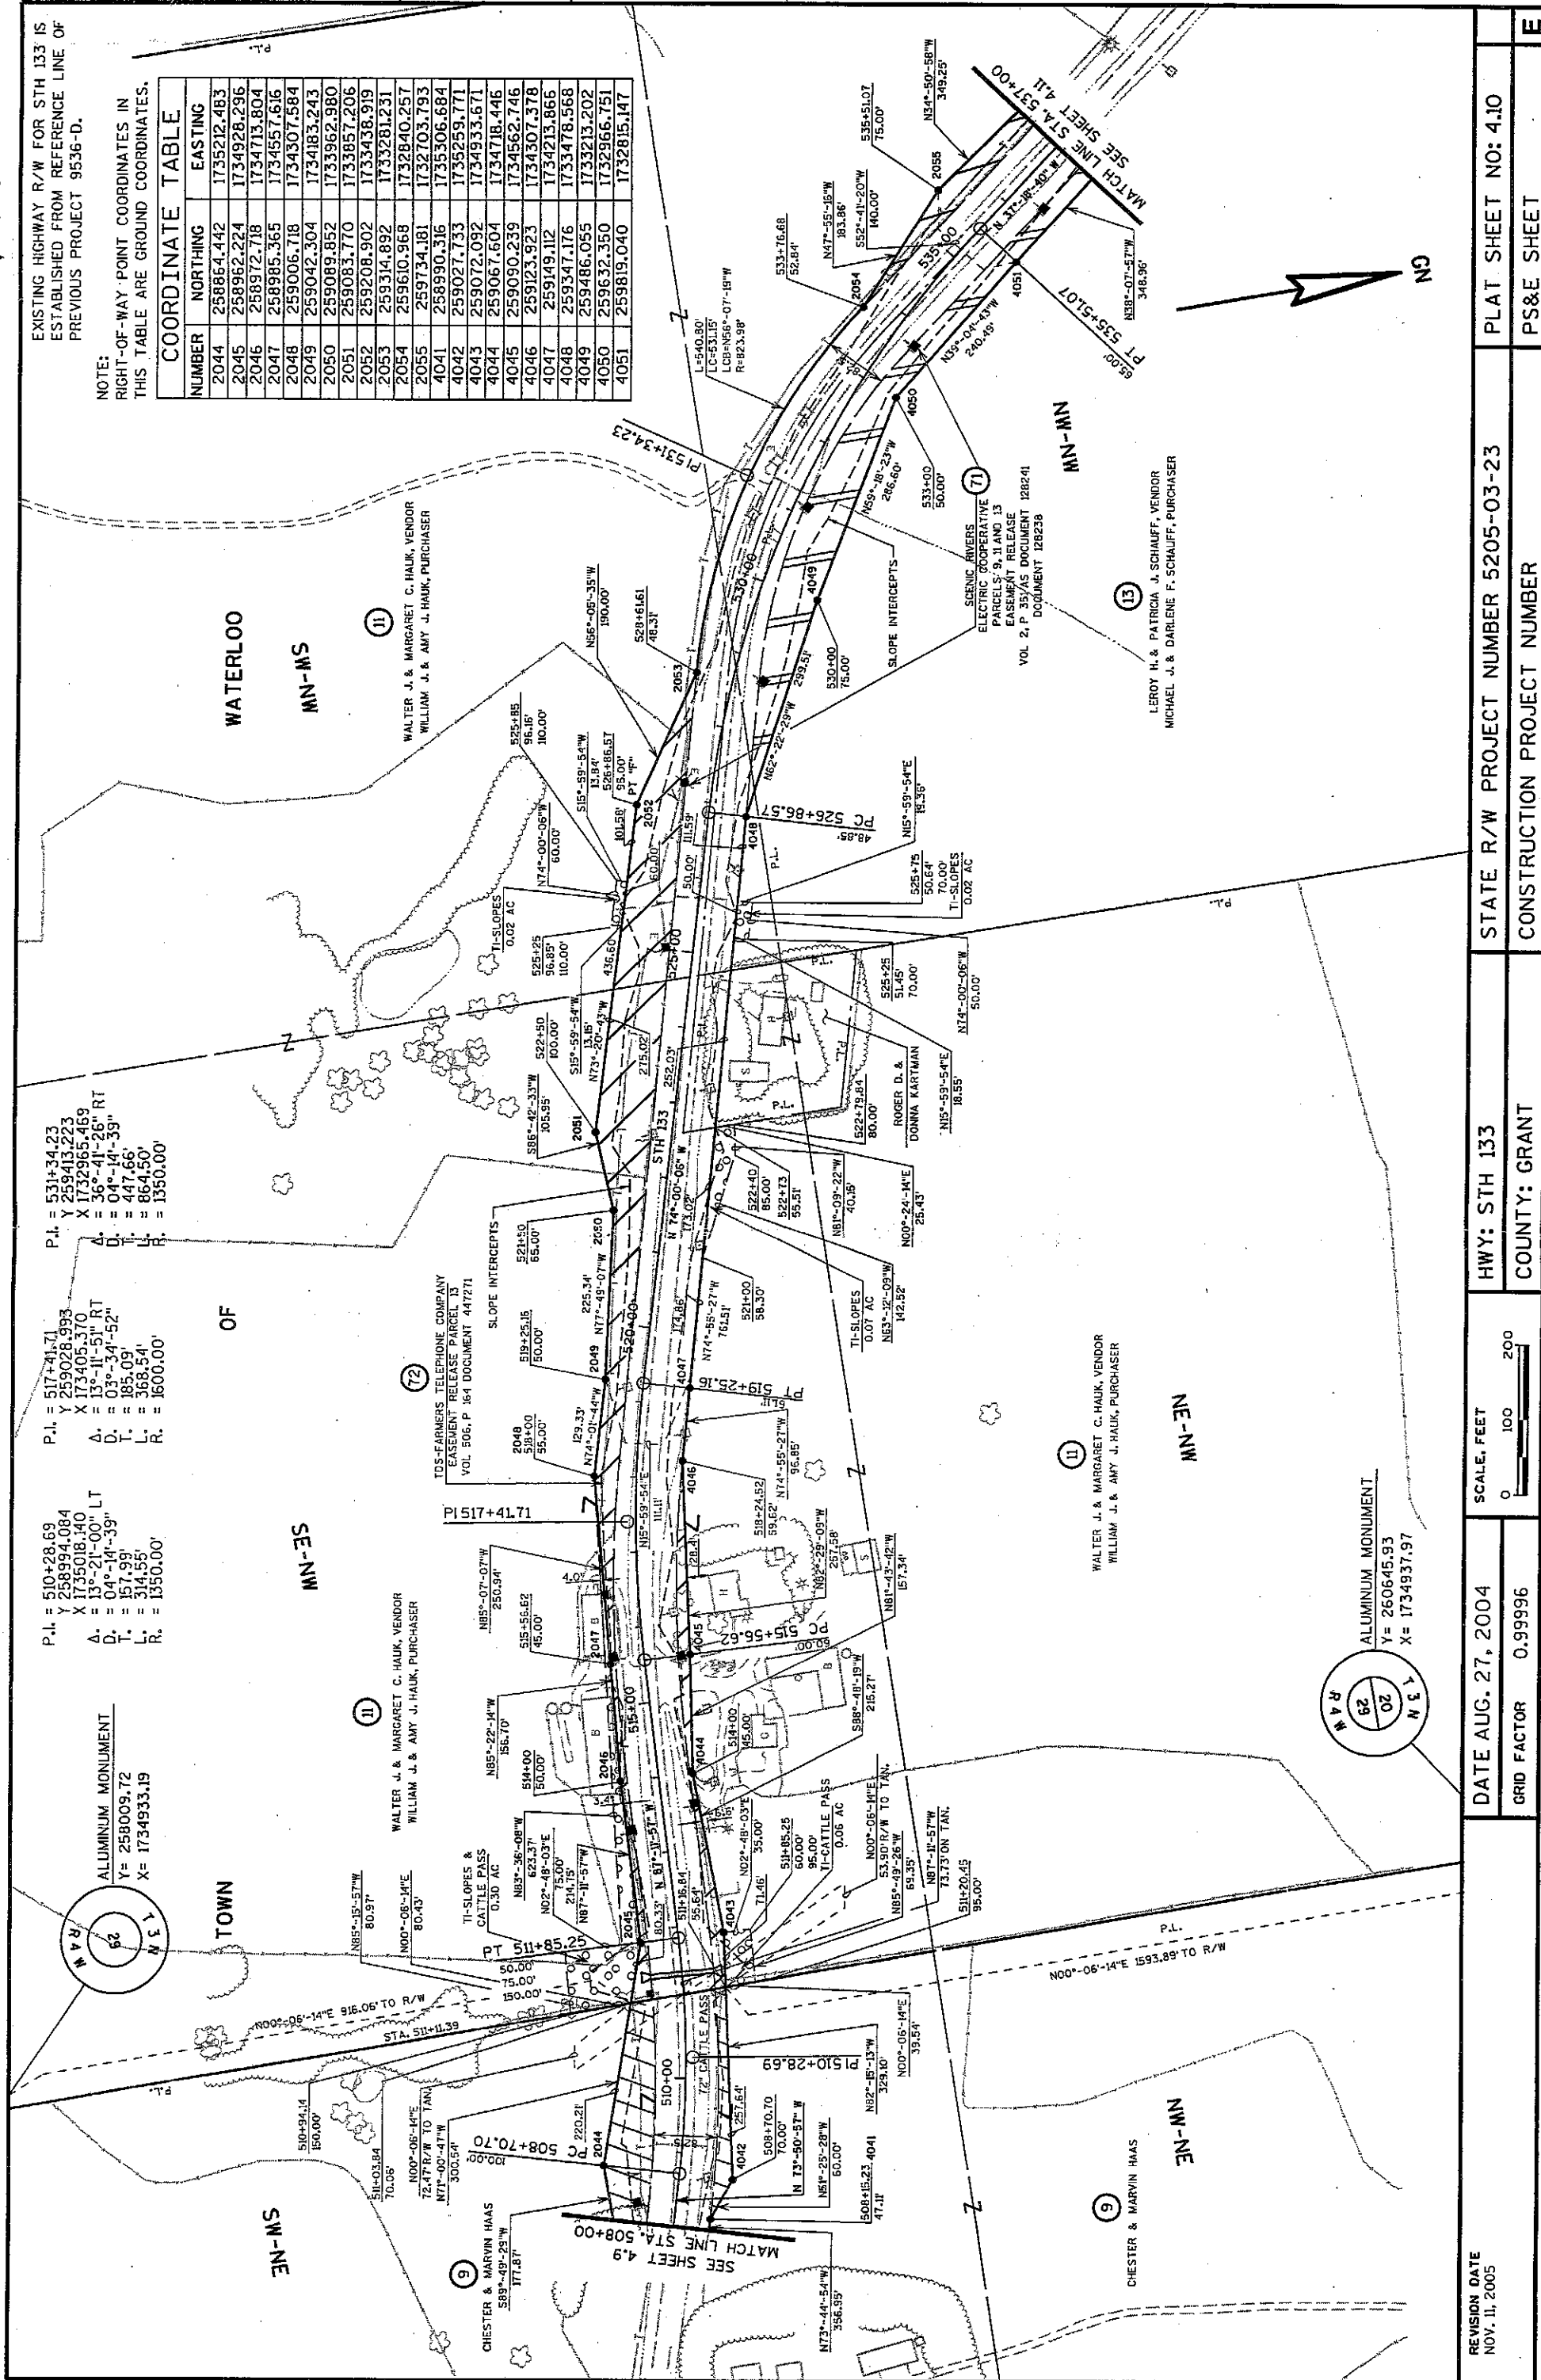

REVISION DATE NOV. 11, 2005	DATE AUG. 27, 2004	SCALE, FEET 0 100 200	HWY: STH 133	STATE R/W PROJECT NUMBER 5205-03-23	PLAT SHEET NO: 4.10
GRID FACTOR 0.99996			COUNTY: GRANT	CONSTRUCTION PROJECT NUMBER	PS&E SHEET
FILE NAME : g:\vto\hwy\109941\w\941r\w410.dgn			PLOT DATE : 10 NOV 2005	PLOT BY : KL Engineer-Ing	PLOT SCALE :
					WISDOT/CADDs SHEET 75

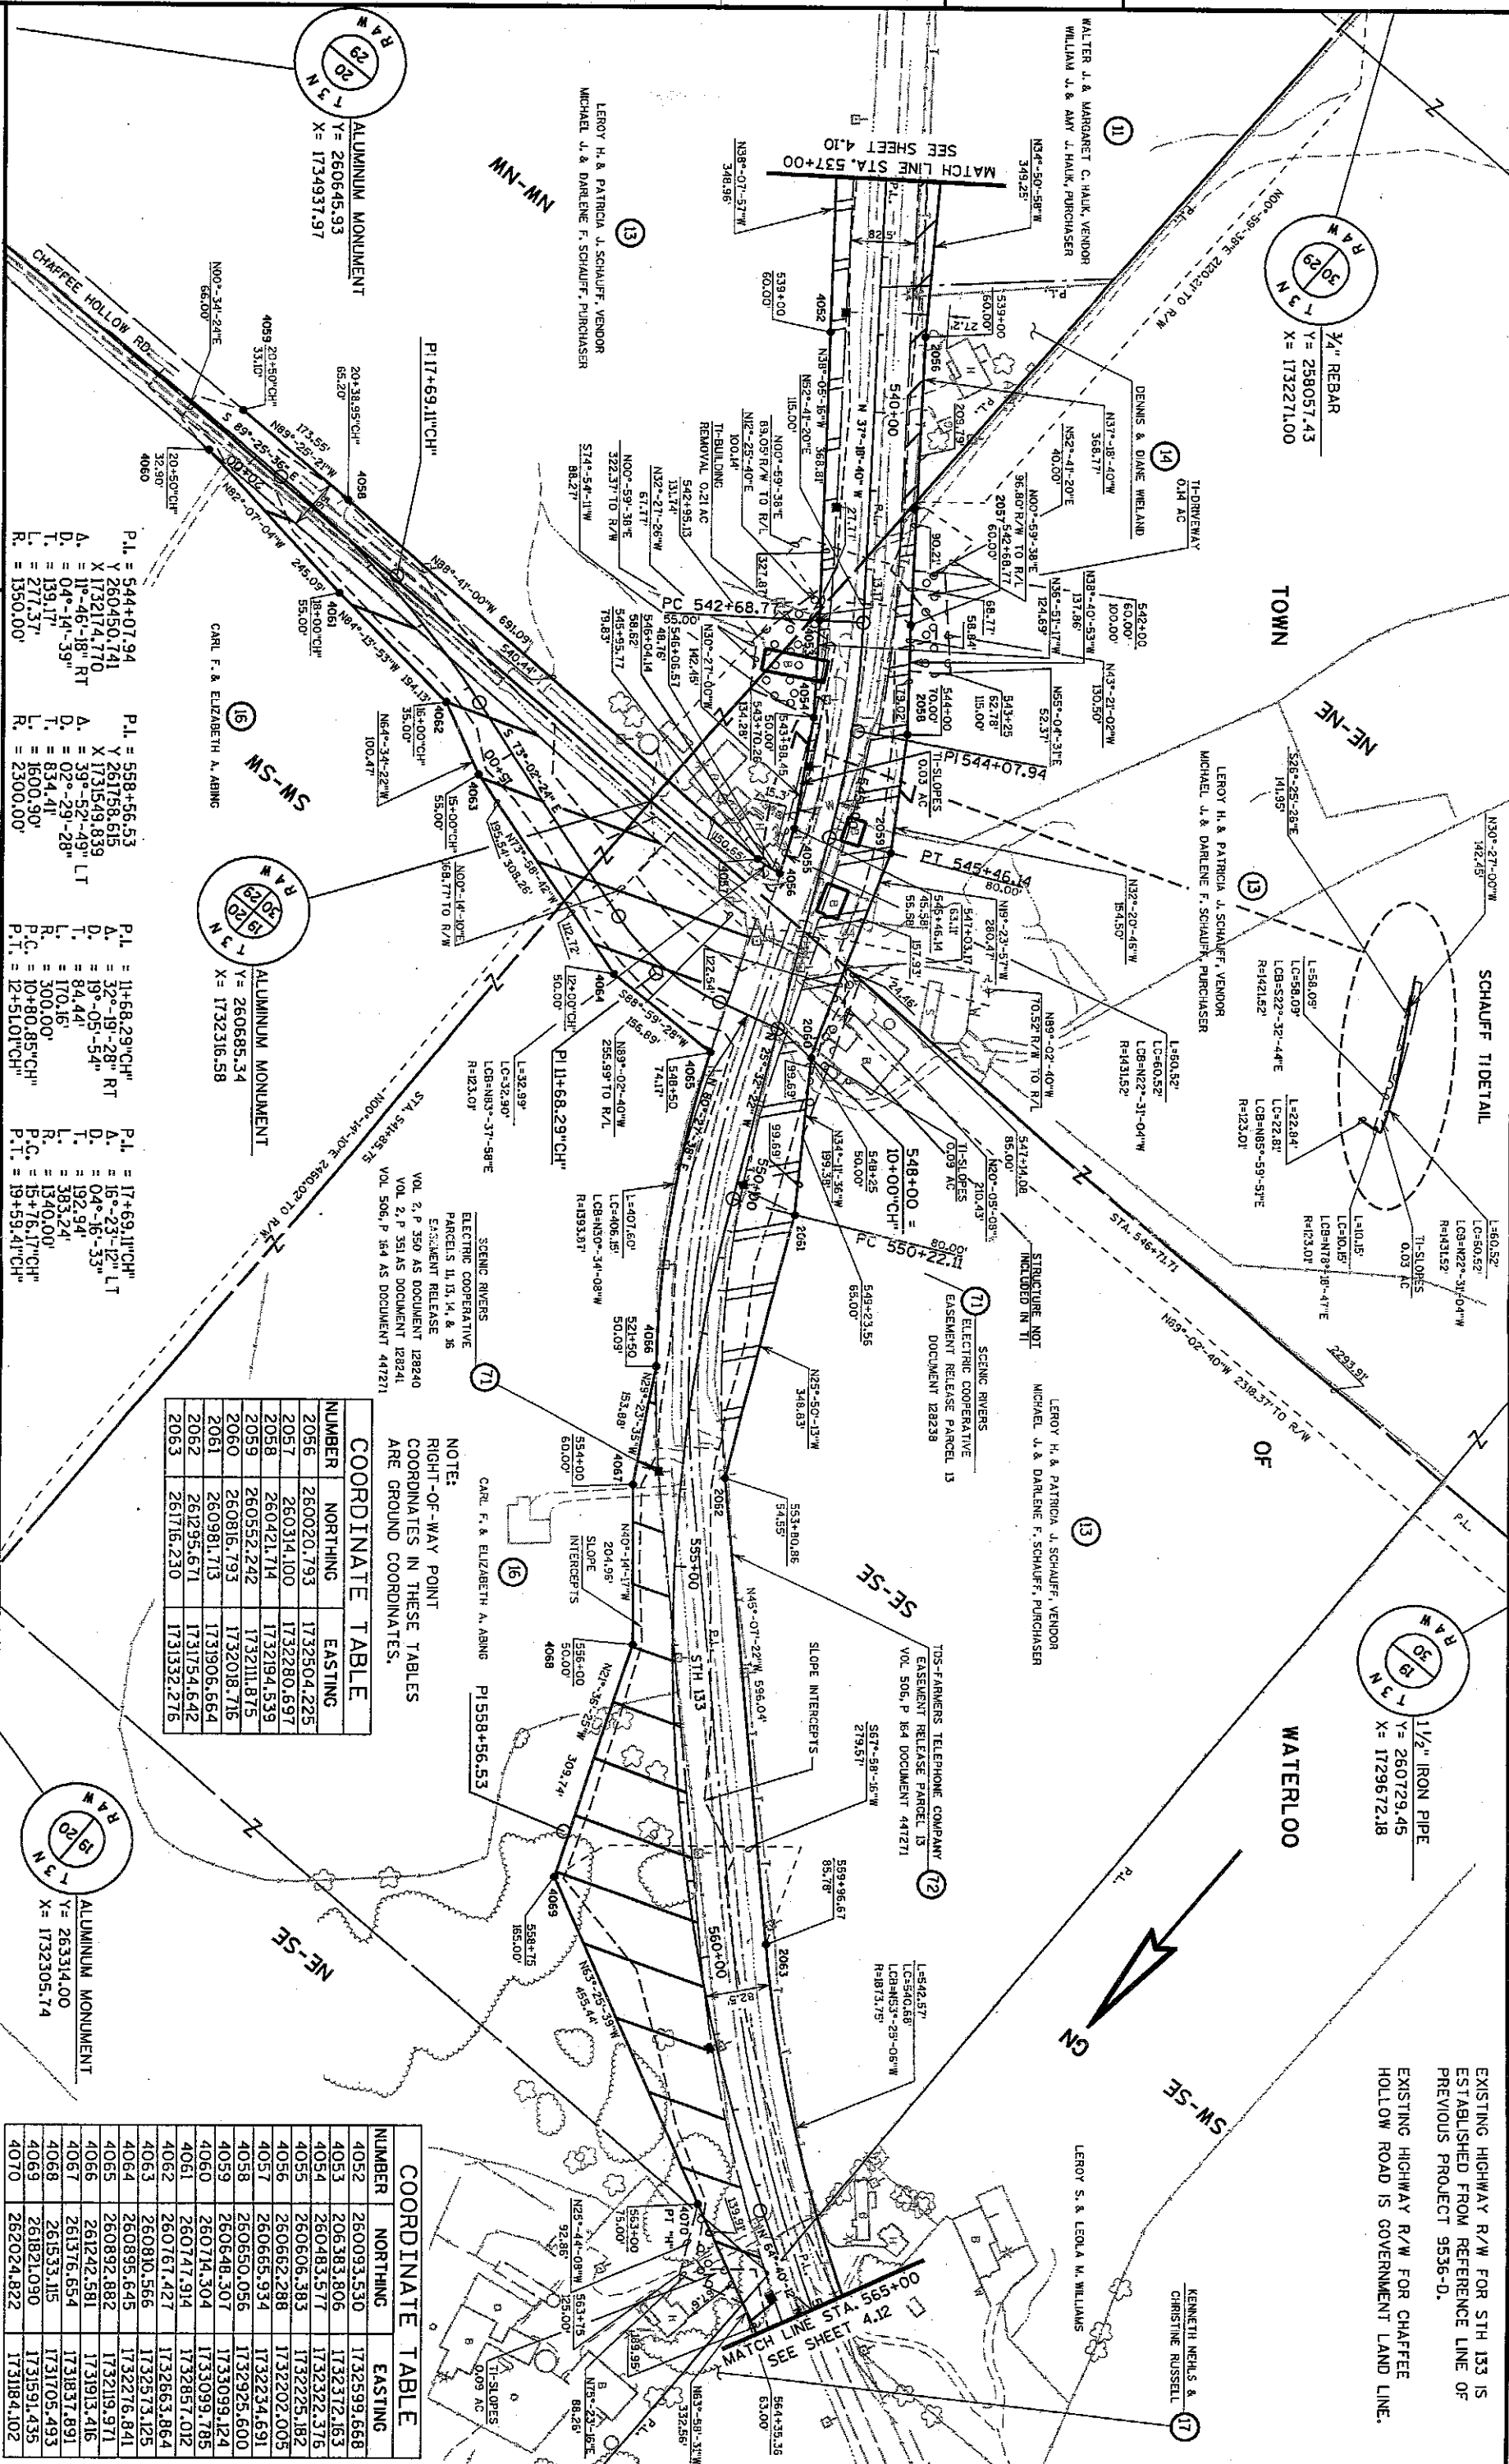

REVISION DATE
NOV. 11, 2005

DATE AUG. 27, 2004

GRID FACTOR 0.99996

SCALE, FEET
0 100 200

HWY: STH 133

COUNTY: GRANT

STATE R/W PROJECT NUMBER 5205-03-23

CONSTRUCTION PROJECT NUMBER

PLAT SHEET NO: 4.11


PS&E SHEET

E

NOTE:
RIGHT-OF-WAY POINT
COORDINATES IN THESE TABLES
ARE GROUND COORDINATES.

NUMBER	NORTHING	EASTING
2056	260020.793	1732504.225
2057	260314.100	1732280.697
2058	260421.714	1732194.539
2059	260552.242	1732111.875
2060	260816.793	1732018.716
2061	260981.713	1731905.664
2062	261235.671	1731754.642
2063	261716.230	1731332.276

NUMBER	NORTHING	EASTING
4052	260093.530	1732599.668
4053	206383.806	1732312.163
4054	260483.577	1732322.376
4055	260606.383	1732225.182
4056	260652.288	1732202.005
4057	260665.934	1732234.691
4058	260650.056	1732925.600
4059	260648.307	1733099.124
4060	260714.304	1733099.785
4061	260747.914	1732857.012
4062	260767.427	1732663.864
4063	260810.566	1732573.125
4064	260895.645	1732276.841
4065	260892.882	1732119.971
4066	261242.581	1731913.416
4067	261376.654	1731837.891
4068	261533.115	1731705.493
4069	261821.090	1731591.435
4070	262024.822	173184.102

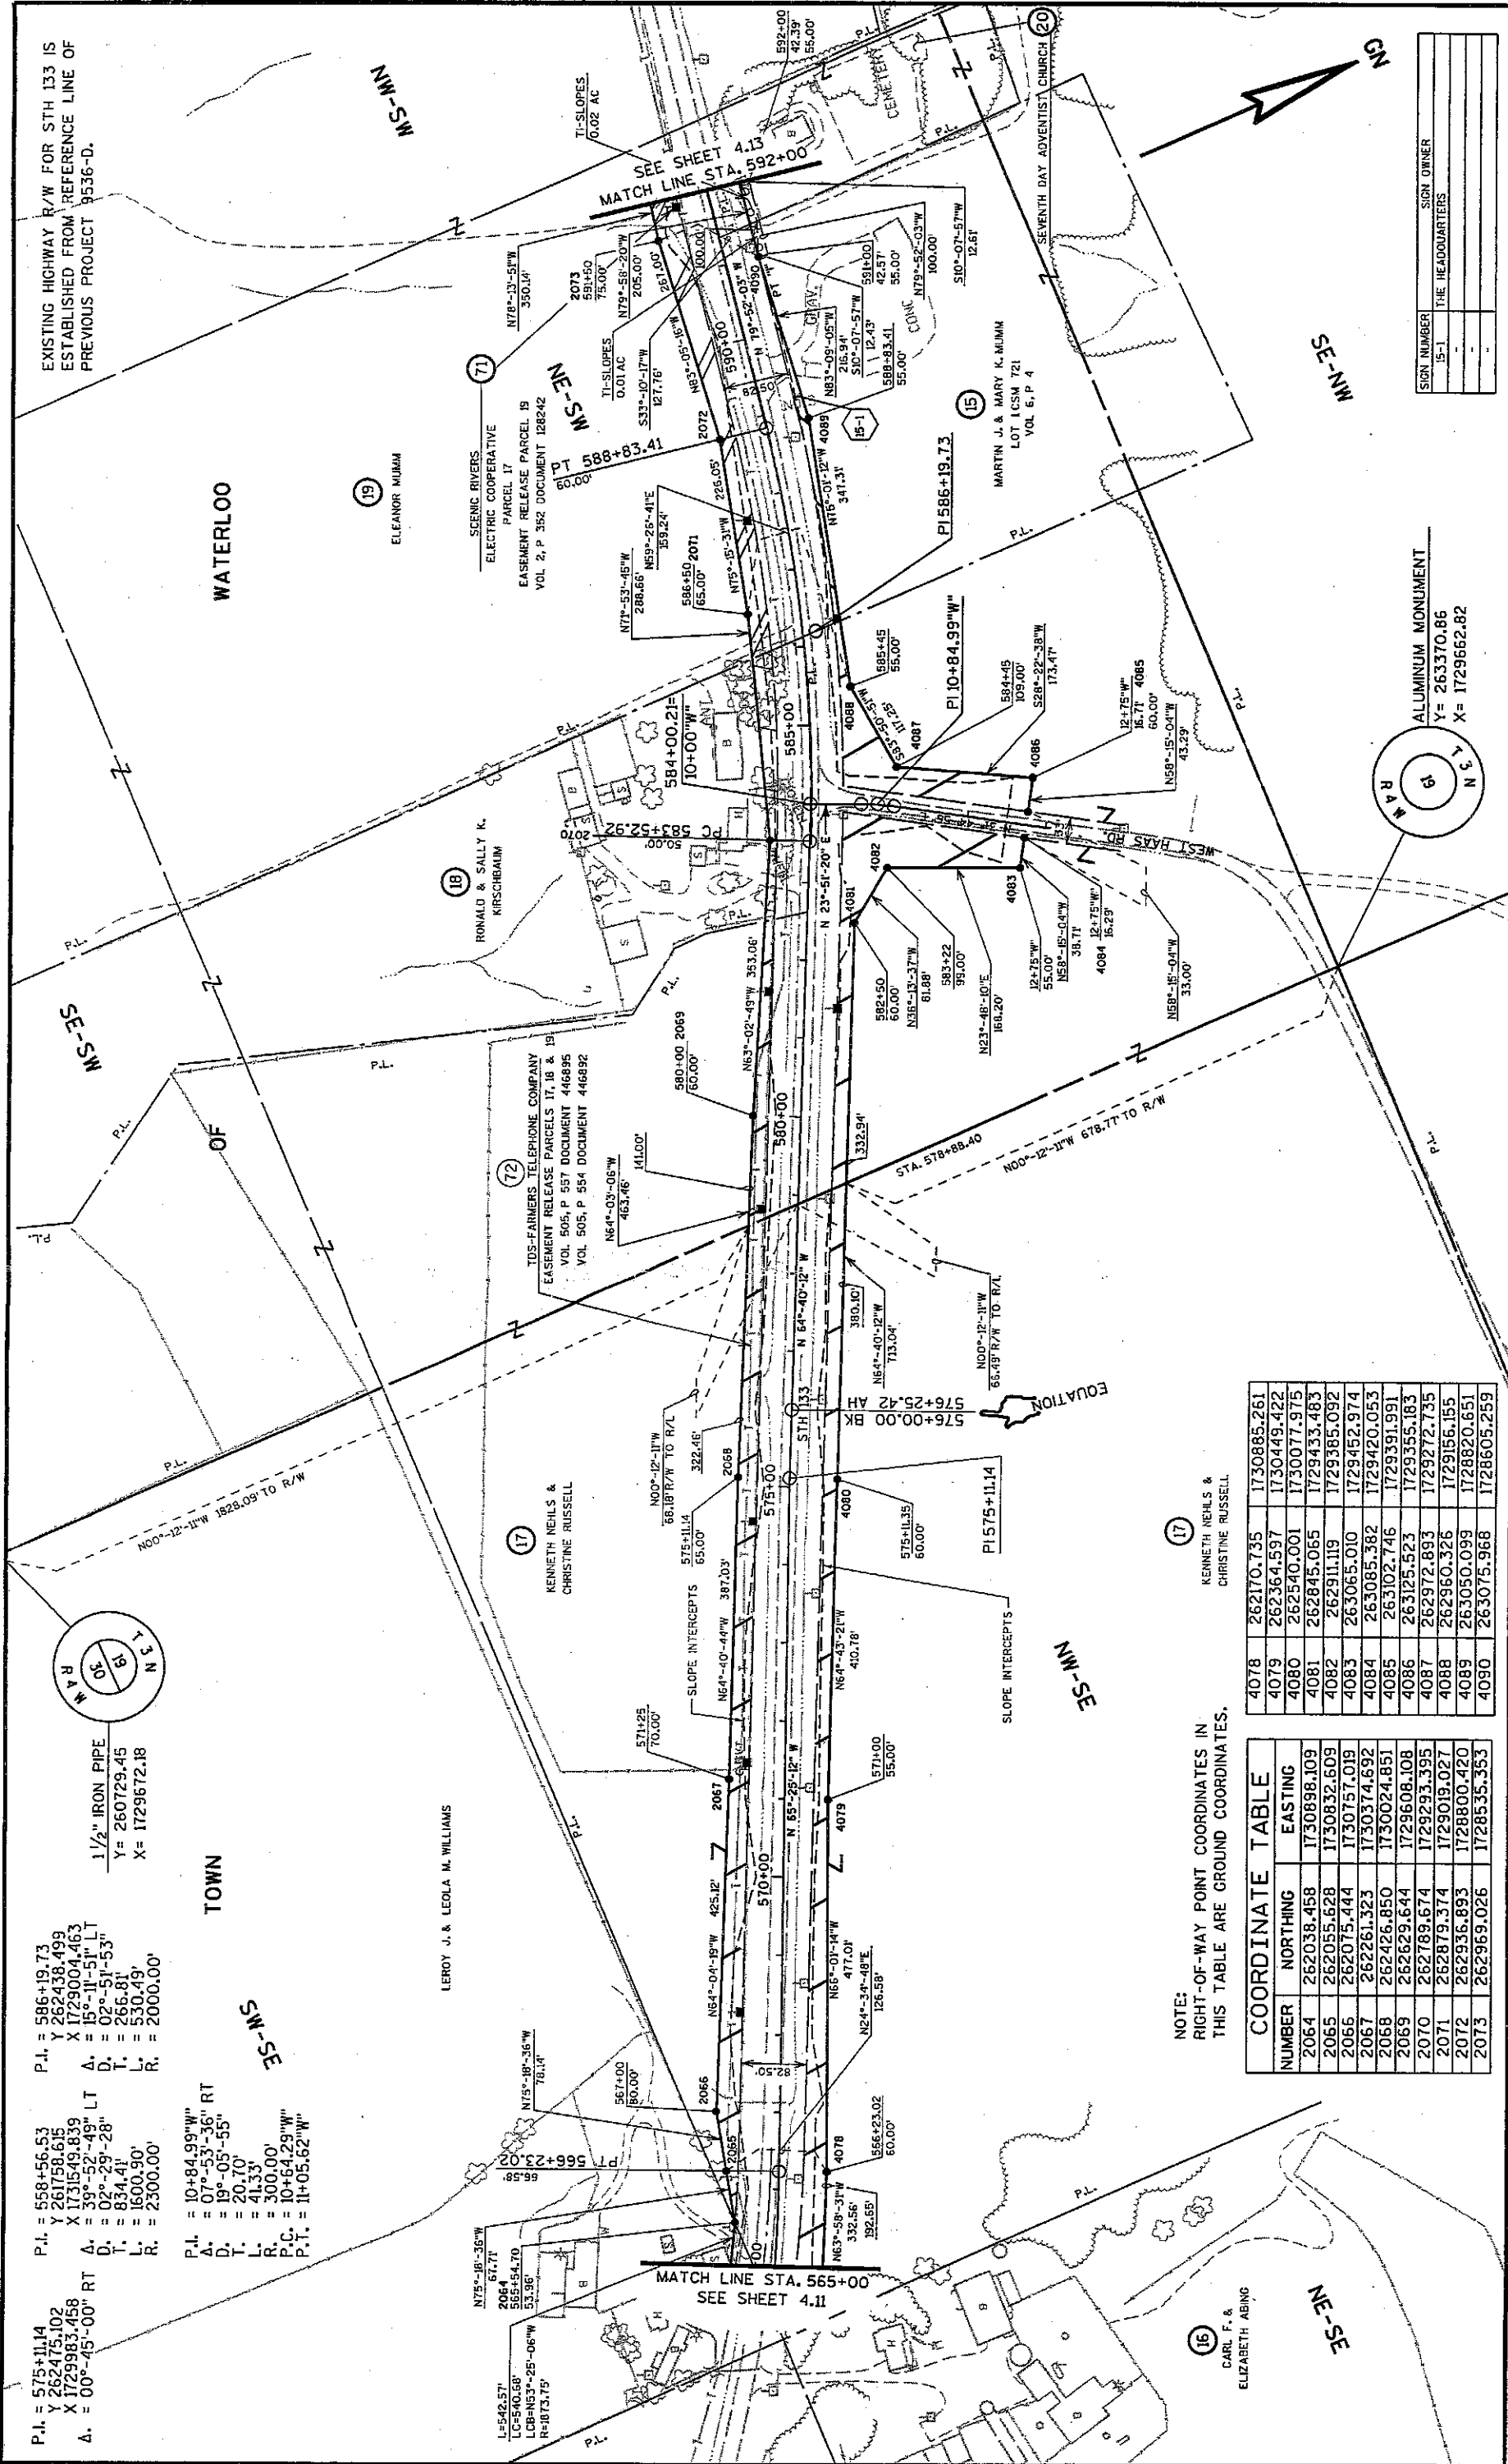

P.I. = 575+11.14
Y = 262475.102
X = 1729983.458
A. = 00°-45'-00" RT
D. = 39°-52'-49" LT
L. = 834.41'
T. = 266.81'
R. = 1600.90'
P.T. = 10+64.29"W"

P.I. = 586+19.73
Y = 262438.499
X = 1729004.463
A. = 15°-11'-51" LT
D. = 02°-29'-28"
L. = 1600.90'
T. = 266.81'
R. = 2300.00'

P.I. = 10+84.99"W"
A. = 07°-53'-36" RT
D. = 19°-05'-55"
T. = 20.70'
L. = 41.33'
R. = 300.00'
P.C. = 10+64.29"W"
P.T. = 11+05.62"W"

NOTE:
RIGHT-OF-WAY POINT COORDINATES IN
THIS TABLE ARE GROUND COORDINATES.

COORDINATE TABLE		
NUMBER	NORTHING	EASTING
2064	262038.458	1730898.109
2065	262055.628	1730832.609
2066	262075.444	1730757.019
2067	262261.323	1730374.692
2068	262426.850	1730024.851
2069	262629.644	1729608.108
2070	262789.674	1729293.395
2071	262879.374	1729019.027
2072	262936.893	1728800.420
2073	262969.026	1728535.353

4078	262170.735	1730885.261
4079	262364.597	1730449.422
4080	262540.001	1730077.975
4081	262845.065	1729433.483
4082	262911.119	1729385.092
4083	263065.010	1729452.974
4084	263085.382	1729420.053
4085	263102.746	1729391.991
4086	263125.523	1729355.183
4087	262972.893	1729272.735
4088	262960.326	1729156.155
4089	263050.099	1728820.651
4090	263075.968	1728605.259

SIGN NUMBER	SIGN OWNER
15-1	THE HEADQUARTERS

REVISION DATE
NOV. 11, 2005

DATE AUG. 27, 2004

DATE AUG. 27, 2004

DATE AUG. 27, 2004

GRID FACTOR 0.99996

SCALE, FEET
0 100 200

SCALE, FEET
0 100 200

SCALE, FEET
0 100 200

PLAT SHEET NO: 4.12

STATE R/W PROJECT NUMBER 5205-03-23

HWY: STH 133

CONSTRUCTION PROJECT NUMBER

COUNTY: GRANT

PLAT SHEET NO: 4.12

STATE R/W PROJECT NUMBER 5205-03-23

HWY: STH 133

CONSTRUCTION PROJECT NUMBER

COUNTY: GRANT

PS&E SHEET

CONSTRUCTION PROJECT NUMBER

COUNTY: GRANT

PS&E SHEET

CONSTRUCTION PROJECT NUMBER

COUNTY: GRANT

WISDOT/CADD SHEET 75

WISDOT/CADD SHEET 75

WISDOT/CADD SHEET 75

WISDOT/CADD SHEET 75

P.L. = 610+78.48
A. = 263371.594
X = 1726581.078
D. = 30'-16'-23" RT
T. = 03'-22'-13"
L. = 459.87
R. = 898.24
P.T. = 1700.00'


P.L. = 16+39.90" AH"
A. = 29'-52'-31" LT
D. = 16'-22'-13"
T. = 93.31
L. = 182.50
R. = 350.00'
P.C. = 15+46.53" AH"
P.T. = 17+29.03" AH"

P.L. = 18+89.84" AH"
A. = 28'-38'-52" RT
D. = 18'-48'-50"
T. = 90.13
L. = 169.36
R. = 200.00'
P.C. = 17+99.71" AH"
P.T. = 19+69.07" AH"

P.L. = 22+21.29" AH"
A. = 18'-18'-33" LT
D. = 11'-21'-33"
T. = 80.37
L. = 159.78
R. = 500.00'
P.C. = 21+40.71" AH"
P.T. = 23+00.45" AH"

ALUMINUM MONUMENT
Y = 261205.83
X = 1726874.85

EXISTING HIGHWAY R/W FOR STH 133 IS
ESTABLISHED FROM REFERENCE LINE OF
PREVIOUS PROJECT 9536-D.

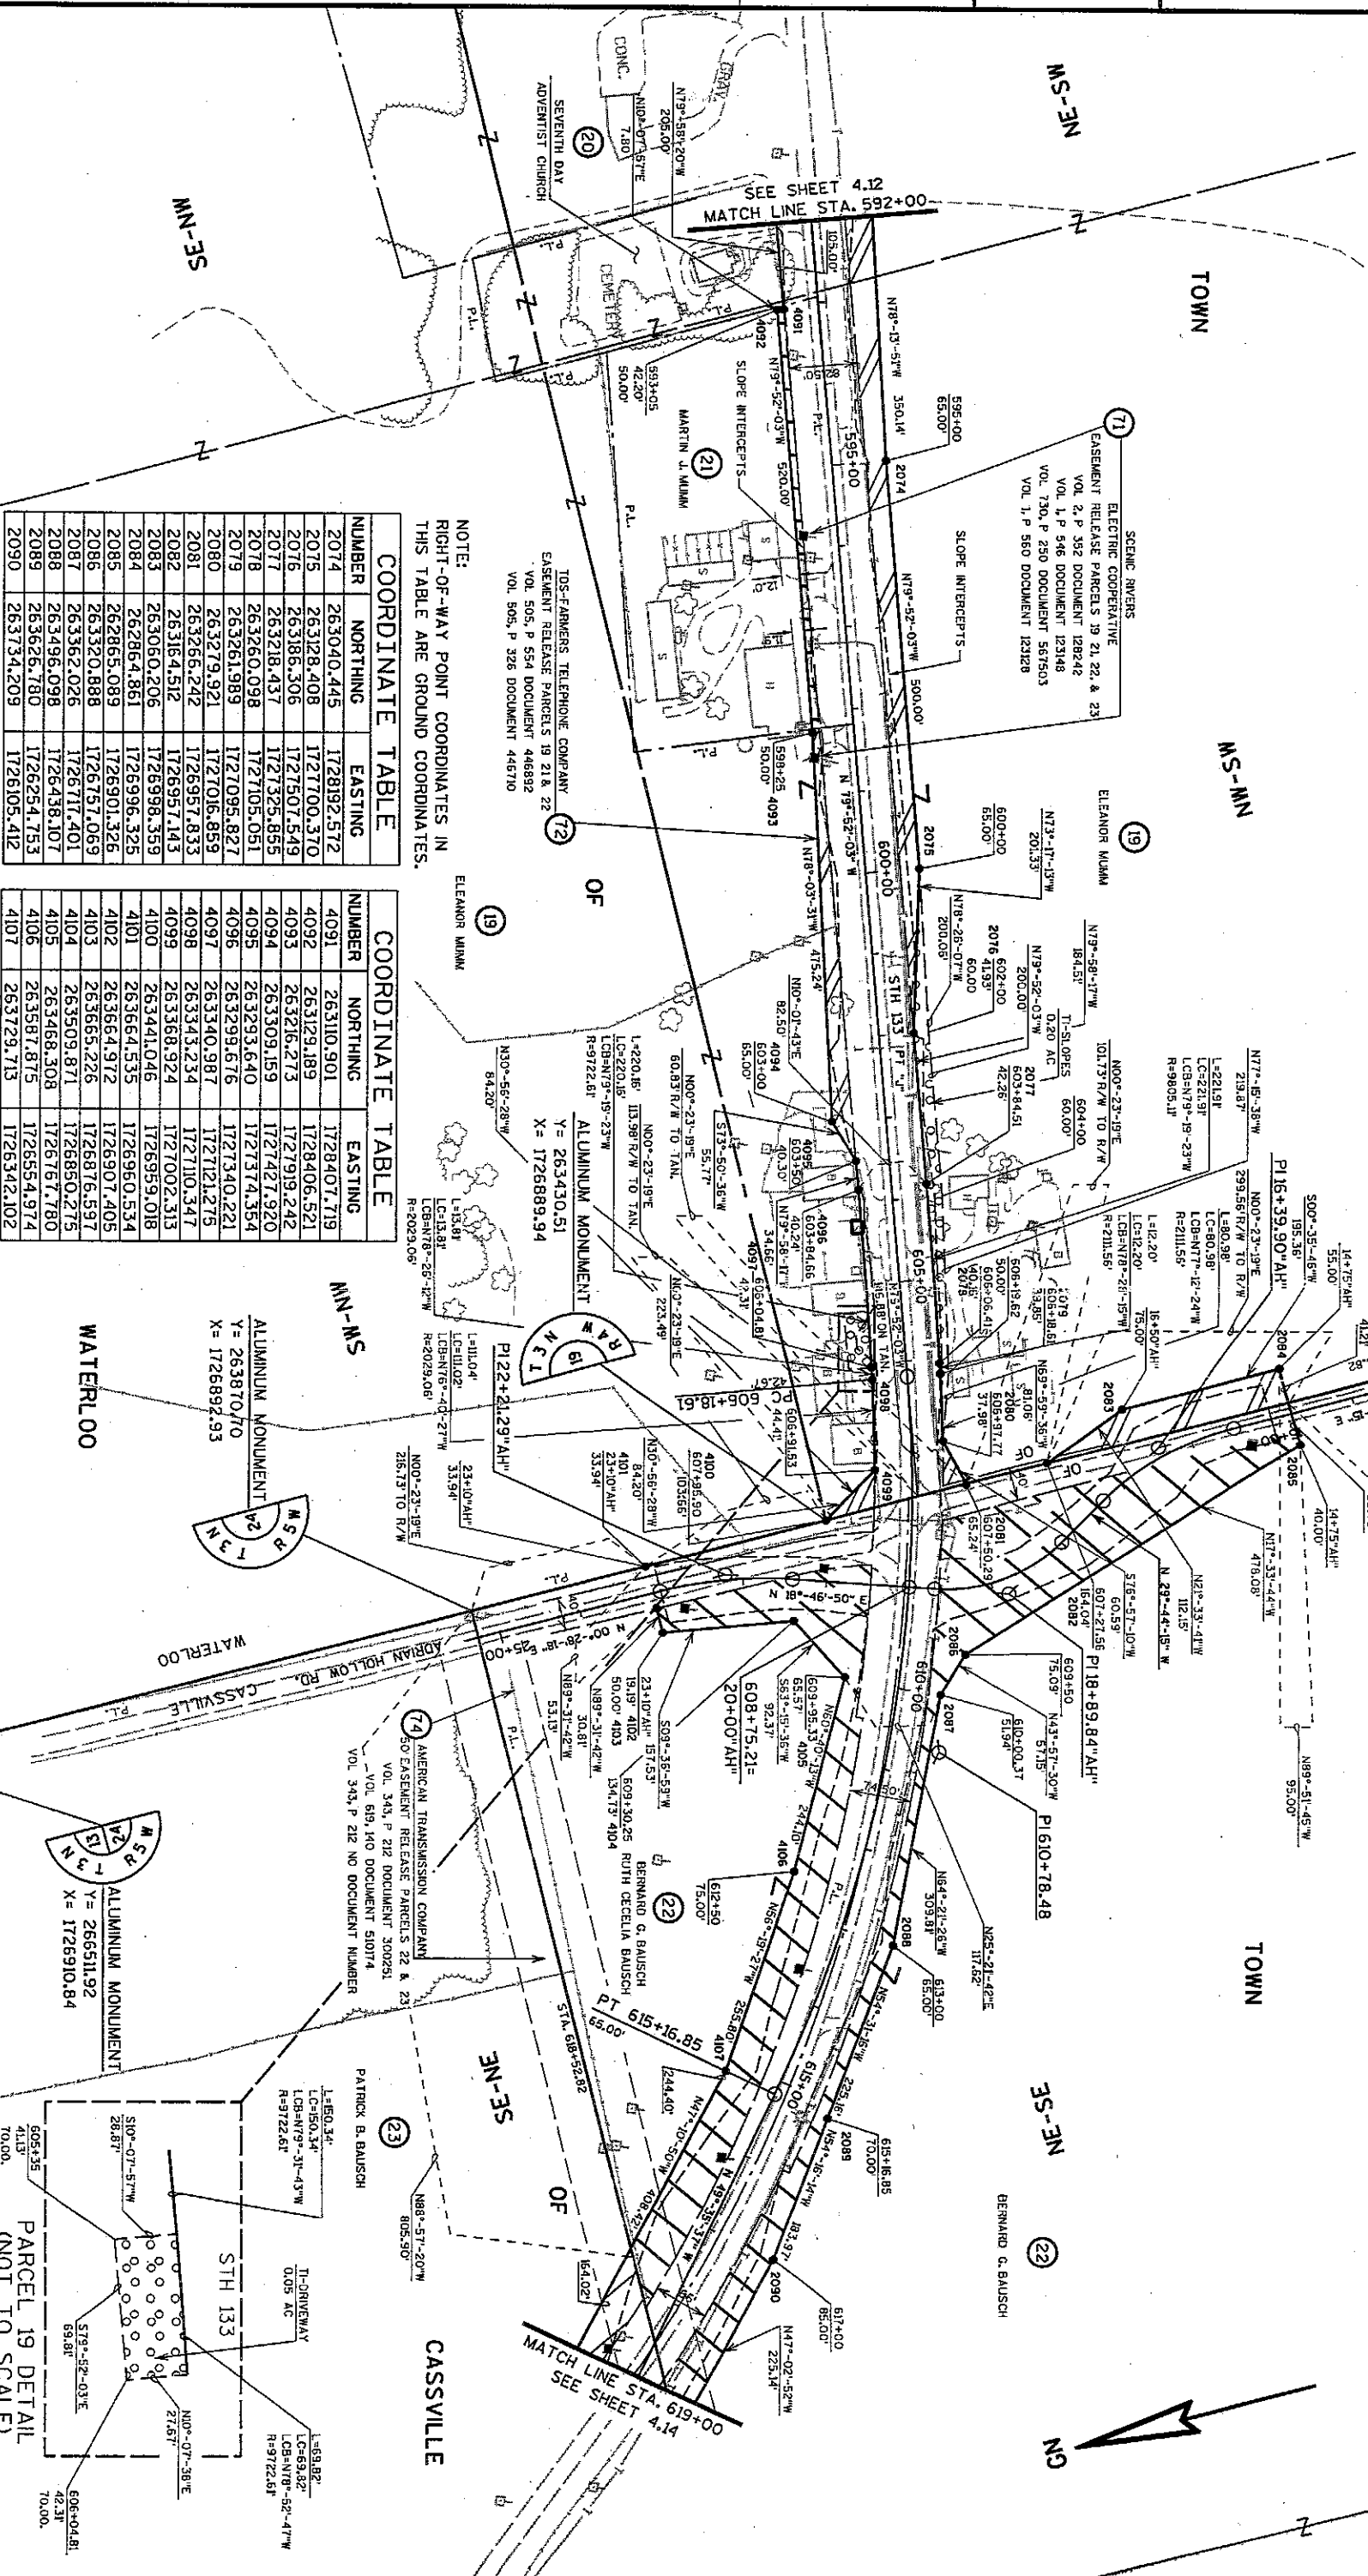

NOTE:
RIGHT-OF-WAY POINT COORDINATES IN
THIS TABLE ARE GROUND COORDINATES.

COORDINATE TABLE

NUMBER	NORTHING	EASTING
2074	263040.445	1728192.572
2075	263128.408	1727700.370
2076	263186.306	1727507.549
2077	263218.437	1727325.855
2078	263260.098	1727105.051
2079	263261.989	1727095.827
2080	263279.921	1727016.859
2081	263265.242	1726957.833
2082	263164.512	1726957.143
2083	263060.206	1726998.559
2084	262864.861	1726996.325
2085	262865.089	1726901.326
2086	263320.888	1726757.069
2087	263362.026	1726717.401
2088	263496.098	1726438.107
2089	263626.780	1726254.753
2090	263734.209	1726105.412

COORDINATE TABLE

NUMBER	NORTHING	EASTING
4091	26310.901	1728407.719
4092	263129.189	1728406.521
4093	263216.273	1727919.242
4094	263309.159	1727427.920
4095	263293.640	1727374.354
4096	263299.676	1727340.221
4097	263340.987	1727121.275
4098	263343.234	1727102.347
4099	263368.924	1727002.313
4100	263441.046	1726959.018
4101	263664.535	1726907.405
4102	263664.972	1726907.405
4103	263665.226	1726876.597
4104	263509.871	1726850.275
4105	263468.308	1726767.780
4106	263587.875	1726554.974
4107	263729.713	1726342.102

REVISION DATE NOV. 11, 2005	DATE AUG. 27, 2004	SCALE, FEET 0 100 200	HWY: STH 133	STATE R/W PROJECT NUMBER 5205-03-23	PLAT SHEET NO: 4.13
GRID FACTOR 0.99996			COUNTY: GRANT	CONSTRUCTION PROJECT NUMBER	PS&E SHEET
FILE NAME : g:\fortn\105941\105941\13.dgn	LOT DATE : 10 NOV 2005	LOT BY : KL Engineering	LOT NAME :	LOT SCALE :	WISDOT/CADDSS SHEET 75

NOTE:
RIGHT-OF-WAY POINT COORDINATES IN
THESE TABLES ARE GROUND COORDINATES.

COORDINATE TABLE	
NUMBER	NORTHING EASTING
4121	263453.846 1723436.592
4122	263430.715 1723403.640
4123	263437.876 1723398.620
4124	263433.130 1723263.681
4125	263283.903 1723142.738
4126	263025.305 1722837.406
4127	262844.444 1722636.630
4128	262735.652 1722502.827
4129	262694.253 1722362.331
4130	262644.302 1722259.089
4131	262578.711 172252.116
4132	262516.094 1722125.067
4133	262540.715 1721995.876
4134	262497.144 1721771.037
4135	262447.617 1721628.657
4136	262382.601 1721335.746
4206	262554.292 1722219.435
4223	262543.6327 1723564.460

P.I. = 645+60.65
Y 263529.893
X 1723559.963
A. = 04°-40'-31" LT
D. = 01°-08'-45"
T. = 204.11'
L. = 407.99'
R. = 5000.00'

P.I. = 661+52.31
Y 263531.785
X 1723319.926
A. = 25°-21'-39" RT
D. = 03°-22'-13"
T. = 382.50'
L. = 752.47'
R. = 1700.00'

P.I. = 18+00.45" RT
A. = 64°-23'-30"
D. = 51°-17'-45"
T. = 46.63'
L. = 87.26'
R. = 100.00'
P.C. = 17+21.75"
P.T. = 19+78.86"


TOWN

OF

CASSVILLE

BERNARD & RUTH C. BAUSCH, SELLERS
DENNIS C. & KAREN S. BAUSCH, BUYERS

ALUMINUM MONUMENT
Y= 261325.09
X= 1721559.63

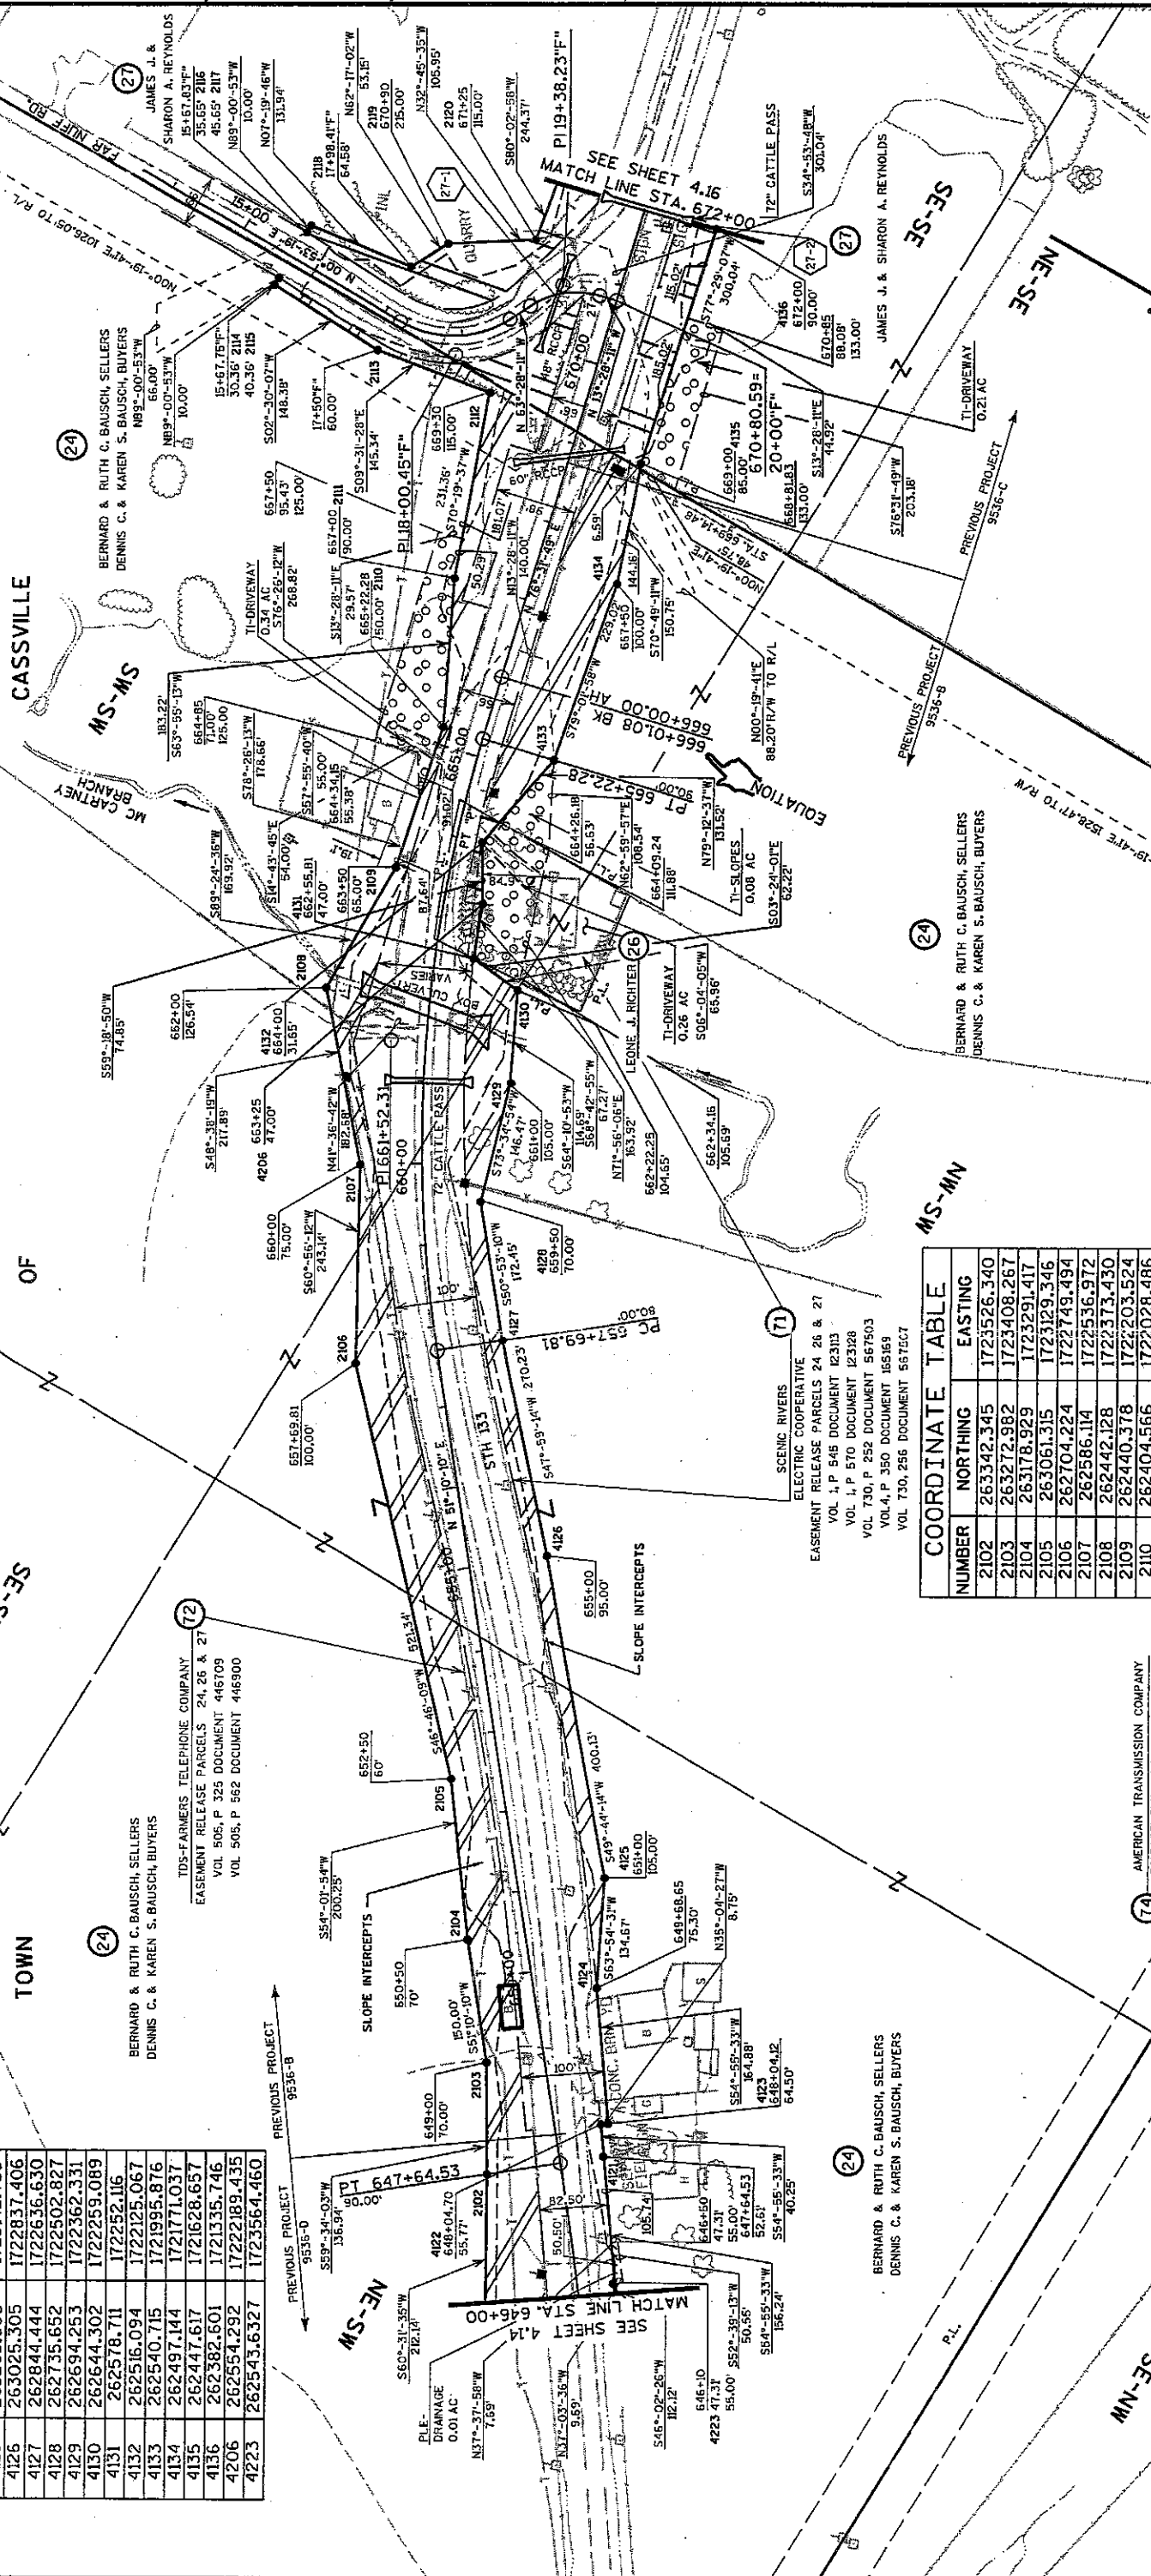

COORDINATE TABLE	
NUMBER	NORTHING EASTING
2102	263342.345 1723526.340
2103	263272.982 1723408.267
2104	263178.929 1723291.417
2105	263061.315 1723129.346
2106	262704.224 1722749.494
2107	262586.114 1722536.972
2108	262442.128 1722373.430
2109	262440.378 1722203.524
2110	262404.566 1722028.486
2111	262324.018 1721863.921
2112	262246.131 1721646.068
2113	262102.790 1721670.110
2114	261954.551 1721663.641
2115	261954.723 1721653.642
2116	261955.858 1721587.646
2117	261956.030 1721577.647
2118	262086.892 1721560.815
2119	262111.612 1721513.763
2120	262200.709 1721456.432


EASEMENT RELEASE PARCELS 24, 26 & 27
VOL. 1, P. 548 DOCUMENT 123103
VOL. 1, P. 570 DOCUMENT 123288
VOL. 730, P. 252 DOCUMENT 167503
VOL. 4, P. 350 DOCUMENT 165169
VOL. 730, P. 256 DOCUMENT 167507

AMERICAN TRANSMISSION COMPANY
50' EASEMENT RELEASE PARCEL 24
VOL. 343, P. 213 DOCUMENT 300253
VOL. 343, P. 214 DOCUMENT 300254

SIGN NUMBER	SIGN OWNER
27-1	WHITE TAIL BLUE CAMP GROUND & RESORT LLC
27-2	JAMES J. & SHARON A. REYNOLDS

REVISION DATE NOV. 11, 2005	DATE AUG. 27, 2004	SCALE, FEET 0 100 200	HWY: STH 133	STATE R/W PROJECT NUMBER 5205-03-23	PLAT SHEET NO: 4J5
GRID FACTOR 0.99996			COUNTY: GRANT	CONSTRUCTION PROJECT NUMBER	PS&E SHEET
PLOT DATE: 10 NOV 2005			PLOT BY: KL Engineering	PLOT NAME: WISDOT/CADD SHEET 75	

FILE NAME: g:\f0th\Fv109941\w\941\w415.dgn

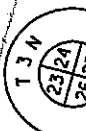

ALUMINUM MONUMENT
N 54° 32' 32" E
Y = 261325.09
X = 1721559.63

TOWN

EN-SN

OF

EN-MN

CASSVILLE

PARCEL 29 T1-DETAIL

MN-SN


EXISTING HIGHWAY R/W FOR STH 133 IS
ESTABLISHED FROM REFERENCE LINE OF
PREVIOUS PROJECT 9536-C.

3/4" REBAR
Y = 261373.61
X = 1718913.54



4

4

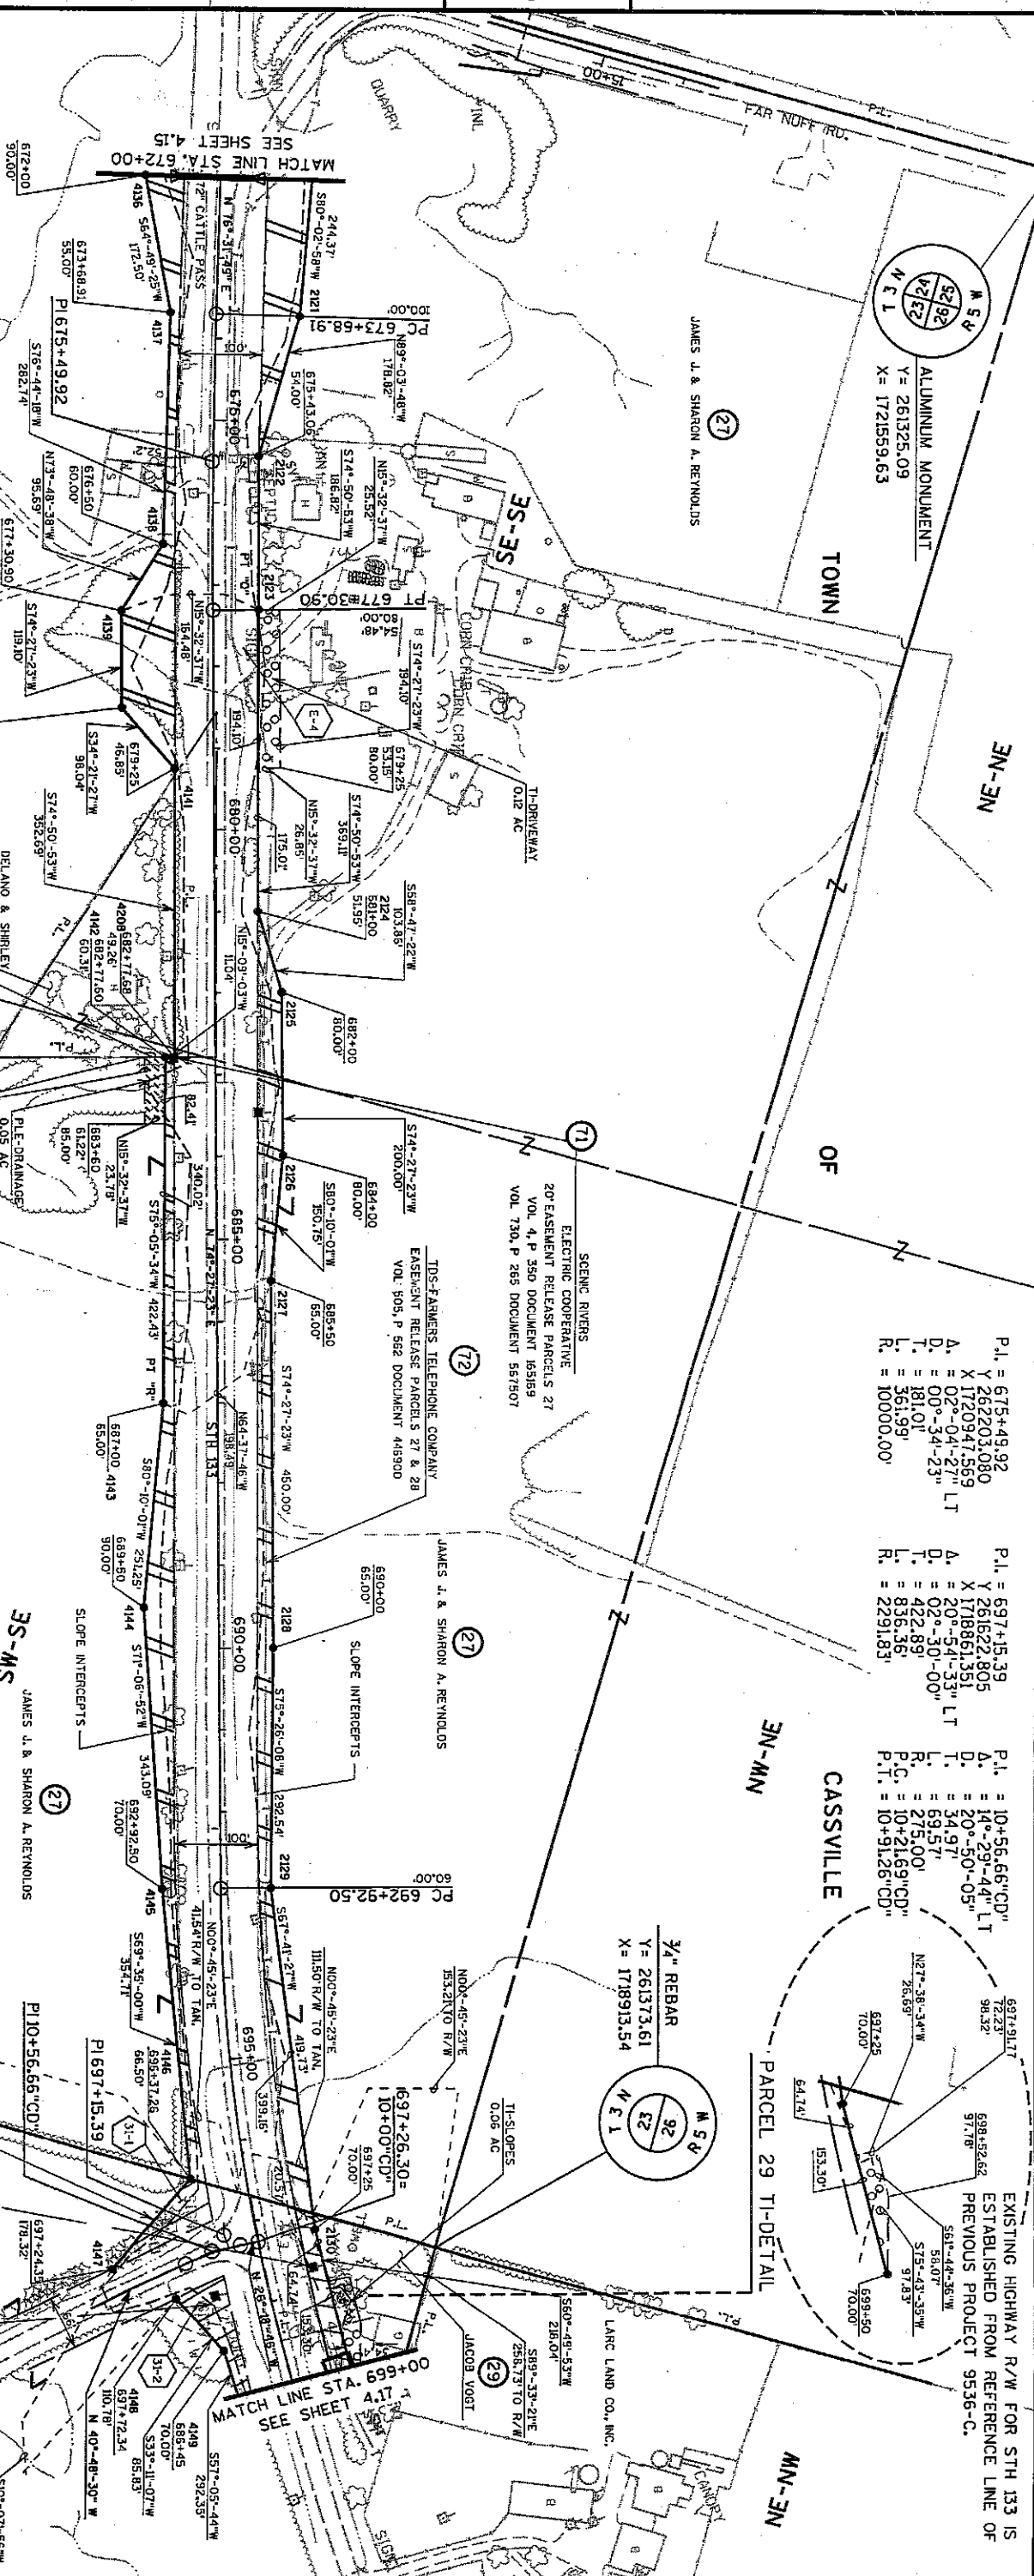

NOTE:
RIGHT-OF-WAY POINT COORDINATES IN
THIS TABLE ARE GROUND COORDINATES.

COORDINATE TABLE			
NUMBER	NORTHING	EASTING	
2121	262158.483	1721215.740	
2122	262161.407	1721036.940	
2123	262112.575	1720856.613	
2124	262016.098	1720500.336	
2125	261962.280	1720411.509	
2126	261908.685	1720218.824	
2127	261882.940	1720070.290	
2128	261762.352	1719636.749	
2129	261688.787	1719553.606	
2130	261529.458	1718965.299	

3/4" REBAR
Y = 26653.41
X = 1718983.26




SIGN NUMBER	SIGN OWNER
31-1	CASSVILLE CONSERVATION CLUB
31-2	BAUSCH REPAIR
E-4	JAMES J. & SHARON A. REYNOLDS

REVISION DATE: NOV. 11, 2005
DATE AUG. 27, 2004
SCALE, FEET: 0 100 200
HWY: STH 133
COUNTY: GRANT
STATE R/W PROJECT NUMBER 5205-03-23
PLAT SHEET NO: 4.16
PS&E SHEET: E

NOTE:
RIGHT-OF-WAY POINT COORDINATES IN
THIS TABLE ARE GROUND COORDINATES.

COORDINATE TABLE		
NUMBER	NORTHING	EASTING
2140	259872.053	1716562.566
2141	259779.336	1716454.731
2142	259700.086	1716241.873
2143	259613.259	1716068.546
2144	259560.616	1715919.248
2145	259524.197	1715775.908
2146	258441.876	1715564.147
2147	259447.457	1715488.988
2148	259308.167	1715238.526
2149	259045.026	1715039.950
2150	258789.037	1714904.559
2151	258505.759	1714817.876
4160	260055.902	1716587.555
4161	259924.936	1716357.132
4162	259807.718	1716178.310
4163	259695.062	1715880.205
4164	259675.260	1715827.806
4165	259652.518	1715664.533
4166	259622.681	1715511.641
4167	259501.221	1715296.326
4168	259309.176	1715109.017
4169	259176.435	1714935.833
4170	258970.197	1714844.754
4171	258501.421	1714747.941
4172	258462.493	1714751.628
4173	258364.579	1714763.102
4211	260018.367	1716534.227
4212	260023.776	1716531.032

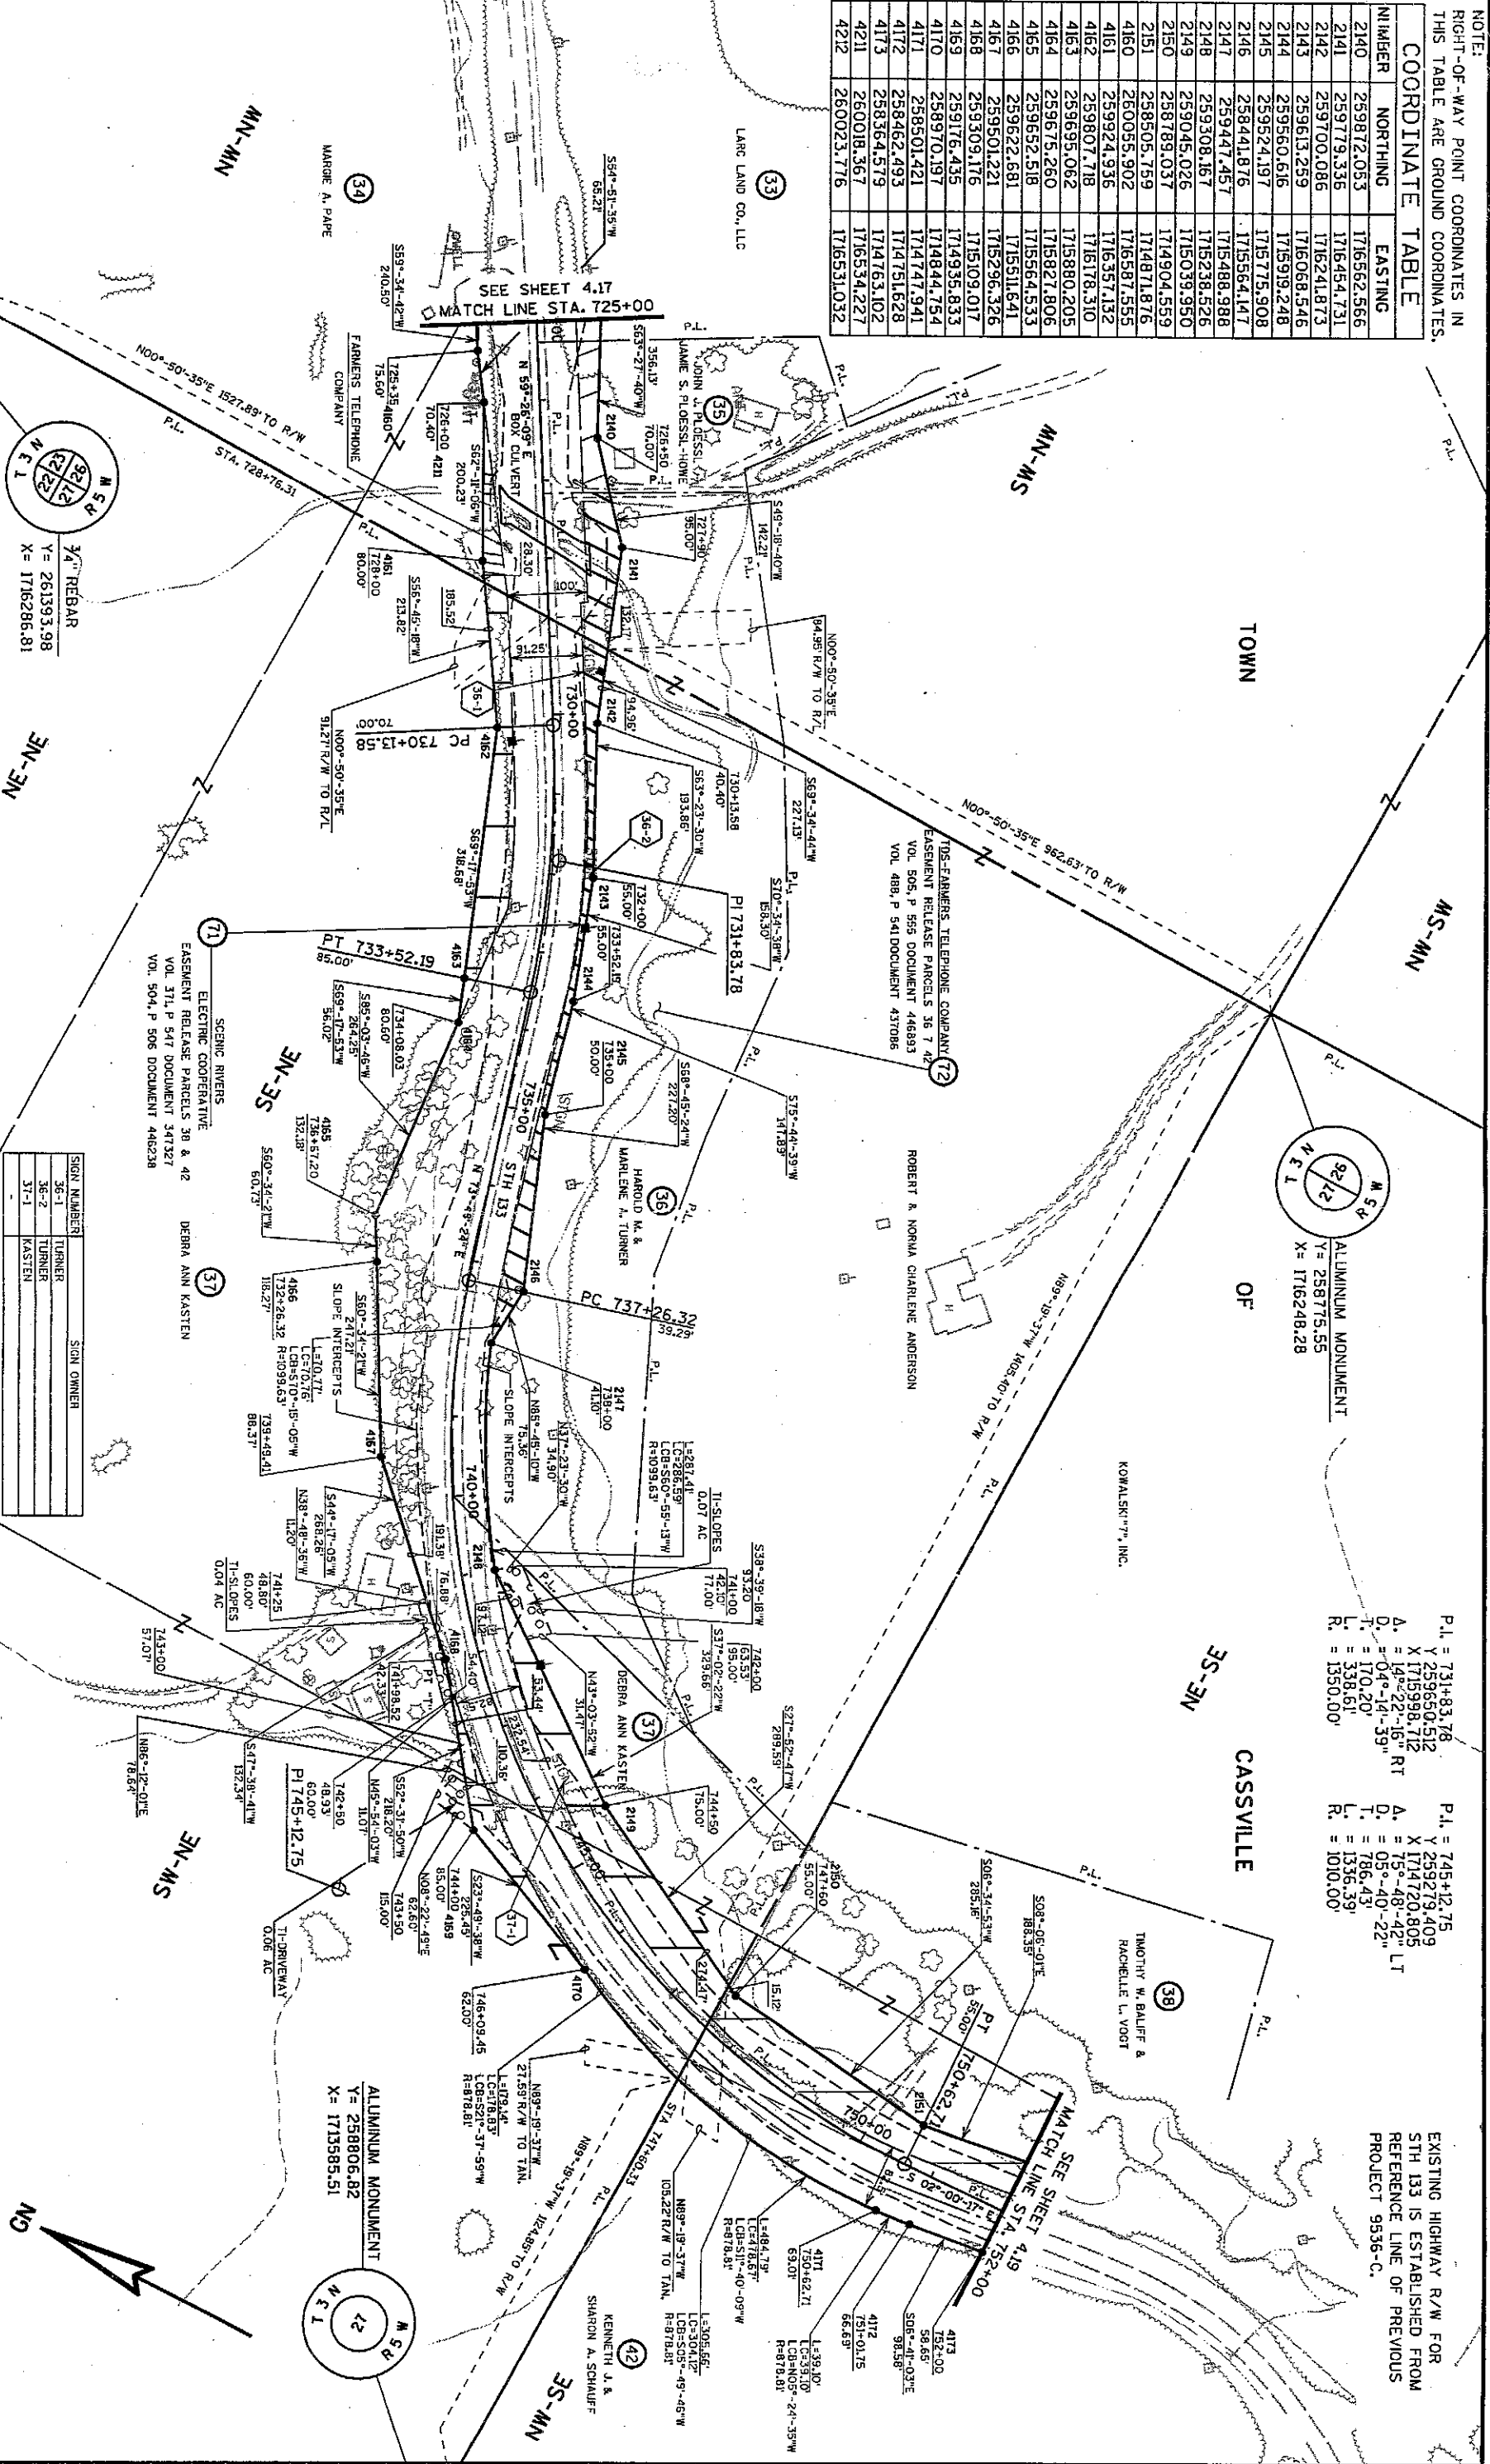

P.L. = 731+83.78
Y = 259650.512
X = 1715998.712
A. = 14°22'-16" RT
D. = 0°40'-14'-39"
T. = 170.20'
L. = 338.61'
R. = 1350.00'

P.L. = 745+12.75
Y = 259629.409
X = 1714720.805
A. = 75°-48'-42" LT
D. = 0°-40'-22"
T. = 786.43'
L. = 1336.33'
R. = 1010.00'

EXISTING HIGHWAY R/W FOR
STH 133 IS ESTABLISHED FROM
REFERENCE LINE OF PREVIOUS
PROJECT 9536-C.

3/4" REBAR
Y = 261393.98
X = 1716286.81

SIGN NUMBER	SIGN OWNER
36-1	TURNER
36-2	TURNER
37-1	KASTEN



ALUMINUM MONUMENT
Y = 258806.82
X = 1713585.51

REVISION DATE NOV. 11, 2005	DATE AUG. 27, 2004	SCALE, FEET 0 100 200	HWY: STH 133	STATE R/W PROJECT NUMBER 5205-03-23	PLAT SHEET NO: 4.1B
	GRID FACTOR 0.99996		COUNTY: GRANT	CONSTRUCTION PROJECT NUMBER	PS&E SHEET
FILE NAME : g:\fort\h\fv109943\fv\w\341\w\418.dgn		PLOT DATE : 10 NOV 2005	PLOT BY : KL Engineering	PLOT NAME :	WISDOT/CADDS SHEET 75

EXISTING HIGHWAY R/W FOR STH 133 IS ESTABLISHED FROM REFERENCE LINE OF PREVIOUS PROJECT 9536-C.

NOTE: THIS TABLE OF WAY POINT COORDINATES IN THIS TABLE ARE GROUND COORDINATES.

COORDINATE TABLE			COORDINATE TABLE		
NUMBER	NORTHING	EASTING	NUMBER	NORTHING	EASTING
4173	258364.579	1714763.102	2152	258319.285	1714898.416
4174	258363.741	1714752.719	2153	258198.638	1714892.633
4175	258040.437	1714729.279	2154	257995.678	1714888.092
4176	257838.821	1714668.421	2155	257835.440	1714824.976
4177	257673.409	1714443.666	2156	257770.401	1714739.296
4178	257638.954	1714289.044	2157	257650.422	1714785.676
4179	257675.216	1714045.698	2158	257591.699	1714878.689
4180	257680.611	1714031.920	2159	257577.958	1714870.014
4181	257837.490	1713645.783	2160	257535.679	1714843.321
4182	257869.211	1713646.051	2161	257521.938	1714834.646
4183	257904.888	1713517.688	2162	257637.057	1714852.308
4184	258068.620	1713152.426	2163	257629.191	1714560.789
4185	258207.051	1712759.408	2164	257583.796	1714462.755
			2165	257543.597	1714304.585
			2166	257525.525	1714136.735
			2167	257573.392	1714004.564
			2168	257648.436	1713845.495
			2169	257728.577	1713644.863

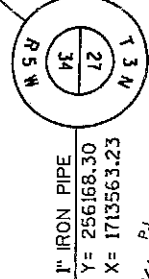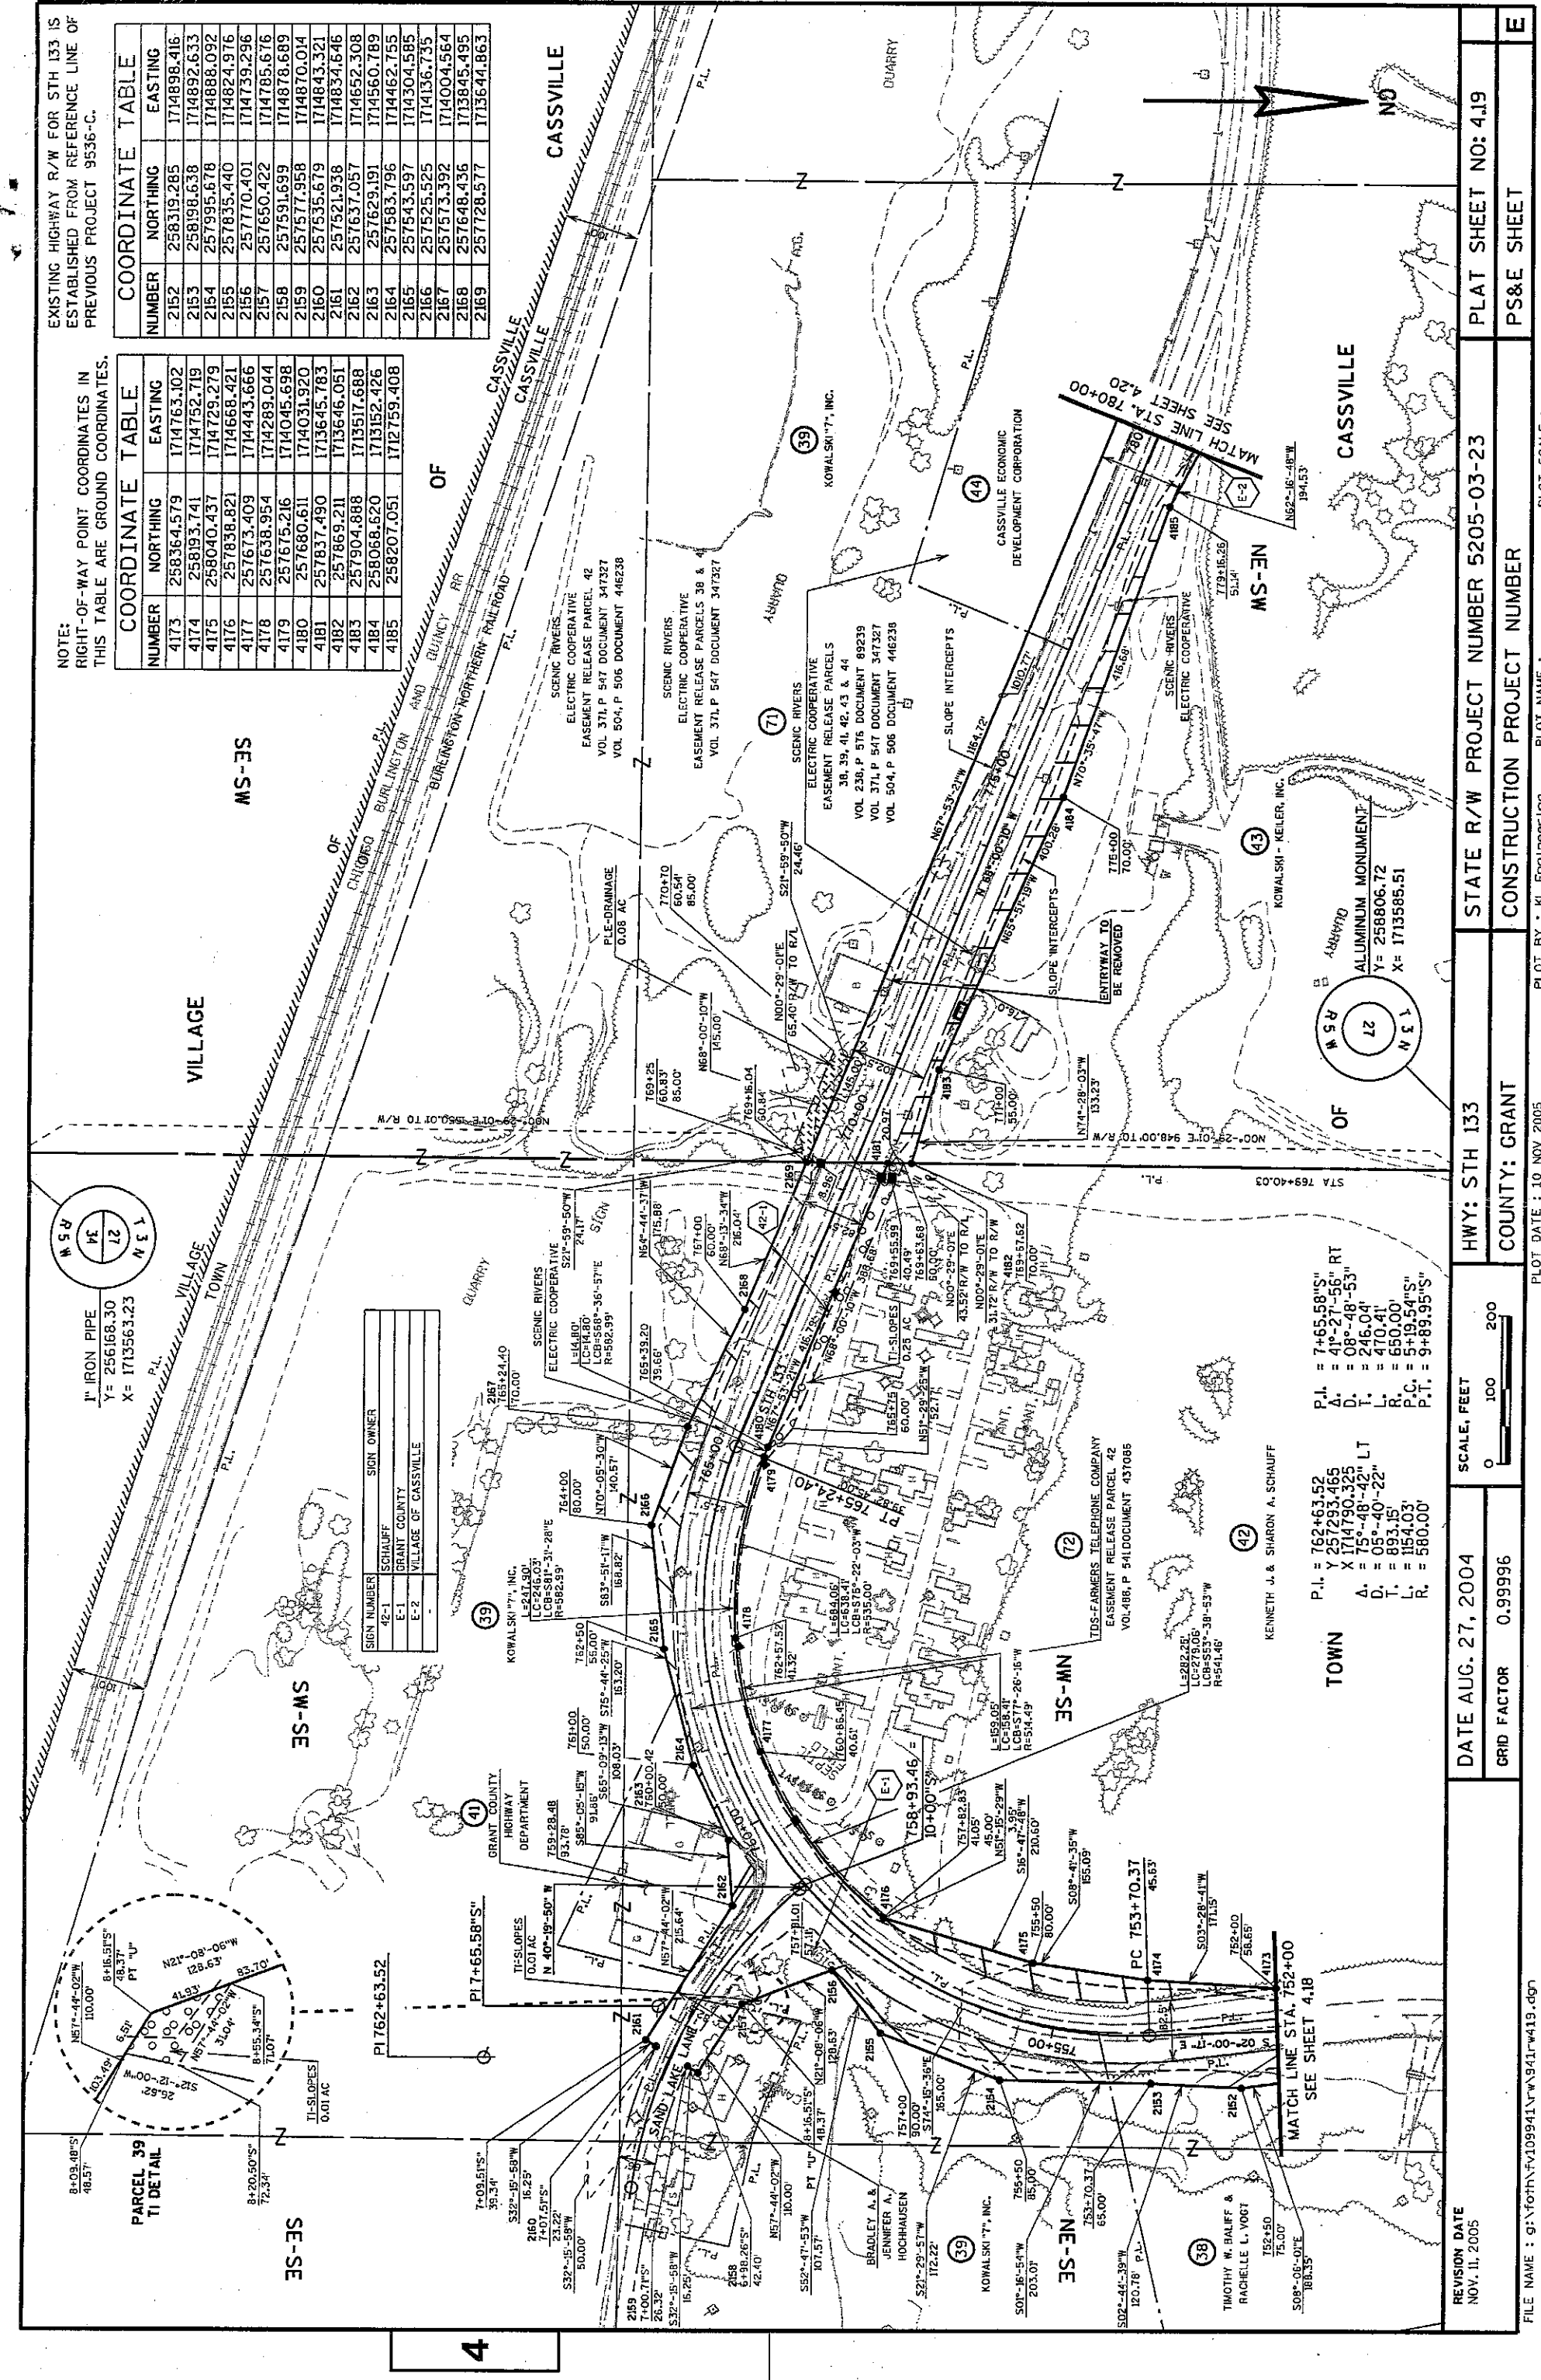

SIGN NUMBER	SIGN OWNER
42-1	SCHAUFF
E-1	GRANT COUNTY
E-2	VILLAGE OF CASSVILLE

P.I. = 762+63.52
A. = 41°-27'-56" RT
D. = 08°-48'-53"
T. = 246.04'
L. = 470.41'
R. = 650.00'
P.C. = 5+19.54'S
P.T. = 9+89.95'S

REVISION DATE NOV. 11, 2005	DATE AUG. 27, 2004	SCALE, FEET 0 100 200	HWY: STH 133	STATE R/W PROJECT NUMBER 5205-03-23	PLAT SHEET NO: 4J9
GRID FACTOR 0.99996			COUNTY: GRANT	CONSTRUCTION PROJECT NUMBER	PS&E SHEET
			PLOT DATE : 10 NOV 2005	PLOT BY : KL Engineer Inc	PLOT NAME :
			WISDOT/CADD SHEET 75		

FILE NAME : g:\t\th\w\109941\w\941w419.dgn

SIGN NUMBER	SIGN OWNER
43-1	EAGLE'S ROOST MOTEL-CABINS

VILLAGE

COORDINATE TABLE		COORDINATE TABLE	
NUMBER	NORTHING	NUMBER	EASTING
2170	258166.979	4186	258297.538
2171	258177.569	4187	258368.329
2172	258195.210	4188	258409.273
2173	258229.221	4189	258351.382
2174	258246.318	4190	258290.944
2175	258162.112	4191	258267.963
2176	258179.362	4192	258316.713
2177	258132.067	4193	258270.315
2178	258039.765	4194	258210.310
2179	258011.797	4195	258165.293
2180	258001.733	4196	258092.127
2181	257941.423	4198	258135.080
2182	257960.298	4199	258131.736
2183	258059.027	4200	258157.188
2184	258066.558	4201	258261.378
2185	258194.090	4202	258241.575

NOTE:
RIGHT-OF-WAY POINT COORDINATES IN
THIS TABLE ARE GROUND COORDINATES.


P.I. = 785+67.63
Y 258393.273
X 1712067.806
A. = 43°-35'-12" LT
D. = 05°-00'-14" RT
T. = 457.81
L. = 871.04
R. = 1145.00

P.I. = 791+03.46
Y 257958.947
X 1710970.246
A. = 39°-53'-57" RT
D. = 05°-27'-24" LT
T. = 381.12
L. = 731.19
R. = 1050.00

P.I. = 9+26.43" J"
A. = 15°-47'-48" LT
D. = 19°-05'-55" LT
T. = 41.62
L. = 82.71
R. = 300.00
P.C. = 8+84.81" J"
P.T. = 9+67.52" J"


P.I. = 10+69.40" WB"
A. = 46°-20'-45" LT
D. = 57°-17'-45" LT
T. = 42.80
L. = 80.89
R. = 100.00
P.C. = 10+26.60" WB"
P.T. = 11+07.49" WB"

EXISTING HIGHWAY R/W FOR STH 133 IS
ESTABLISHED FROM REFERENCE LINE OF
PREVIOUS PROJECT 9536-C AND CHICAGO,
BURLINGTON & QUINCY RAILROAD STATION
MAP, DATED JUNE 30, 1917.


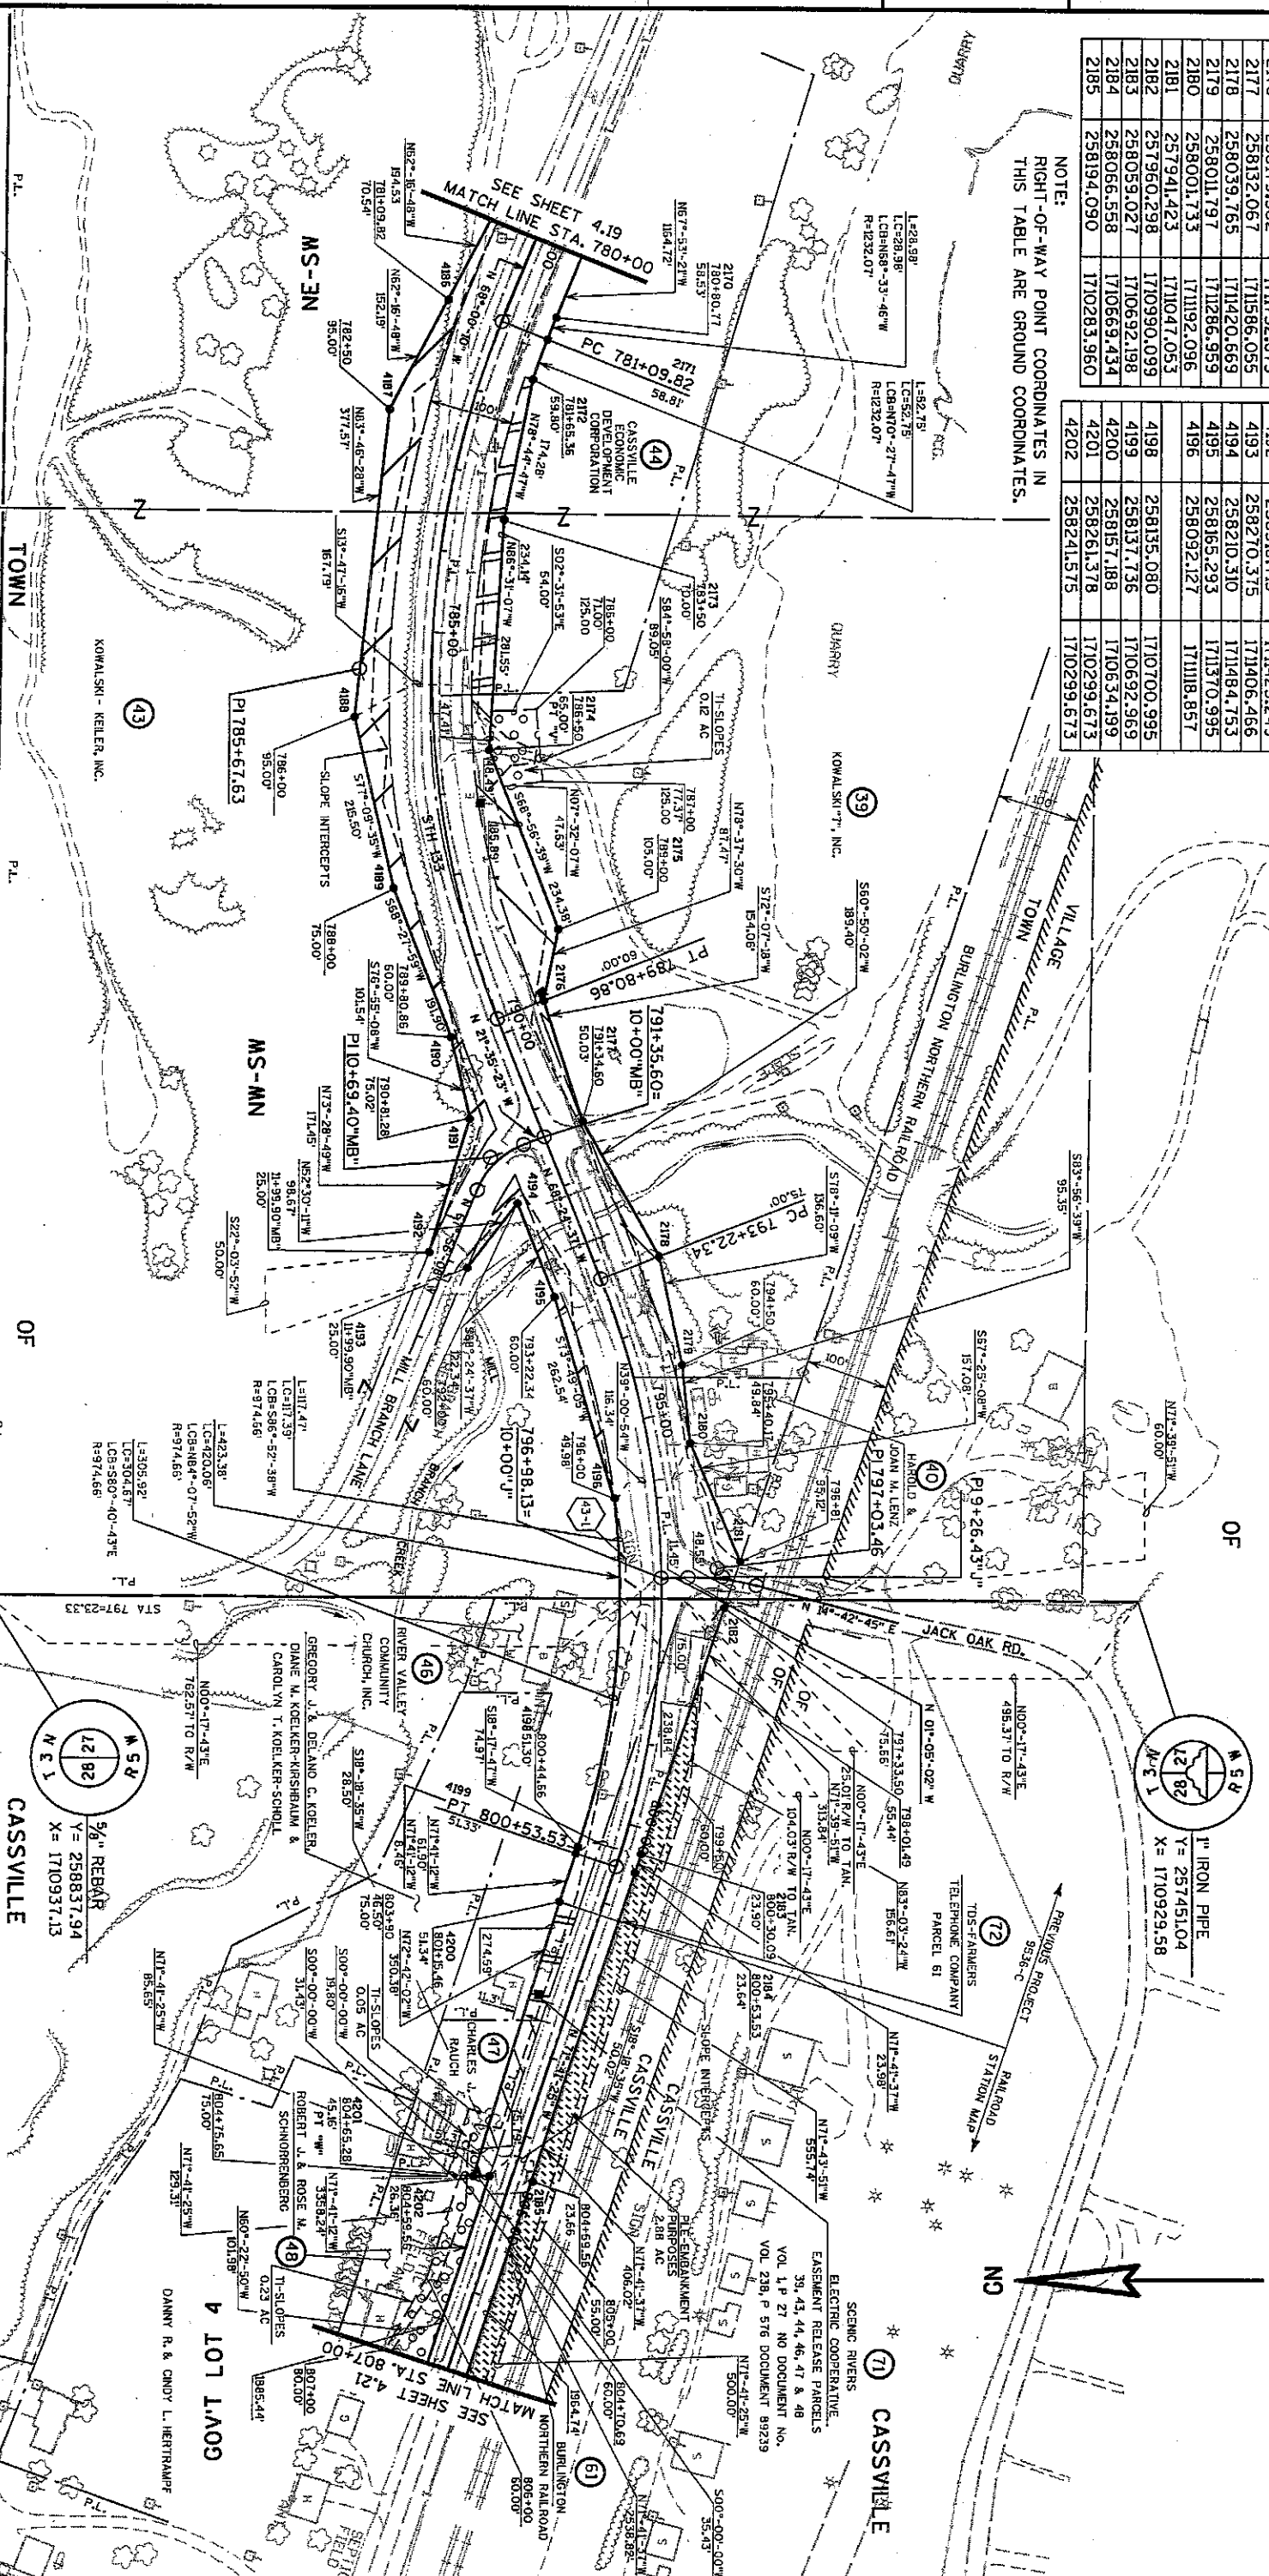


REVISION DATE NOV. 11, 2005	DATE AUG. 27, 2004	SCALE, FEET 0 100 200	HWY: STH 133	STATE R/W PROJECT NUMBER 5205-03-23	PLAT SHEET NO: 420
	GRID FACTOR 0.99996		COUNTY: GRANT	CONSTRUCTION PROJECT NUMBER	PS&E SHEET

EXISTING HIGHWAY R/W FOR STH 133
IS ESTABLISHED FROM CHICAGO,
BURLINGTON & QUINCY RAILROAD
STATION MAP, DATED JUNE 30, 1917.

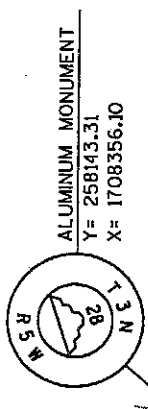

ALUMINUM MONUMENT
Y= 258143.31
X= 1708356.10

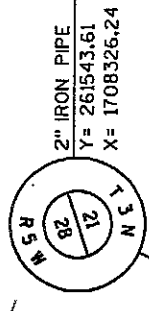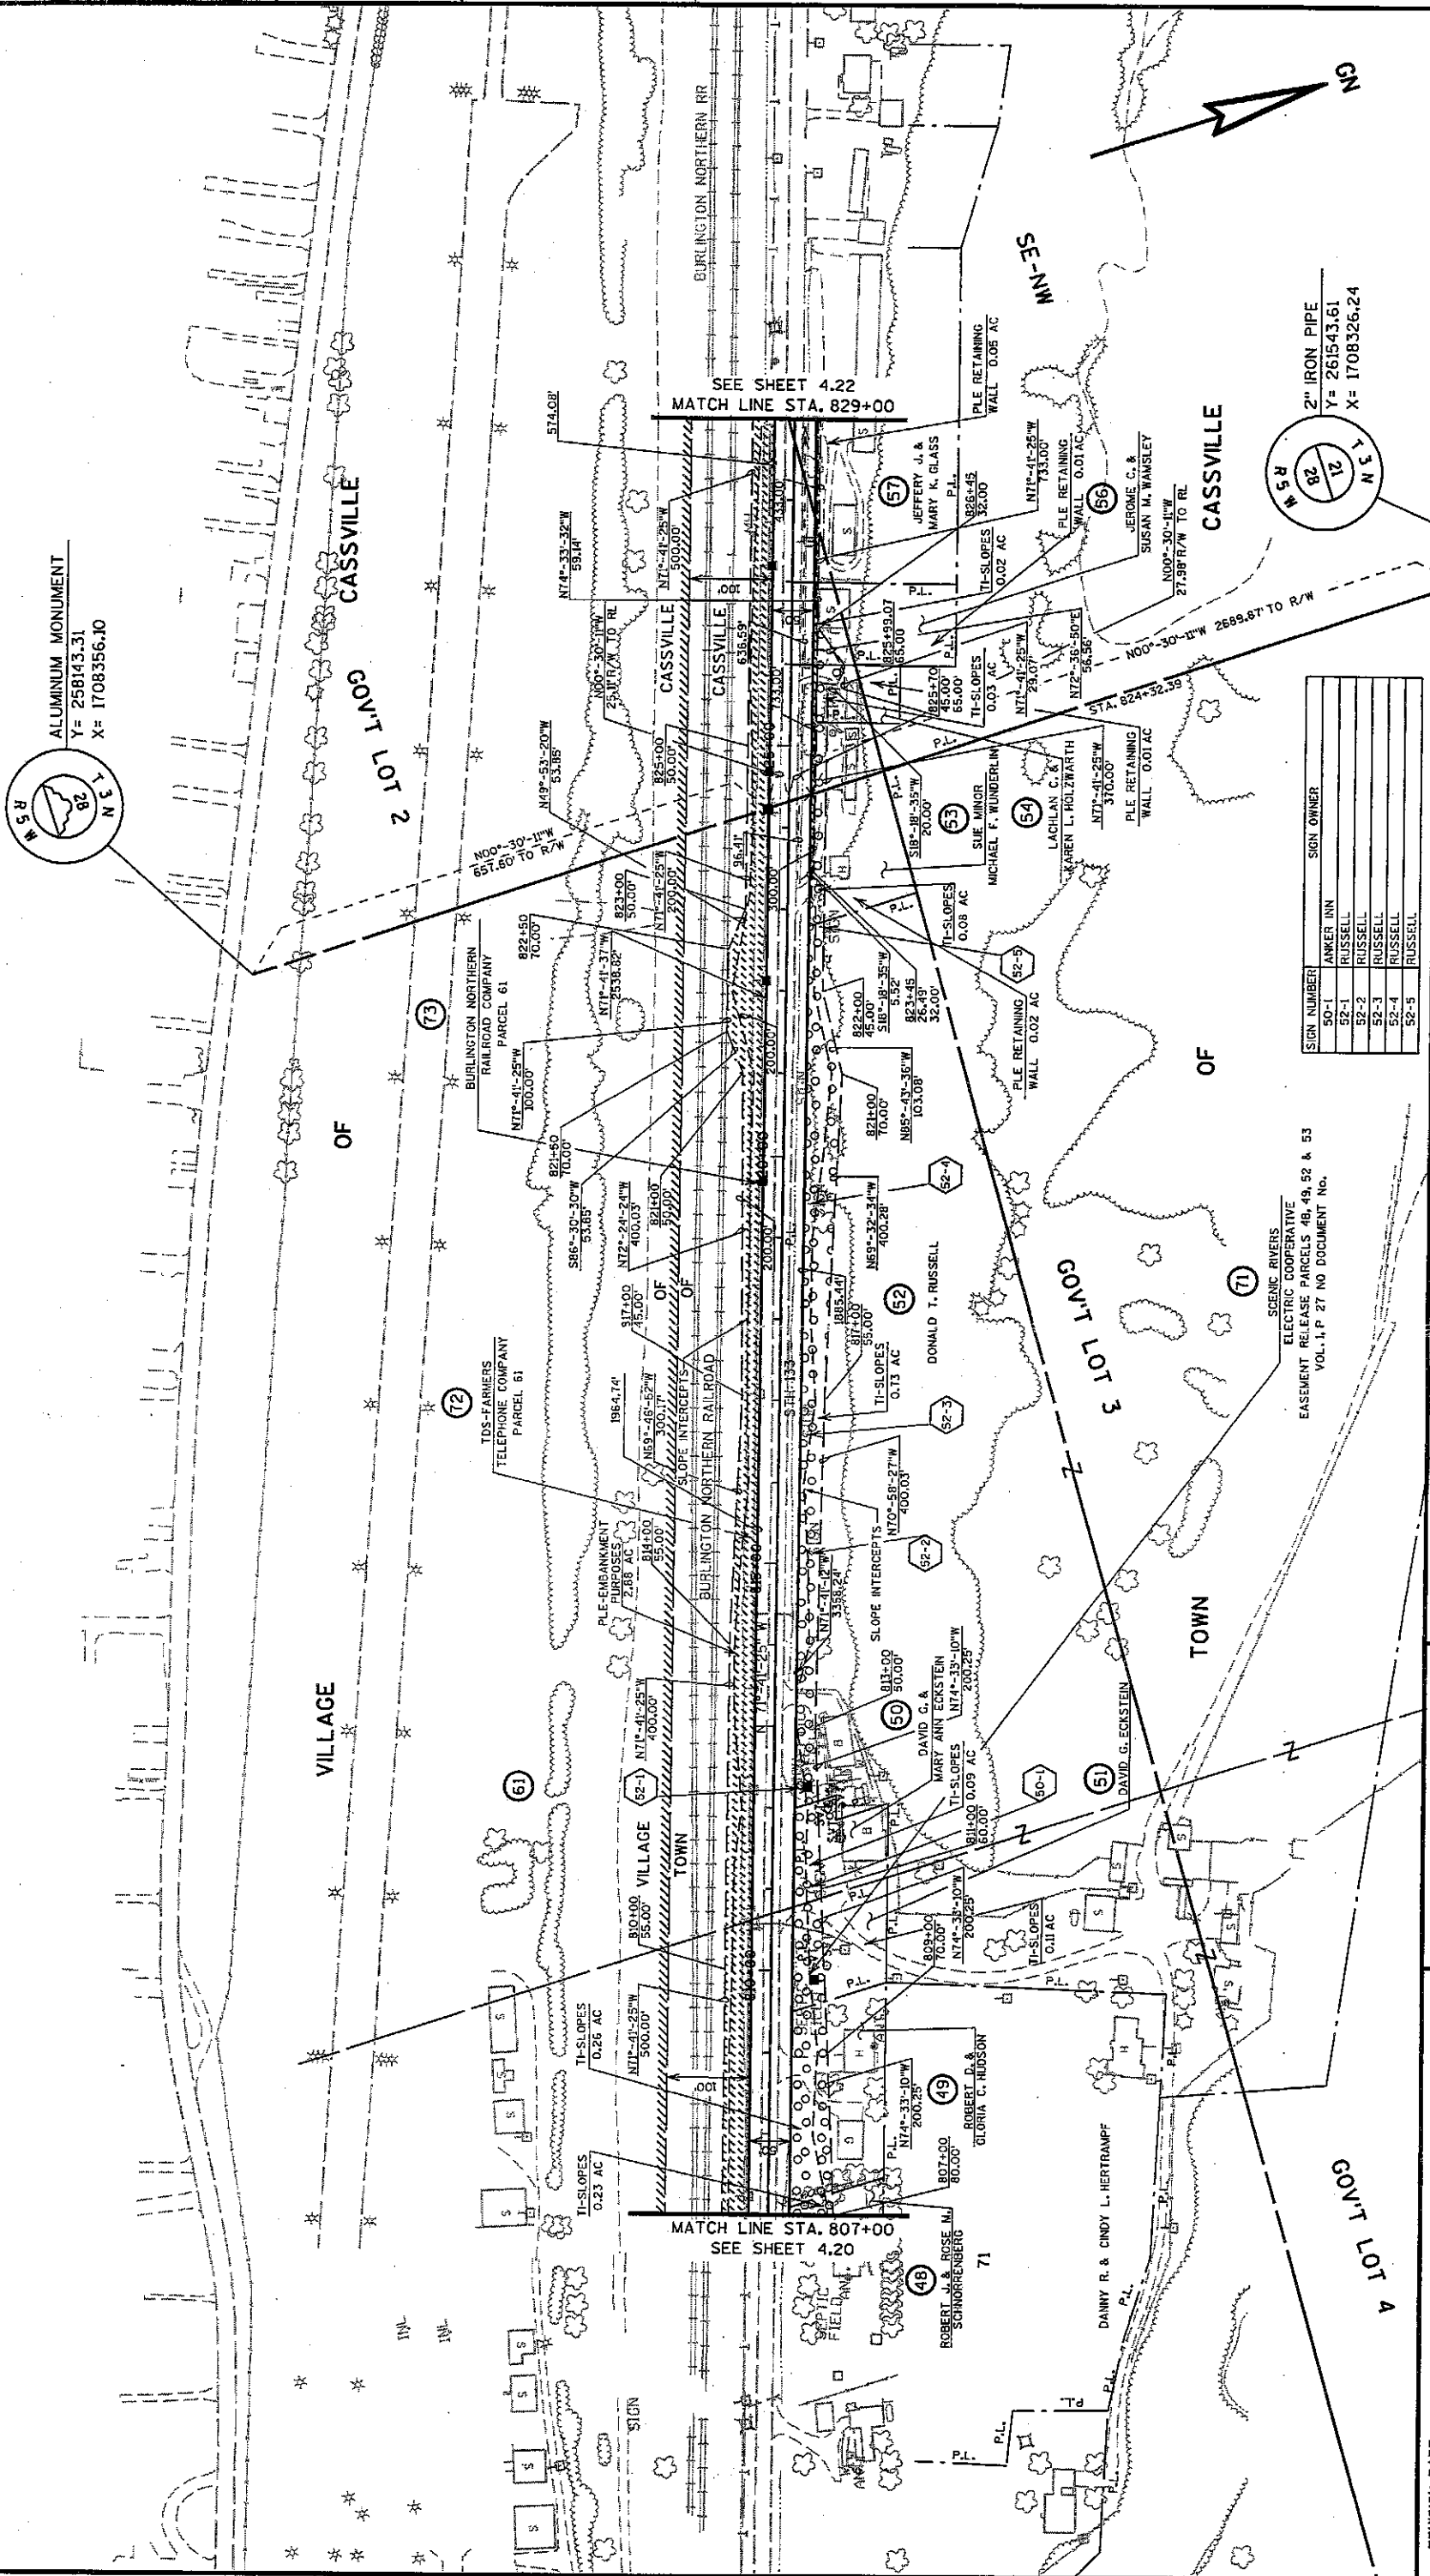

2\"/>

SIGN NUMBER	SIGN OWNER
50-1	JANER INN
52-1	RUSSELL
52-2	RUSSELL
52-3	RUSSELL
52-4	RUSSELL
52-5	RUSSELL

SCENIC RIVERS
ELECTRIC COOPERATIVE
EASEMENT RELEASE PARCELS 48, 49, 52 & 53
VOL. 1, P. 27 NO DOCUMENT NO.

REVISION DATE NOV. 11, 2005	DATE AUG. 27, 2004	SCALE, FEET 0 100 200	HWY: STH 133	STATE R/W PROJECT NUMBER 5205-03-23	PLAT SHEET NO: 4.21
	GRID FACTOR 0.99996	COUNTY: GRANT	CONSTRUCTION PROJECT NUMBER	PS&E SHEET	E
FILE NAME : g:\n\form\109841\w\941r\w421.dgn					
PLOT DATE : 10 NOV 2005					
PLOT BY : KL Engineer\jng					
PLOT NAME :					
PLOT SCALE :					
WISDOT/CADDs SHEET 75					

