



Wisconsin Department of Transportation

April 28, 1995

TRANSPORTATION DISTRICT 1
2101 Wright Street
Madison, WI 53704-2583

Dorothea Eck
Grant County Clerk
130 W. Maple St.
Lancaster, WI 53813



Dear Dorothea:

MAY 2 1995

Project I.D. 5616-00-21
Blue River - Muscoda Rd
CTH T - Blue River Bridge
STH 133 - Grant County

The Department of Transportation deems it necessary to make certain revisions to a previously approved Right-of-Way Plat and to acquire certain lands and interests therein, according to such revisions, for the proper improvement or maintenance of the above-designated project and highway.

Sections 84.09(1) and 32.05(1)(a) of Wisconsin Statutes state, in part, that a copy of the Department's Relocation Order and Right-of-Way plat shall be filed, within 20 days after its issue, with the county clerk and county highway committee of each county in which such lands or interests are required. It is the intent of this submittal to comply with that law and provide you with a copy to file of the Relocation Order and Right-of-Way Plat for the project. The Relocation Order also indicates by whom the right-of-way will be acquired.

The original of this approved Relocation Order will be retained in this office.

Sincerely,

Gary Plummer

Gary Plummer
Real Estate Agent

Enclosure

cc: County Highway Commissioner
Central Office Real Estate

RELOCATION ORDER - Revised

RE3006 88 (Replaces RO572)
Wisconsin Department of Transportation
Division of Highways and Transportation Services

Project	Name of Road	Highway	County
5616-00-21	Blue River - Muscoda Road	STH 133	Grant
Right of Way Plat Date	Plat Sheet Numbers	Date of Previously Approved Relocation Order	
11-1-94	4.0 - 4.2	6-1-93	

Description of Termini of Project

Beginning at a point 756.21 feet North of and 38.88 feet East of the West $\frac{1}{4}$ Corner of Section 12, T-8-N, R-2-W; thence continuing to a point 776.88 feet South of and 2540.62 feet East of the NW Section Corner of Section 12, T-8-N, R-2-W.

To properly establish, lay out, widen, enlarge, extend, construct, reconstruct, improve, or maintain a portion of the highway designated above, it is necessary to relocate or change and acquire certain lands or interest in lands as shown on the right of way plat for the above project.


To effect this change, pursuant to authority granted under Sections 84.02(3) and 84.09, Wisconsin Statutes, the Department of Transportation orders that:

1. The said highway is laid out and established to the lines and widths as shown on the plat.
2. The required lands or interests in lands as shown on the plat shall be acquired by the Division of Highways and Transportation Services, in the name of the State of Wisconsin, pursuant to the provisions of Section 84.09(1) or (2), Wisconsin Statutes.
3. This order supersedes and amends any previous order issued by the Department.

Date

4-27-95

District Real Estate Manager

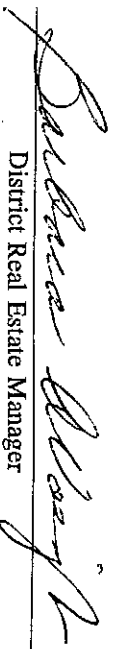

[illegible]

TELEPHONE
SERVICE PEDESTAL
CABLE MARKER
SECTION CORNER

756.21' NORTH OF AND 38.88' EAST OF THE WEST
1/4 CORNER OF SECTION 12, T-B-N, R-2-W

776.8' SOUTH OF AND 2540.62' EAST OF THE
NORTHWEST SECTION CORNER SECTION 12 T-8-N, R-2-W

FEDERAL PROJEC

S.T.H. 133

GRANT COUNTY

SLOPE INTERCEPT
 ORIGINAL GROUND
 MARSH OR ROCK PROFILE
 CULVERT IN PLACE
 CULVERT REQUIRED
 CULVERT REQUIRED (Profile)
 FENCE
 TEMPORARY LIMITED
 EASEMENT
 PERMANENT LIMITED
 EASEMENT
 BEAM GUARD
 TRANSMISSION
 TOWER AND LINE
 BUILDING
 HOUSE
 GARAGE
 SHED
 NOT TO SCALE
 CORNER
 LONG CHORD
 LONG CHORD BEARING
 RADIUS
 REFERENCE LINE

SLOPE INTERCEPT
 RAILROADS
 MARSH
 WOODED AREA
 GAS PUMPS
 BUSHES
 TREES
 (DECIDUOUS)
 (CONIFEROUS)
 IRON PIN, IRON ROD
 R/W MONUMENT
 WINDMILL
 SIGN MONUMENT,
 SEPTIC VENT, WELL, ETC.
 VALVE
 GAS (TYPE)


COMPENSABLE
 NON-COMPENSABLE
 POWER POLE
 TELEPHONE
 NO ACCESS (BY ACQUISITION)
 NO ACCESS (BY STATUTORY AUTHORITY)
 NO ACCESS (BY PREVIOUS PROJECT)

DIMENSIONING FOR THE NEW R/W IS MEASURED ALONG AND PERPENDICULAR TO THE NEW REFERENCE LINES.

COORDINATES AND BEARINGS ON THIS PLAT ARE ORIENTED TO THE WISCONSIN COORDINATE SYSTEM SOUTH ZONE, NAD 83. ALL PLAT DISTANCES ARE GROUND LENGTH AND MAY BE CONVERTED TO GRID LENGTH BY MULTIPLYING THE DISTANCE BY THE GRID FACTOR PROVIDED ON THE DETAIL SHEETS.

RIGHT OF WAY MONUMENTS ARE TYPE 2 AND ARE PLACED PRIOR TO OR AT THE TIME OF LAND TITLE TRANSFER.

RIGHT OF WAY BOUNDARIES ARE DEFINED WITH COURSES OF THE PERIMETER OF THE HIGHWAY LANDS REFERENCED TO THE U.S. PUBLIC LAND SURVEY OR OTHER SURVEYS OF PUBLIC RECORD.

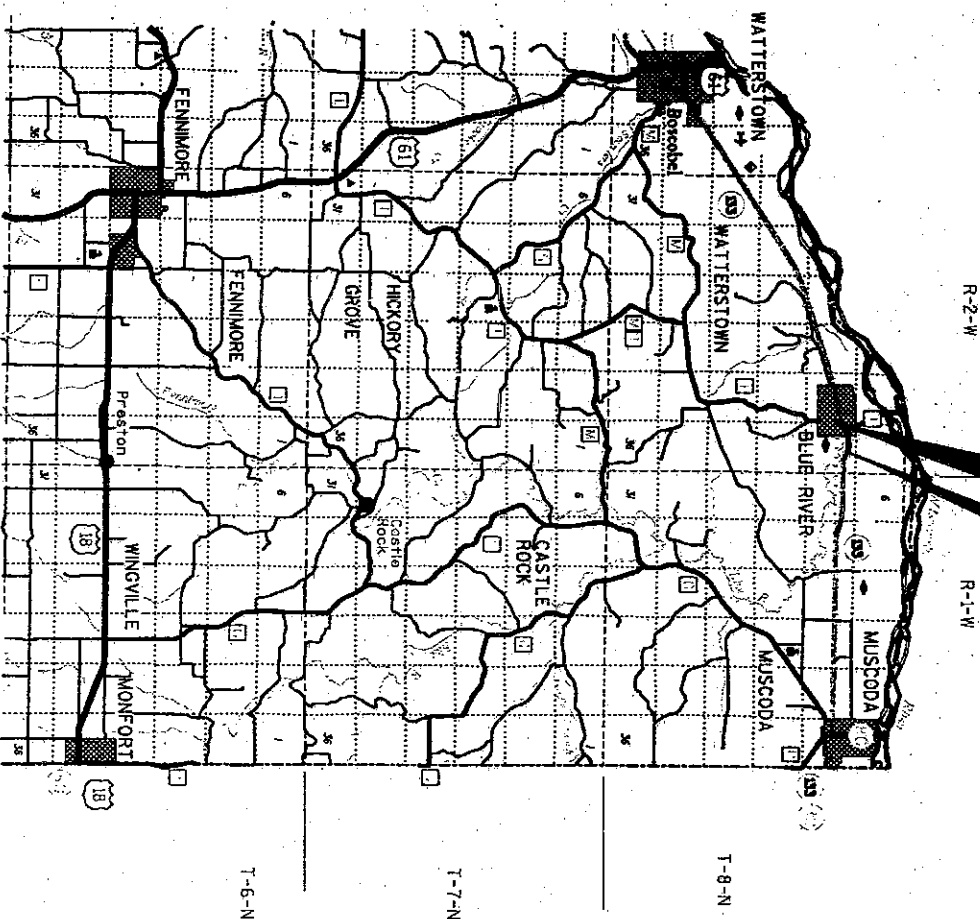

EXISTING HIGHWAY RIGHT-OF-WAY SHOWN HEREIN IS BASED ON THE FOLLOWING POINTS OF REFERENCE AS SPECIFIED ON EACH PLAT DETAIL SHEET:
EXISTING S.T.H. 133 CENTERLINE OF PAVEMENT, GRANT COUNTY HIGHWAY DEED "H.C.-44" RECORDED MAY 13, 1935 AND GRANT COUNTY HIGHWAY DEED "H.C.-427" RECORDED NOV. 7, 1935

LAYOUT

SCALE 0 2 MI

TOTAL NET LENGTH OF CENTERLINE = 0.548 MI.

REVISION DATE
11-1-94 N.C.
4-1-95 N.C.

STATE OF WISCONSIN
DEPARTMENT OF TRANSPORTATION

APPROVED:

DAI 5-6-93 *Kevin Chavira*

for DISTRICT DIRECTOR

FILE NAME

WISDOT/CADOS SHEET 50

SCHEDULE OF LANDS & INTERESTS REQUIRED

AREAS SHOWN IN THE TOTAL ACRES COLUMN MAY BE APPROXIMATE AND ARE DERIVED FROM TAX ROLLS OR OTHER AVAILABLE SOURCES AND MAY NOT INCLUDE LANDS OF THE OWNER WHICH ARE NOT CONTIGUOUS TO THE AREA TO BE ACQUIRED.

REVISION DATE
11-1-94
4-1-95

ROUTE
STH 133

COUNTY
GRANT CO.

DATE
5-6-93

R/W PROJECT NUMBER
5616-00-21

FEDERAL PROJECT NUMBER

SHEET NUMBER
4.1

PARCEL NUMBER	SHEET NUMBER	OWNERS	INTEREST REQUIRED	TOTAL ACRES OR S.F.	R/W ACRES OR S.F.		TOTAL ACRES OR S.F. REMAINING	P.L.E. OR T.L.E. ACRES OR S.F.
					NEW	REQUIRED EXISTING	TOTAL	
1	4.2	GREGORY K. & JOANN E. TISDALE	FEE & T.L.E.	0.62	0.50	-	0.50	0.12
2	4.2	RICHLAND - GRANT TELEPHONE COOPERATIVE, INC.	FEE	0.26	0.02	-	0.02	0.24
3	4.2	EDWARD L. & PATRICIA M. NACHTIGAL	TLE	10,000 S.F.	-	-	-	60 S.F.
4	4.2	CLIFFORD W. POST	FEE & T.L.E.	131.88	7.26	1.28	8.54	0.95
5	4.2	VILLAGE OF BLUE RIVER	FEE	1.79	0.03	0.29	0.32	-
7	4.2	WISCONSIN DEPARTMENT OF TRANSPORTATION BUREAU OF RAILROADS & HARBORS	T.L.E.	-	-	-	-	0.09
12	4.2	RICHLAND - GRANT TELEPHONE COOPERATIVE, INC.	RELEASE OF RIGHTS	-	-	-	-	-

NOTE: ALL PARCELS ARE COMPUTED IN ACRES UNLESS OTHERWISE INDICATED

