



## Wisconsin Department of Transportation



TRANSPORTATION DISTRICT 1  
2101 Wright Street  
Madison, WI 53704-2583

Telephone (608) 246-5367  
FAX (608) 246-3819

April 4, 2003

Chris Carl  
Grant County Clerk  
111 S. Jefferson  
Lancaster, WI 53813

SUBJECT: Project ID 5616-02-21  
Blue River - Muscoda Road  
STH 133  
Grant County



Dear Ms. Carl:

The Department of Transportation deems it necessary to make certain revisions to a previously approved Right-of-Way Plat and to acquire certain lands and interests therein, according to such revisions, for the proper improvement or maintenance of the above-designated project and highway.

Sections 84.09(1) and 32.05(1)(a) of Wisconsin Statutes state, in part, that a copy of the Department's Relocation Order and Right-of-Way Plat shall be filed, within 20 days after its issue, with the county clerk and county highway committee of each county in which such lands or interests are required. It is the intent of this submittal to comply with that law and provide you with a copy to file of the Relocation Order and Right-of-Way Plat for the project. The Relocation Order also indicates by whom the right-of-way will be acquired.

The original of this approved Relocation Order will be retained in this office.

Sincerely,

*Bob Rogers*  
Bob Rogers  
Real Estate Agent

Enclosure

cc: County Highway Commissioner  
Central Office Real Estate

# PROJECT COST ALLOCATION

DT1632 4/2000 (Replaces RE 3021)

Wisconsin Department of Transportation

To: Bureau of State Highway Programs  
Program Finance Section, Room #951

From: Real Estate Management District 1

|                                |        |
|--------------------------------|--------|
| Design Study Report Date       | N/A    |
| Relocation Plan Approval Date  | N/A    |
| Relocation Order Approval Date | 4/1/03 |

Project  
5616-02-21  
Blue River - Muscoda Road

|               |
|---------------|
| BSHP Approval |
|---------------|

STH 133  
Grant County

|                             |      |
|-----------------------------|------|
| BHRE Finance Unit Use Only: |      |
| Order Number Assigned       |      |
| Initials                    | Date |

☐ Original  
☒ Revision # 1 ☐ Final  
☐ Phased Project ID \_\_\_\_\_

☐ 5550 - State  
☐ 5526 - County  
☐ 5531 - Local

## NON-DELIVERY

- Estimated right of way costs of all parcels (exclusive of reimbursable utilities.) See attached Parcel Cost Estimate. \$ 0.00
- Estimated relocation assistance and moving costs. \$ \$0.00
- Amount to be encumbered. (Total of Lines 1 & 2) \$ \$0.00
- Other contracts for razing, site clearance. \$ \$0.00

## DELIVERY

- Estimated Labor Costs \$ \$0.00
- Contracts (Title, Appraisals, etc.) \$ \$0.00
- Total Delivery \$ \$0.00
- Percent of delivery (5c. divided by Line 3) 0.00 %

6. Total Acquisition Cost Estimate: (Total of Lines 3, 4 & 5c) \$ \$0.00

7. Total number of parcels on plat. Previous 59  
+ or - Revised 0  
Total 59

## 8. Project Concepts

To record several plat changes. No additional funds to be encumbered at this time.

There are 5 utility parcels in addition to the above.

(District Planning Section)

(Date)

(District Real Estate Representative)

(Date)

**RELOCATION ORDER**  
Wisconsin Department of Transportation  
DT1708 2000 (Replaces RES005)

| Project                | Name of Road              | Highway                                      | County |
|------------------------|---------------------------|----------------------------------------------|--------|
| 5616-02-21             | Blue River - Muscoda Road | STH 133                                      | Grant  |
| Right of Way Plat Date | Plat Sheet Numbers        | Date of Previously Approved Relocation Order |        |
| 2/21/03                | 4.1 - 4.25                | 2/14/03                                      |        |


**Description of Termini of Project**

Beginning at a point 766.25 feet South of and 134.27 feet West of the North quarter corner of Section 12, Town 8 North, Range 2 West; thence continuing to a point 2050.85 feet South of and 40.20 feet West of the Northeast corner of Section 11, Town 8 North, Range 1 West.

To properly establish, lay out, widen, enlarge, extend, construct, reconstruct, improve, or maintain a portion of the highway designated above, it is necessary to relocate or change and acquire certain lands or interests in lands as shown on the right of way plat for the above project.

To effect this change, pursuant to authority granted under Sections 84.02(3) and 84.09, Wisconsin Statutes, the Department of Transportation orders that:

1. The said highway is laid out and established to the lines and widths as shown on the plat.
2. The required lands or interests in lands as shown on the plat shall be acquired by the Division of Transportation Districts in the name of the State of Wisconsin, Division of Transportation Infrastructure Development, pursuant to the provisions of Section 84.09(1) or (2), Wisconsin Statutes.
3. This order supersedes and amends any previous order issued by the Department.

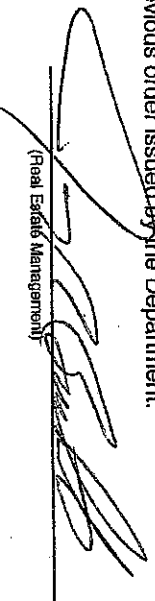  
(Road Estate Management)

4/1/03  
(Date)

Project No.  
5616-02-71

Relocation Order No.  
5616-02-21

Record of Revisions to Right of Way Plat

Highway:  
STH 133

County:  
GRANT

*Original*

| Parcel No. | Sheet No. | Date      | Description of Revisions                             | D | S | L |
|------------|-----------|-----------|------------------------------------------------------|---|---|---|
|            | ALL       | 2/21/2003 | ADDED REVISION DATE                                  | X | X | X |
| 2          | 4.2       | 2/21/2003 | CHANGED NAME AND ACREAGES                            |   | X | X |
| 6          | 4.2       | 2/21/2003 | CHANGED ACREAGES                                     |   | X | X |
| 14         | 4.2       | 2/21/2003 | CHANGED NAME                                         |   | X |   |
| 22         | 4.2       | 2/21/2003 | CHANGED NAME                                         |   | X |   |
| 23         | 4.2       | 2/21/2003 | CHANGED NAME                                         |   | X |   |
| 42         | 4.2       | 2/21/2003 | CHANGED NAME                                         |   | X |   |
| 57         | 4.2       | 2/21/2003 | CHANGED NAME                                         | X |   |   |
| 43         | 4.3       | 2/21/2003 | CHANGED NAME                                         |   | X |   |
| 46         | 4.3       | 2/21/2003 | CHANGED NAME                                         |   | X |   |
| 49         | 4.3       | 2/21/2003 | CHANGED NAME                                         |   | X |   |
| 57         | 4.3       | 2/21/2003 | CHANGED NAME                                         |   | X |   |
| 62         | 4.3       | 2/21/2003 | CHANGED NAME                                         |   | X |   |
| 64         | 4.3       | 2/21/2003 | CHANGED NAME                                         |   | X |   |
| 2          | 4.4       | 2/21/2003 | PARCEL DIVIDED, HALF ADDED TO PARCEL 6               | X |   |   |
| 2          | 4.6       | 2/21/2003 | PARCEL DIVIDED, HALF ADDED TO PARCEL 6, CHANGED NAME | X |   | X |
| 6          | 4.6       | 2/21/2003 | LAND FROM PARCEL 2 ADDED TO PARCEL 6                 | X |   | X |
| 14         | 4.7       | 2/21/2003 | CHANGED NAME                                         | X |   |   |
| 14         | 4.8       | 2/21/2003 | CHANGED NAME                                         | X |   |   |
| 22         | 4.9       | 2/21/2003 | CHANGED NAME                                         | X |   |   |
| 22         | 4.10      | 2/21/2003 | CHANGED NAME                                         | X |   |   |
| 23         | 4.10      | 2/21/2003 | CHANGED NAME                                         | X |   |   |
| 22         | 4.11      | 2/21/2003 | CHANGED NAME                                         | X |   |   |
| 23         | 4.11      | 2/21/2003 | CHANGED NAME                                         | X |   |   |
| 32         | 4.14      | 2/21/2003 | SIGN ADDED                                           | X |   |   |
| 42         | 4.18      | 2/21/2003 | CHANGED NAME                                         | X |   |   |
| 43         | 4.18      | 2/21/2003 | CHANGED NAME                                         | X |   |   |
| 46         | 4.19      | 2/21/2003 | CHANGED NAME                                         | X |   |   |
| 49         | 4.19      | 2/21/2003 | CHANGED NAME                                         | X |   |   |
| 62         | 4.23      | 2/21/2003 | CHANGED NAME                                         | X |   |   |
| 64         | 4.23      | 2/21/2003 | CHANGED NAME                                         | X |   |   |

D = Detail Sheet  
S = Schedule Sheet  
L = Legal Description



SCHEDULE OF LANDS & INTERESTS REQUIRED



| PARCEL NUMBER | SHEET NUMBER  | OWNER                                                      | INTEREST REQUIRED | TOTAL ACRES | NEW  | R/W ACRES REQUIRED EXISTING | TOTAL | TOTAL ACRES REMAINING | T.I. ACRES |
|---------------|---------------|------------------------------------------------------------|-------------------|-------------|------|-----------------------------|-------|-----------------------|------------|
| 1             | 4.5-4.6       | BEVERLY LILLIAN POST                                       | FEE               | 97.00       | 0.48 | 0.69                        | 1.17  | 95.83                 | -          |
| 2             | 4.6           | VICTOR R. AND TAMALA J. POWELL                             | FEE               | 2.06        | 0.03 | 0.14                        | 0.17  | 1.89                  | -          |
| 3             | 4.6           | JEROD S. AND NANCY J. FRAZIER                              | FEE, T.I.         | 48.00       | 0.45 | 0.82                        | 1.28  | 46.72                 | 0.01       |
| 4             | 4.6           | TAMALA J. POWELL                                           | FEE               | 1.11        | 0.03 | 0.10                        | 0.13  | 0.98                  | -          |
| 5             |               |                                                            |                   |             |      |                             |       |                       |            |
| 6             | 4.6           | ROONEY L. PASOLD                                           | FEE               | 2.83        | 0.13 | 0.45                        | 0.58  | 2.25                  | -          |
| 7             | 4.6-4.9       | CLOVERLAND FARMS, INC., A WISCONSIN CORPORATION            | FEE               | 267.80      | 0.89 | 2.37                        | 3.26  | 264.54                | -          |
| 8             | 4.6           | PAUL J. GASSERE                                            | FEE               | 5.00        | 0.08 | 0.25                        | 0.33  | 4.67                  | -          |
| 9             | 4.6-4.7       | BLUE RIVER RIFLE AND PISTOL CLUB                           | FEE               | 34.00       | 0.21 | 0.44                        | 0.65  | 33.35                 | -          |
| 10            |               |                                                            |                   |             |      |                             |       |                       |            |
| 11            | 4.7           | IRENE DIENES                                               | FEE, T.I.         | 15.20       | 0.30 | -                           | 0.30  | 14.90                 | 0.01       |
| 12            | 4.7           | WILLIAM R. AND REBECCA J. KAGEL                            | FEE, T.I.         | 3.00        | 0.03 | 0.11                        | 0.14  | 2.86                  | 0.01       |
| 13            | 4.7           | DONNIE J. AND DARLA J. KARASEK                             | FEE, T.I.         | 3.00        | 0.03 | 0.11                        | 0.14  | 2.86                  | 0.01       |
| 14            | 4.7-4.8       | WILLIAM H. AND JENNY L. JESSEN                             | FEE, T.I.         | 16.66       | 0.09 | -                           | 0.09  | 16.57                 | 0.01       |
| 15            |               |                                                            |                   |             |      |                             |       |                       |            |
| 16            | 4.8,4.20-4.21 | REYNOLDS CREDIT SHELTER, LAVON B. AND JUDY ANN REYNOLDS    | FEE               | 42.00       | 0.51 | 3.73                        | 4.24  | 37.76                 | -          |
| 17            | 4.8-4.9       | RUDOLPH M. AND JEANNE M. NIGL                              | FEE               | 40.00       | 0.28 | 1.58                        | 1.86  | 38.14                 | -          |
| 18            | 4.9           | ROBERT E. LEBRUN AND JEANNE CLOUGH                         | FEE               | 1.73        | 0.12 | 0.27                        | 0.39  | 1.34                  | -          |
| 19            | 4.9           | GERALD D. AND LAURA E. DEGENHARDT                          | FEE               | 12.36       | 0.04 | 0.15                        | 0.19  | 12.17                 | -          |
| 20            |               |                                                            |                   |             |      |                             |       |                       |            |
| 21            | 4.9-4.10      | K-J FARMS, INC., A WISCONSIN CORPORATION                   | FEE               | 25.92       | 0.24 | 1.45                        | 1.69  | 24.23                 | -          |
| 22            | 4.9-4.11      | HUNT CLUB FARM, LLC, A WISCONSIN LIMITED LIABILITY COMPANY | FEE               | 37.00       | 0.49 | 0.29                        | 0.78  | 36.22                 | -          |
| 23            | 4.10-4.11     | RONALD G. STURDEVANT                                       | FEE               | 39.00       | 0.52 | 1.66                        | 2.19  | 36.81                 | -          |
| 24            | 4.10          | BETSY R. FOUST                                             | FEE               | 1.00        | 0.04 | 0.14                        | 0.18  | 0.82                  | -          |
| 25            |               |                                                            |                   |             |      |                             |       |                       |            |
| 26            | 4.11          | SCOTT E. AND CHERIE J. KROPF                               | FEE               | 2.00        | 0.23 | -                           | 0.23  | 1.77                  | -          |
| 27            | 4.11-4.13     | WILLIAM J. AND EDNA J. TRIMM                               | FEE               | 20.00       | 0.43 | 1.97                        | 2.40  | 17.60                 | -          |
| 28            | 4.11          | NOAH E. AND ROXANNE J. MILLER                              | FEE               | 4.00        | 0.24 | -                           | 0.24  | 3.76                  | -          |
| 29            | 4.11-4.12     | EDWARD J. AND SADIE I. HEADINGS                            | FEE               | 7.00        | 0.24 | -                           | 0.24  | 6.76                  | -          |
| 30            |               |                                                            |                   |             |      |                             |       |                       |            |
| 31            | 4.13-4.14     | LAVON B. AND JUDY REYNOLDS                                 | FEE               | 48.00       | 0.25 | 4.01                        | 4.26  | 43.74                 | -          |
| 32            | 4.14          | DALE G. PADFIELD                                           | FEE               | 4.00        | 0.24 | 0.40                        | 0.64  | 3.36                  | -          |
| 33            | 4.15          | BRIAN D. BREWER                                            | FEE               | 5.28        | 0.03 | 0.38                        | 0.41  | 4.87                  | -          |
| 34            | 4.15          | GERALD W. GRIMM                                            | FEE, T.I.         | 5.60        | 0.06 | 0.40                        | 0.46  | 5.14                  | 0.01       |
| 35            |               |                                                            |                   |             |      |                             |       |                       |            |
| 36            | 4.15          | JEFFREY J. VALLEY                                          | FEE, T.I.         | 5.59        | 0.01 | 0.39                        | 0.40  | 5.19                  | 0.01       |
| 37            | 4.16          | BUCK CANYON TRUST                                          | FEE, T.I.         | 3.00        | 0.00 | 0.39                        | 0.39  | 2.61                  | 0.01       |
| 38            | 4.16          | HERBERT AND JANICE LEDBURY                                 | FEE               | 5.42        | 0.04 | 0.36                        | 0.40  | 5.02                  | -          |
| 39            | 4.16-4.17     | BONNITA M. TVRDIK                                          | FEE, T.I.         | 20.00       | 0.24 | 1.22                        | 1.46  | 18.54                 | 0.02       |
| 40            |               |                                                            |                   |             |      |                             |       |                       |            |
| 41            | 4.17-4.18     | CLARK J. AND EUNICE M. PAHLAS                              | FEE               | 20.00       | 0.22 | 2.98                        | 3.20  | 16.80                 | -          |
| 42            | 4.18          | MARDELL AND KAREN K. KROPF                                 | FEE               | 5.70        | 0.23 | 0.55                        | 0.78  | 4.92                  | -          |

|                                                                                                                                                                                                                |                |                               |                                |                       |   |
|----------------------------------------------------------------------------------------------------------------------------------------------------------------------------------------------------------------|----------------|-------------------------------|--------------------------------|-----------------------|---|
| REVISION DATE: 2-21-03                                                                                                                                                                                         | DATE: 10-17-01 | HIGHWAY: S.T.H. 133           | R/W PROJECT NUMBER: 5616-02-21 | SHEET NUMBER: 4.2     | E |
| AREAS SHOWN IN THE TOTAL ACRES COLUMN MAY BE APPROXIMATE AND ARE DERIVED FROM TAX ROLLS OR OTHER AVAILABLE SOURCES AND MAY NOT INCLUDE LANDS OF THE OWNER WHICH ARE NOT CONTIGUOUS TO THE AREA TO BE ACQUIRED. |                | COUNTY: GRANT                 | FEDERAL PROJECT NUMBER:        |                       |   |
| FILE NAME :                                                                                                                                                                                                    | ORIGINATOR :   | PLOT DATE: 88-plottingd06e-88 |                                | WISDOT/CADDs SHEET 60 |   |

LEVELS ON - 1,2,3,4,5,6,7,8,9,10,11,12,13,14,15,16,17,18,19,20,21,22,23,24,25,26,27,28,29,30,31,32,33,34,35,36,37,38,39,40,41,42,43,44,45,46,47,48,49,50,51,52,53,54,55,56,57, 58,59, 60, 62.

SCHEDULE OF LANDS & INTERESTS REQUIRED




| PARCEL<br>NUMBER | SHEET<br>NUMBER              | OWNER                                          | INTEREST<br>REQUIRED | TOTAL<br>ACRES | NEW  | R/W ACRES REQUIRED<br>EXISTING | TOTAL | TOTAL<br>ACRES<br>REMAINING | T.I.<br>ACRES |
|------------------|------------------------------|------------------------------------------------|----------------------|----------------|------|--------------------------------|-------|-----------------------------|---------------|
| 43               | 4.18                         | LLOYD KROPF                                    | FEE                  | 7.71           | 0.06 | 0.38                           | 0.44  | 7.27                        | -             |
| 44               | 4.18-4.19                    | SUSAN E. BONSE-POCIUS                          | FEE                  | 8.07           | 0.09 | 0.39                           | 0.48  | 7.59                        | -             |
| 45               |                              |                                                |                      |                |      |                                |       |                             |               |
| 46               | 4.19                         | EUGENE J. BOROWCZYK                            | FEE                  | 5.73           | 0.03 | 0.28                           | 0.31  | 5.42                        | -             |
| 47               | 4.19                         | RICKY L. TISDALE AND NANCY J. TISDALE          | FEE                  | 12.36          | 0.08 | 0.37                           | 0.45  | 11.91                       | -             |
| 48               | 4.19                         | GRANT COUNTY                                   | FEE                  | 0.50           | 0.01 | 0.07                           | 0.08  | 0.42                        | -             |
| 49               | 4.19                         | DENNIS L. AND CAROL M. GUNDERSON               | FEE, T.I.            | 2.88           | 0.03 | -                              | 0.03  | 2.85                        | 0.01          |
| 50               |                              |                                                |                      |                |      |                                |       |                             |               |
| 51               | 4.20                         | MICHAEL B. AND LORRAINE SALMON                 | FEE, T.I.            | 2.88           | 0.05 | -                              | 0.05  | 2.83                        | 0.02          |
| 52               | 4.20                         | DENNIS L. AND CAROL M. GUNDERSON               | FEE                  | 2.88           | 0.04 | -                              | 0.04  | 2.84                        | -             |
| 53               | 4.20                         | CODY G. AND ROSEMARY ADEN                      | FEE                  | 1.76           | 0.04 | -                              | 0.04  | 1.72                        | -             |
| 54               | 4.20                         | MICHAEL B. STUCKEY SR. AND KRISTINA M. STUCKEY | FEE                  | 2.88           | 0.04 | 0.45                           | 0.49  | 2.39                        | -             |
| 55               |                              |                                                |                      |                |      |                                |       |                             |               |
| 56               | 4.20                         | THEODORA W. TILLER                             | FEE                  | 2.88           | 0.05 | 0.46                           | 0.51  | 2.37                        | -             |
| 57               | 4.20                         | CURTIS J. KAUFFMAN                             | FEE                  | 2.84           | 0.10 | 0.92                           | 1.02  | 1.82                        | -             |
| 58               | 4.21-4.22                    | CLYDE J. AND CHERYL L. CARPENTER               | FEE                  | 38.20          | 0.24 | -                              | 0.24  | 37.96                       | -             |
| 59               | 4.22-4.23                    | TERRY AND HELEN MAR ADAMS                      | FEE                  | 21.10          | 0.36 | -                              | 0.36  | 20.74                       | -             |
| 60               |                              |                                                |                      |                |      |                                |       |                             |               |
| 61               | 4.22-4.23                    | NANCY J. JONES                                 | FEE                  | 5.08           | 0.03 | -                              | 0.03  | 5.05                        | -             |
| 62               | 4.23                         | ISRAEL GUTIERREZ                               | FEE                  | 5.06           | 0.05 | -                              | 0.05  | 5.01                        | -             |
| 63               | 4.23                         | NELL AND JERRY SCHELL                          | FEE                  | 0.83           | 0.03 | -                              | 0.03  | 0.80                        | -             |
| 64               | 4.23                         | RENAH J. CHITWOOD                              | FEE                  | 10.84          | 0.08 | -                              | 0.08  | 10.76                       | -             |
| 65               |                              |                                                |                      |                |      |                                |       |                             |               |
| 66               | 4.23                         | JESSE R. AND KAREN M. EWING                    | FEE                  | 0.84           | 0.05 | -                              | 0.05  | 0.79                        | -             |
| 67               | 4.23-4.24                    | JILL M. HARRIS                                 | FEE                  | 1.76           | 0.05 | -                              | 0.05  | 1.71                        | -             |
| 68               | 4.24                         | WILLIAM G. AND PENNY R. TRACY                  | FEE                  | 1.27           | 0.04 | -                              | 0.04  | 1.23                        | -             |
| 69               | 4.24                         | KATHLEEN HARMS                                 | FEE                  | 5.50           | 0.10 | -                              | 0.10  | 5.40                        | -             |
| 70               |                              |                                                |                      |                |      |                                |       |                             |               |
| 71               | 4.24-4.25                    | STEVEN J. AND LESLIE A. EWING                  | FEE                  | 9.00           | 0.06 | -                              | 0.06  | 8.94                        | -             |
| 72               | 4.24                         | DANIEL R. AND MARCI J. DOBBS                   | FEE                  | 1.00           | 0.03 | -                              | 0.03  | 0.97                        | -             |
| 73               | 4.25                         | LOUISE E. ROBINSON                             | FEE                  | 1.00           | 0.01 | -                              | 0.01  | 0.99                        | -             |
| 74               | 4.5-4.13, 4.17               | RICH AND GRANT TELEPHONE COOPERATIVE, INC.     | RELEASE OF RIGHTS    | --             | --   | -                              | --    | --                          | -             |
| 75               |                              |                                                |                      |                |      |                                |       |                             |               |
| 76               | 4.5, 4.7-4.14,<br>4.18, 4.20 | SCENIC RIVERS ENERGY CORPORATION               | RELEASE OF RIGHTS    | --             | --   | -                              | --    | --                          | -             |
| 77               | 4.21                         | VERIZON NORTH, INC.                            | RELEASE OF RIGHTS    | --             | --   | -                              | --    | --                          | -             |
| 78               | 4.22-4.24                    | NORTHERN NATURAL GAS COMPANY                   | RELEASE OF RIGHTS    | --             | --   | -                              | --    | --                          | -             |
| 79               | 4.23, 4.24                   | MUSCODA LIGHT AND POWER COMPANY                | RELEASE OF RIGHTS    | --             | --   | -                              | --    | --                          | -             |

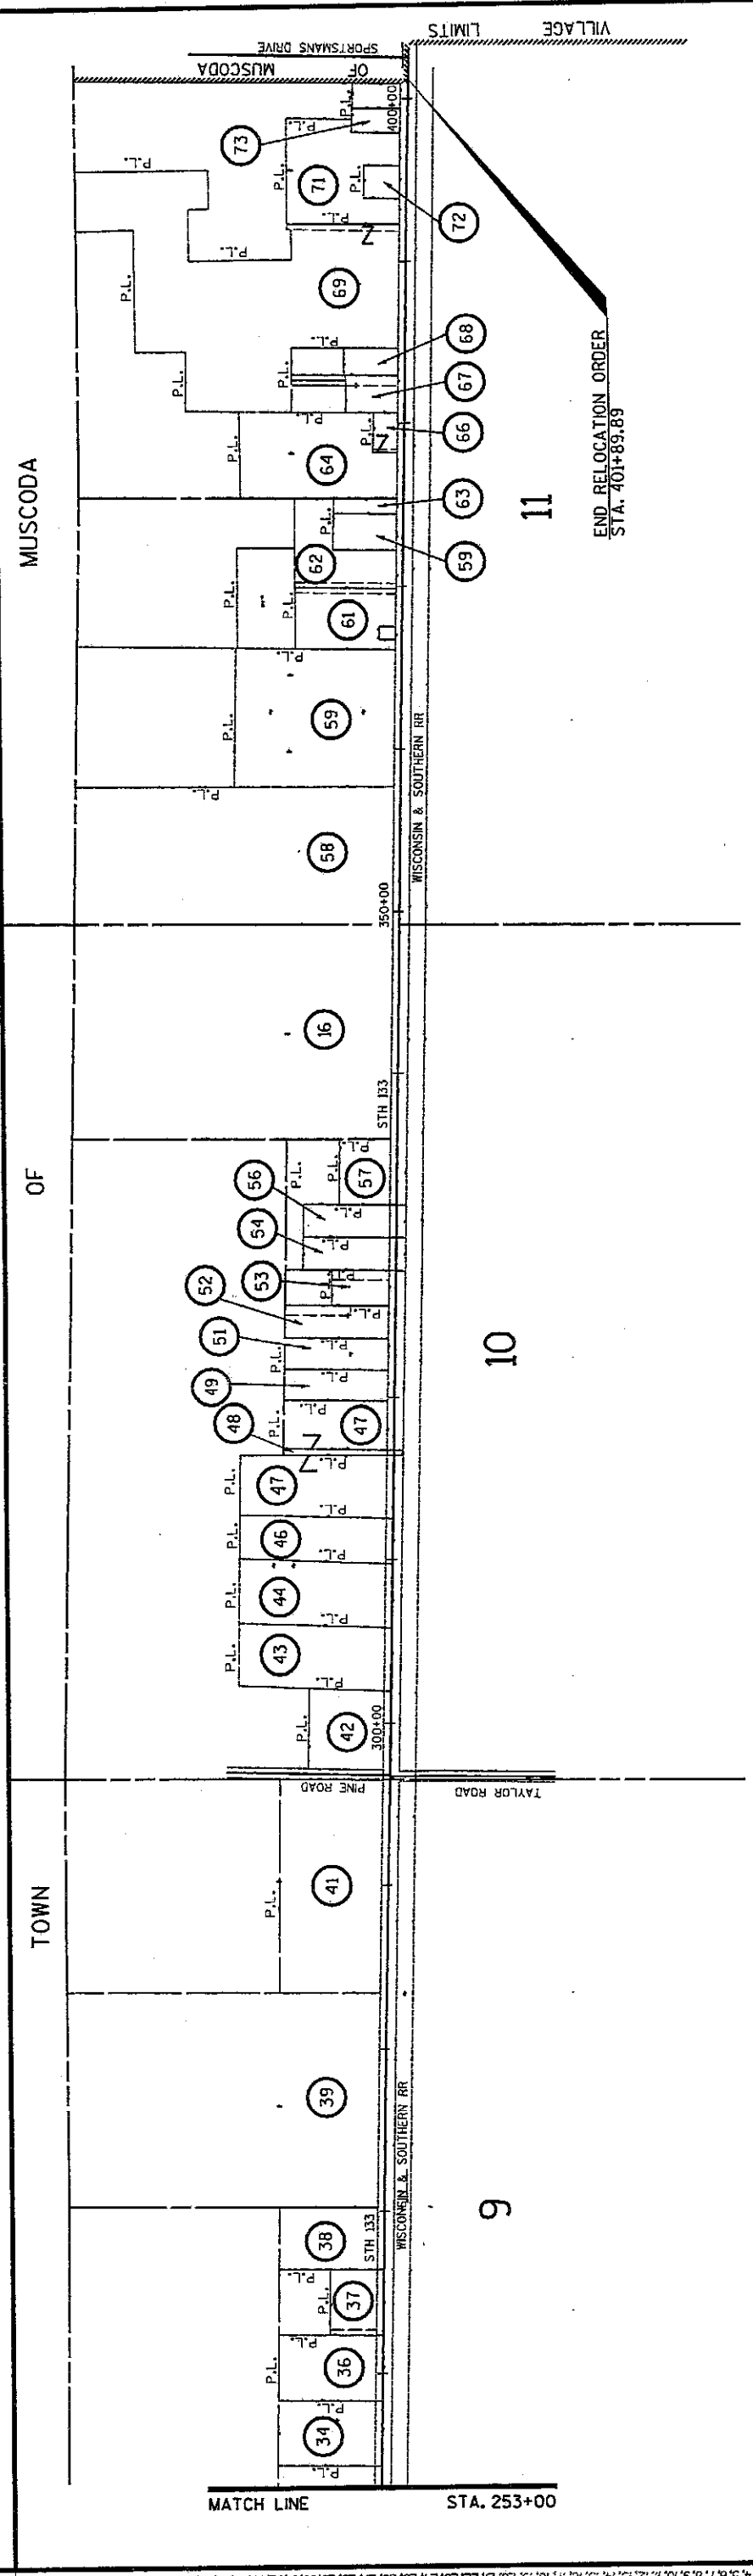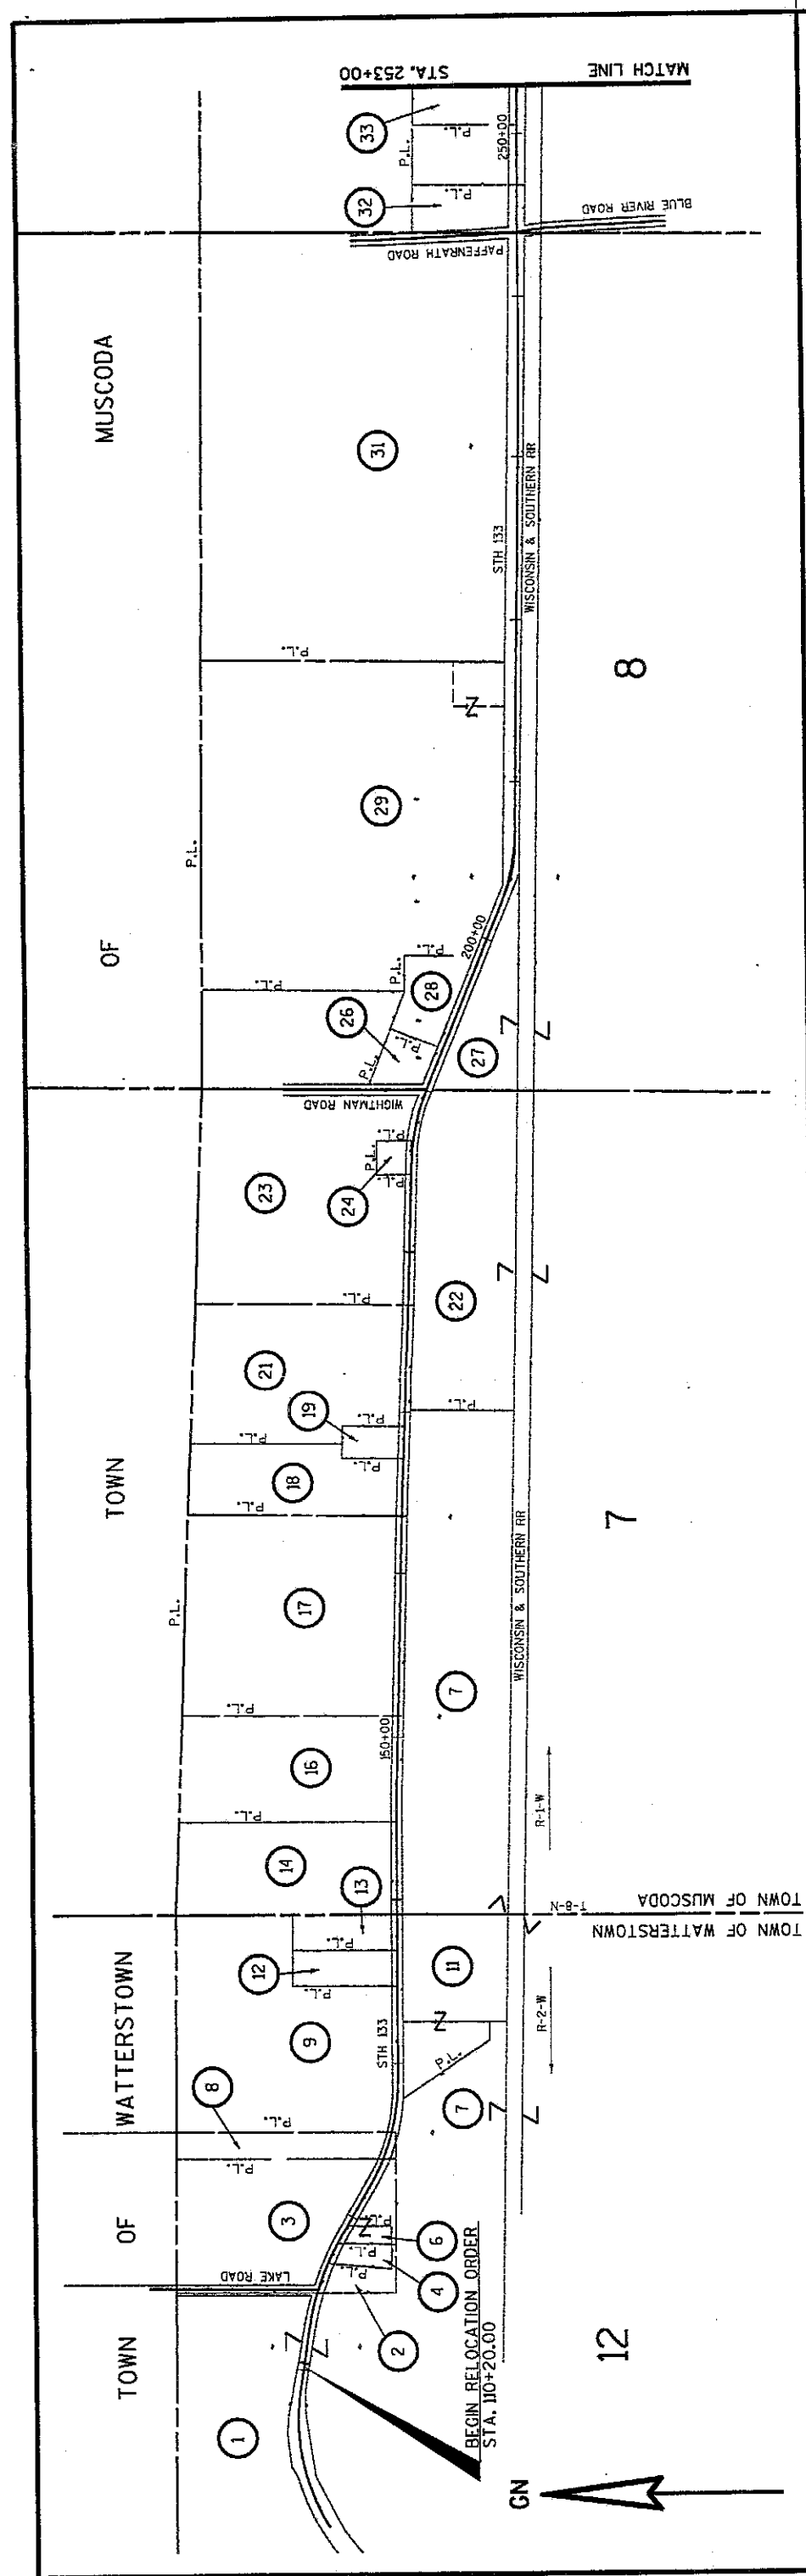


|                        |                           |                |                     |                                |                      |   |
|------------------------|---------------------------|----------------|---------------------|--------------------------------|----------------------|---|
| REVISION DATE: 2-21-03 | SCALE, FEET: NOT TO SCALE | DATE: 10-17-01 | HIGHWAY: S.T.H. 133 | R/W PROJECT NUMBER: 5616-02-21 | SHEET NUMBER: 4.4    | E |
|                        |                           |                | COUNTY: GRANT       | FEDERAL PROJECT NUMBER:        |                      |   |
| PLOT NAME :            |                           |                | PLOT DATE: 00-00-00 |                                | WISDOT/CADD SHEET 75 |   |

1

 P.I. = 115+63.26  
Y 433,736.33  
X 1,820,321.88  
A. = 21°19'08"  
D. = 3°34'52"  
T. = 301.15'  
L. = 595.34'  
R. = 1600.00'

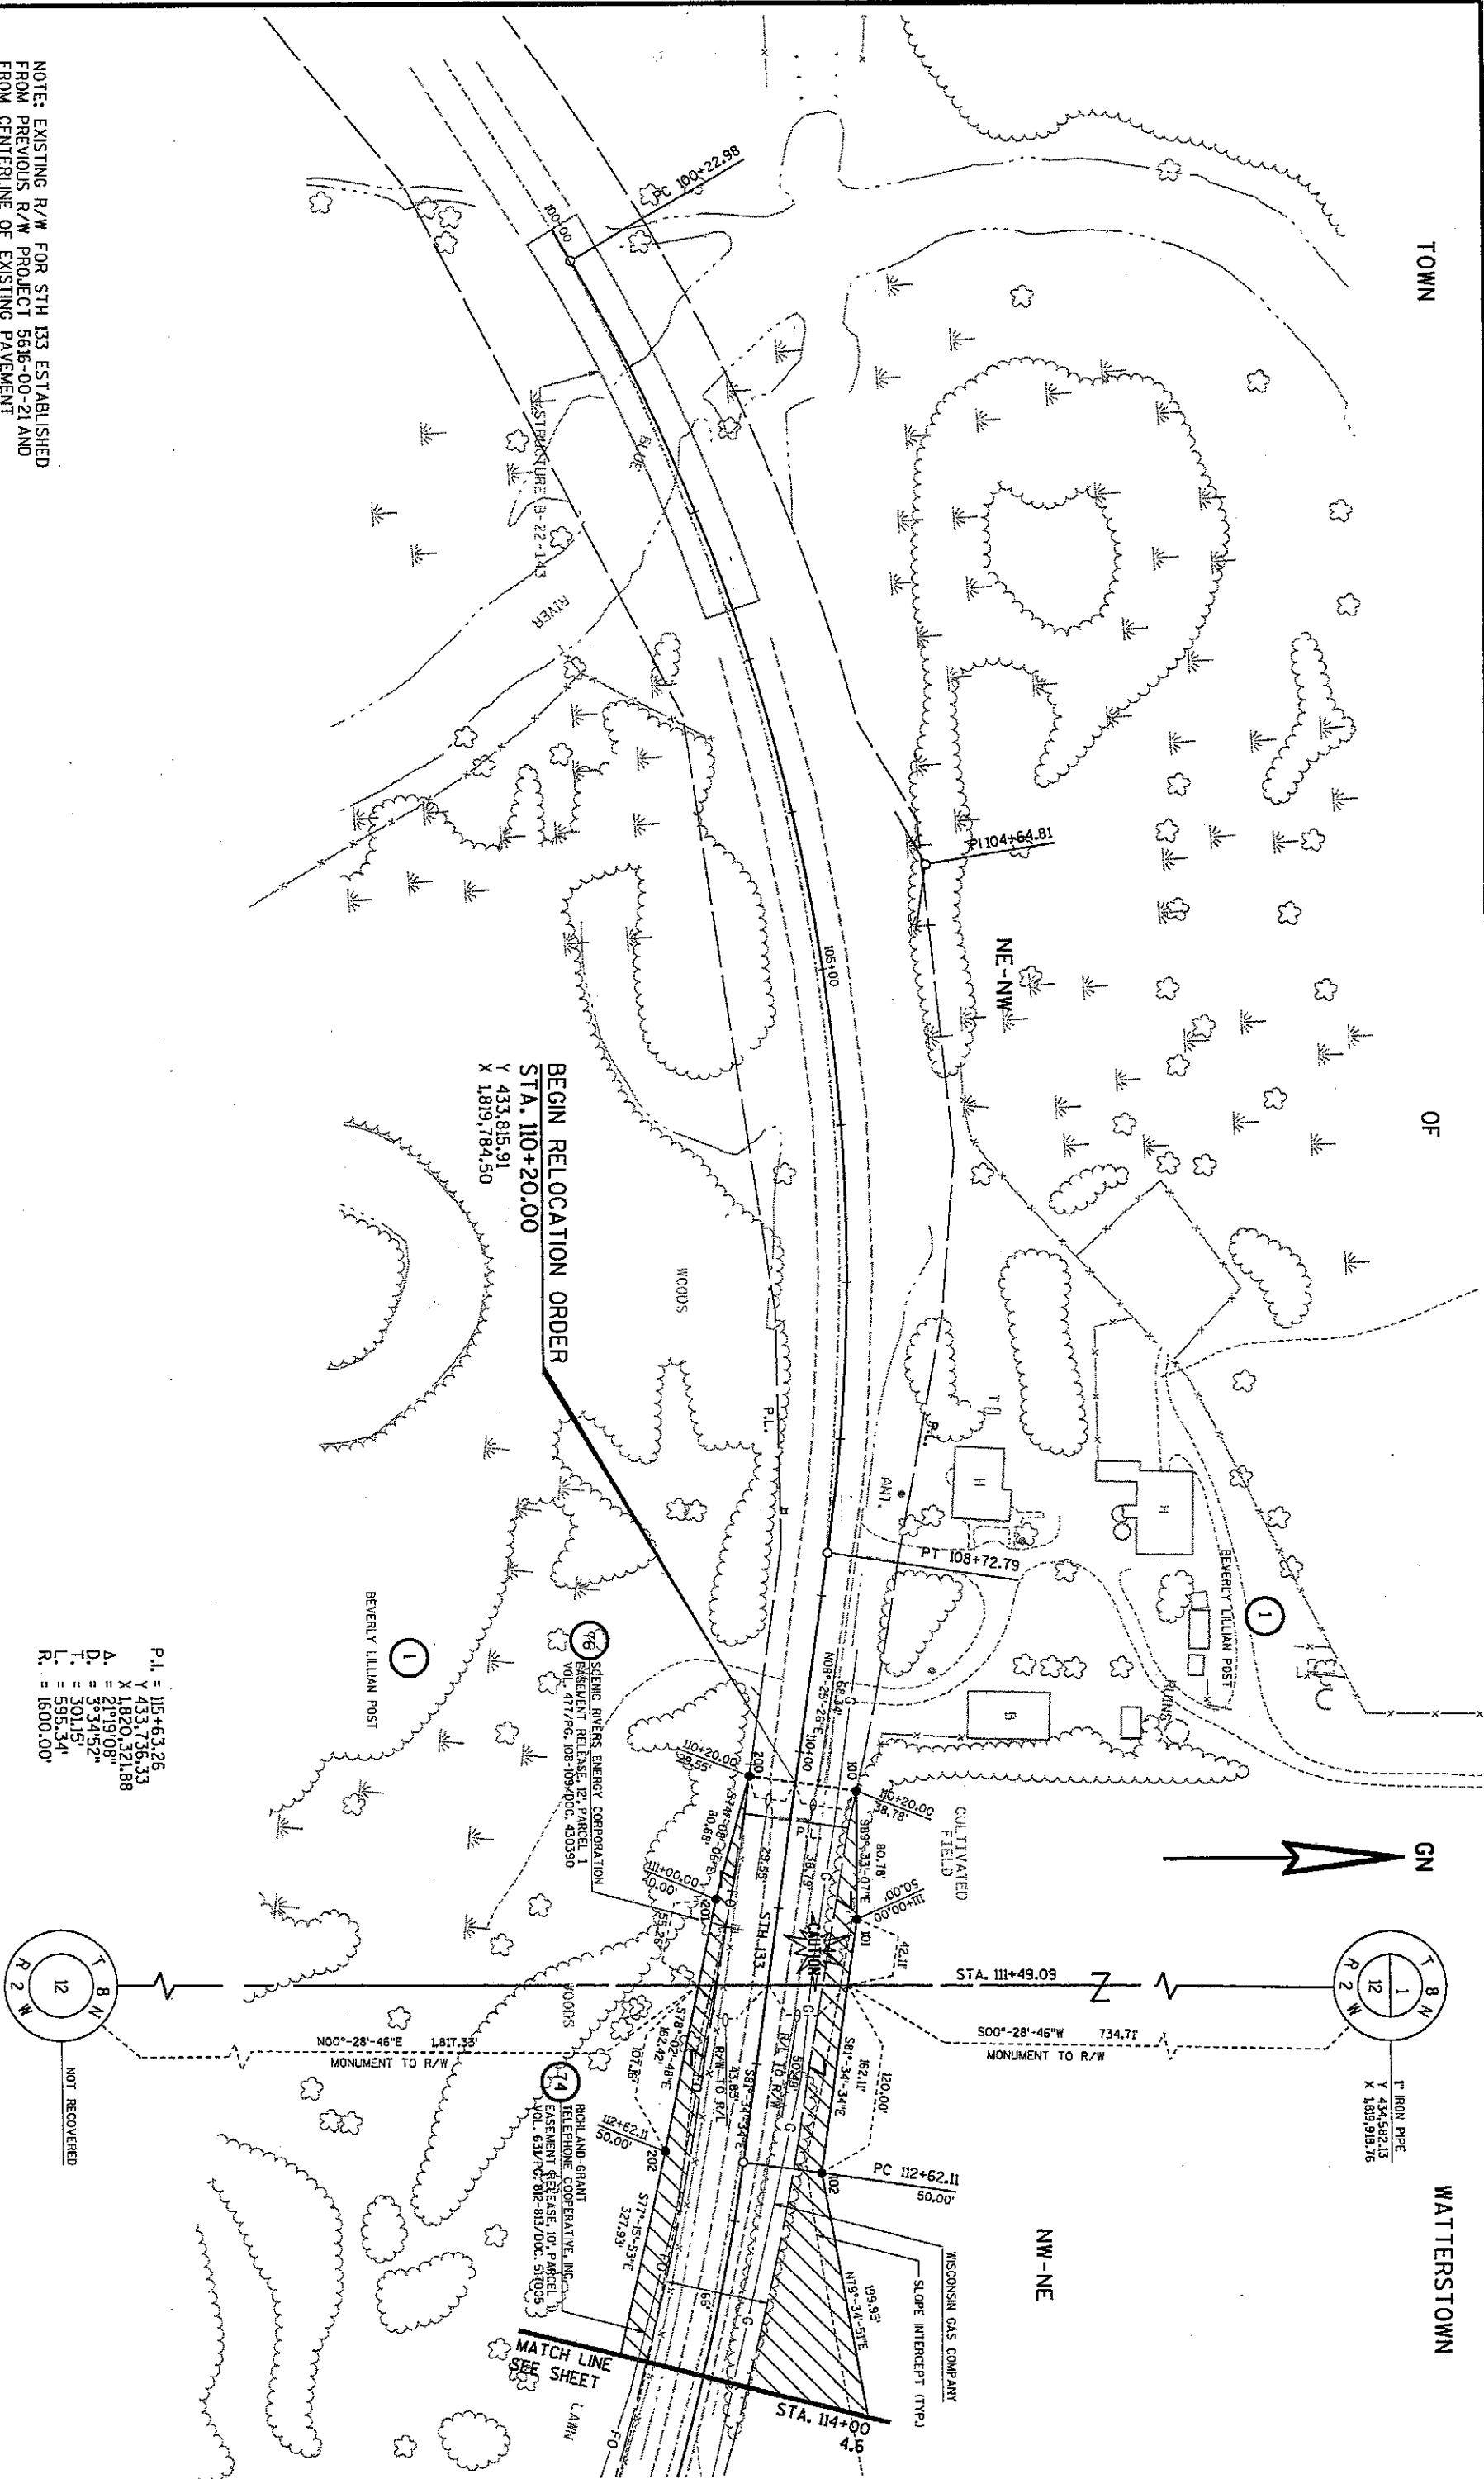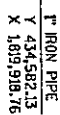

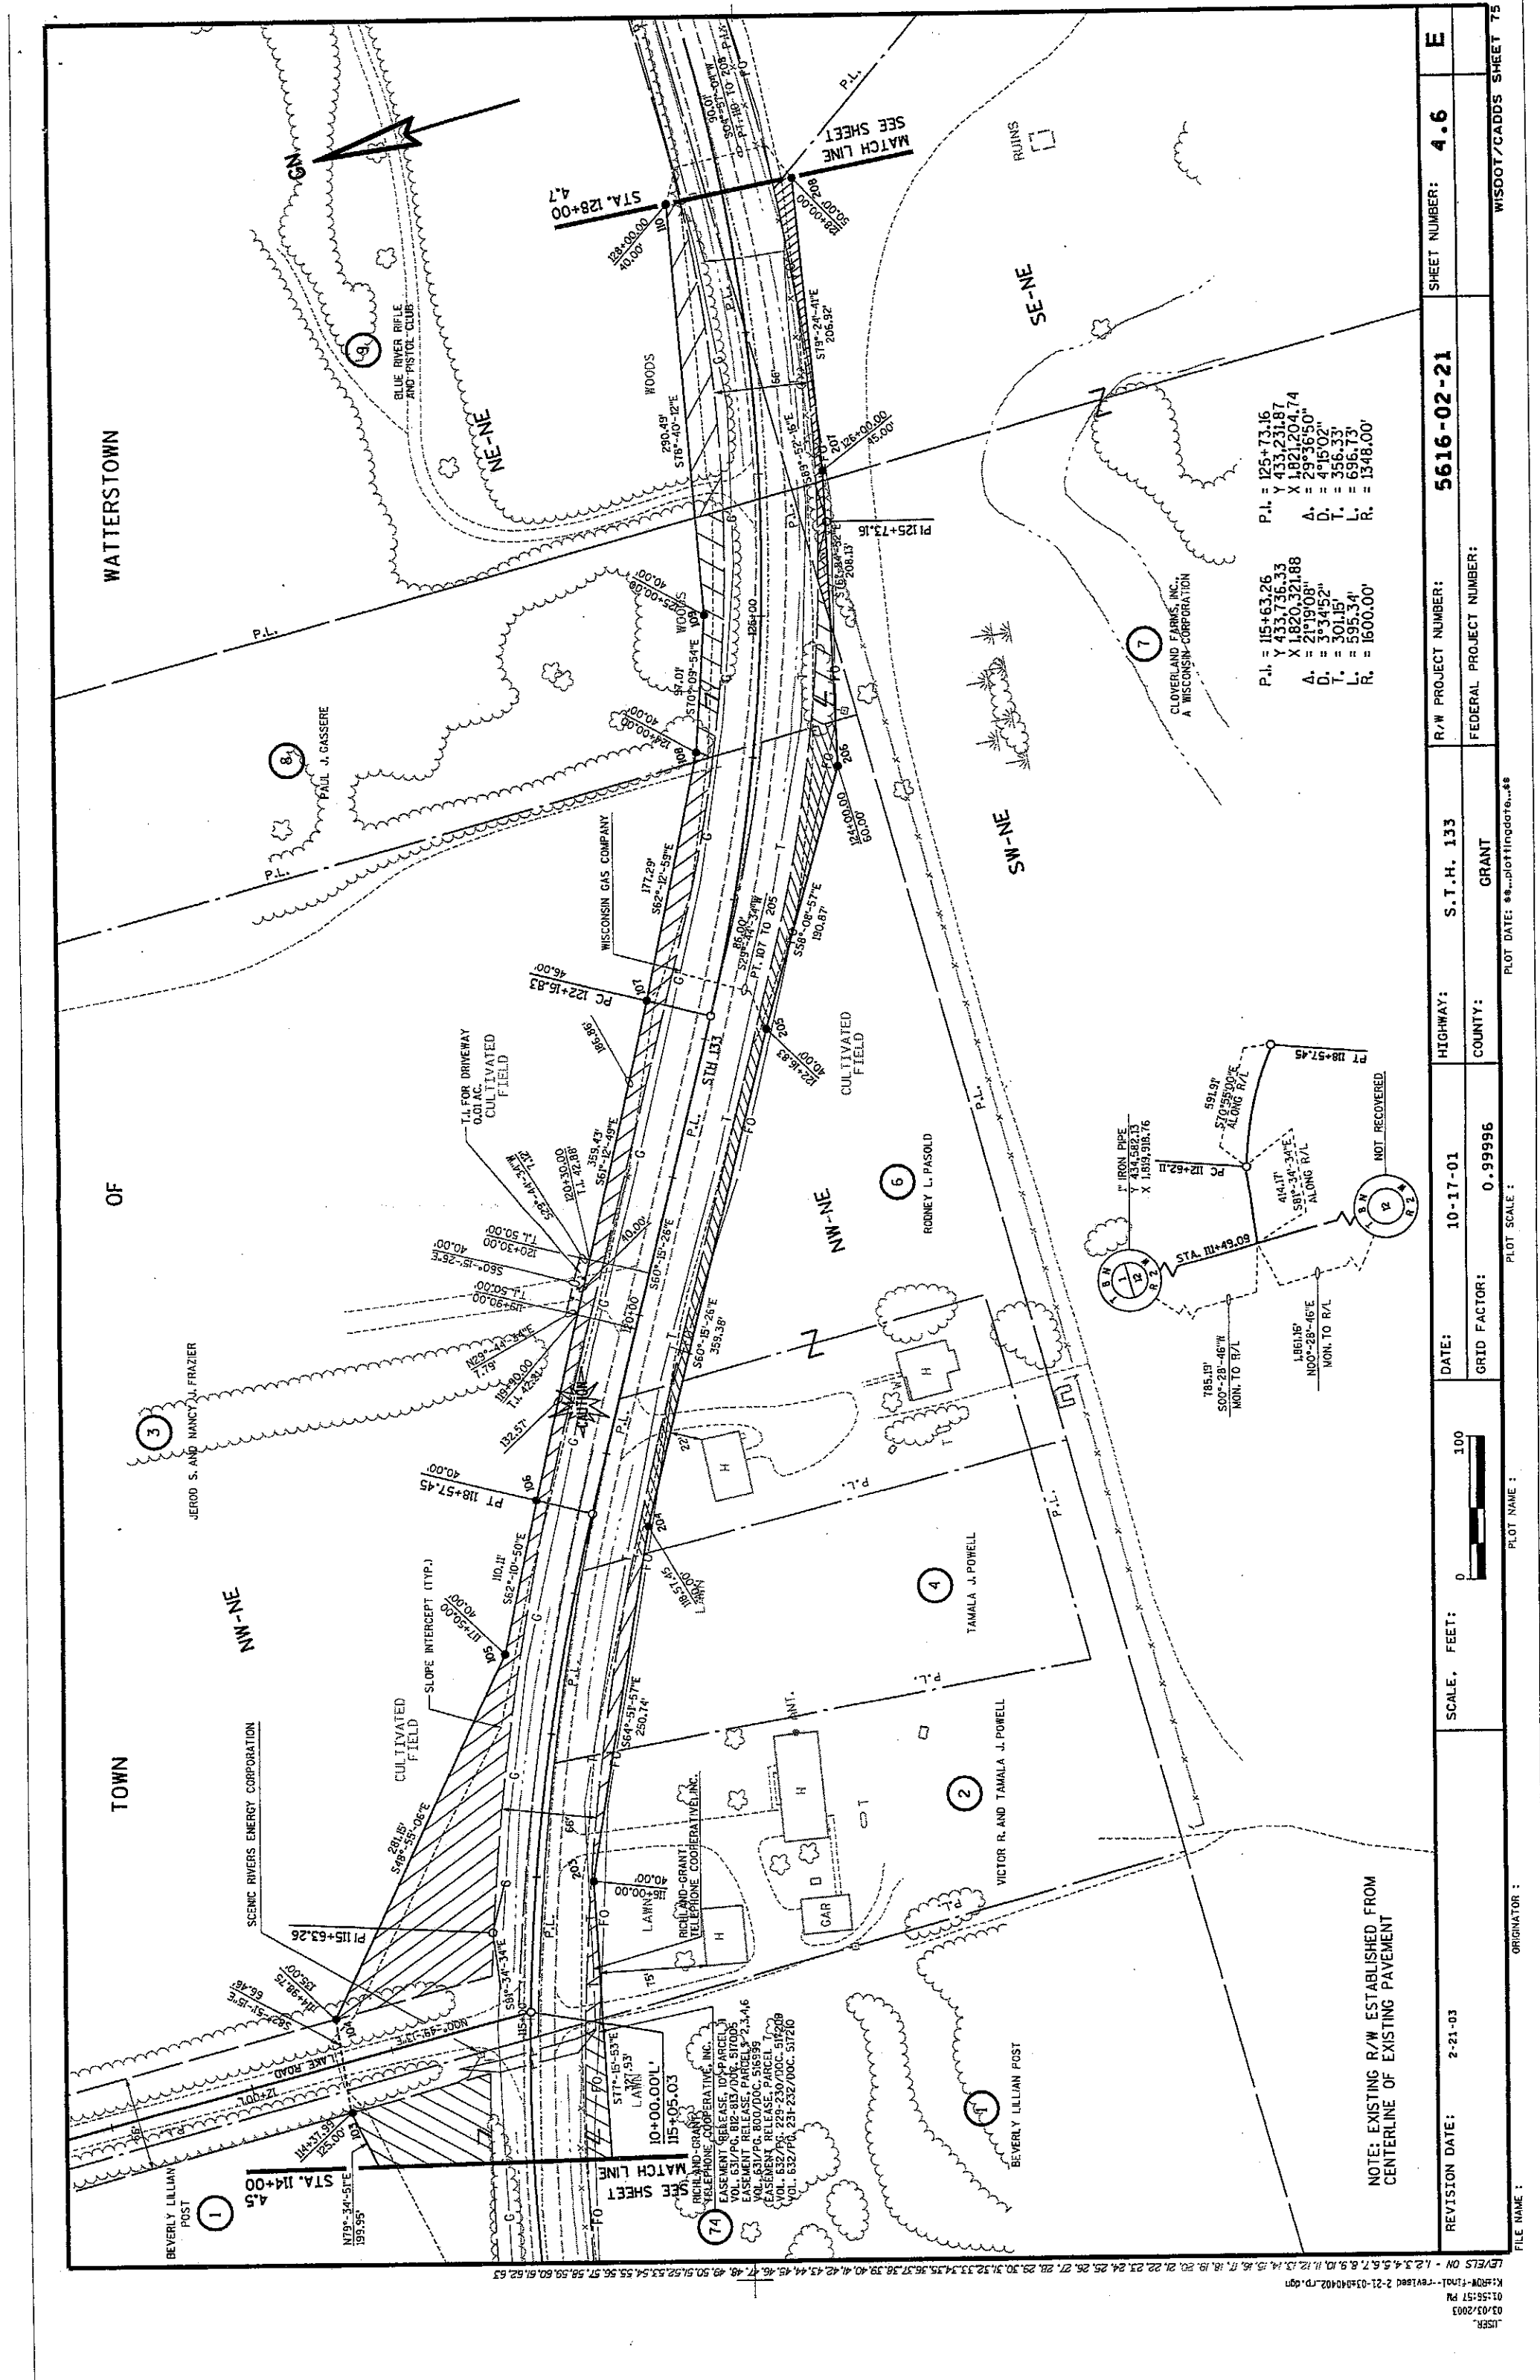



NOTE: EXISTING R/W ESTABLISHED FROM CENTERLINE OF EXISTING PAVEMENT

P.I. = 125+73.16  
Y 433.735.33  
X 1821.204.74  
D. = 29°36'50"  
T. = 4°15'02"  
L. = 356.33'  
R. = 1348.00'

P.I. = 115+63.26  
Y 433.735.33  
X 1820.321.88  
D. = 21°19'08"  
T. = 3°34'52"  
L. = 301.15'  
R. = 1600.00'


|                |         |              |         |            |            |                         |            |                     |            |               |     |   |
|----------------|---------|--------------|---------|------------|------------|-------------------------|------------|---------------------|------------|---------------|-----|---|
| REVISION DATE: | 2-21-03 | SCALE, FEET: | 0 100   | DATE:      | 10-17-01   | HIGHWAY:                | S.T.H. 133 | R/W PROJECT NUMBER: | 5616-02-21 | SHEET NUMBER: | 4.6 | E |
| ORIGINATOR:    |         | GRID FACTOR: | 0.99996 | COUNTY:    | GRANT      | FEDERAL PROJECT NUMBER: |            |                     |            |               |     |   |
| FILE NAME:     |         | PLOT NAME:   |         | PLOT DATE: | 08/01/2006 |                         |            |                     |            |               |     |   |

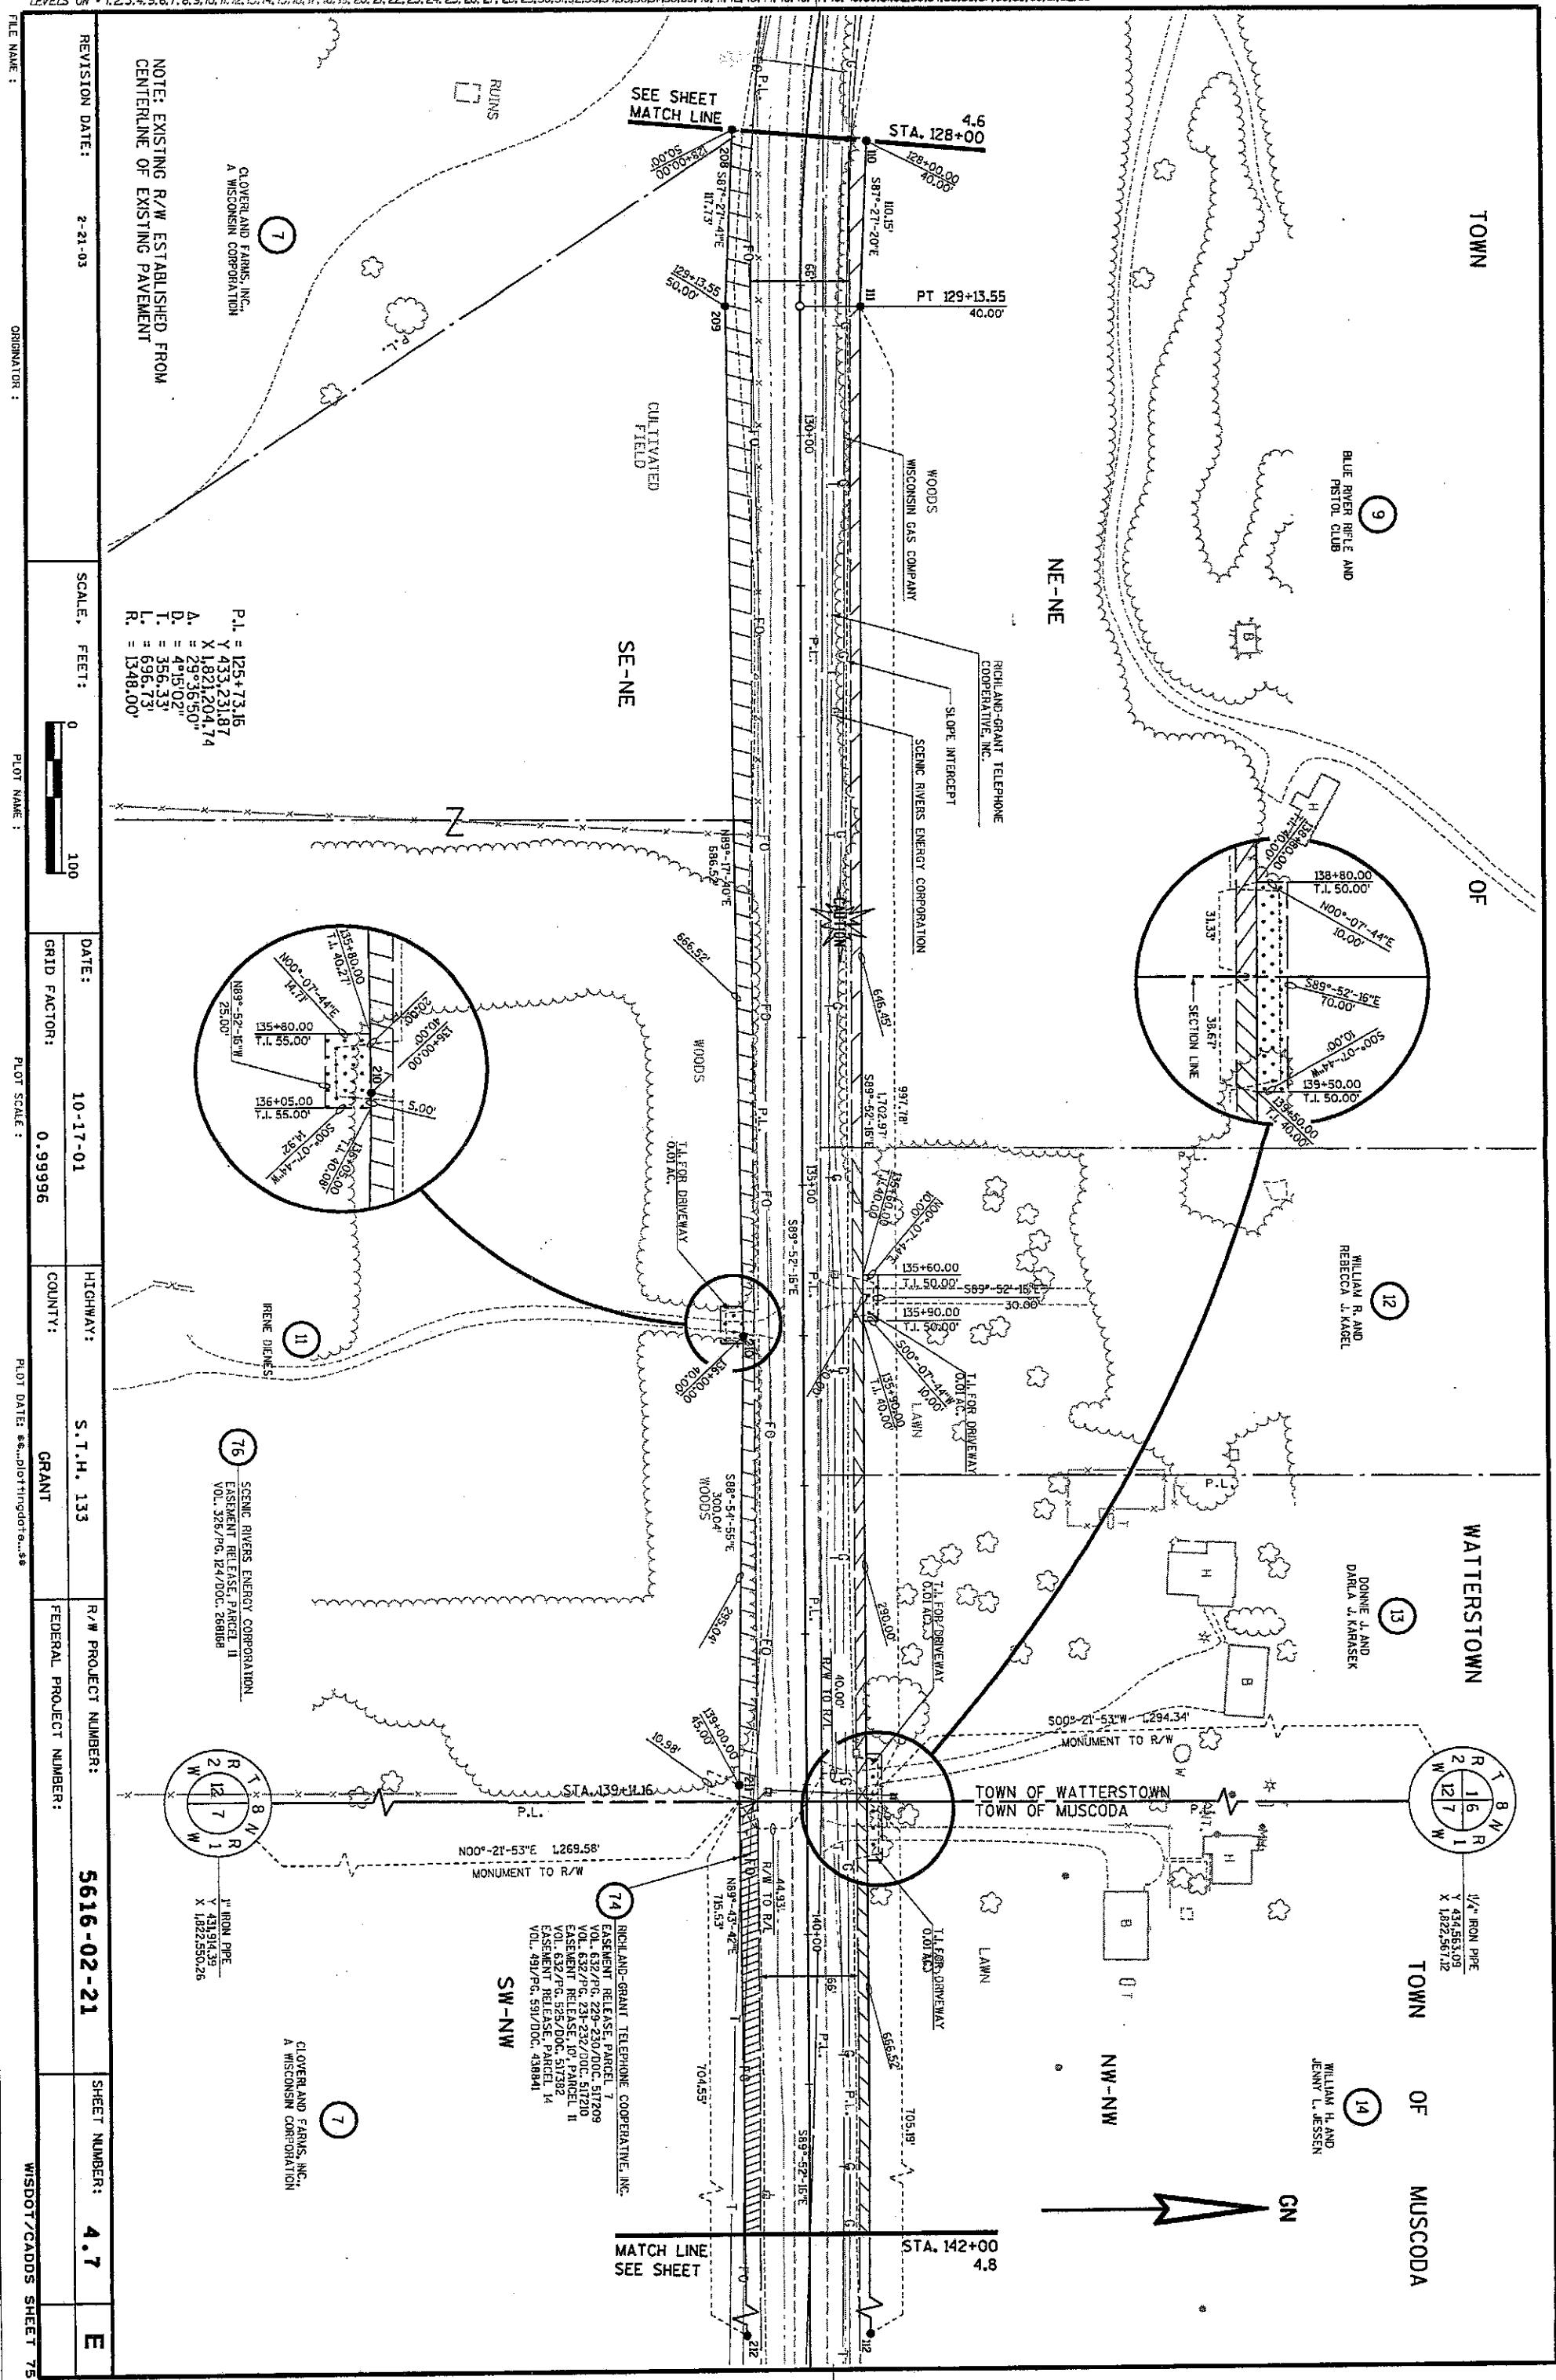


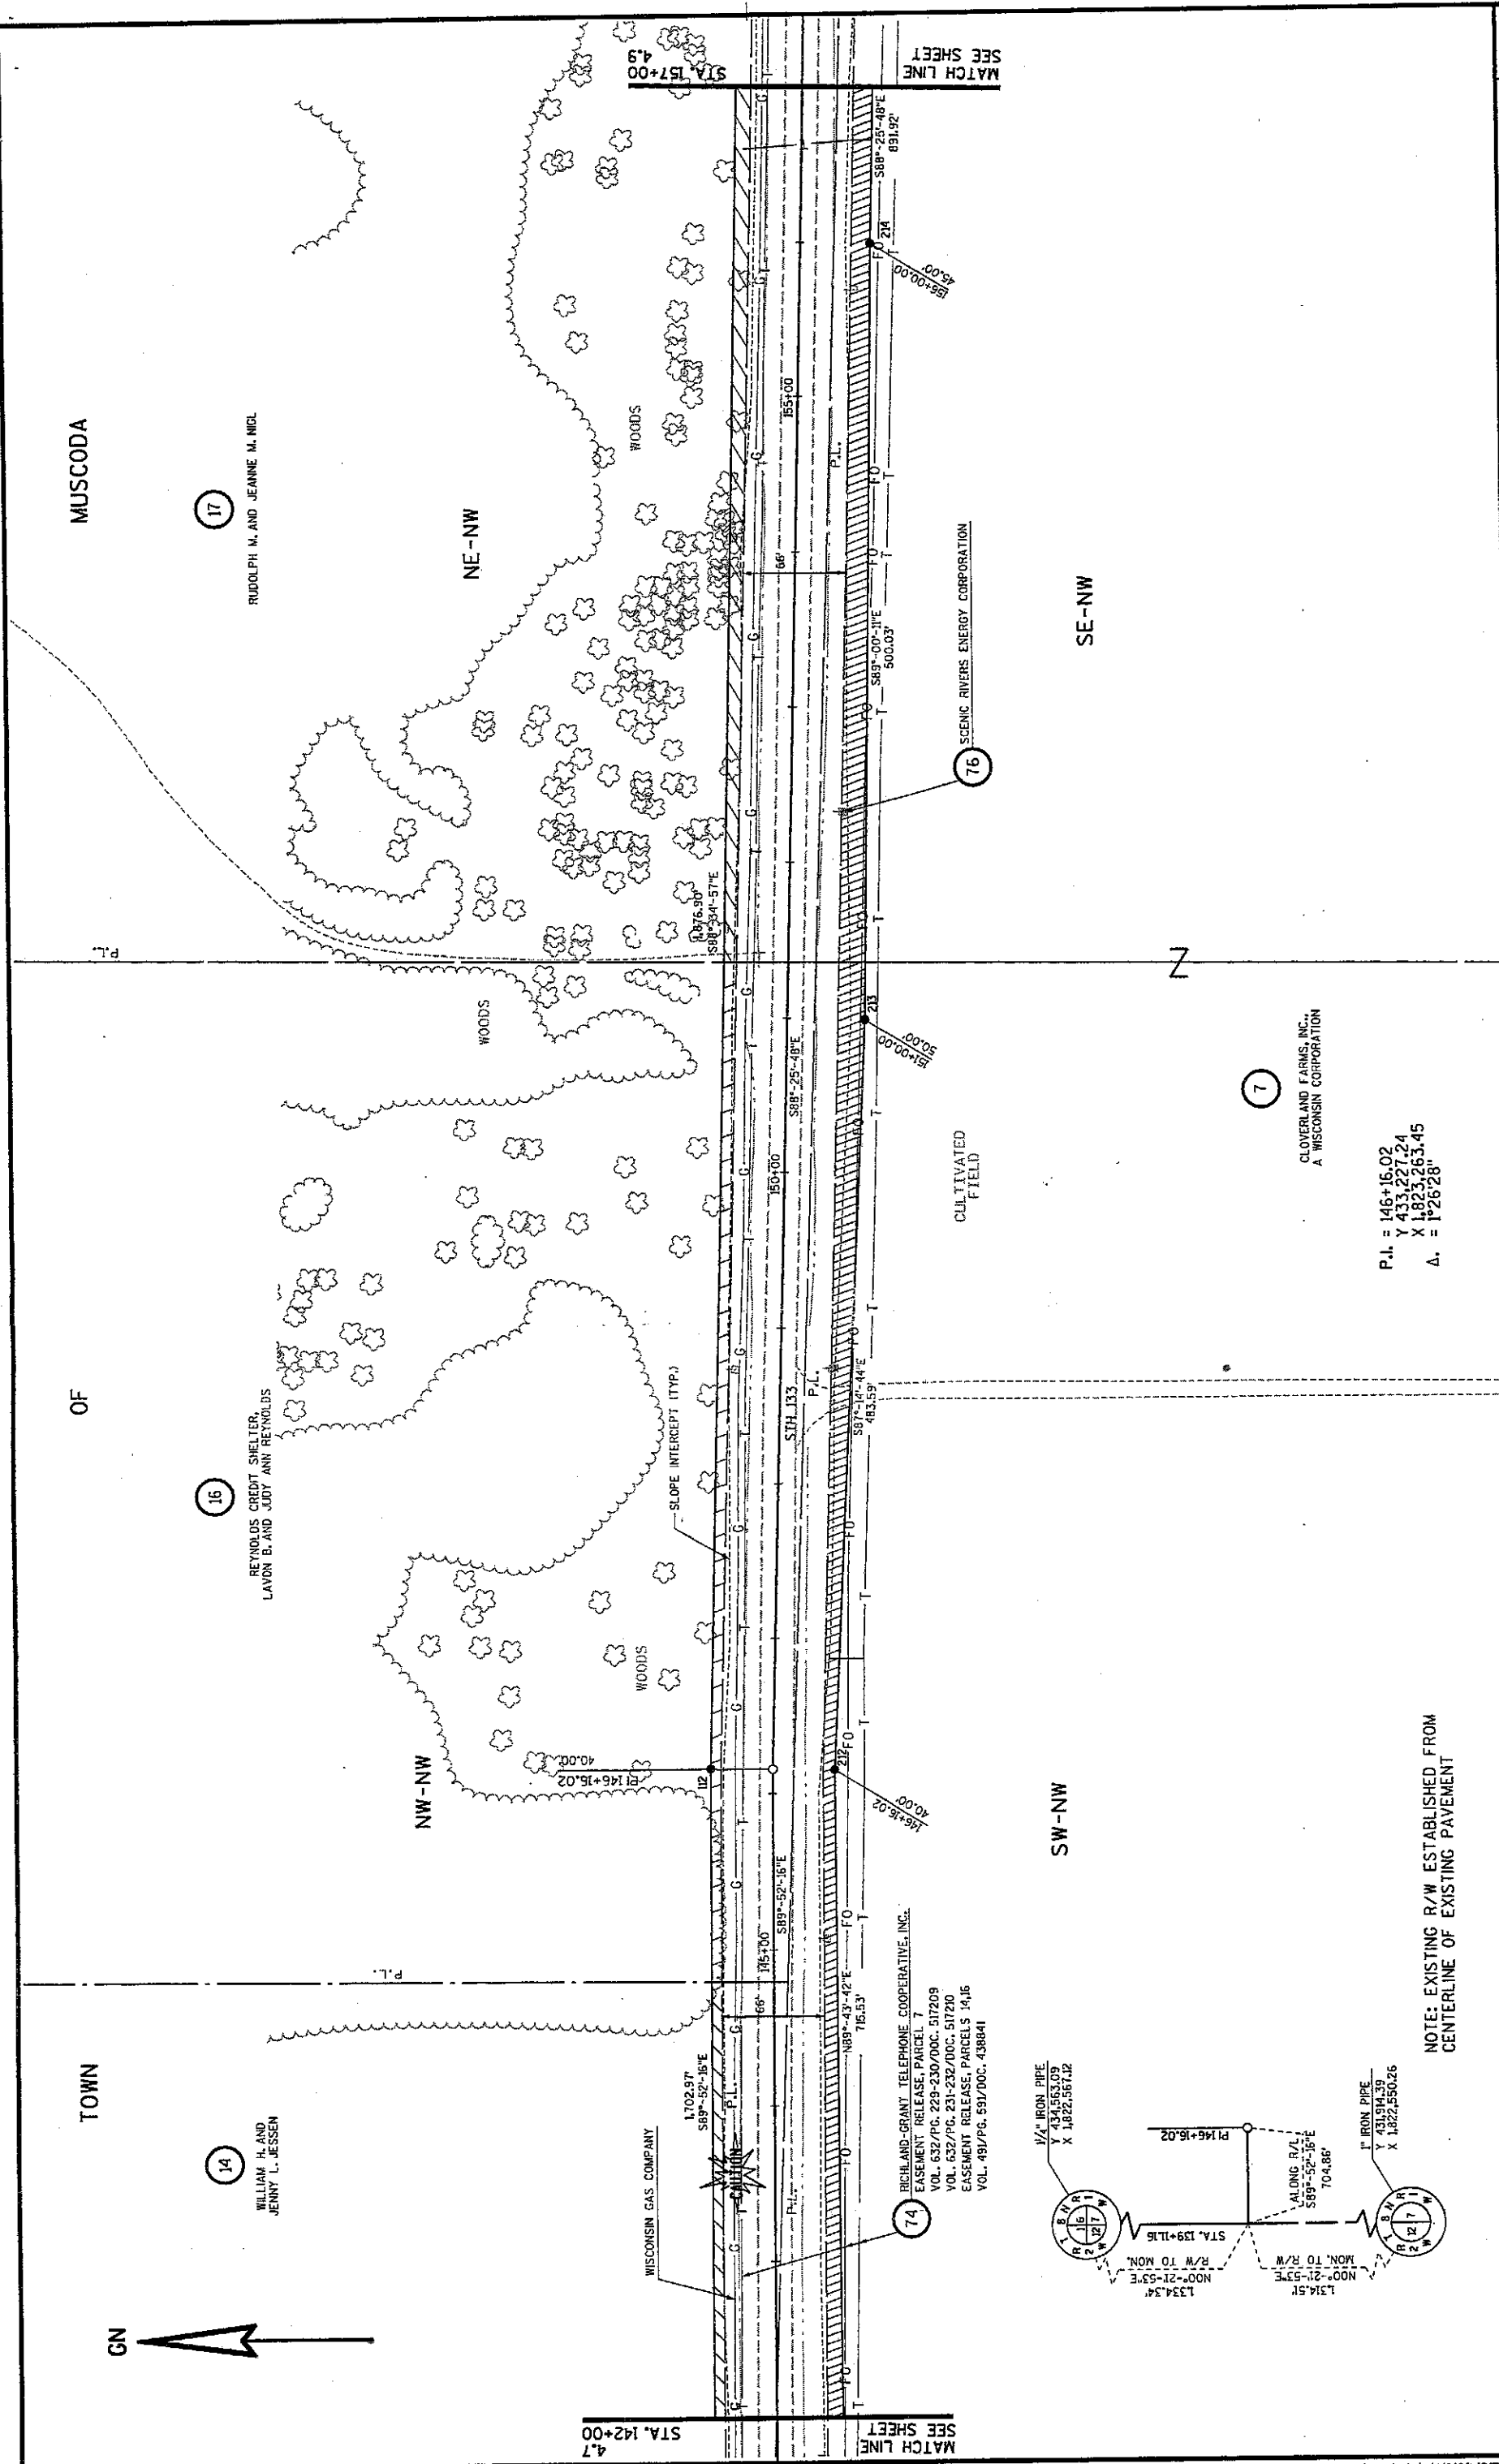

П

**NOTE: EXISTING R/W ESTABLISHED FROM  
CENTERLINE OF EXISTING PAVEMENT**

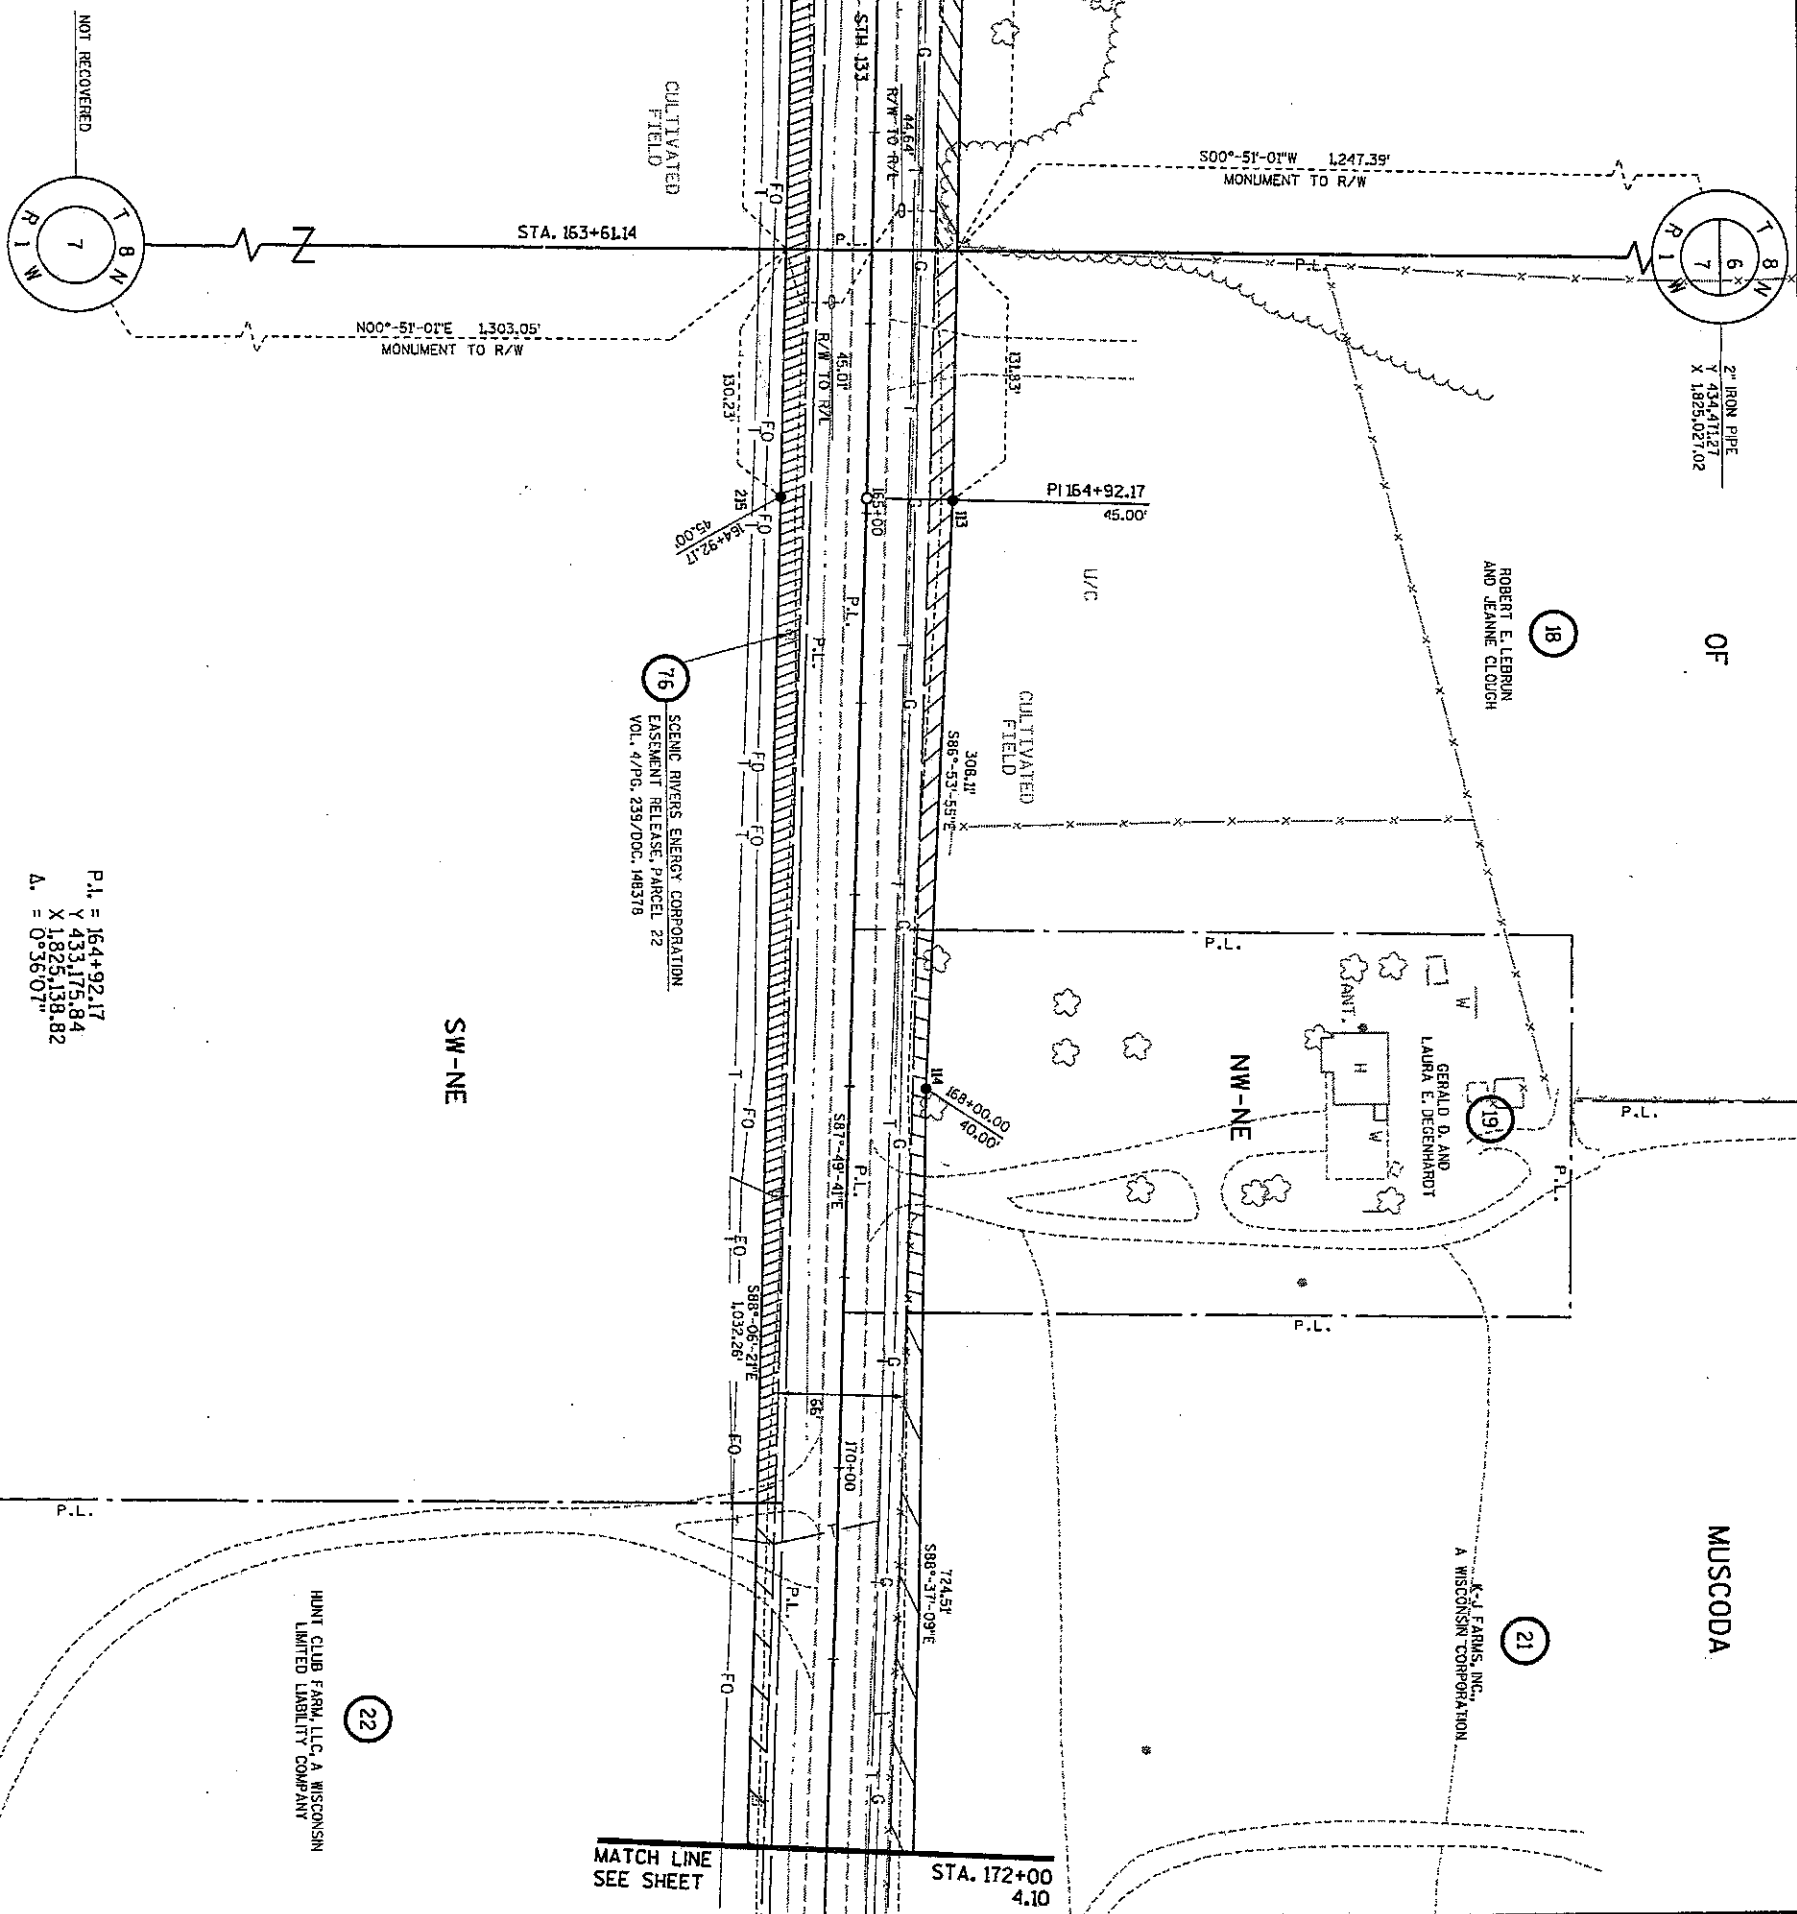

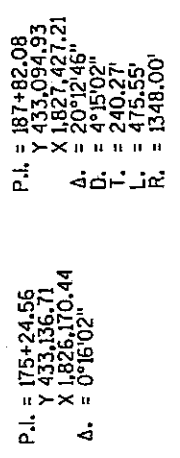

|                                                                                                                 |                                        |                                      |                                                           |                         |
|-----------------------------------------------------------------------------------------------------------------|----------------------------------------|--------------------------------------|-----------------------------------------------------------|-------------------------|
| REVISION DATE: 2-21-03<br> | DATE: 10-17-01<br>GRID FACTOR: 0.99996 | HIGHWAY: S.T.H. 133<br>COUNTY: GRANT | R/W PROJECT NUMBER: 5616-02-21<br>FEDERAL PROJECT NUMBER: | SHEET NUMBER: 4.10<br>E |
| PLOT NAME:                                                                                                      |                                        |                                      | PLOT DATE: ##-##-##                                       |                         |
| ORIGINATOR:                                                                                                     |                                        |                                      | PLOT SCALE:                                               |                         |
| WISDOT/CADD'S SHEET 7E                                                                                          |                                        |                                      |                                                           |                         |

FILE NAME :

ORIGINATOR :

PLOT NAME :

PLOT SCALE :

PLOT DATE: \$\$.plottingdate\$.

REVISION DATE:

2-21-03

SCALE, FEET:



DATE:

10-17-01

HIGHWAY:

S.T.H. 133

R/W PROJECT NUMBER:

5616-02-21

SHEET NUMBER:

4.11

E

GRID FACTOR:

0.99996

COUNTY:

GRANT

FEDERAL PROJECT NUMBER:

WISDOT/GAODS SHEET 75

NOTE: EXISTING R/W ESTABLISHED FROM  
CENTERLINE OF EXISTING PAVEMENT

HUNT CLUB FARM, LLC, A WISCONSIN  
LIMITED LIABILITY COMPANY

ALUMINUM MONUMENT  
Y 431,742.15  
X 1827,620.34

WISCONSIN DEPARTMENT  
OF TRANSPORTATION

WILLIAM J. AND EDNA J. TRINAM

74 RICH AND GRANT TELEPHONE COOPERATIVE, INC.  
EASEMENT RELEASE, 10' PARCEL 22  
VOL. 632/P.G. 896-897/DOC. 517600  
EASEMENT RELEASE, PARCEL 23  
VOL. 497/P.G. 605/DOC. 438885  
EASEMENT RELEASE, PARCELS 26, 27, 28, 29  
VOL. 497/P.G. 597/DOC. 438847

76 SCENIC RIVERS ENERGY CORPORATION  
EASEMENT RELEASE, PARCEL 22  
VOL. 632/P.G. 896-897/DOC. 517600  
EASEMENT RELEASE, PARCELS 26, 27, 28, 29  
VOL. 367/P.G. 118/DOC. 335921

P.L. = 187+82.08  
Y 433,094.93  
X 1827,427.21  
A. = 20°12'46"  
D. = 4°15'02"  
T. = 240.27'  
L. = 475.55'  
R. = 1348.00'

MATCH LINE  
SEE SHEET

STA. 202+00  
4.12

SEE SHEET  
MATCH LINE

STA. 187+00  
4.10

RONALD G. STURDEVANT

2" IRON PIPE  
Y 434,354.55  
X 1827,650.33

TOWN

OF

MUSCODA

GN

NE-NE

NW-NW

SW-NW

SEE SHEET  
MATCH LINE

MATCH LINE  
SEE SHEET

STA. 202+00  
4.12

RONALD G. STURDEVANT

2" IRON PIPE  
Y 434,354.55  
X 1827,650.33

TOWN

OF

MUSCODA

GN

NE-NE


NW-NW

SW-NW

SEE SHEET  
MATCH LINE

MATCH LINE  
SEE SHEET

STA. 202+00  
4.12

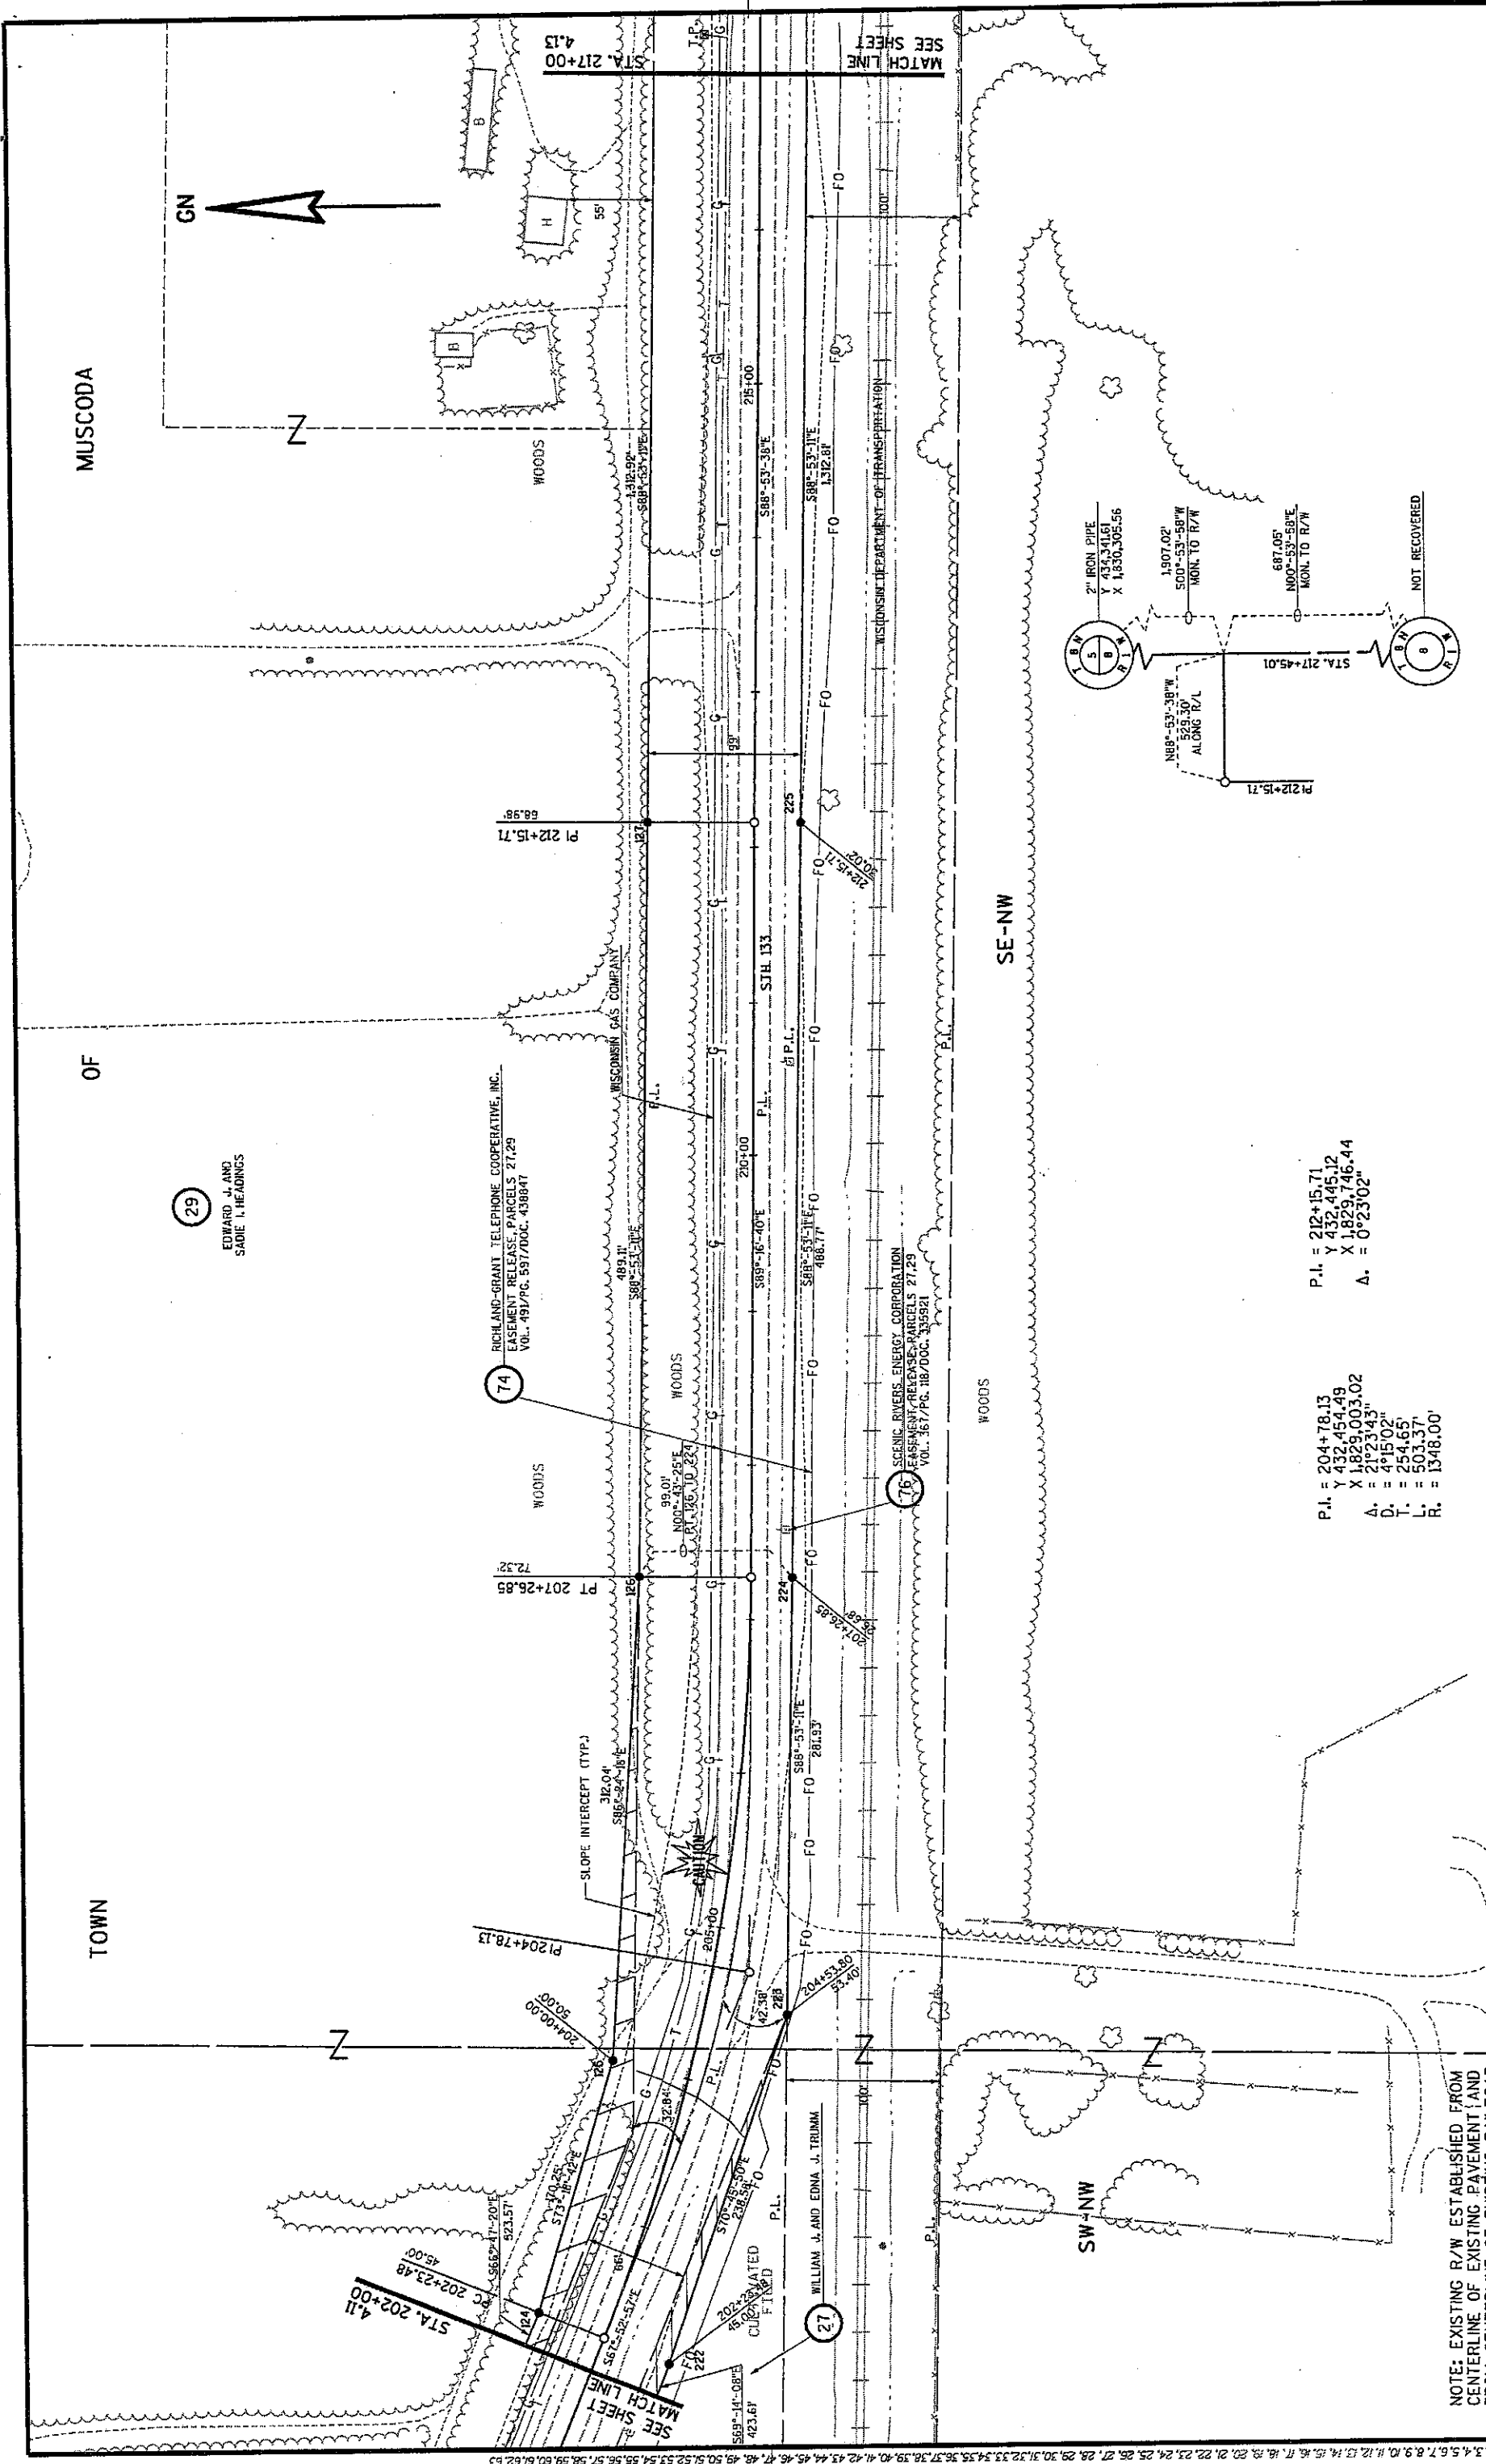

NOTE: EXISTING R/W ESTABLISHED FROM CENTERLINE OF EXISTING PAVEMENT AND FROM CENTERLINE OF EXISTING RAILROAD

|                                                                     |  |                                                                                                                |  |                                   |                     |                                |                    |   |
|---------------------------------------------------------------------|--|----------------------------------------------------------------------------------------------------------------|--|-----------------------------------|---------------------|--------------------------------|--------------------|---|
| REVISION DATE: 2-21-03 N.C.<br>FROM CENTERLINE OF EXISTING RAILROAD |  | SCALE, FEET:<br>0 100<br> |  | DATE: 10-17-01                    | HIGHWAY: S.T.H. 133 | R/W PROJECT NUMBER: 5616-02-21 | SHEET NUMBER: 4.12 | E |
|                                                                     |  |                                                                                                                |  | GRID FACTOR: 0.99996              | COUNTY: GRANT       | FEDERAL PROJECT NUMBER:        |                    |   |
| FILE NAME :                                                         |  | ORIGINATOR :                                                                                                   |  | PLOT DATE: **...plottingdate...** |                     | PLOT SCALE :                   |                    |   |
| PLOT NAME :                                                         |  | WISDOT/CADDs SHEET 75                                                                                          |  |                                   |                     |                                |                    |   |

LEVELS ON 1, 2, 3, 62, 63

FILE NAME :

REVISION DATE: 2-21-03 N.C.

SCALE, FEET:



DATE: 10-17-01

GRID FACTOR: 0.99996

HIGHWAY: S.T.H. 133

COUNTY: GRANT

R/W PROJECT NUMBER:

5616-02-21

SHEET NUMBER:

4.13

E

ORIGINATOR :


PLOT NAME :

PLOT SCALE :

PLOT DATE: \*\*plottingdate\*\*

WISDOT/CADD SHEET 75

NOTE: EXISTING R/W ESTABLISHED FROM  
CENTERLINE OF EXISTING RAILROAD

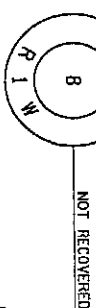

NOT RECOVERED

WILLIAM J. AND  
EDNA J. TRIUM

27

N00°-53'-59"E 656.96'  
MONUMENT TO R/W

WOODS

WOODS  
SW-NE

SE-NE


SEE SHEET  
MATCH LINE

74  
HIGHLAND GRANT TELEPHONE COOPERATIVE, INC.  
EASEMENT RELEASE PARCEL 29  
VOL. 491/Pg. 537/DOC. 438841

76  
SCENIC RIVERS ENERGY CORPORATION  
EASEMENT RELEASE PARCEL 29  
VOL. 361/Pg. 118/DOC. 335921


WISCONSIN DEPARTMENT OF TRANSPORTATION

MATCH LINE  
SEE SHEET

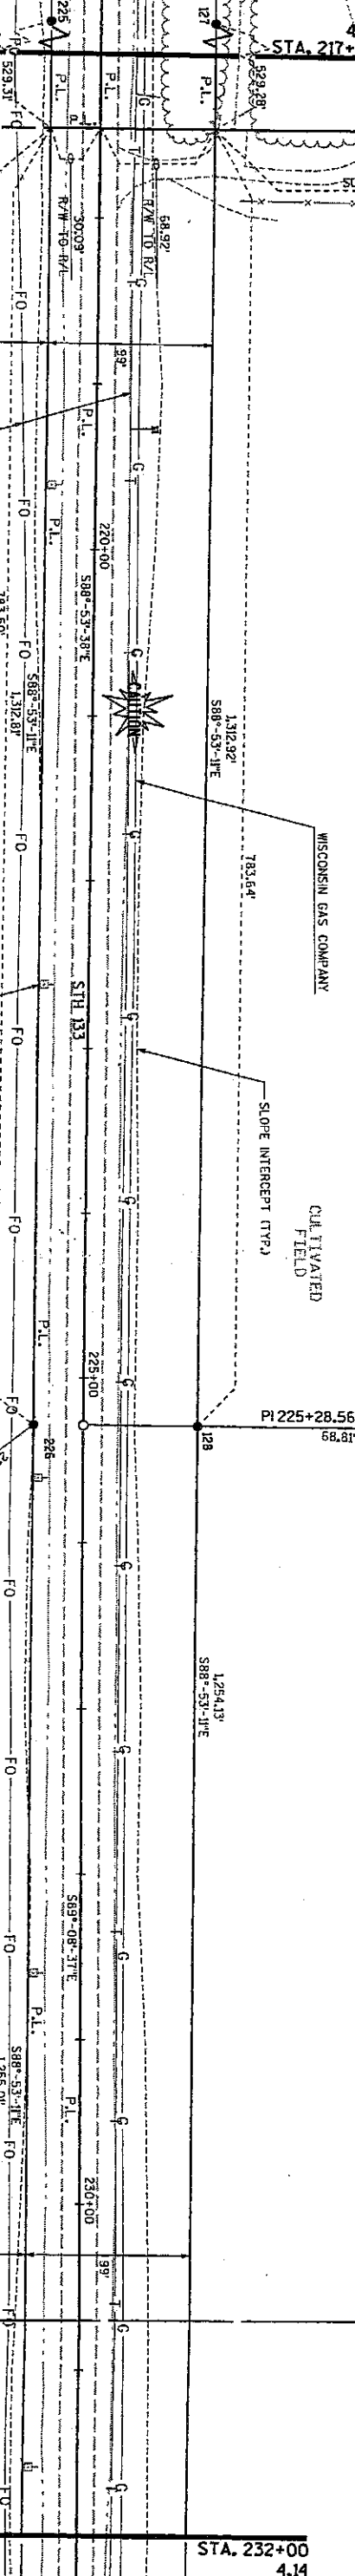

EDWARD J. AND  
SADE L. HEADINGS

29

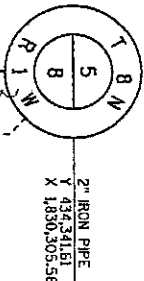

2" IRON PIPE  
Y 432.341.51  
X 1,830.305.56

TOWN

OF

MUSCODA

LAYON B. AND JUDY REYNOLDS

31



CN

GN

TOWN

OF

MUSCODO

LAVON B. AND JUDY REYNOLDS

31

32

DALE G. PADFIELD

VIOLA L. DAVIS

SCENIC RIVERS ENERGY CORPORATION

RICHLAND-GRANT TELEPHONE COOPERATIVE, INC.

WISCONSIN GAS COMPANY

CULTIVATED FIELD

WISCONSIN DEPARTMENT OF TRANSPORTATION

WISCONSIN DEPARTMENT OF TRANSPORTATION

EXISTING HIGHWAY EASEMENT

SE-NE

WOODS

SW-NW

| SIGN NUMBER | SIGN OWNER                                |
|-------------|-------------------------------------------|
| E-1         | WISCONSIN DEPARTMENT OF NATURAL RESOURCES |
| ---         | ---                                       |
| ---         | ---                                       |
| ---         | ---                                       |

NOTE: EXISTING R/W ESTABLISHED FROM CENTERLINE OF EXISTING RAILROAD

REVISION DATE: 2-21-03

SCALE, FEET: 0 100

DATE: 10-17-01

HIGHWAY: S.T.H. 133

R/W PROJECT NUMBER: 5616-02-21

SHEET NUMBER: 4.14

E

FILE NAME :

ORIGINATOR :

PLOT NAME :


PLOT SCALE :

PLOT DATE: ss...plottingdate...ss

FEDERAL PROJECT NUMBER:

WISDOT/CADD'S SHEET 75

USBR  
12/24/2003  
12:49:05 PM  
K:\trav-f\hpl-travel\2-21-03\hpl10.rp.dgn  
LEVELS ON : 1,2,3,4,5,6,7,8,9,10,11,12,13,14,15,16,17,18,19,20,21,22,23,24,25,26,27,28,29,30,31,32,33,34,35,36,37,38,39,40,41,42,43,44,45,46,47,48,49,50,51,52,53,54,55,56,57,58,59,60,61,62,63

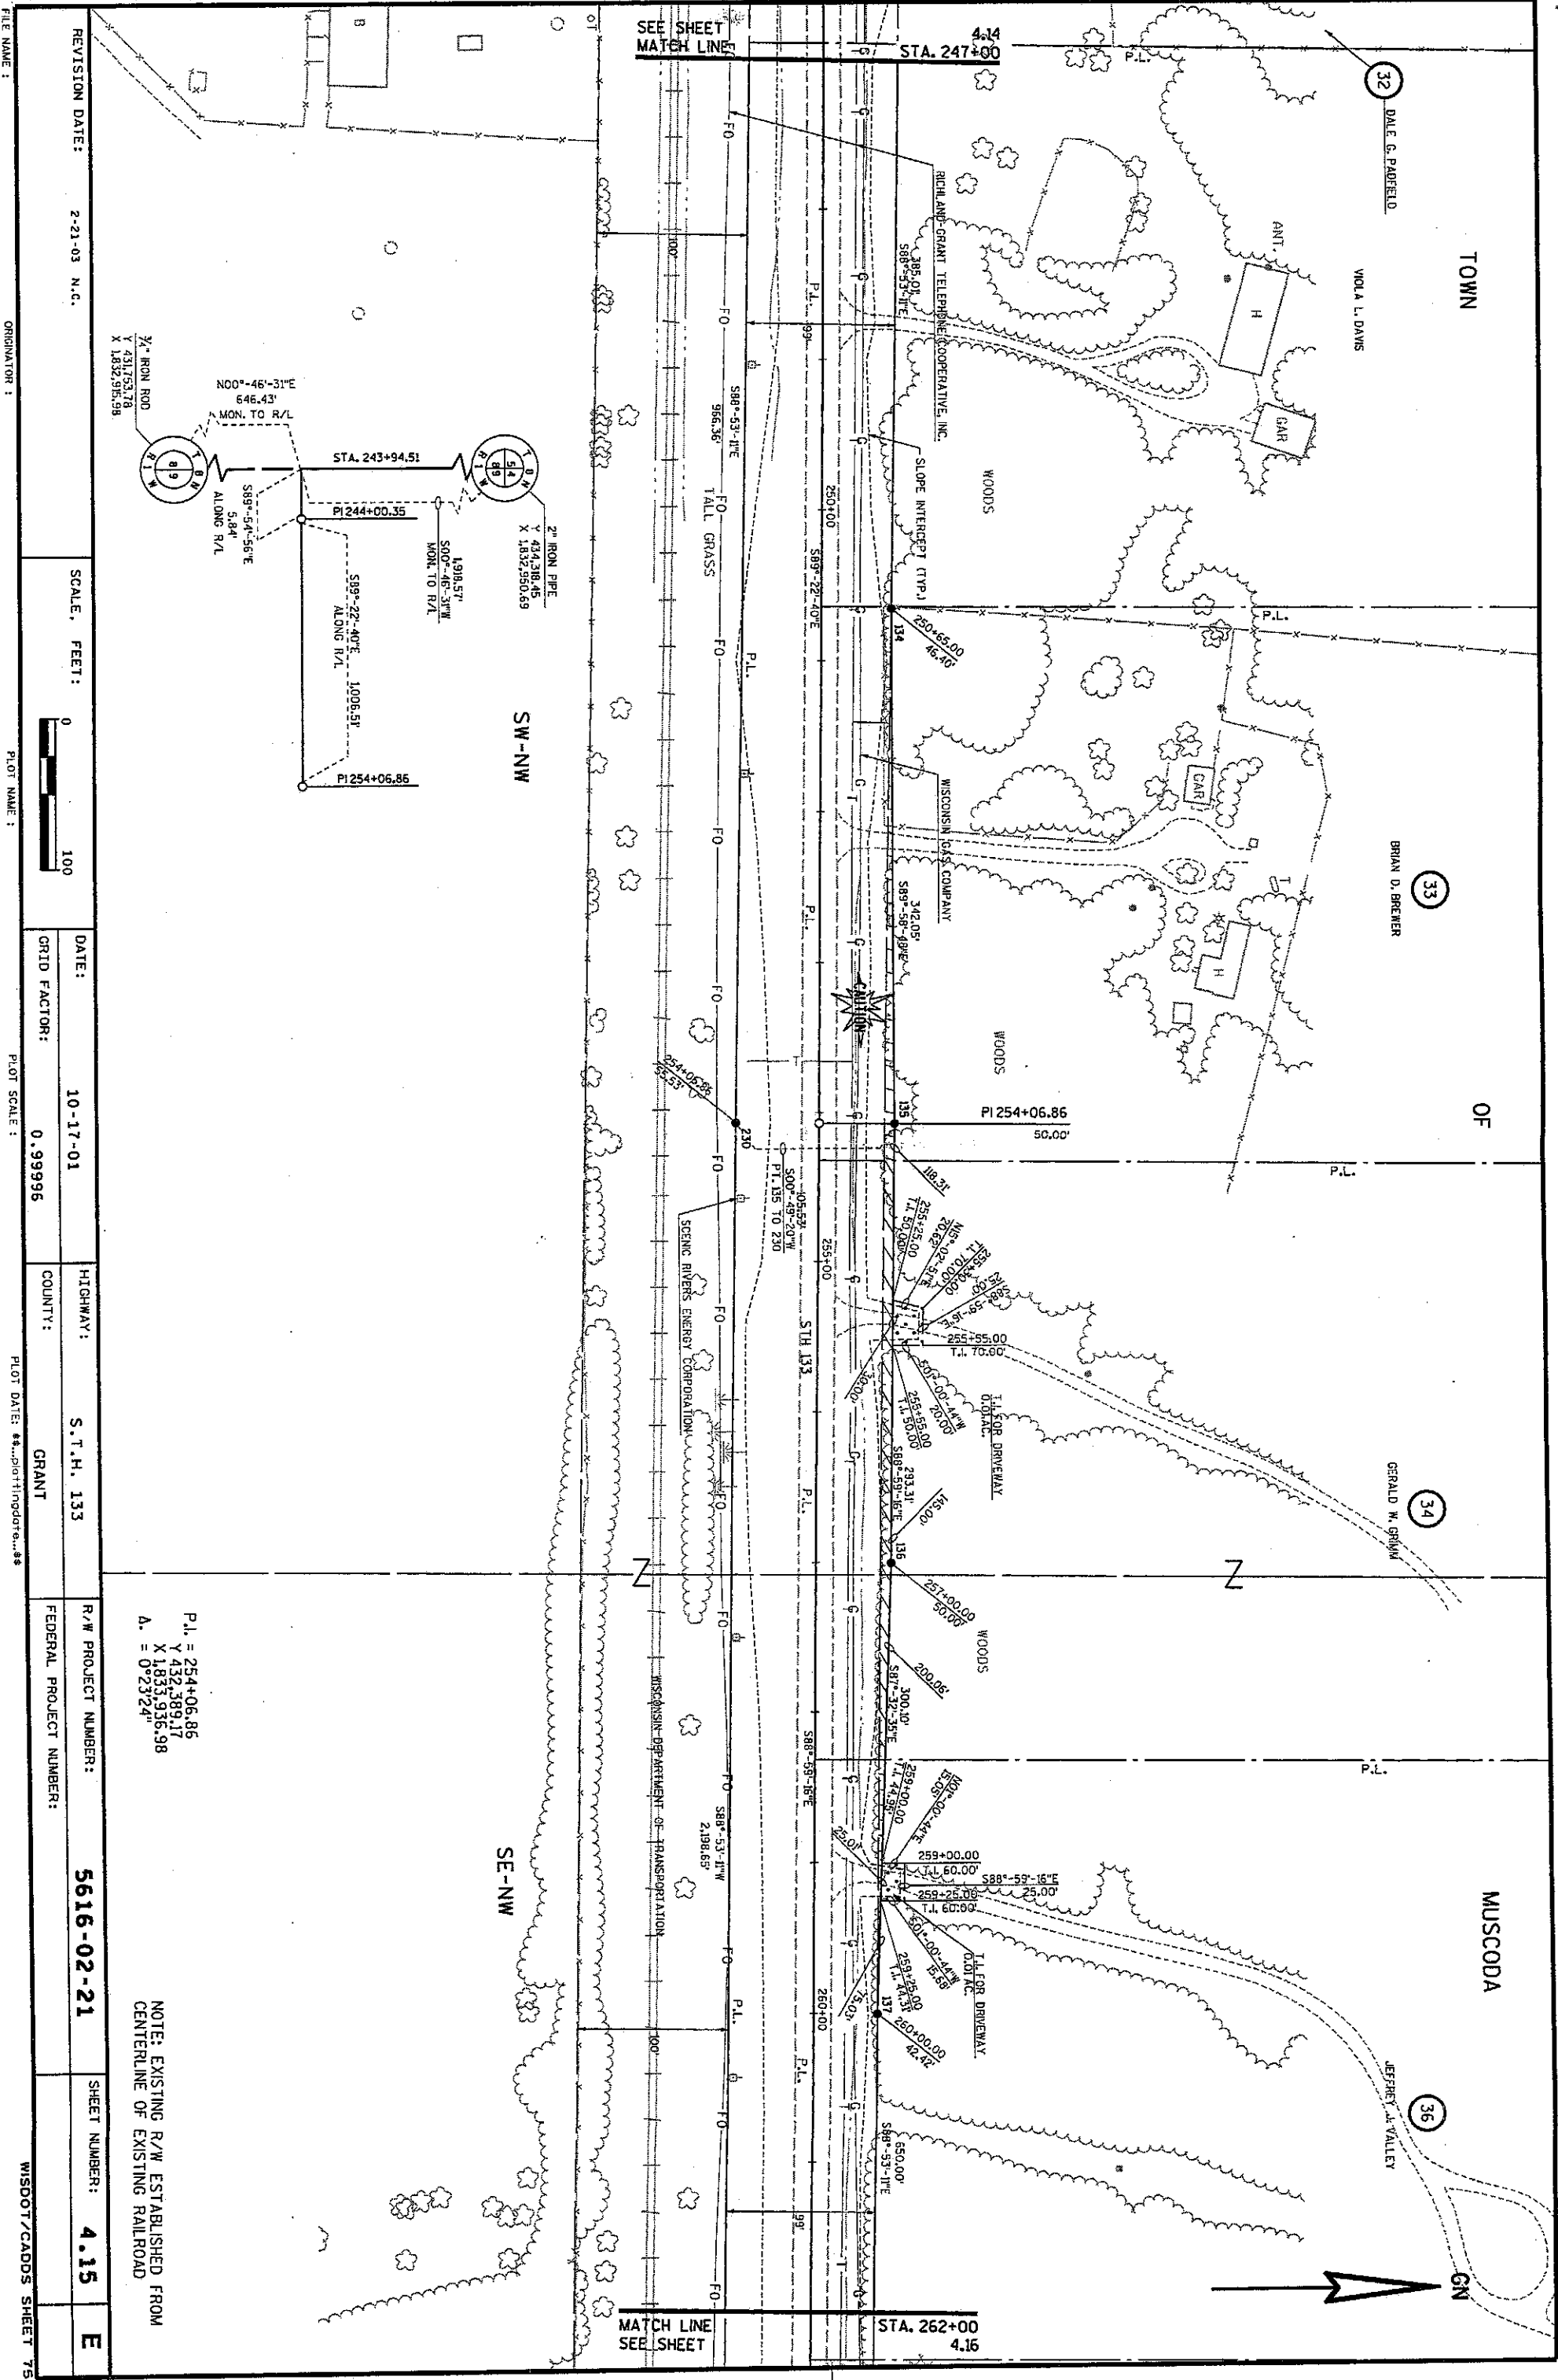

P.L. = 254+06.86  
Y 432.389,17  
X 1833.936,98  
A. = 0°23'24"

NOTE: EXISTING R/W ESTABLISHED FROM  
CENTERLINE OF EXISTING RAILROAD

[illegible]

התאריך: 11.01.2017

0. 100.

10-11-01


**SECRET**

---

\_\_\_\_\_

[illegible]

|  |         |        |                    |
|--|---------|--------|--------------------|
|  | 0.99896 | GRAIN! | WISDOT/CADDS SHEET |
|--|---------|--------|--------------------|

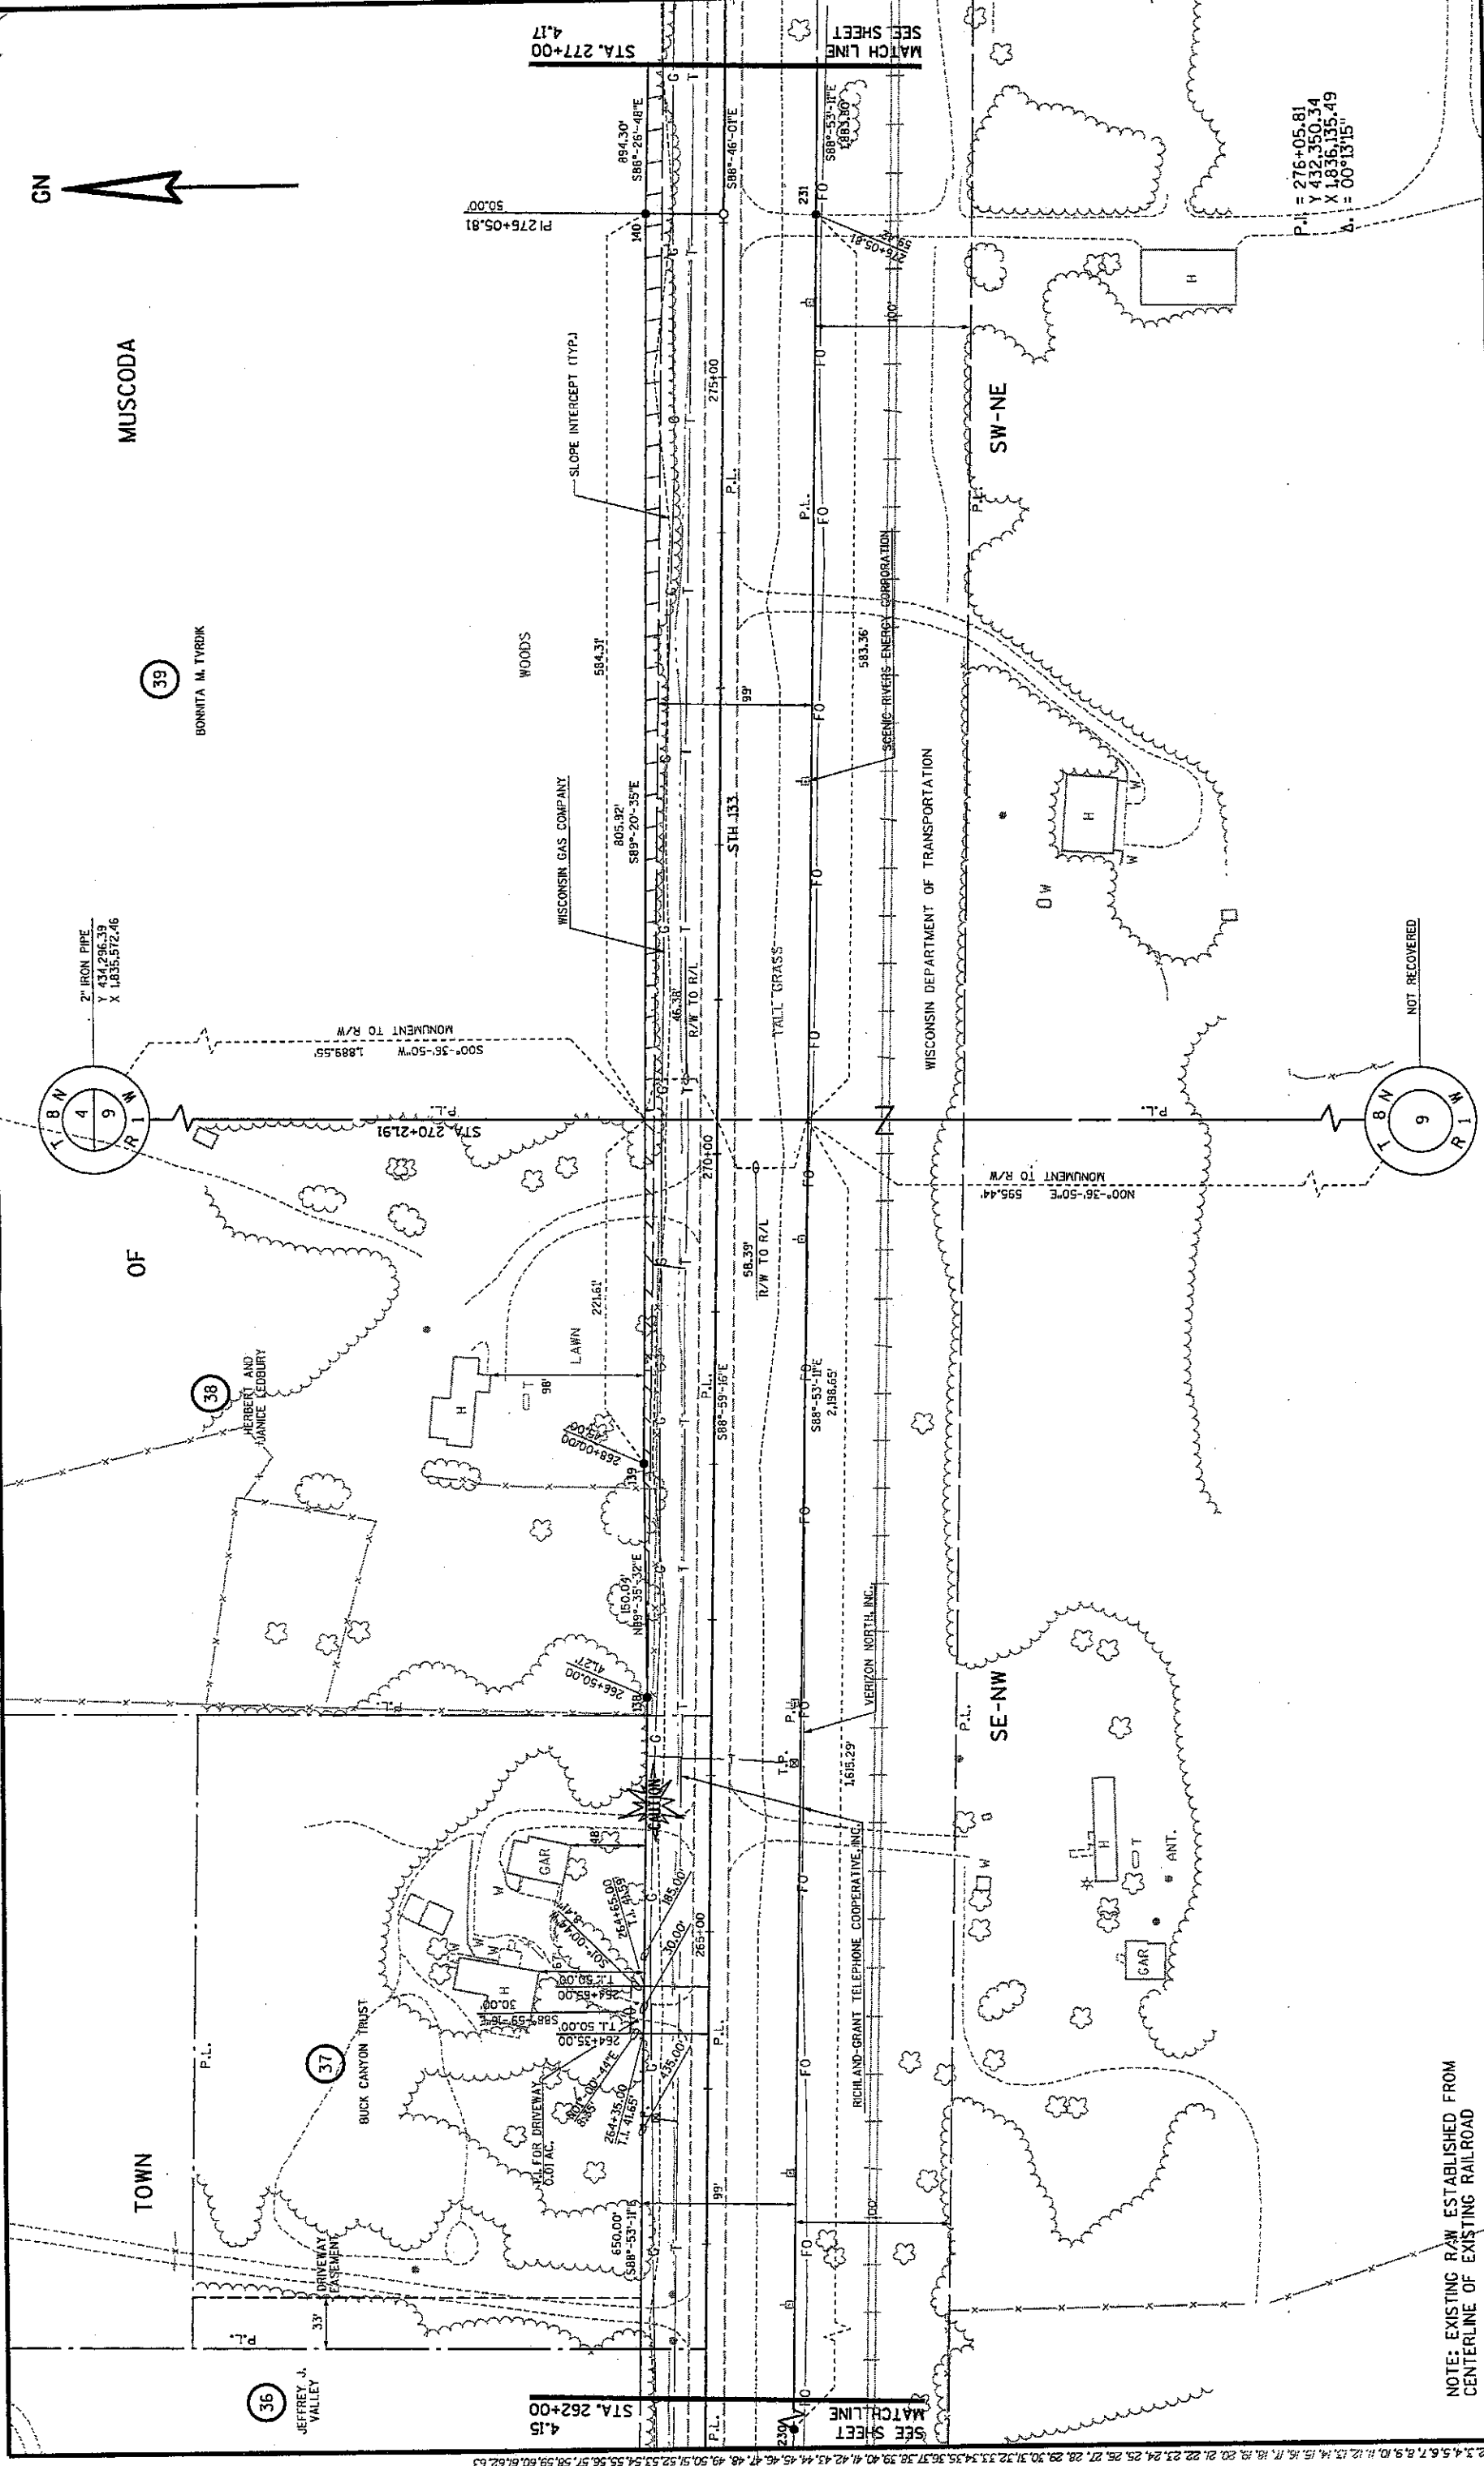

MUSCODA

01

# TOWN

**BONNITA M. TYRDIK**

38

36

37

BUCK CANYON TRUST

2

16

STA. 277+00  
4-17

SEE SHEET  
MATCHLINE

MATCH LINE  
SEE SHEET

P.I. = 276+05.81  
Y 432,350.34  
X 1,836,135.49  
Δ. = 00°13'15"

FILE NAME :

ORIGINATOR :

PLOT NAME :

PLOT SCALE :

PLOT DATE: \*\*plottingdate\*\*

WISDOT/CADDS SHEET 75

REVISION DATE: 2-21-03 N.C.

SCALE, FEET:



DATE: 10-17-01

GRID FACTOR:

0.99996

HIGHWAY: S.T.H. 133

COUNTY:

GRANT

R/W PROJECT NUMBER:


5616-02-21

SHEET NUMBER:

4.17

E

NOTE: EXISTING R/W ESTABLISHED FROM  
CENTERLINE OF EXISTING RAILROAD


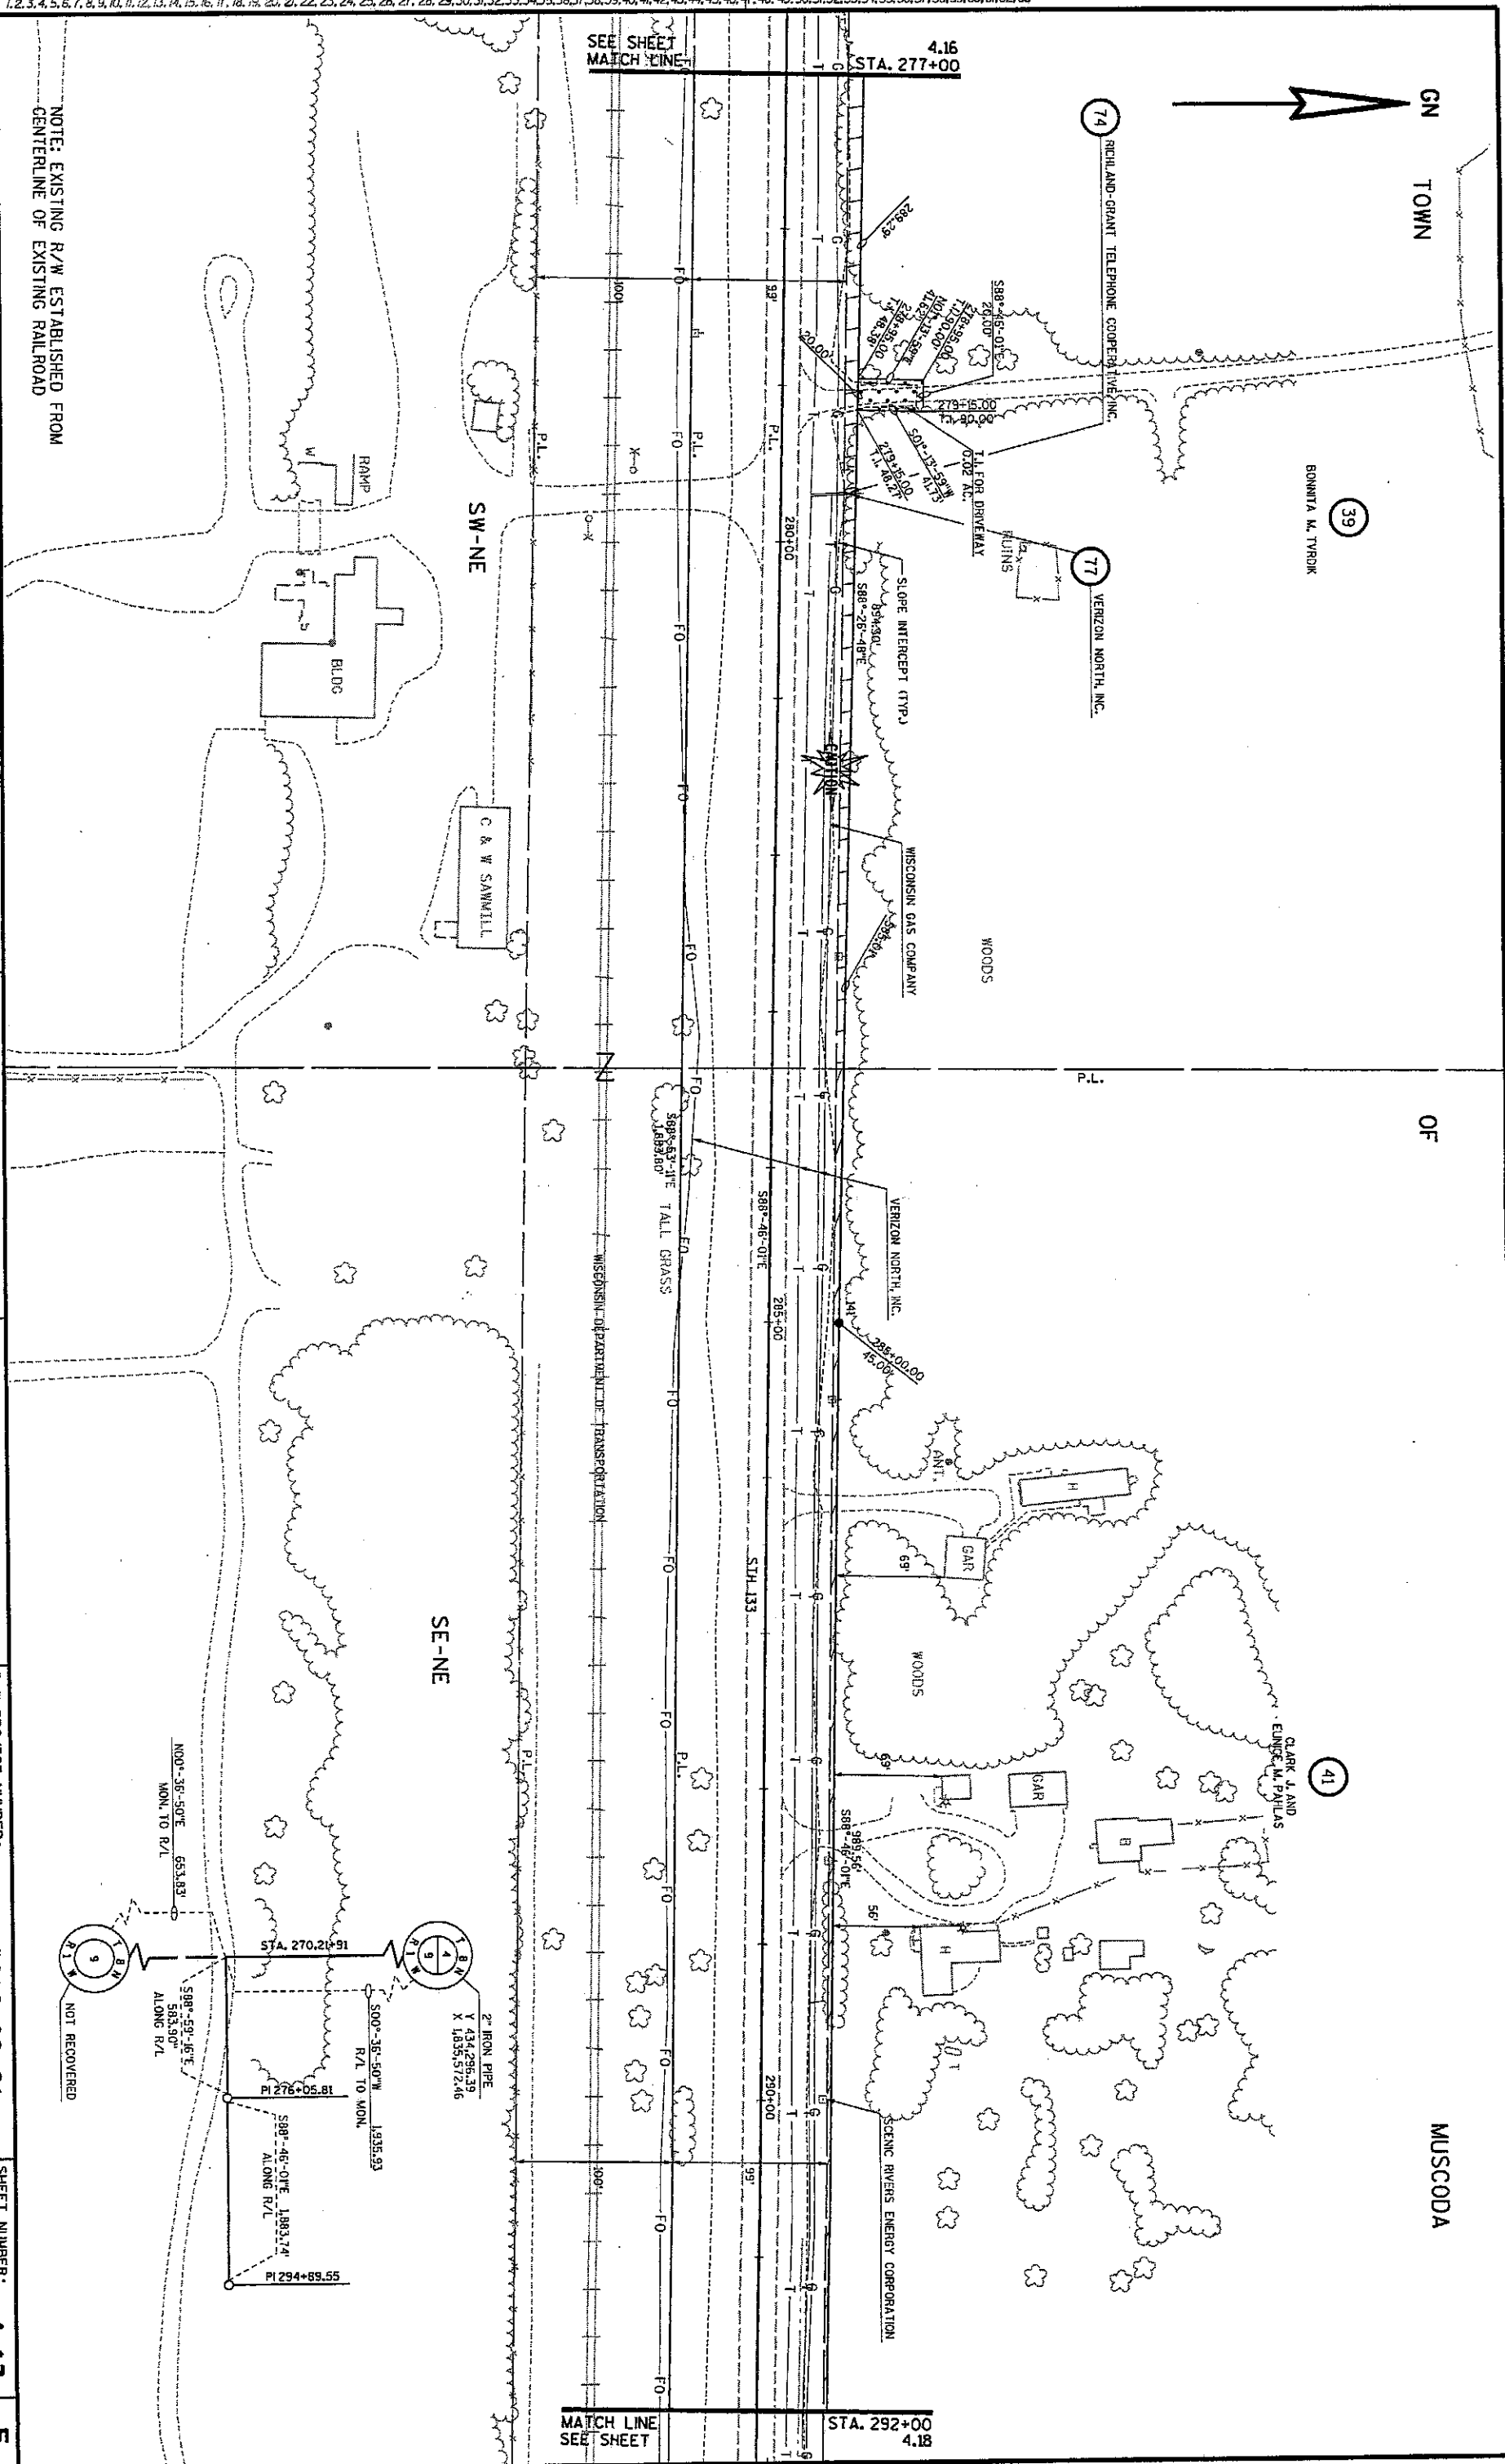








100

1

NOTE: EXISTING R/W ESTABLISHED FROM  
CENTERLINE OF EXISTING RAILROAD

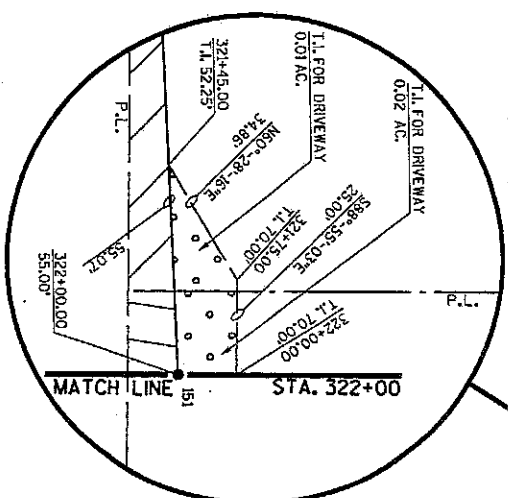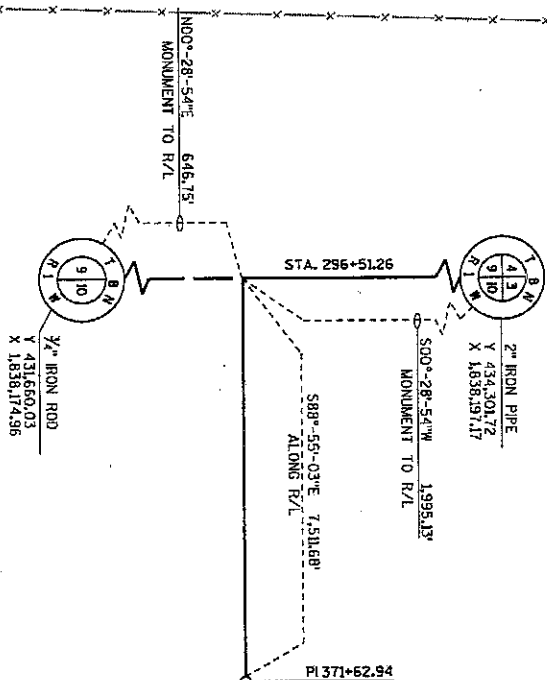

NOTE: EXISTING R/W ESTABLISHED FROM  
CENTERLINE OF EXISTING RAILROAD

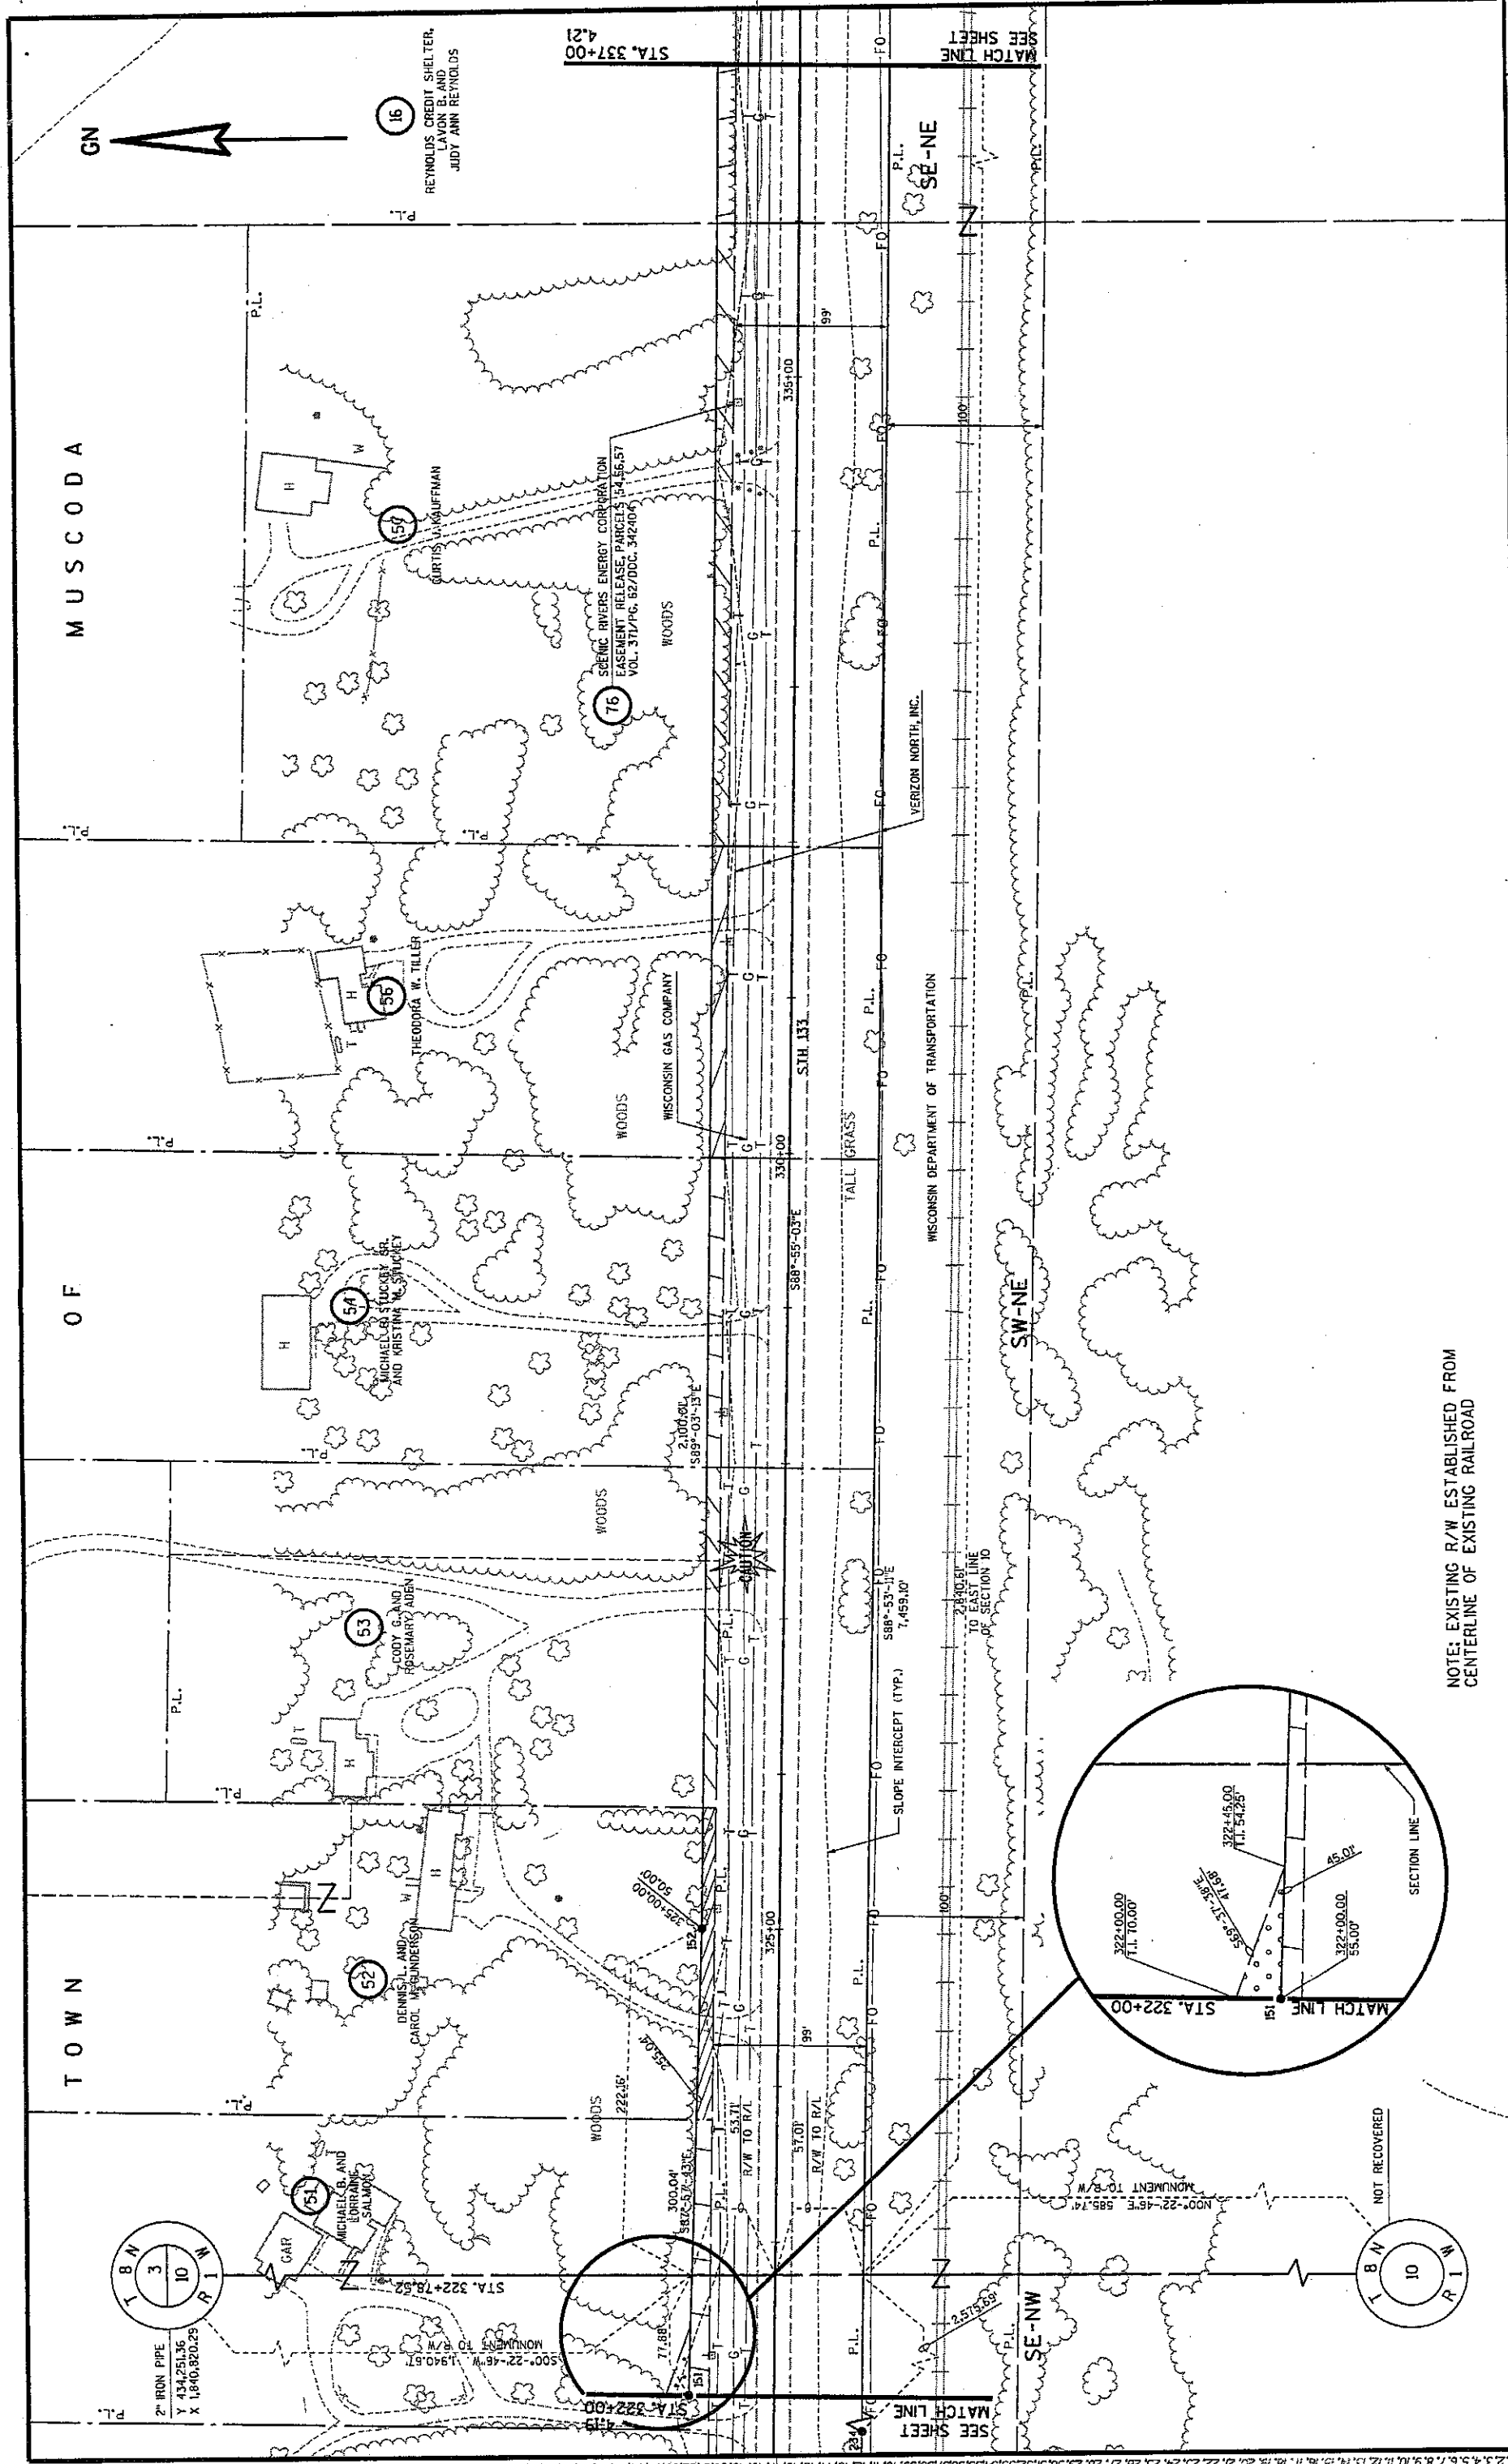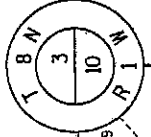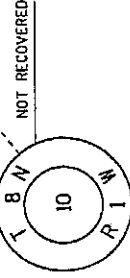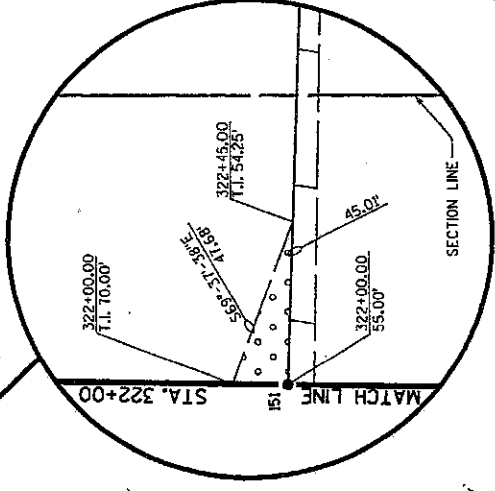

STA. 337+00  
4.21

MATCH LINE  
SEE SHEET

SE-NE

SW-NE

SE-NW

USER-  
02/24/2003  
12:49:15 PM

1. 2. 3. 62. 63

FILE NAME :

ORIGINATOR :

PLOT NAME :

PLOT SCALE :

PLOT DATE: \$\$.plottingdate.\$

WISDOT/CADDIS SHEET 75

REVISION DATE: 2-21-03 N.C.

SCALE, FEET: 0 100

DATE: 10-17-01

HIGHWAY: S.T.H. 133

R/W PROJECT NUMBER: 5616-02-21

SHEET NUMBER: 4.21


E



GRID FACTOR: 0.99996

COUNTY: GRANT

FEDERAL PROJECT NUMBER:

NOTE: EXISTING R/W ESTABLISHED FROM CENTERLINE OF EXISTING RAILROAD

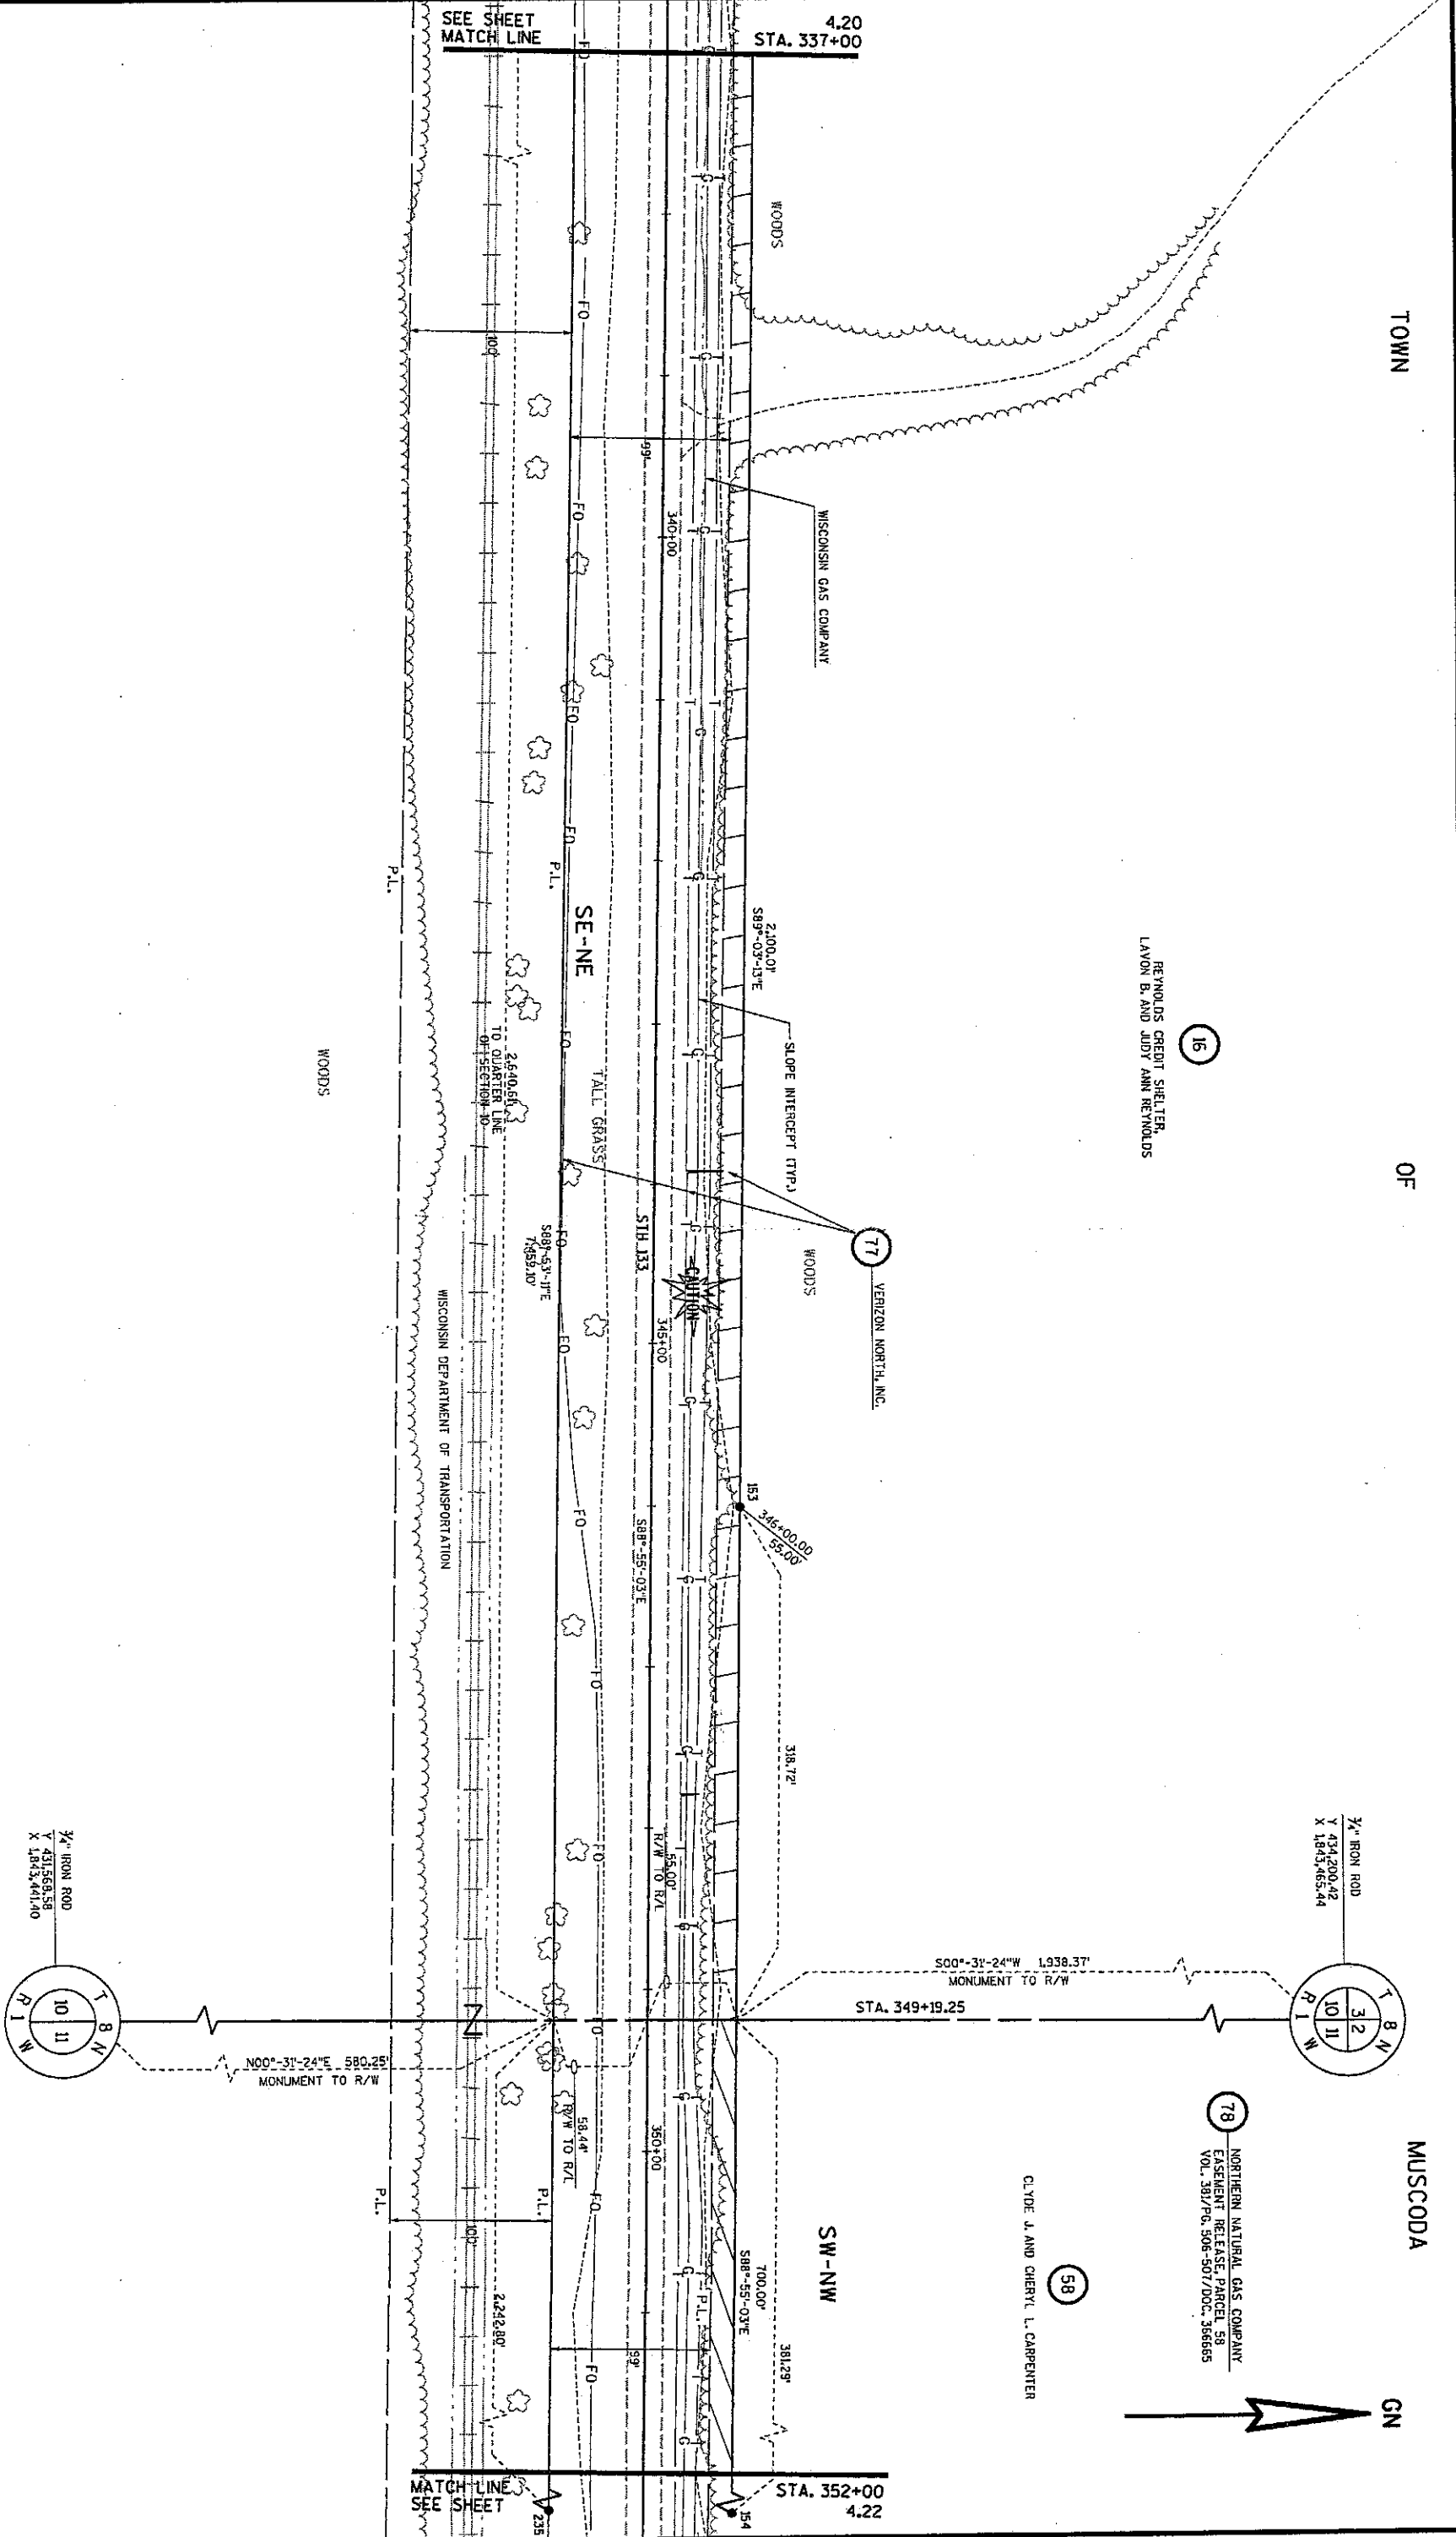

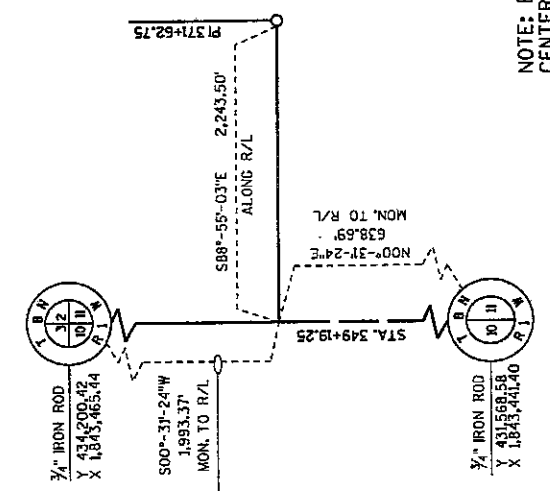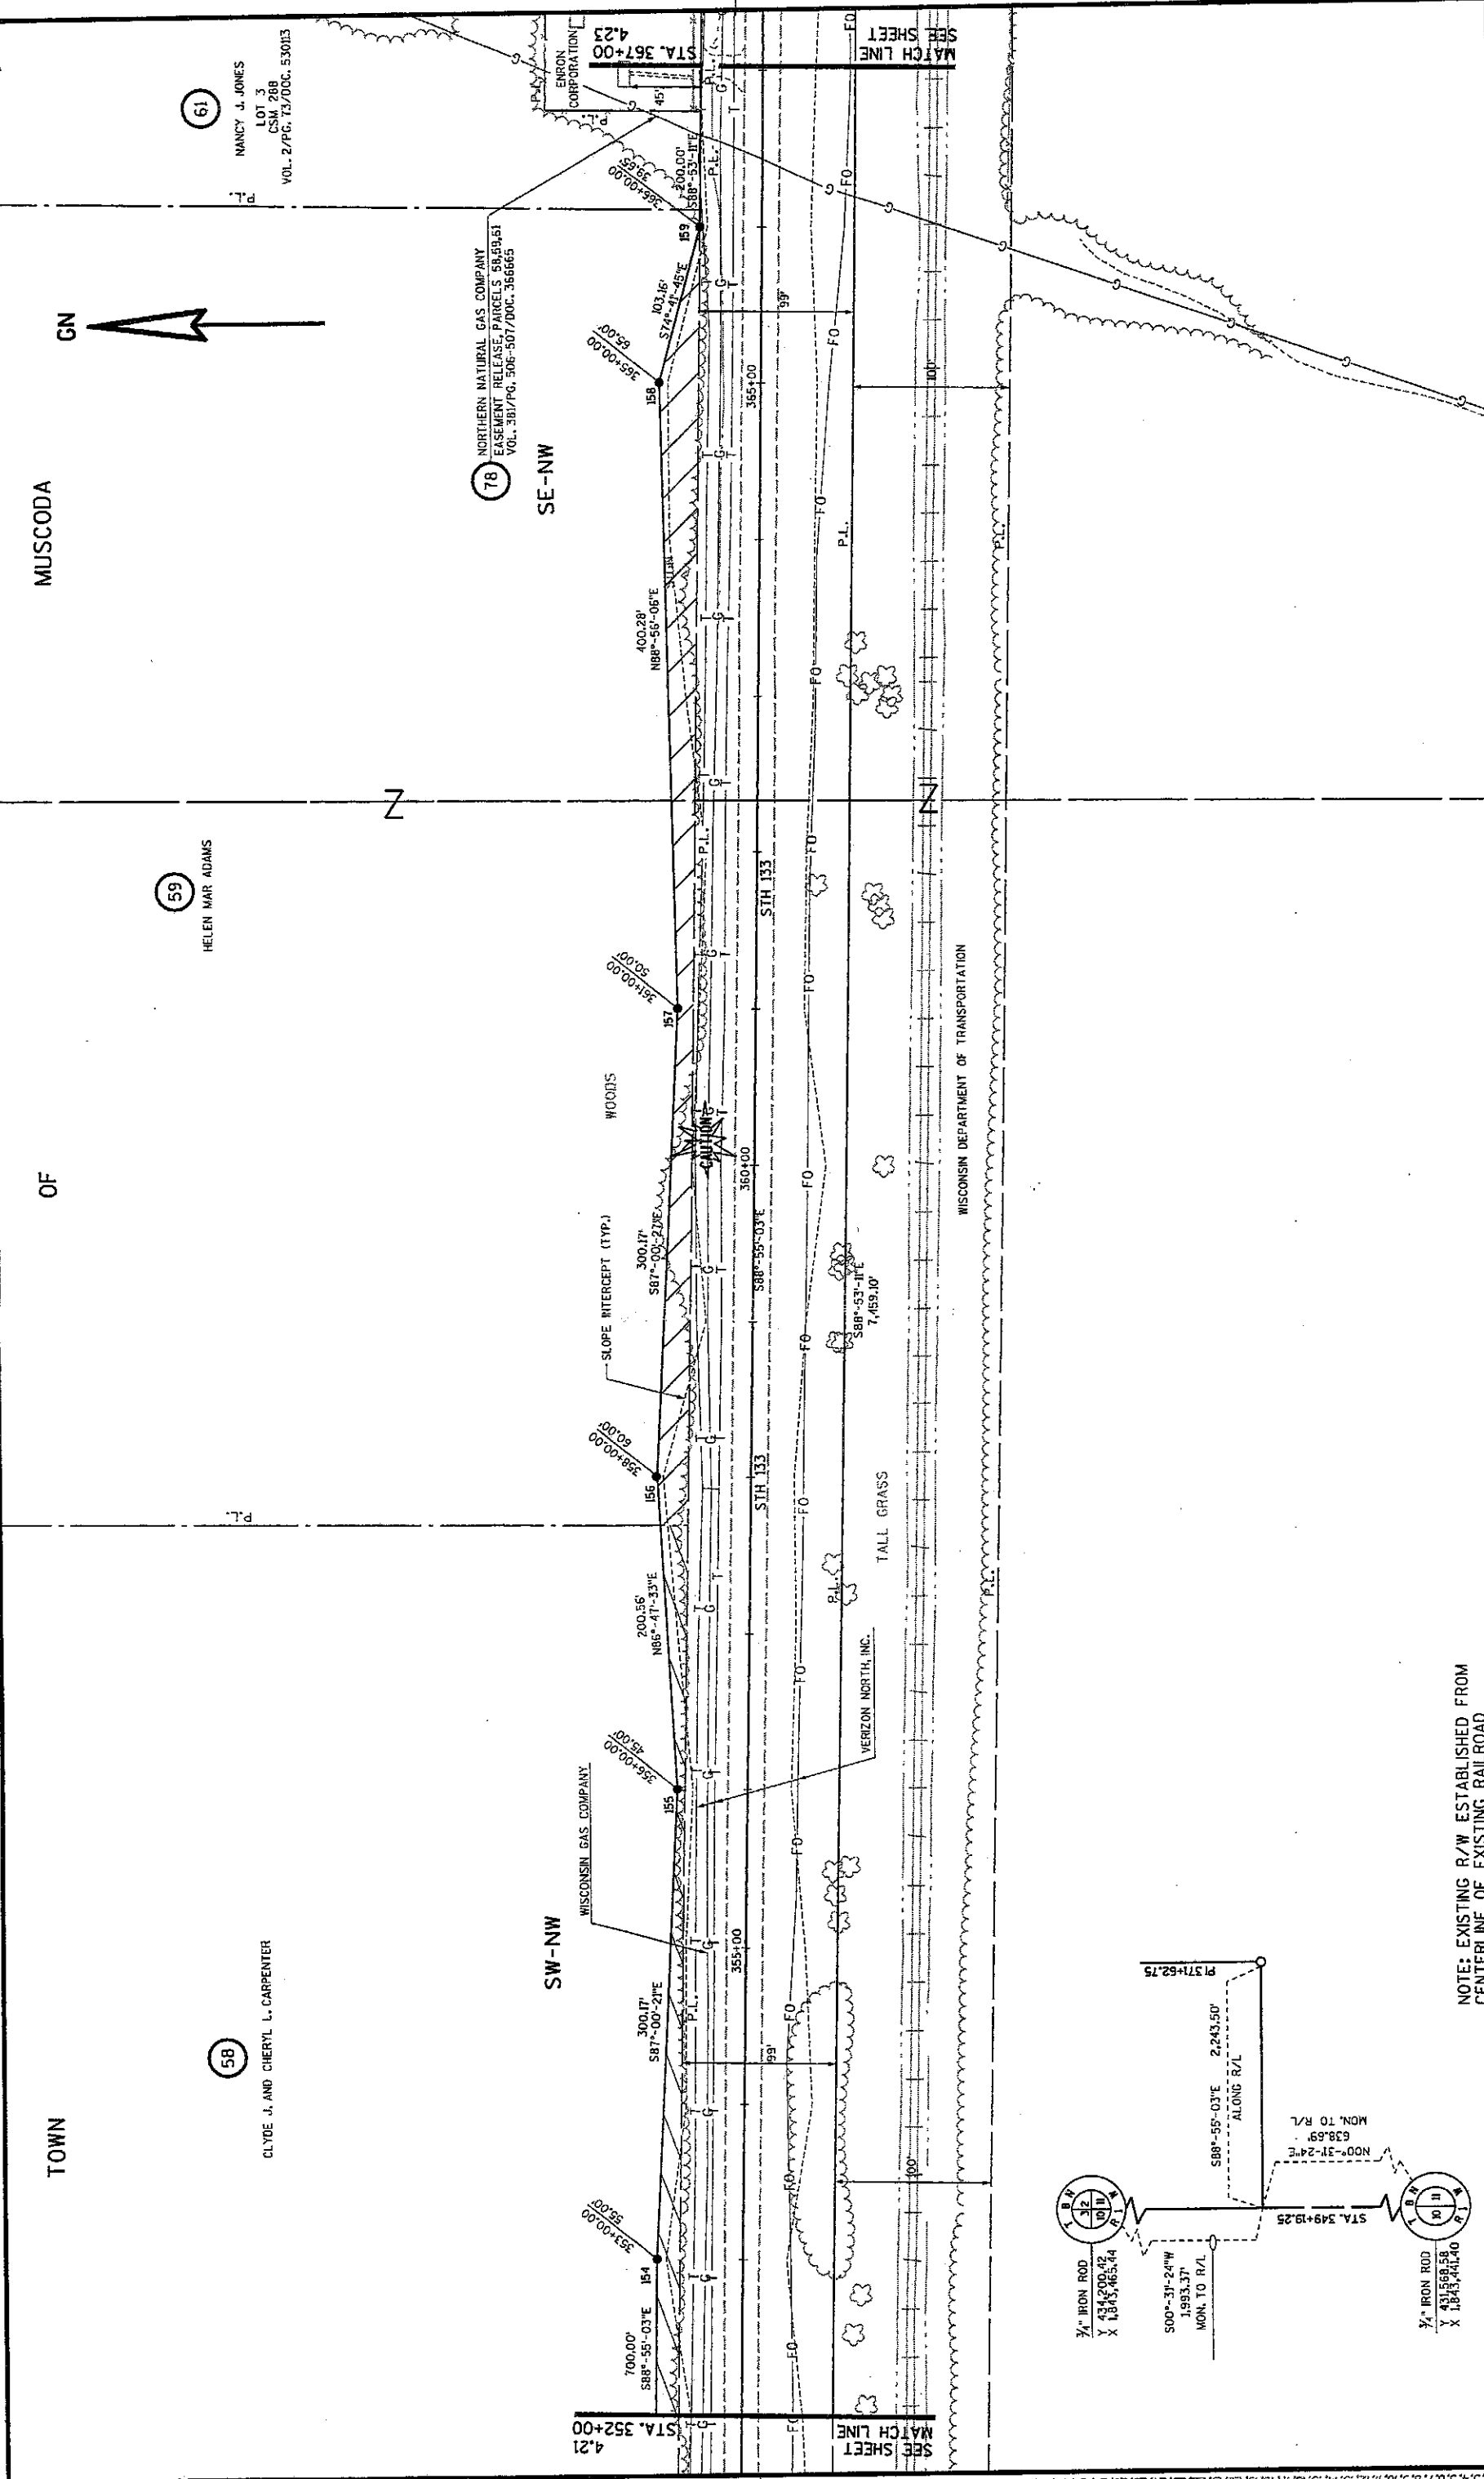

NOTE: EXISTING R/W ESTABLISHED FROM  
CENTERLINE OF EXISTING RAILROAD

|                             |                    |                      |                     |                                |                    |   |
|-----------------------------|--------------------|----------------------|---------------------|--------------------------------|--------------------|---|
| REVISION DATE: 2-21-03 N.C. | SCALE: FEET: 0 100 | DATE: 10-17-01       | HIGHWAY: S.T.H. 133 | R/W PROJECT NUMBER: 5616-02-21 | SHEET NUMBER: 4.22 | E |
|                             |                    | GRID FACTOR: 0.99996 | COUNTY: GRANT       | FEDERAL PROJECT NUMBER:        |                    |   |

FILE NAME :

ORIGINATOR :

PLOT NAME :

PLOT SCALE :

PLOT DATE: 08.11.2003

REVISION DATE: 2-21-03

SCALE, FEET:



DATE: 10-17-01

GRID FACTOR:

0.99996

HIGHWAY:

S.T.H. 133

COUNTY:

GRANT

R/W PROJECT NUMBER:

5616-02-21

FEDERAL PROJECT NUMBER:

SHEET NUMBER: 4.23

E

NOTE: EXISTING R/W ESTABLISHED FROM  
CENTERLINE OF EXISTING RAILROAD

P.L. = 371+62.75  
X 1845.630,24  
Y 432.164,82  
A. = 0°11'21"

P.L. = 379+15.27  
X 1846.442,55  
Y 432.148,13  
A. = 0°04'32"

P.L. = 382+05.13  
X 1846.732,34  
Y 432.142,08  
A. = 0°08'10"

NOT RECOVERED

N00°-42'-55"E 569.21'  
MONUMENT TO R/W.

N00°-42'-55"E 1,935.30'  
R/W TO MONUMENT

3/4" IRON ROD  
Y 434.165,03  
X 1846.092,41

RENAH J. CHITWOOD

MUSCODA

TOWN

GN

SEE SHEET  
MATCH LINE

4.22  
STA. 367+00

EMERSON  
CORPORATION

LOT 3  
CSM 288  
VOL. 27/P. 73/DOC. 53013

LOT 2  
CSM 288  
VOL. 27/P. 73/DOC. 53013

NORTHERN NATURAL GAS COMPANY  
EASEMENT RELEASE, PARCELS 3-59,61,62,63  
VOL. 381/P. 6, 506-507/DOC. 568565

ISRAEL GUTIERREZ  
LOT 2  
CSM 288  
VOL. 27/P. 73/DOC. 53013

TERRY AND HELEN MARY ADAMS

NEEL AND  
JERRY SCHELL

JESSE R. AND KAREN M. EWING

JILL M. HARRIS

MATCH LINE  
SEE SHEET

STA. 382+05.13  
4.24



FILE NAME:

ORIGINATOR:

PLOT NAME:

PLOT SCALE:

PLOT DATE: 6-11-2003

WISDOT/CADD SHEET 75

REVISION DATE: 2-21-03 N.C.

SCALE, FEET: 0 100

DATE: 10-17-01

HIGHWAY: S.T.H. 133

R/W PROJECT NUMBER: 5616-02-21

SHEET NUMBER: 4.25

E


GRID FACTOR: 0.99996

COUNTY: GRANT

FEDERAL PROJECT NUMBER:

WISDOT/CADD SHEET 75

NOTE: EXISTING R/W ESTABLISHED FROM CENTERLINE OF EXISTING RAILROAD

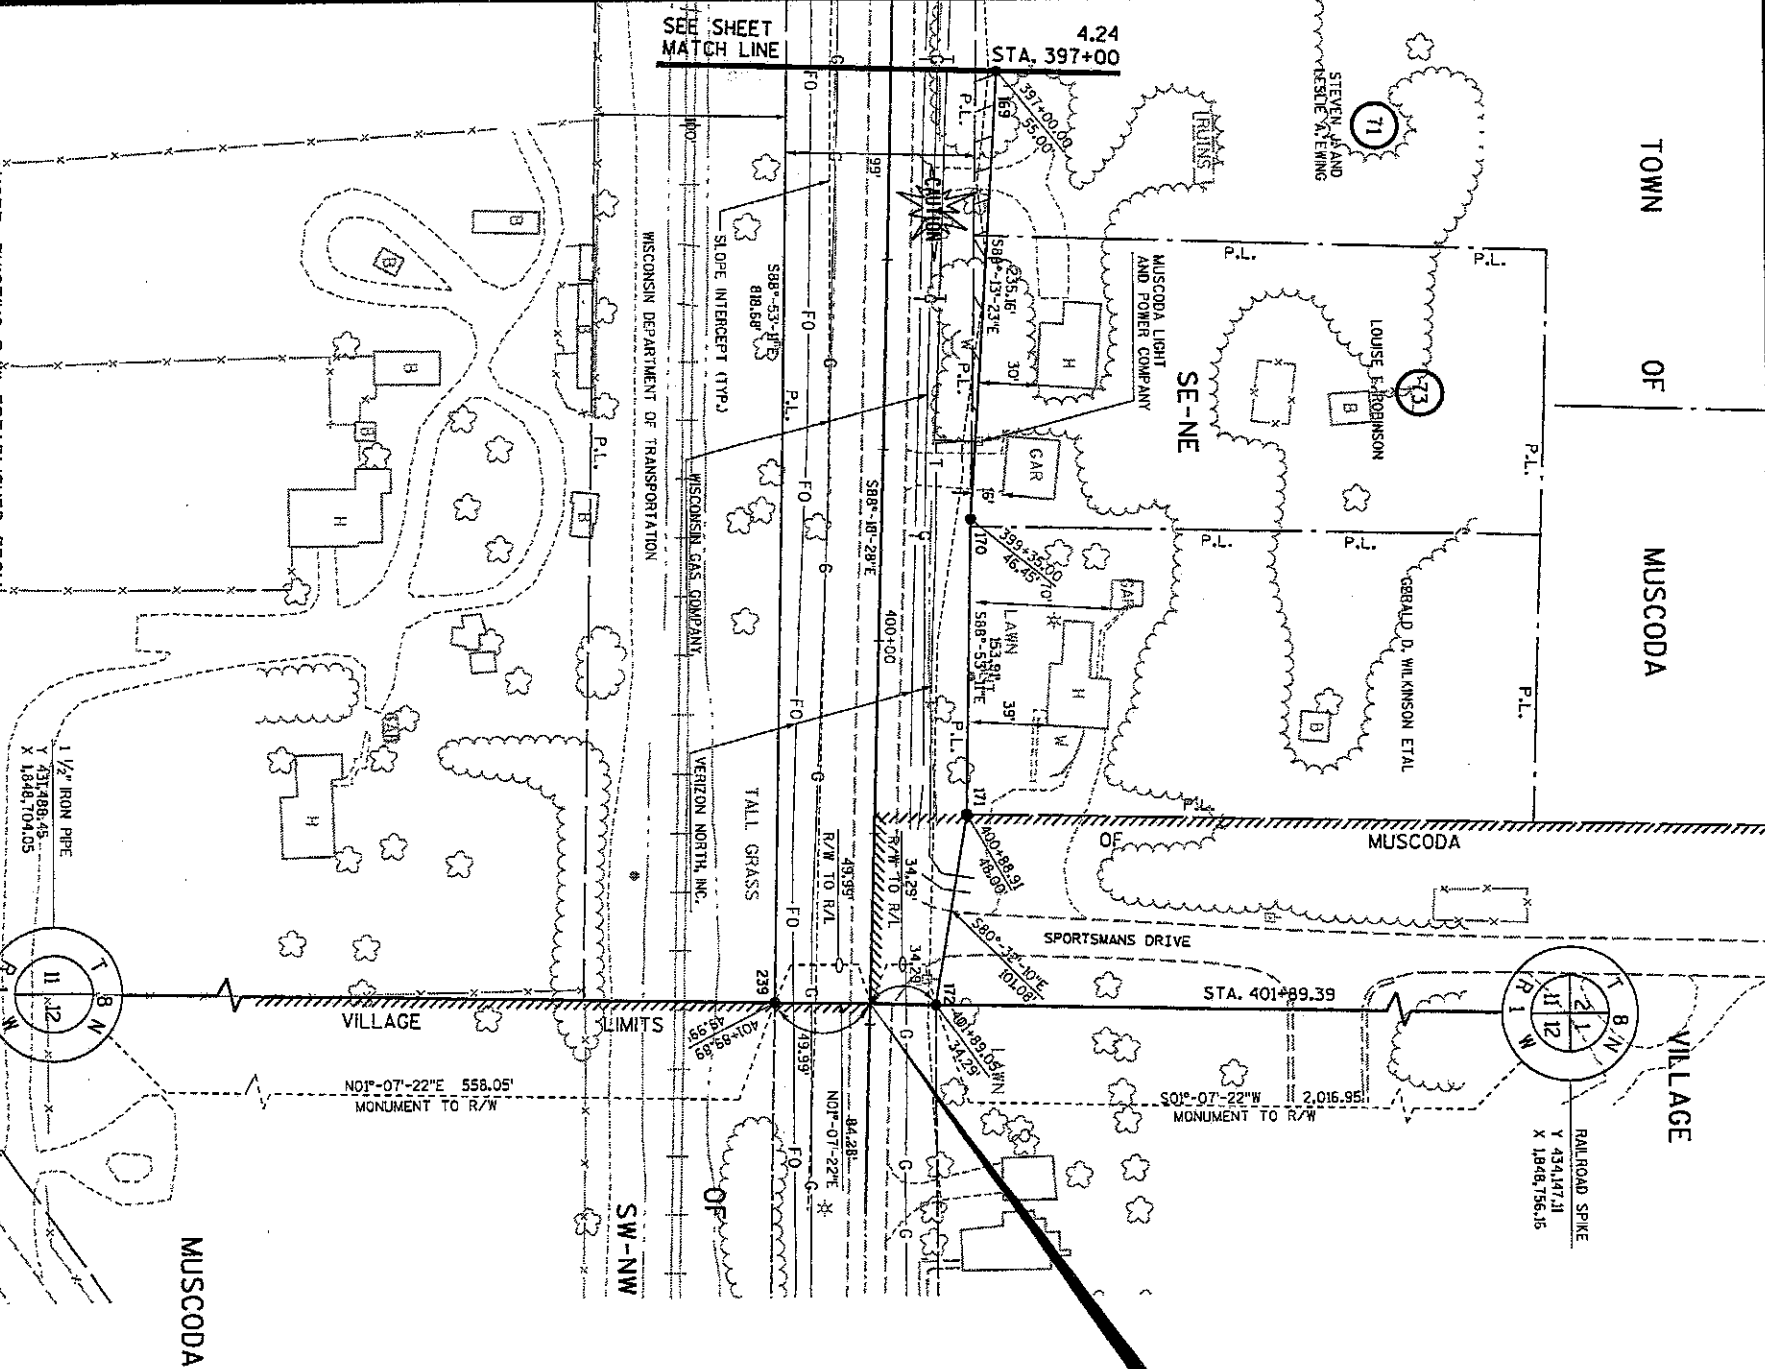

END RELOCATION ORDER  
STA. 401+89.89  
Y 432,096.35  
X 1,848,715.96

| POINT | Y          | X            |
|-------|------------|--------------|
| 100   | 433,854.28 | 1,819,790.19 |
| 101   | 433,853.65 | 1,819,870.96 |
| 102   | 433,829.90 | 1,820,031.32 |
| 103   | 433,866.05 | 1,820,227.96 |
| 104   | 433,857.78 | 1,820,293.90 |
| 105   | 433,673.04 | 1,820,505.82 |
| 106   | 433,621.65 | 1,820,603.15 |
| 107   | 433,448.58 | 1,820,918.19 |
| 108   | 433,365.94 | 1,821,075.03 |
| 109   | 433,333.03 | 1,821,166.29 |
| 110   | 433,276.96 | 1,821,451.11 |
| 111   | 433,271.07 | 1,821,561.14 |
| 112   | 433,267.24 | 1,823,264.05 |
| 113   | 433,220.81 | 1,825,140.29 |
| 114   | 433,204.14 | 1,825,447.94 |
| 115   | 433,186.68 | 1,826,172.21 |
| 116   | 433,165.89 | 1,826,647.08 |
| 117   | 433,147.88 | 1,827,188.58 |
| 118   | 433,127.94 | 1,827,350.50 |
| 119   | 433,163.20 | 1,827,609.24 |
| 120   | 433,139.63 | 1,827,675.07 |
| 121   | 433,117.81 | 1,827,695.86 |
| 122   | 432,972.75 | 1,827,834.04 |
| 123   | 432,798.40 | 1,828,302.88 |
| 124   | 432,592.06 | 1,828,784.06 |
| 125   | 432,543.17 | 1,828,947.13 |
| 126   | 432,523.60 | 1,829,298.55 |
| 127   | 432,514.09 | 1,829,747.54 |
| 128   | 432,488.58 | 1,831,060.16 |
| 129   | 432,464.20 | 1,832,314.00 |
| 130   | 432,458.05 | 1,832,630.31 |
| 131   | 432,535.17 | 1,832,888.58 |
| 132   | 432,534.86 | 1,832,954.75 |
| 133   | 432,446.77 | 1,833,210.73 |
| 134   | 432,439.29 | 1,833,595.65 |
| 135   | 432,439.17 | 1,833,937.69 |
| 136   | 432,433.99 | 1,834,230.94 |
| 137   | 432,421.12 | 1,834,530.75 |
| 138   | 432,408.49 | 1,835,180.60 |
| 139   | 432,409.56 | 1,835,330.63 |

| POINT | Y          | X            |
|-------|------------|--------------|
| 140   | 432,400.32 | 1,836,136.47 |
| 141   | 432,316.08 | 1,837,030.41 |
| 142   | 432,354.79 | 1,838,019.70 |
| 143   | 432,441.85 | 1,838,175.92 |
| 144   | 432,440.60 | 1,838,241.91 |
| 145   | 432,347.05 | 1,838,429.93 |
| 146   | 432,342.60 | 1,838,929.92 |
| 147   | 432,340.04 | 1,839,329.92 |
| 148   | 432,332.48 | 1,839,729.65 |
| 149   | 432,318.03 | 1,840,229.64 |
| 150   | 432,307.36 | 1,840,529.48 |
| 151   | 432,313.58 | 1,840,729.62 |
| 152   | 432,302.91 | 1,841,029.46 |
| 153   | 432,268.23 | 1,843,129.09 |
| 154   | 432,255.01 | 1,843,828.94 |
| 155   | 432,239.33 | 1,844,128.69 |
| 156   | 432,230.55 | 1,844,328.92 |
| 157   | 432,234.88 | 1,844,628.67 |
| 158   | 432,247.32 | 1,845,028.87 |
| 159   | 432,215.09 | 1,845,128.37 |
| 160   | 432,211.20 | 1,845,328.32 |
| 161   | 432,223.88 | 1,845,528.57 |
| 162   | 432,208.82 | 1,845,691.19 |
| 163   | 432,212.31 | 1,846,028.62 |
| 164   | 432,198.11 | 1,846,443.63 |
| 165   | 432,192.06 | 1,846,733.32 |
| 166   | 432,191.59 | 1,847,028.17 |
| 167   | 432,171.89 | 1,847,227.94 |
| 168   | 432,165.47 | 1,847,898.96 |
| 169   | 432,165.74 | 1,848,228.43 |
| 170   | 432,150.25 | 1,848,463.05 |
| 171   | 432,147.25 | 1,848,616.64 |
| 172   | 432,130.63 | 1,848,716.64 |

| POINT | Y          | X            |
|-------|------------|--------------|
| 200   | 433,766.68 | 1,819,780.17 |
| 201   | 433,764.62 | 1,819,857.77 |
| 202   | 433,730.98 | 1,820,016.67 |
| 203   | 433,658.69 | 1,820,336.51 |
| 204   | 433,552.20 | 1,820,563.50 |
| 205   | 433,373.91 | 1,820,875.53 |
| 206   | 433,273.20 | 1,821,031.66 |
| 207   | 433,224.31 | 1,821,239.95 |
| 208   | 433,186.29 | 1,821,443.34 |
| 209   | 433,181.07 | 1,821,560.94 |
| 210   | 433,189.53 | 1,822,247.39 |
| 211   | 433,183.85 | 1,822,547.37 |
| 212   | 433,187.24 | 1,823,262.86 |
| 213   | 433,154.00 | 1,823,745.87 |
| 214   | 433,155.30 | 1,824,245.80 |
| 215   | 433,130.86 | 1,825,137.35 |
| 216   | 433,096.75 | 1,826,169.01 |
| 217   | 433,074.30 | 1,826,844.14 |
| 218   | 433,052.94 | 1,827,185.42 |
| 219   | 432,967.41 | 1,827,634.73 |
| 220   | 432,898.64 | 1,827,803.92 |
| 221   | 432,658.85 | 1,828,354.10 |
| 222   | 432,508.68 | 1,828,750.18 |
| 223   | 432,430.08 | 1,828,975.43 |
| 224   | 432,424.60 | 1,829,257.30 |
| 225   | 432,415.10 | 1,829,745.96 |
| 226   | 432,389.59 | 1,831,058.46 |
| 227   | 432,365.19 | 1,832,313.18 |
| 228   | 432,353.73 | 1,832,903.32 |
| 229   | 432,352.44 | 1,832,970.04 |
| 230   | 432,333.65 | 1,833,936.18 |
| 231   | 432,290.92 | 1,836,134.32 |
| 232   | 432,254.31 | 1,838,017.70 |
| 233   | 432,251.44 | 1,838,165.58 |
| 234   | 432,250.15 | 1,838,231.60 |
| 235   | 432,105.20 | 1,846,588.99 |
| 236   | 432,090.57 | 1,846,441.31 |
| 237   | 432,084.94 | 1,846,731.21 |
| 238   | 432,062.28 | 1,847,896.48 |
| 239   | 432,046.37 | 1,848,714.98 |