



The State of Wisconsin

HIGHWAY COMMISSION
STATE OFFICE BUILDING
MADISON 2

October 23, 1952

Mr. Eugene Croft
Grant County Highway Commissioner
Lancaster, Wisconsin

Mr. Alonzo Aupperle
County Clerk, Grant County
Lancaster, Wisconsin

Gentlemen:

SUBJECT: Project S 0200(1)
Cassville-Bloomington Road
S.T.H. 133
Grant County

FILED

OCT 24 1952

ALONZO AUPPERLE
COUNTY CLERK
GRANT COUNTY, WIS.

The Highway Commission deems it necessary to make certain revisions on a previously approved right-of-way plat and to acquire certain lands and interests in lands according to such revisions, for the proper improvement or maintenance of the above-designated project and highway. The revised relocation order of the Commission and the map showing the highway as laid out and established and the lands and interests to be acquired are transmitted herewith.

The enclosed relocation order provides that the county highway committee shall make the necessary acquisitions of lands and interests not previously acquired, pursuant to Section 84.09(3), Wisconsin Statutes.

Very truly yours

STATE HIGHWAY COMMISSION OF WISCONSIN

O. J. Hughes
O. J. Hughes
Secretary

OJH:MO
CC: DE#9
WBB
Enc.

RELOCATION ORDER
BY STATE HIGHWAY COMMISSION OF WISCONSIN

* * * * *

THE STATE HIGHWAY COMMISSION FINDS AND DETERMINES THAT:

The proper establishing, laying out, widening, enlarging, extending, constructing, reconstructing, improving, or maintaining a portion of the highway now designated as State Trunk Highway 133, from a point 640 feet south and 30 feet east of the west one-quarter corner of Section 20, Township 3 North, Range 5 West, and extending thence northerly to a point 680 feet east and 75 feet south of the north one-quarter corner of Section 26, Township 5 North, Range 5 West,

and on roads or lands in and about and along and leading to same, requires certain relocation or change and the acquisition of lands or interests in lands as shown on the map or copy thereof marked

"PLAT OF RIGHT OF WAY REQUIRED, PROJECT S 0200(1),"

for the Cassville-Bloomington Road,

S.T. H. 133, Grant County, dated October 1, 1952,
and 4.8

the same being sheets No. 4, 4.1, 4.2, 4.3, 4.4, 4.5, 4.6, 4.7, of the plans for said project, and

Pursuant to its authority under Sections 84.02 (3) and 84.09, Wisconsin Statutes,

THE STATE HIGHWAY COMMISSION HEREBY ORDERS THAT:

(1) The said highway is hereby laid out and established to the lines and widths as shown on the said plat.


(2) The required lands or interests in lands as shown on the plat shall be acquired by the County Highway Committee of the county in which the lands are situate, pursuant to the provisions of Section 84.09 (3), Wisconsin Statutes. However, said County Highway Committee shall have no authority to settle or compromise any action or proceeding which might arise because of acts done by it in complying with this order, without prior written approval by the State Highway Commission.

(3) Buildings, fixtures or chattels acquired incident to the acquisition of lands or rights in lands under this order, and to be removed, shall, subject to approval of the Highway Commission, be sold by the County Highway Committee at public or private sale to the highest bidder, and the net proceeds of such sale paid into the state highway fund.

(4) This order supersedes and amends the previous order issued by the Commission on June 13, 1951.

* * * * *

The foregoing order was issued by the State Highway Commission and entered in the minutes of its meeting on October 22, 1952.

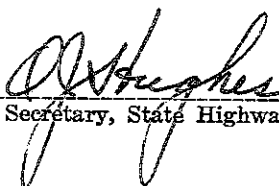

 Secretary, State Highway Commission of Wisconsin



SCHEDULE OF LANDS AND INTERESTS REQUIRED				
PARCEL	OWNER	ACRES	FOOT OF FENCING TO BUILD TO MOVE	INTEREST REQUIRED
1	TOWN SCHWABER ET AL	0.10	29	HIGHWAY EASEMENT
2	H. KLEIN	3.10	19	"
3	MARGARET ESSER	0.23	47	"
4	LEWIS LAU	0.17	5	"
5	WM. P. BAUSCH	2.14	169	"
6	MARGARET ESSER ET AL	0.96	110	"
7	ALEX. KIRSCHBAUM	0.45	90	"
8	VICTOR LAUGESON	2.30	161	"
9	JOE CASANOVA	4.05	130	"
10	ADAM KIRSCHBAUM	1.33	78	"
11	MYRA ECKSTEIN	1.37	44	"
12	A.B. YOUNG	1.61	142	"
13	REINHARDT BAUSCH	4.66	250	"
14	WM. BAUSCH	1.69	130	"
15	CHRIS BREUER	2.20	134	"
16	FRED MUMM	6.67	26	"
17	JOSEPH MUMM	4.79	142	"
18	LOUIS KLEIN	0.20	63	"
19	GABRIEL LINDNER	3.00	48	"
20	JOSEPH MUMM	3.92	108	"
21	VINCENT WEIST	0.46	87	"
22	VINCENT WEIST	1.71	156	"
23	IRMA BRANDT ET AL	1.60	156	"
24	CARL FORKE	4.58	240	"
25	ANNA GARNER	9.97	435	"
26	WM. WENNER	0.26	12	"
27	VERNON HAMPTON	0.04	9	"
28	LOUIS DATTIMAN	0.66	66	"
29	ROY MEYERS	1.03	25	"
30	JOHN J. RYAN	1.06	40	"
31	IRENE RYAN	1.83	193	"
32	LILL WETENS ET AL	4.35	49	"
33	WM. SCHMITZ	0.01	7	"
34	DAVID TAYLOR	2.22	158	"
35	BERNARD ERITZ ET AL	1.03	88	"
36	RUSSEL MEYERS	2.12	136	"
37	DONALD MUMM	0.12	78	"
38	ENUCH WEIST	1.85	157	"
39	GEORGE NEIS	0.68	161	"
40	HERBERT PATTERSON	1.04	92	"
41	RALPH I. HEYER	0.84	300	"
42	FRANK BOHNENKAMP	2.16	78	"
43	WM. S. ELDER POHLE	0.81	88	"
44	ELMER POHLE	1.24	88	"
45	JOHN WEBER	1.41	88	"
46	ANTON J. WELCHERT	0.87	63	"
47	HENRY BONN	1.62	105	"
48	EDWARD HERGENS	3.01	124	"
49	DAY MARTIN	3.47	71	"
50	FRED BREUER	0.25	18	"
51	HERBERT PATTERSON	1.88	103	"
52	RICHARD LEFER	0.26	82	"
53	MONGOE CRITCHFIELD	2.13	78	"
54	ANDREW HOFFMAN	2.83	97	"
55	ELLIOT EDWARDS	2.05	79	"
56	GRANT CO. FARM BUREAU	0.02	4	"
57	HERBERT PATTERSON			LIMITED EASEMENT


ACTIVITY	ROUTE	CLASS AND AGREEMENT	FEDERAL	STATE	TOTAL
HIGHWAY	SECTION	STATE	FEDERAL	WIS.	BN
				4	238

STATE HIGHWAY COMMISSION OF WISCONSIN
PLAT OF RIGHT OF WAY REQUIRED
PROJECT S 0200 (1)
CASSVILLE — BLOOMINGTON
S.H. 133
GRANT
COUNTY
OCTOBER 1, 1932
MAY 8, 1931
DATED MARCH 1, 1931
LENGTH 13.786 MILES
SCALE 1" = 400'

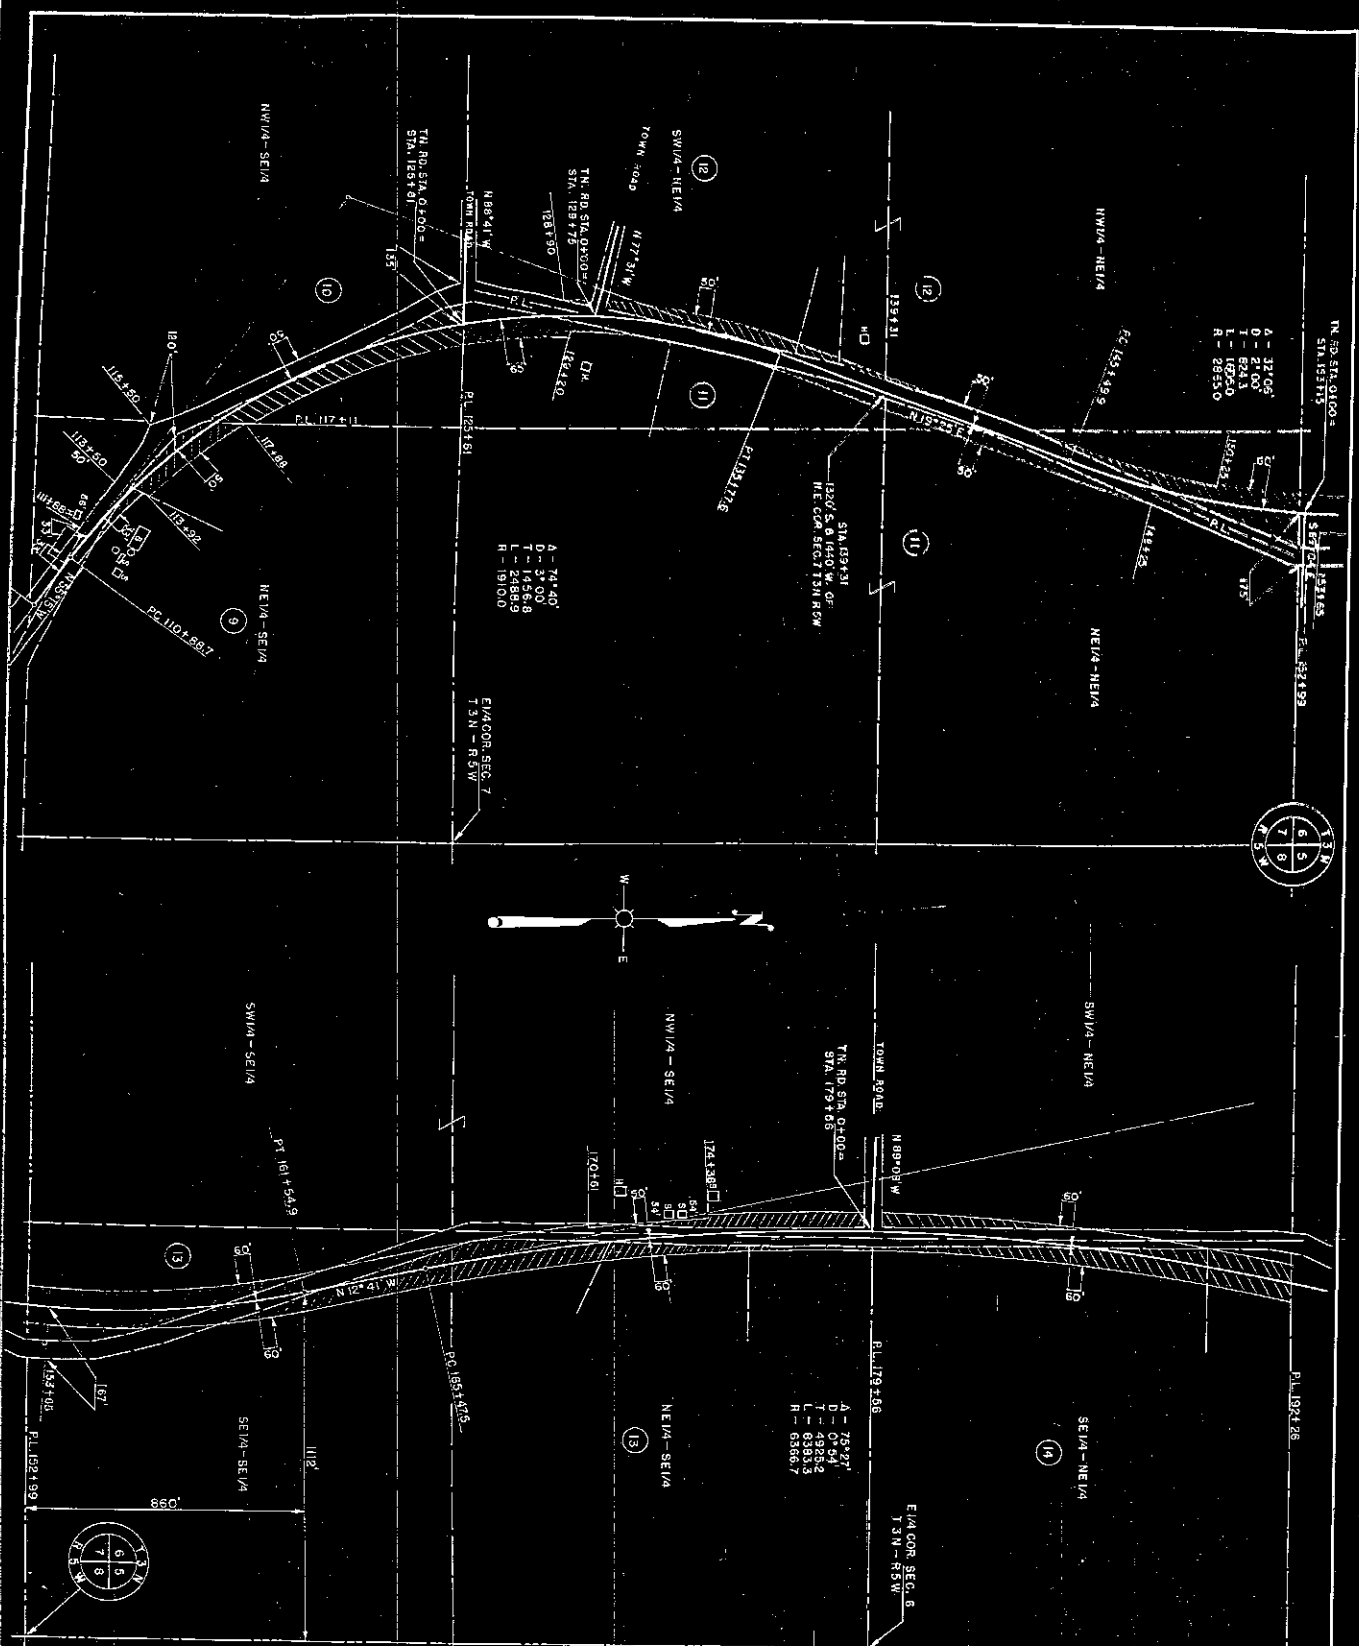

STATE HIGHWAY COMMISSION OF WISCONSIN
 PLAT OF RIGHT OF WAY REQUIRED
 PROJECT 50200(1)
 CASSVILLE — BLOOMINGTON
 S.T.H. 133
 GRANT COUNTY
 ROAD
 DATE: MARCH 1, 1931
 LENGTH: 13.766 M.F.S.
 SCALE: 40' = 1" (1" = 40')

COUNTY	ROUTE	CLASS AND AGREEMENT	DIVISION	DATE	TOTAL
GRANT	133	STATE	1	4.2	336

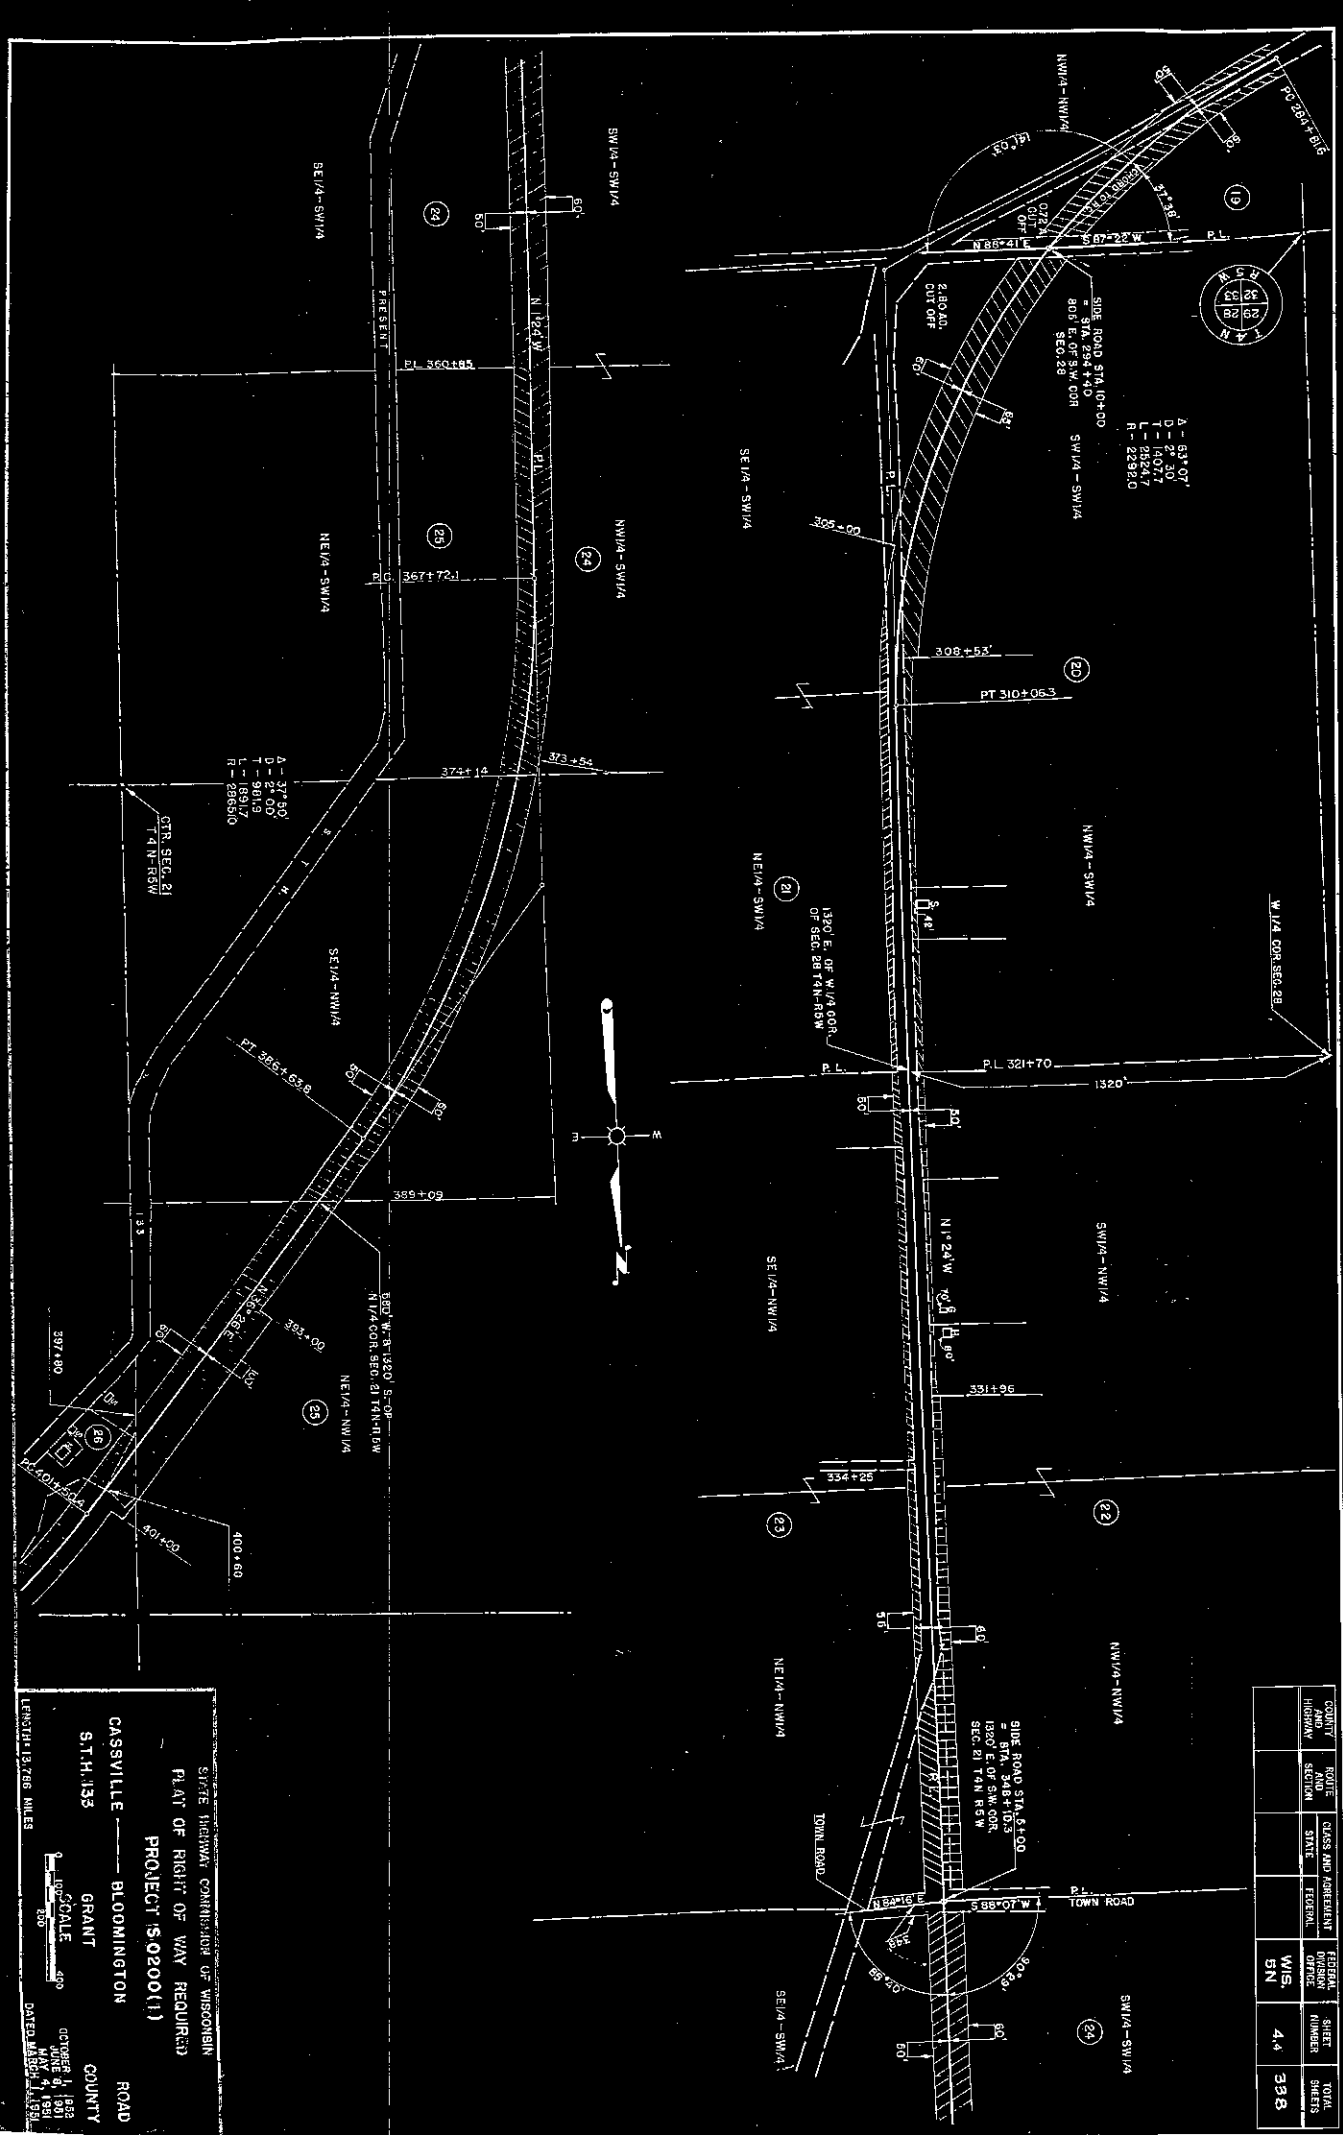


COUNTY	ROUTE	CLASS AND AGREEMENT	FEDERAL	SHEET	TOTAL
GRANT	137	STATE	WIS.	44	338
SECTION	137	STATE	WIS.	44	338
STATE	137	STATE	WIS.	44	338
FEDERAL	137	STATE	WIS.	44	338
WIS.	137	STATE	WIS.	44	338
SN	137	STATE	WIS.	44	338

STATE HIGHWAY COMMISSION OF WISCONSIN
 PLAN OF RIGHT OF WAY REQUIRED
 PROJECT (S0200(1))
 CASSVILLE — BLOOMINGTON
 ROAD
 S.T.H. 135
 GRANT COUNTY
 SCALE
 1" = 40'
 DATE: MARCH 1, 1931
 LENGTH 13.766 MILES

COUNTY	ROUTE	CLASS AND ABREVIATION	SECTION	STATE	FEDERAL	WIS. SN	SHEET NUMBER	TOTAL SHEETS
							46	338




COUNTY	SECTION	CLASS AND ALTERNATE	LENGTH	WIS.	TOTAL
AND	SECTION	STATE	FEET	BN	SHEETS
				4.7	398

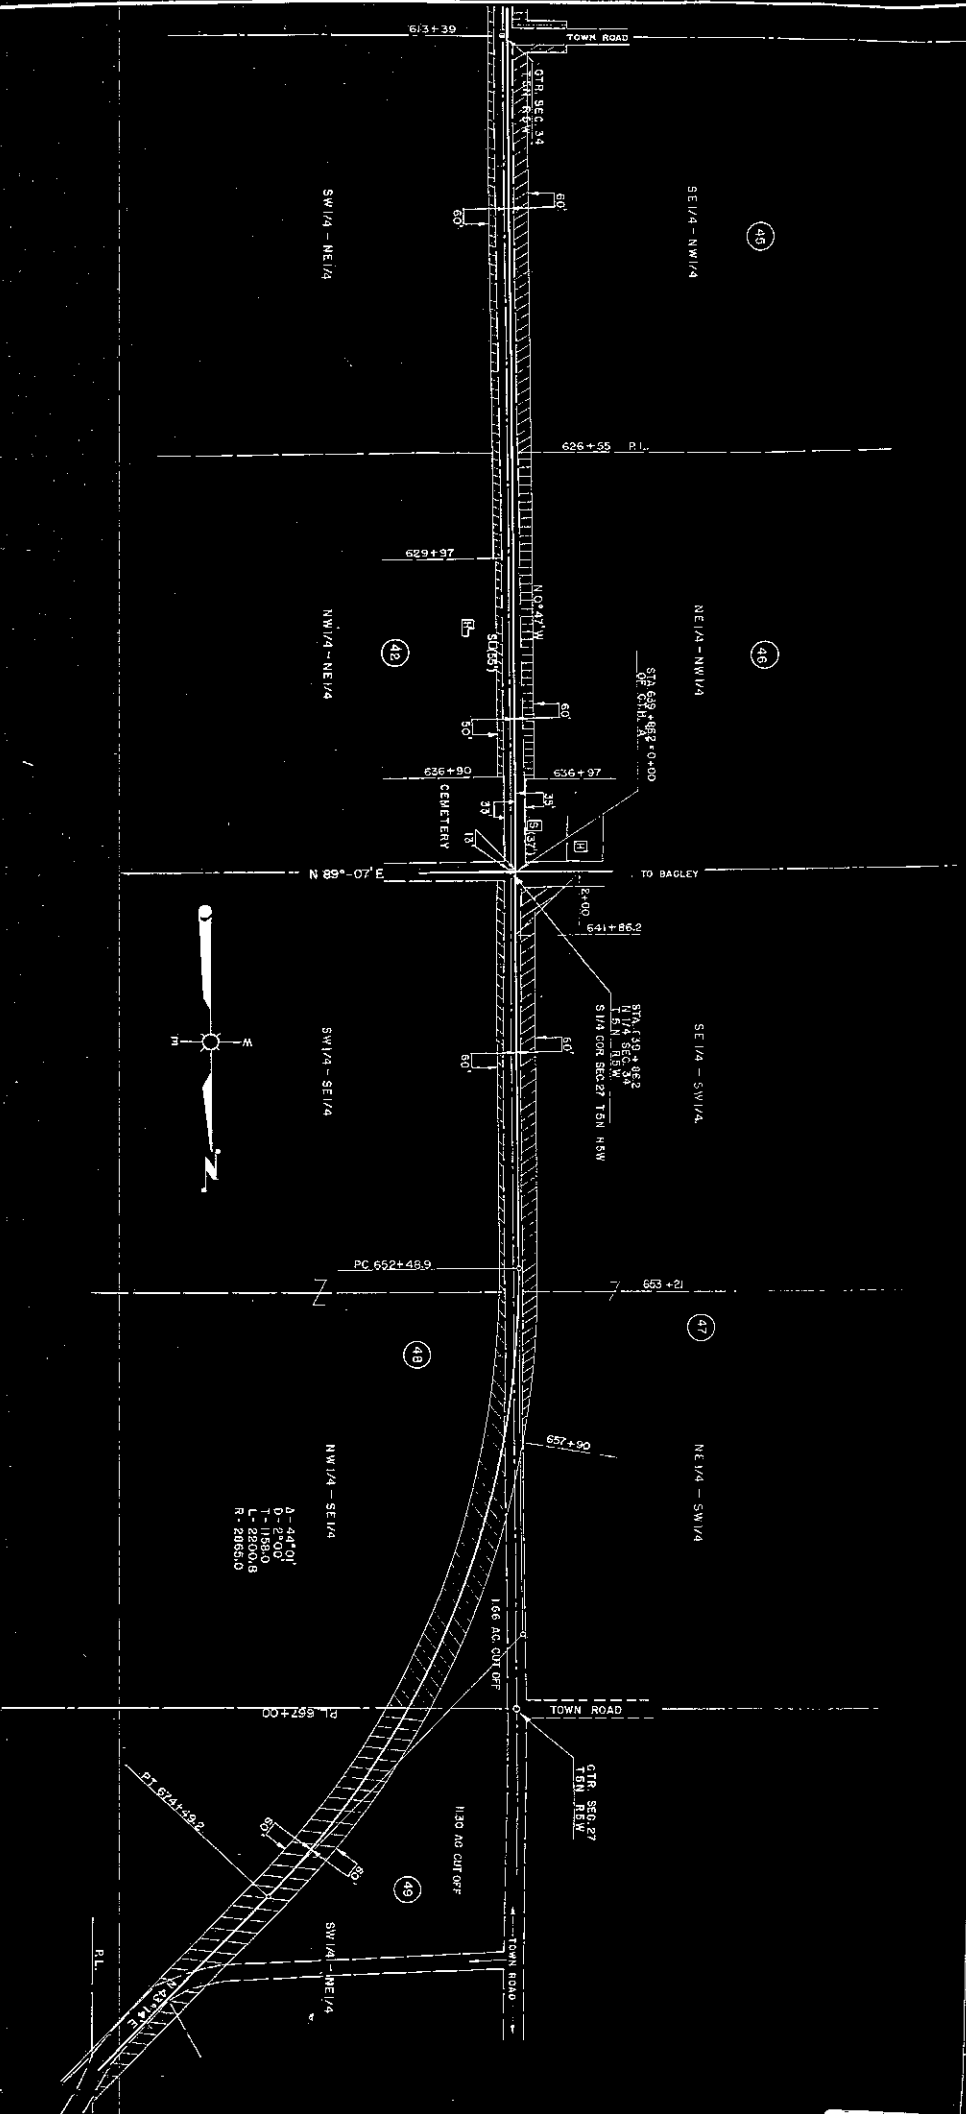

STATE HIGHWAY COMMISSION OF WISCONSIN
 PLAT OF RIGHT OF WAY REQUIRED
 PROJECT 810200(1)
 GASSVILLE — BLOOMINGTON ROAD
 S.T.H. 133 GRANT COUNTY
 SCALE 1" = 100' 1" = 100'
 DATED MARCH 1, 1951
 LENGTH 13.786 MILES

COUNTY	ROUTE	CLASS AND AGREEMENT	REMARKS	SHEET	TOTAL
HIGHWAY	SECTION	STATE	FEDERAL	WIS.	4.9
				5N	358

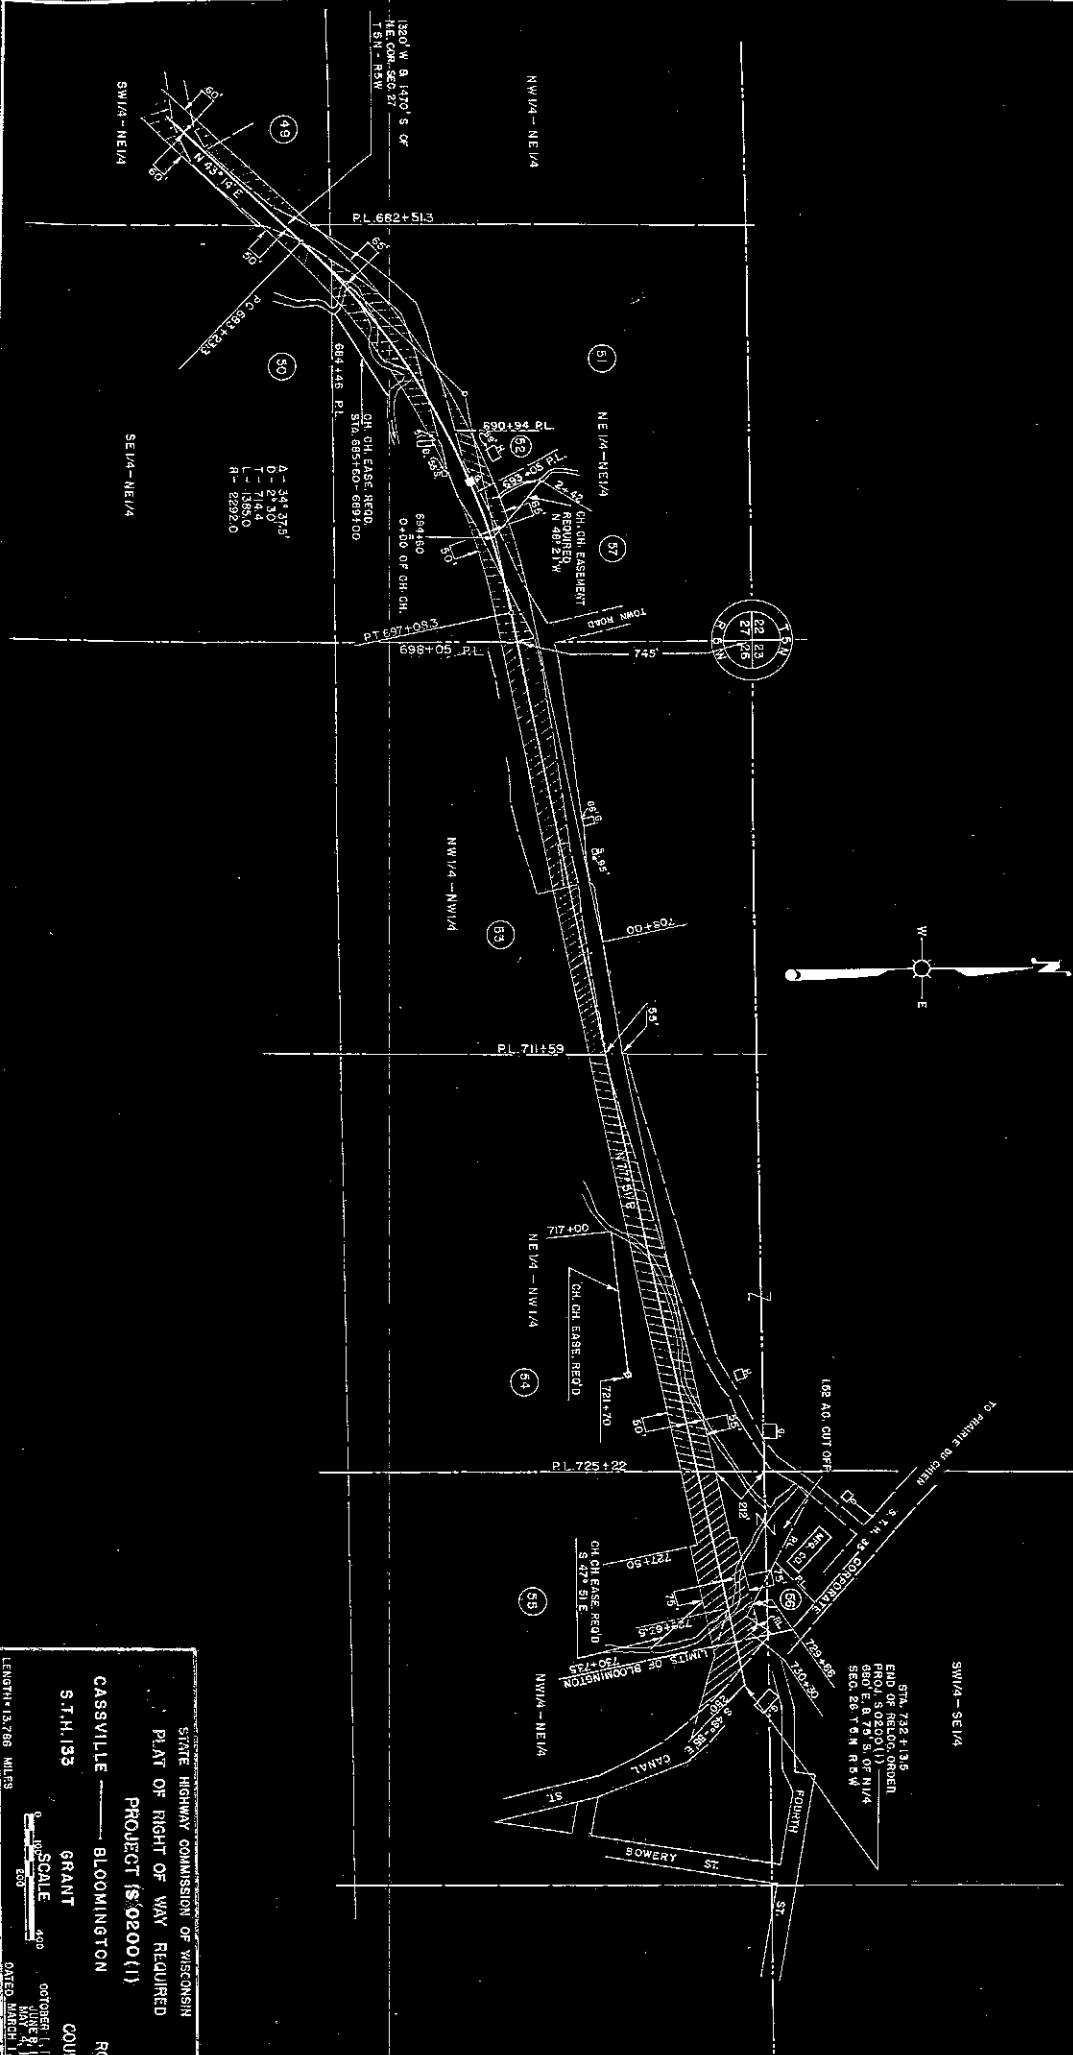

STATE HIGHWAY COMMISSION OF WISCONSIN
 PLAT OF RIGHT OF WAY REQUIRED
 PROJECT (S. 0200(1))
 CASSVILLE - BLOOMINGTON ROAD
 S.T.H. 133
 GRANT
 COUNTY
 SCALE 1" = 400'
 DATE: MARCH 1, 1951