



The State of Wisconsin

HIGHWAY COMMISSION

STATE OFFICE BUILDING

MADISON 2

February 17, 1950

Mr. Eugene Croft
Grant County Highway Commissioner
Lancaster, Wisconsin

Mr. Alonzo Aupperle
County Clerk, Grant County
Lancaster, Wisconsin

Gentlemen:

SUBJECT: Project T 0204(1)
British Hollow-Potosi Road
S.T.H. 133
Grant County

The Highway Commission deems it necessary to make certain revisions on a previously approved right-of-way plat and to acquire certain lands and interests in lands according to such revisions, for the proper improvement or maintenance of the above-designated project and highway. The revised relocation order of the Commission and the map showing the highway as laid out and established and the lands and interests to be acquired are transmitted herewith.

The enclosed relocation order provides that the county highway committee shall make the necessary acquisitions of lands and interests not previously acquired, pursuant to Section 84.09(3), Wisconsin Statutes.

Very truly yours

STATE HIGHWAY COMMISSION OF WISCONSIN

William P. Ward

William P. Ward
Secretary

WPW:MO
CC:DE#9
WBB
Enc.

FILED

FEB 18 1950
ALONZO AUPPERLE
COUNTY CLERK
GRANT COUNTY, WIS.

RELOCATION ORDER
BY STATE HIGHWAY COMMISSION OF WISCONSIN

* * * * *

THE STATE HIGHWAY COMMISSION FINDS AND DETERMINES THAT:

The proper establishing, laying out, widening, enlarging, extending, constructing, reconstructing, improving, or maintaining a portion of the highway now designated as State Trunk Highway 133, from a point 360 feet south and 530 feet east of the north one-quarter corner of Section 9, Township 2 North, Range 3 West, thence northerly through the Village of Potosi to a point 40 feet south and 530 feet west of the north one-quarter corner of Section 35, Township 3 North, Range 3 West,

and on roads or lands in and about and along and leading to same, require certain relocation or change and the acquisition of lands or interests in lands as shown on the map or copy thereof marked

"PLAT OF RIGHT OF WAY REQUIRED, PROJECT No. T 0204(1),"

for the British Hollow-Potosi Road,

S.T. H. 133, Grant County, dated February 3, 1950,

the same being sheet No. 4, 4.1, 4.2, 4.3, and 4.4 of the plans for said project, and

Pursuant to its authority under Sections 84.02 (3) and 84.09, Wisconsin Statutes,

THE STATE HIGHWAY COMMISSION HEREBY ORDERS THAT:

(1) The said highway is hereby laid out and established to the lines and widths as shown on the said plat.

(2) The required lands or interests in lands as shown on the plat shall be acquired by the County Highway Committee of the county in which the lands are situate, pursuant to the provisions of Section 84.09 (3), Wisconsin Statutes.

However, said County Highway Committee shall have no authority to settle or compromise any action or proceeding which might arise because of acts done by it in complying with this order, without prior written approval by the State Highway Commission.

(3) Buildings, fixtures or chattels acquired incident to the acquisition of lands or rights in lands under this order, and to be removed, shall, subject to approval of the Highway Commission, be sold by the County Highway Committee at public or private sale to the highest bidder, and the net proceeds of such sale paid into the state highway fund.

(4) This order supersedes and amends the previous order issued by the Commission on April 13, 1949.

* * * * *

The foregoing order was issued by the State Highway Commission and entered in the minutes of its meeting on February 17, 1950.

William P. Hard

Secretary, State Highway Commission of Wisconsin



SCHEDULE OF LANDS AND INTERESTS REQUIRED

PAR. NO.	OWNER	INTERESTS REQUIRED	ACRES
1	POTOSI BREWING CO.	LIMITED EASEMENT	
2	W.N. MAHNS	"	
3	POTOSI BREWING CO.	EASEMENT	0.08
4	ST. THOMAS CATHOLIC CH.	FEE TITLE	0.02
5	VILLAGE OF POTOSI	"	0.04
6	ARNO KEENER	"	0.10
7	ALBERT SCHAEFER ET AL.	LIMITED EASEMENT	
8	FRED MILKE	"	
9	FRED MILKE	"	
10	CHARL. LEISERD	"	
11	TONY MEYERS	"	
12	TONY HURST	"	
13	LEO WINKER	"	
14	W.N. STORER	"	
15	ANDREW BODE	"	
16	FRED MILKE	HIGHWAY EASEMENT	0.03
17	JACOB AMES	"	0.17
18	WALLACE MACKIE	"	0.10
19	ALBERT SCHAEFER ET AL.	"	0.04
20	JOHN DUVE EST.	"	0.26
21	GEORGE PENNICKAMP	"	0.06
22	HERMAN UDELOVEN	"	0.21
23	AUG. MILKE	"	0.63
24	RAY GILLEN	FEE TITLE	0.91
25	HENRY DIETZEL	"	2.57
26	HILMUT FRITZ	"	0.47
27	TIRZA ENROS ET AL.	"	1.21
28	GEO. SCHUMACHER EST.	LIMITED EASEMENT	
29	GEORGE MARTIN	"	
30	MASONIC TEMPLE	"	
31	ELIZABETH TURNER EST.	FEE TITLE	0.53
32	FRANCIS DURN	"	0.04
33	CONCEALING DOBER	LIMITED EASEMENT	
34	ANDREW BODE	"	
35	POTOSI BREWING CO.	FEE TITLE	0.76
36	JOHN KRESS	LIMITED EASEMENT	
37	ALBERT PATZNER	"	
38	LOIS WEIDMAN	FEE TITLE	0.46
39	HELEN SCHUMACHER	LIMITED EASEMENT	
40	ROSE MCKEE	FEE TITLE	0.20

SCHEDULE OF CURVE DATA

NO.	A	DEG.	TANG.	LENG.	RAD.	P. I.	P. C.	P. T. O.	P. T. L.
C-1	23°27'	34°30'	324.3	674.8	1637.1	4°49'58"	10498.5	7179.3	7185.1
C-2	10°28'	31°00'	180.0	359.3	1910.0	14°03'3"	9129.3	25493.3	25493.2
C-3	1°26'	0°15'	293.3	886.6	22988.3	22°06'7"	41744.7	41792.4	41792.4
C-4	23°26'	40°00'	316	736	143.28	41°11'1"	49498.7	49498.2	49498.2
C-5	12°41'	8°00'	130.1	258.6	955.0	58°46'5"	58495.1	58495.1	58495.1
C-6	15°31'	8°00'	130.1	258.6	955.0	01°01'	24926	24926	24926
C-7	20°45'	10°00'	104.9	207.6	573.0	2°30'5"	6406.0	6406.0	6406.0
C-8	60°30'	16°00'	169.3	310.8	581.1	2°30'5"	6406.0	6406.0	6406.0



COUNTY	TOWN	SECTION	STATE	FEDERAL	WIS.	SHEET	TOTAL
BRITISH HOLLOW	POTOSI	41	SE	NE	SW	4	65

STATE HIGHWAY COMMISSION OF WISCONSIN
PLAT OF RIGHT OF WAY REQUIRED
PROJECT NO. T 0204(11)

BRITISH HOLLOW — POTOSI
S.T.H. NO. 133
GRANT

CO. 100
SHEET 4
DATE: APRIL 15, 1933

SCALE

A horizontal scale bar with a black and white alternating pattern. It has markings at 0, 50, 100, and 200 feet. The text "SCALE" is written vertically above the bar.

STATE HIGHWAY COMMISSION OF WISCONSIN
PLAT OF RIGHT OF WAY REQUIRED
PROJECT NO. T 0204(1)
BRITISH HOLLOW — POTOSI
S.T. H. NO. 133 GRANT

BRITISH HOLLOW — POTOSI ROAD

S.T.H. NO. 133

GRANT COUNTY

SCALE 100'

LENGTH 2,980 MILES

PERF. 3,1850
APR. 28, 1943
MILE 2980
DATE APR. 28, 1948

COUNTY	ROUTE AND SECTION	CLASS AND NUMBER	REMARKS	SHEET NUMBER	TOTAL SHEETS
BRITISH HOLLOW	35	35		43	65

STATION 188+02.5
END OF RELOCATION ORDER
PROJECT NO. T 0204(1)
40 SOUTH N.330 WEST OF
N/4 COR. SEC. 35 T.34N.R.3W

SCHEDULE OF CURVE DATA

NO.	A	DEG.	TANG.	LENG.	RAO.	P. I.	P. O.	A. T. C.	P. T. T.
C-6	19+31	61°00'	130.1	258.6	335.0	87+63.8	93+86.5	58+45.1	99+46.1
C-7	22+02	110°0'	101.7	203.3	573.0	87+63.8	93+86.5	58+45.1	99+46.1
C-8	18+41	84°00'	98.6	196.0	716.3	87+63.8	93+86.5	58+45.1	99+46.1
C-9	19+02	102°00'	98.0	190.3	573.0	87+63.8	93+86.5	58+45.1	99+46.1
C-10	48+43	78°50'	34.1	64.0	74.93	87+63.8	93+86.5	58+45.1	99+46.1
C-11	18+59	181°00'	45.6	92.5	316.3	87+63.8	93+86.5	58+45.1	99+46.1
C-12	13+19	54°00'	115.7	230.3	553.0	87+63.8	93+86.5	58+45.1	99+46.1
C-13	20+38	158°00'	68.2	130.8	358.1	87+63.8	93+86.5	58+45.1	99+46.1
C-14	17+47	51°00'	179.3	355.7	1146.0	87+63.8	93+86.5	58+45.1	99+46.1
C-15	24+91	24°00'	71.3	142.5	2835.0	87+63.8	93+86.5	58+45.1	99+46.1




STATE HIGHWAY COMMISSION OF WISCONSIN
PLAT OF RIGHT OF WAY REQUIRED
PROJECT NO. T 0204(1)
BRITISH HOLLOW — POTOMI
S.T.H. NO. 133
GRANT
COUNTY
ROAD
LENGTH 4.580 MILES
SCALE 1"=400'
DATED 12/1/1933

A - 154.4'
D - 87.00'
T - 93.6'
L - 196.0'
R - 716.3'

SUBDIVISION OF
SEC. 34, T3N, R3W
VILLAGE OF POTOSI

EXHIBIT - 3

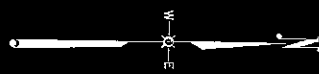

COUNTY	ROUTE	CLASS AND AGREEMENT	FEDERAL	SHEET	TOTAL
WIS.	44	65			

STATE HIGHWAY COMMISSION OF WISCONSIN
 PLAT OF RIGHT OF WAY REQUIRED
 PROJECT NO. T0204(1)
 BRITISH HOLLOW — POTOSI
 S.H. NO. 133
 GRANT
 ROAD
 COUNTY
 FEB. 3, 1940
 FEB. 26, 1941
 LENGTH 2.30 MILES
 SCALE 1" = 100'
 DATED FEB. 26, 1941

