



State Highway Commission of Wisconsin

STATE OFFICE BUILDING
1 WEST WILSON STREET
MADISON, WISCONSIN

MAIN OFFICE

June 27, 1963

Mr. Edward J. Nickson, Commissioner
Grant County Highway Department
Box 150
Lancaster, Wisconsin

✓ Miss Mildred Krohn
Grant County Acting Clerk
Courthouse
Lancaster, Wisconsin

Dear Sir and Madam:


SUBJECT: Project T 0204(2)
Cassville-Potosi Road
S.T.H. 133
Grant County

The Highway Commission deems it necessary to make certain revisions on a previously approved right of way plat and to acquire certain lands and interests in lands according to such revisions, for the proper improvement or maintenance of the above-designated project and highway. The revised relocation order of the Commission and the map showing the highway as laid out and established and the lands and interests to be acquired are transmitted herewith.

The enclosed relocation order provides that the State Highway Commission shall make the necessary acquisitions of lands and interests not previously acquired, pursuant to Section 84.09(1) or (2), Wisconsin Statutes.

Very truly yours

STATE HIGHWAY COMMISSION OF WISCONSIN

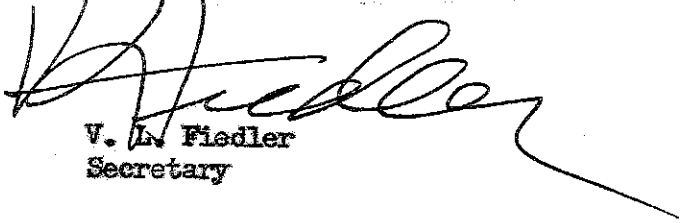
V. L. Fiedler
Secretary

VLF:AK
CC:DE/l
RVL
Enc.

RELOCATION ORDER

BY STATE HIGHWAY COMMISSION OF WISCONSIN

* * * * *

THE STATE HIGHWAY COMMISSION FINDS AND DETERMINES THAT:

The proper establishing, laying out, widening, enlarging, extending, constructing, reconstructing, improving, or maintaining a portion of the highway now designated as State Trunk Highway 133, from a point 955 feet north and 2280 feet west of the southeast corner of Section 5, Township 2 North, Range 3 West, and extending northwesterly to a point 715 feet west and 905 feet south of the northeast corner of Section 6, Township 2 North, Range 3 West,

and on roads or lands in and about and along and leading to same, requires certain relocation or change and the acquisition of lands or interests in lands as shown on the map or copy thereof marked

"PLAT OF RIGHT OF WAY REQUIRED, PROJECT T 0204(2),"

for the Cassville-Potosi Road,

S.T. H. 133, Grant County, dated June 21, 1963,

the same being sheets No. 4 and 4.1 of the plans for said project, and

Pursuant to its authority under Sections 84.02 (3) and 84.09, Wisconsin Statutes,

THE STATE HIGHWAY COMMISSION HEREBY ORDERS THAT:

(1) The said highway is hereby laid out and established to the lines and widths as shown on the said plat.


(2) The required lands or interests in lands as shown on the plat shall be acquired by the County Highway Committee of the county in which the lands are situated, pursuant to the provisions of Section 84.09 (3) Wisconsin Statutes. However, said County Highway Committee shall have no authority to settle or compromise any action or proceeding which might arise because of facts done by it in complying with this order without prior written approval by the State Highway Commission in the name of the State of Wisconsin by the Highway Commission pursuant to the provisions of Section 84.09(1) or (2), Wisconsin Statutes.

(3) Buildings, fixtures or chattels acquired incident to the acquisition of lands or rights in lands under this order, and to be removed, shall ~~be subject to approval of the Highway Commission~~ be sold by the County State Highway ~~Commission~~ at public or private sale to the highest bidder, and the net proceeds of such sale paid into the state highway fund.


(4) This order supersedes and amends the previous order issued by the Commission on May 29, 1963.

* * * * *

The foregoing order was issued by the State Highway Commission and entered in the minutes of its meeting on June 27, 1963.

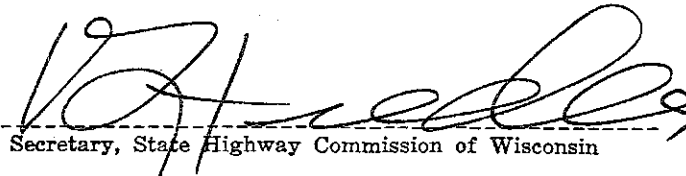

Secretary, State Highway Commission of Wisconsin

END RELOCATION ORDER
PROJ. T 0204(2) STA. 126+00
715' WEST AND 905' SOUTH OF THE
N.E. COR. SEC. 8, T2N, R3W,

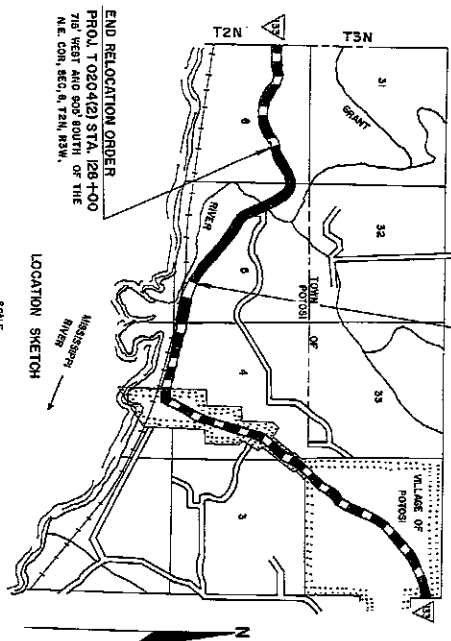


SCHEDULE OF LANDS AND INTERESTS REQUIRED					
PARCEL NO.	SHEET NO.	OWNER	INTEREST'S REQUIRED	ACRES	
1				-	
2	41	WALTER J. TAYLOR	FEDERAL GOVERNMENT	-	
3					
4	41	JOSEPH L. CANNACK JR.	AFFIRMED EVIDENCE	-	

STANDARD ABBREVIATIONS	
N	HOUSE
U	BARB
9	SIED
R.L.	PROPERITY LINE
CON	CONNER
PROJ	PROJECT
STA	STATION
PERM	PERMANENT
SEC	SECTION
ABAND	ABANDONED
9CH	SCHOOL

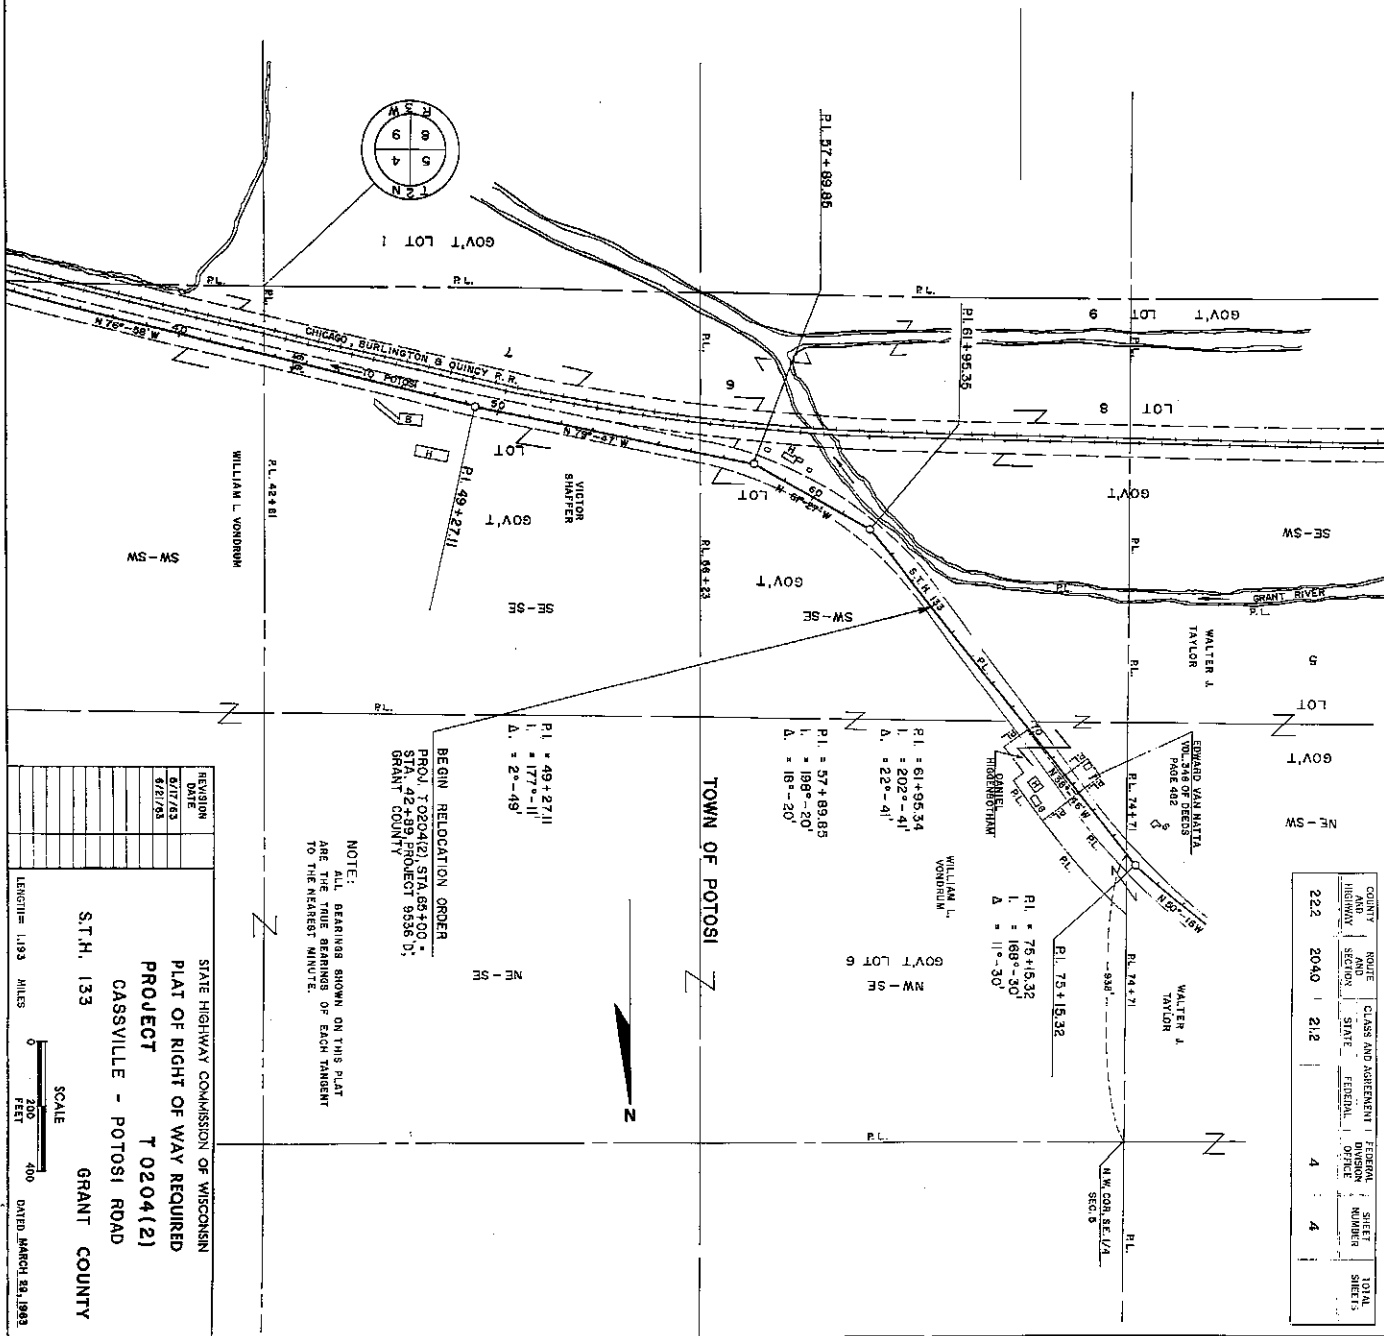

COUNTY	ROUTE	CLASS AND NUMBER	FEDERAL	SHEET	TOTAL
ADAMS	22.2	2040	21.2	4	41
DIVISION	SECTION	STATE	FEDERAL	OFFICE	NUMBER
22.2	2040	21.2	4	41	

END RELOCATION ORDER
PROJ. T0204(2), STA. 123+00

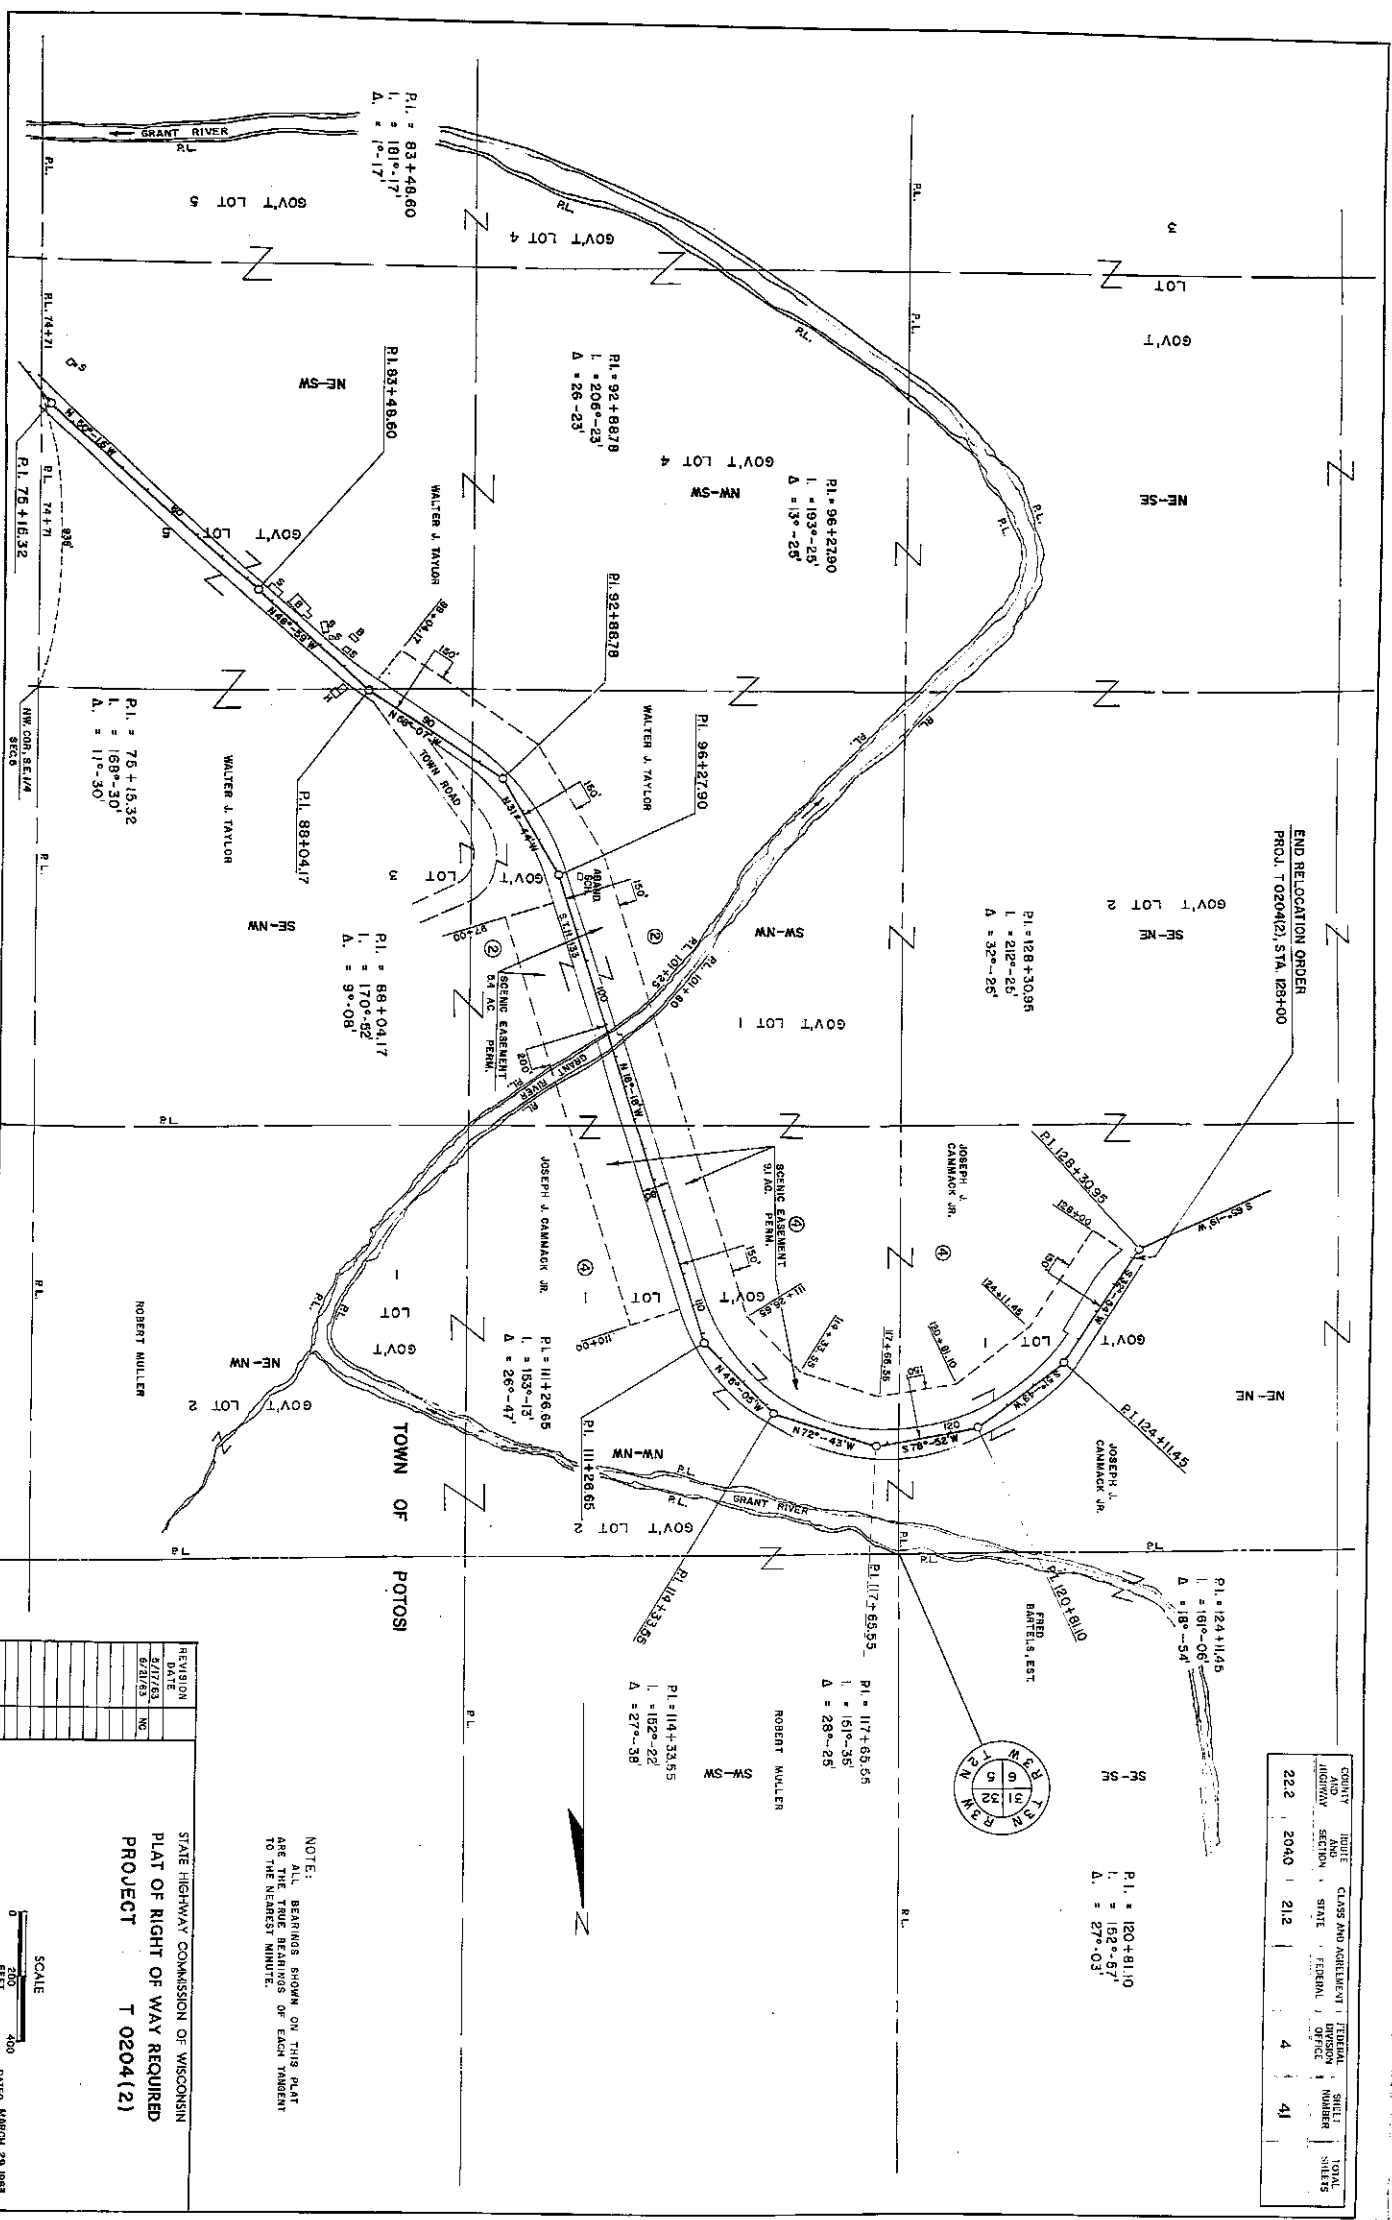

NOTE:
ALL BEARINGS SHOWN ON THIS PLAT
ARE TRUE BEARINGS OF EACH PARCEL
TO THE NEAREST MINUTE.

STATE HIGHWAY COMMISSION OF WISCONSIN
PLAT OF RIGHT OF WAY REQUIRED
PROJECT T 0204(2)

REVISION	DATE	BY
1	5/17/53	NO
2	6/21/53	NO
3	6/21/53	NO
4	6/21/53	NO
5	6/21/53	NO
6	6/21/53	NO
7	6/21/53	NO
8	6/21/53	NO
9	6/21/53	NO
10	6/21/53	NO

SCALE
0 200 400
FEET
DATE: MARCH 29, 1953