



State Highway Commission of Wisconsin

STATE OFFICE BUILDING
1 WEST WILSON STREET
MADISON, WISCONSIN

MAIN OFFICE

May 31, 1963

Mr. Edward J. Nickson, Commissioner
Grant County Highway Department
Box 150
Lancaster, Wisconsin

✓ Miss Mildred Krohn
Acting Grant County Clerk
Courthouse
Lancaster, Wisconsin

Dear Sir and Madam:

SUBJECT: Project T 0204(2)
Cassville-Potosi Road
S.T.H. 133
Grant County

The Highway Commission deems it necessary to make certain revisions on a previously approved right of way plat and to acquire certain lands and interests in lands according to such revisions, for the proper improvement or maintenance of the above-designated project and highway. The revised relocation order of the Commission and the map showing the highway as laid out and established and the lands and interests to be acquired are transmitted herewith.

The enclosed relocation order provides that the State Highway Commission shall make the necessary acquisitions of lands and interests not previously acquired, pursuant to Section 84.09(1) or (2), Wisconsin Statutes.

Very truly yours

STATE HIGHWAY COMMISSION OF WISCONSIN


V. L. Fiedler
Secretary

VLF:SIS
CC:DE#1
RVL
Enc.

RELOCATION ORDER
BY STATE HIGHWAY COMMISSION OF WISCONSIN

* * * * *

THE STATE HIGHWAY COMMISSION FINDS AND DETERMINES THAT:

The proper establishing, laying out, widening, enlarging, extending, constructing, reconstructing, improving, or maintaining a portion of the highway now designated as State Trunk Highway 133, from a point 955 feet north and 2280 feet west of the southeast corner of Section 5, Township 2 North, Range 3 West, and extending northwesterly to a point 715 feet west and 905 feet south of the northeast corner of Section 6, Township 2 North, Range 3 West,

and on roads or lands in and about and along and leading to same, requires certain relocation or change and the acquisition of lands or interests in lands as shown on the map or copy thereof marked

"PLAT OF RIGHT OF WAY REQUIRED, PROJECT T 0204(2),"

for the Cassville-Potosi Road,

S.T. H. 133, Grant County, dated May 17, 1963,

the same being sheet S No. 4 and 4.1 of the plans for said project, and

Pursuant to its authority under Sections 84.02 (3) and 84.09, Wisconsin Statutes,

THE STATE HIGHWAY COMMISSION HEREBY ORDERS THAT:

(1) The said highway is hereby laid out and established to the lines and widths as shown on the said plat.


(2) The required lands or interests in lands as shown on the plat shall be acquired ~~by the County Highway Committee of the county in which the lands are situated pursuant to the provisions of Section 84.09 (2) Wisconsin Statutes. However, said County Highway Committee shall have no authority to settle or compromise any controversy or proceeding which might arise because of acts done by it in complying with this order without prior written approval by the State Highway Commission~~ **in the name of the State of Wisconsin by the Highway Commission pursuant to the provisions of Section 84.09(1) or (2), Wisconsin Statutes.**

(3) Buildings, fixtures or chattels acquired incident to the acquisition of lands or rights in lands under this order, and to be removed, shall ~~be subject to removal of the Highway Commission~~ **be sold by the County Highway Commission** at public or private sale to the highest bidder, and the net proceeds of such sale paid into the state highway fund.


(4) This order supersedes and amends the previous order issued by the Commission on April 17, 1963.

* * * * *

The foregoing order was issued by the State Highway Commission and entered in the minutes of its meeting on May 29, 1963.

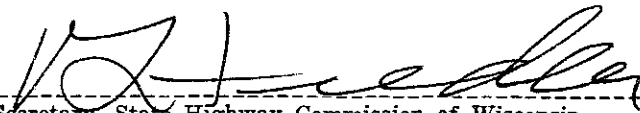

 Secretary, State Highway Commission of Wisconsin

END RELOCATION ORDER
PROJ. T 0204(2) STA. 128+00
715' WEST AND 903' SOUTH OF THE
N.E. COR., SEC. 8, T2N, R3W,

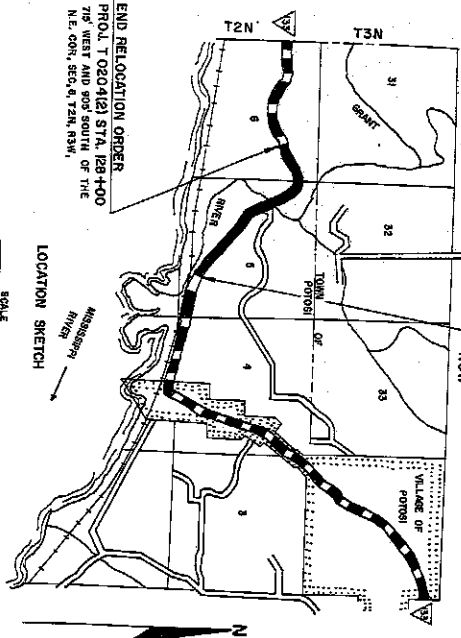[illegible]



STANDARD ABBREVIATIONS

H •	HOUSE
B •	BARN
\$ •	SHED
R.L. •	PROPERTY LINE
CON •	CONCRETE
PROJ •	PROJECT
STA •	STATION
PERM •	PERMANENT
SEC •	SECTION
ABAND •	ABANDONED
SCH •	SCHOOL

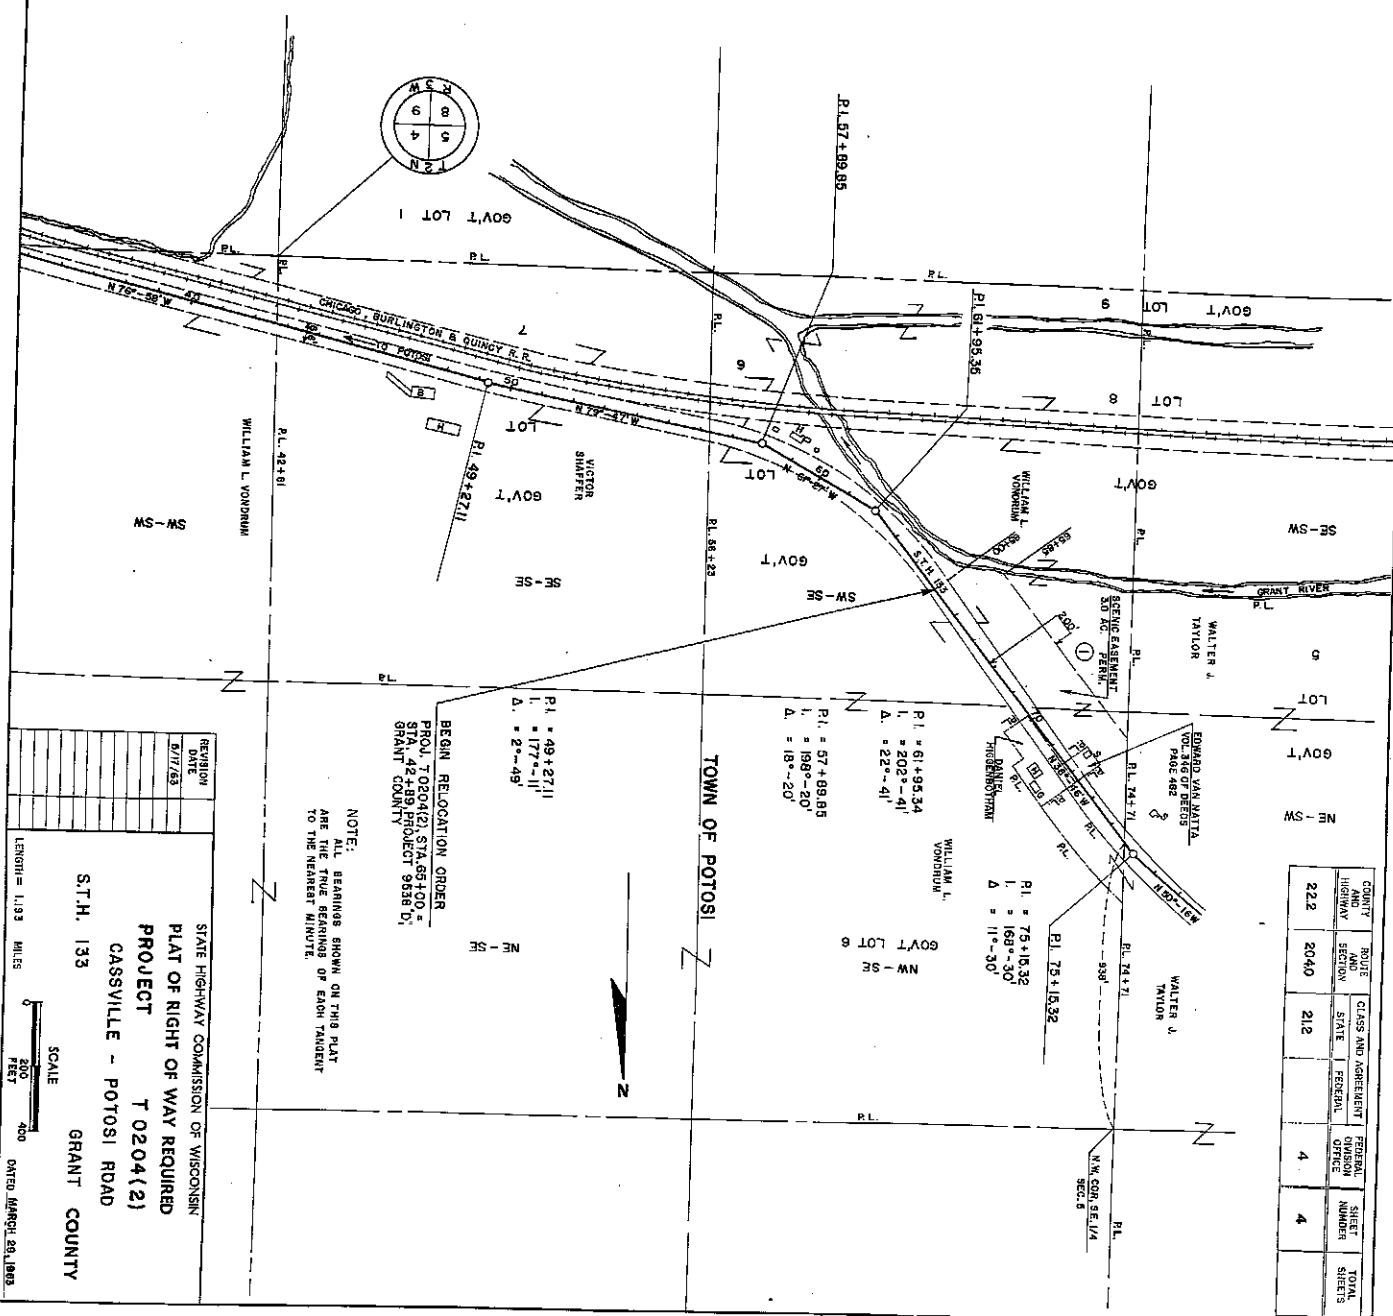


COUNTY AND HIGHWAY	ROUTE	CLASS AND NUMBER	FEDERAL DIVISION	SHEET NUMBER	TOTAL SHEETS
22.2	2040	212	4	41	

END RELOCATION ORDER
PROJ. T0204(2), STA. 128+00

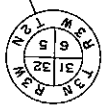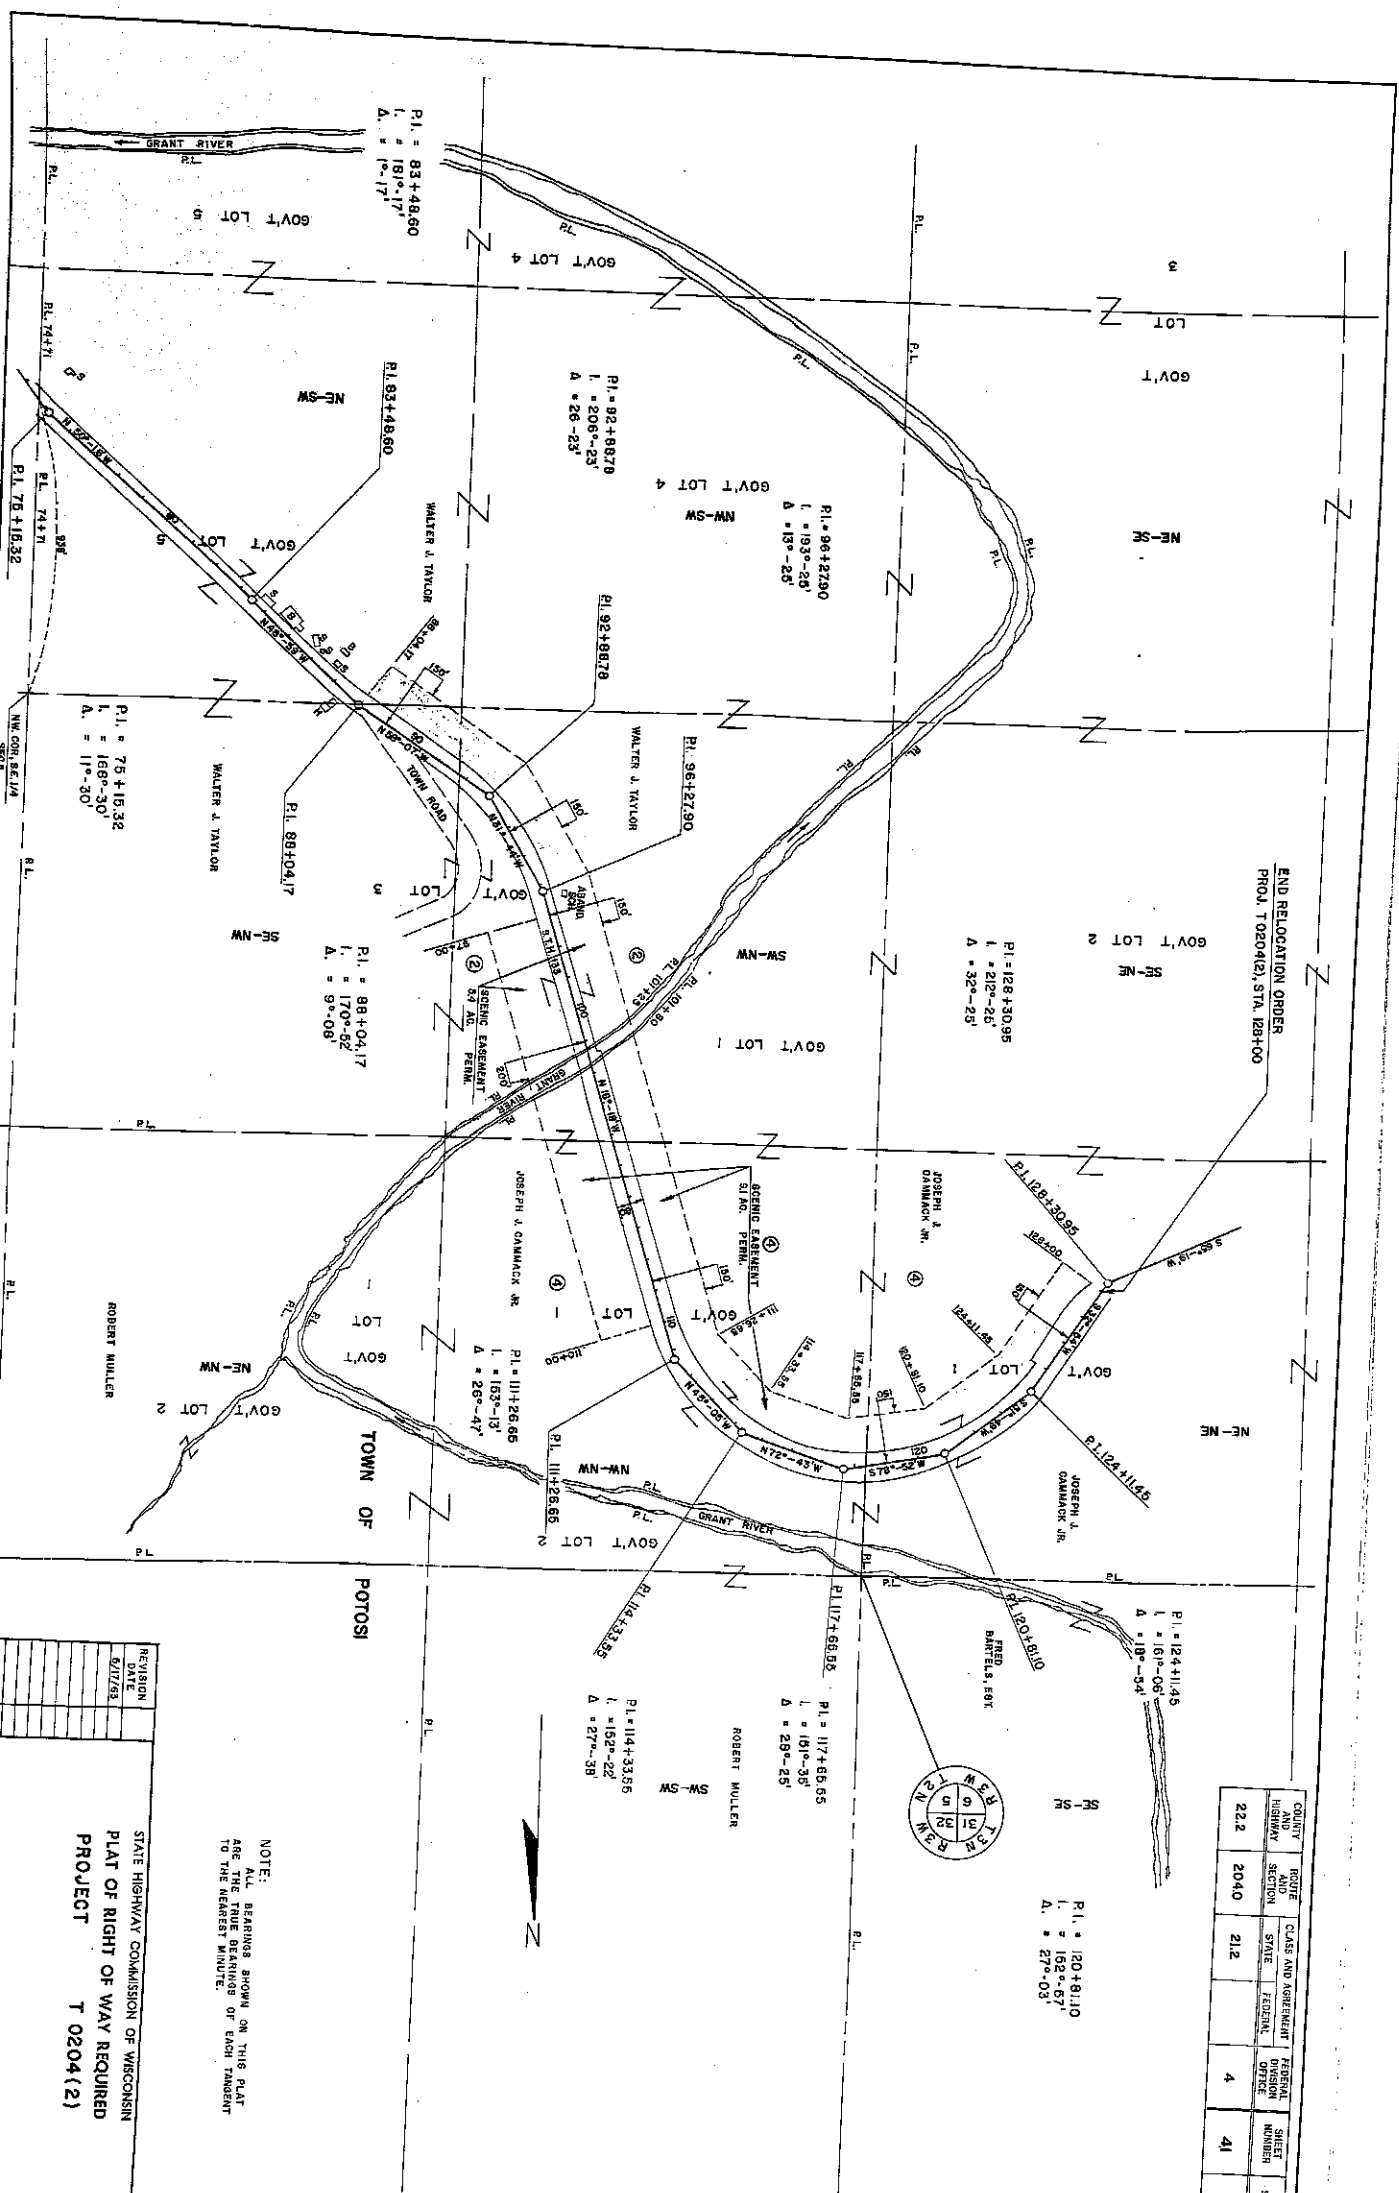

NOTE:
ALL BEARINGS SHOWN ON THIS PLAT
ARE THE TRUE BEARINGS OF EACH TANGENT
TO THE NEAREST MINUTE.

STATE HIGHWAY COMMISSION OF WISCONSIN
PLAT OF RIGHT OF WAY REQUIRED
PROJECT T 0204(2)

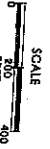

DATED MARCH 29, 1965