



State Highway Commission of Wisconsin

STATE OFFICE BUILDING
1 WEST WILSON STREET
MADISON, WISCONSIN 53702

CENTRAL OFFICE

August 26, 1964

Mr. Edward J. Nickson, Commissioner
Grant County Highway Department
Box 150
Lancaster, Wisconsin 53813

Miss Mildred Krohn
Grant County Clerk
Courthouse, Box 191
Lancaster, Wisconsin 53813

Dear Sir and Madam:

SUBJECT: Project T 017-1(17)
Aux. 8.1
Fennimore-Mount Ida Road
U.S.H. 18
Grant County

The Highway Commission deems it necessary to make certain revisions on a previously approved right of way plat and to acquire certain lands and interests in lands according to such revisions, for the proper improvement or maintenance of the above-designated project and highway. The revised relocation order of the Commission and the map showing the highway as laid out and established and the lands and interests to be acquired are transmitted herewith.

The enclosed relocation order provides that the State Highway Commission shall make the necessary acquisitions of lands and interests not previously acquired, pursuant to Section 84.09(1) or (2), Wisconsin Statutes.

Very truly yours

STATE HIGHWAY COMMISSION OF WISCONSIN

V. L. Fiedler
Secretary

VLf:AK
CC: DE#1
RVL
Enc.

RELOCATION ORDER
BY STATE HIGHWAY COMMISSION OF WISCONSIN

* * * * *

THE STATE HIGHWAY COMMISSION FINDS AND DETERMINES THAT:

The proper establishing, laying out, widening, enlarging, extending, constructing, reconstructing, improving, or maintaining a portion of the highway now designated as U. S. Highway 18, from a point **253 feet north of the south one-quarter corner of Section 15, Township 6 North, Range 3 West,** and extending thence northeasterly to a point **770 feet east and 405 feet north of the south one-quarter corner of Section 15, Township 6 North, Range 3 West,**

and on roads or lands in and about and along and leading to same, requires certain relocation or change and the acquisition of lands or interests in lands as shown on the map or copy thereof marked

"PLAT OF RIGHT OF WAY REQUIRED, PROJECT T 017-1(17), Aux. 8.1,"

for the Fennimore-Mount Ida Road,

U.S.H. 18, Grant County, dated August 20, 1964,

the same being sheet No. 4 of the plans for said project, and

Pursuant to its authority under Sections 84.02 (3) and 84.09, Wisconsin Statutes,

THE STATE HIGHWAY COMMISSION HEREBY ORDERS THAT:

(1) The said highway is hereby laid out and established to the lines and widths as shown on the said plat.

(2) The required lands or interests in lands as shown on the plat shall ~~be acquired by the County Highway Committee of the county in which the lands are situate pursuant to the provisions of Section 84.09 (2) Wisconsin Statutes. However, said County Highway Committee shall have no authority to settle or compromise any action or proceeding which might arise because of acts done by it in complying with this order without prior written approval by the State Highway Commission.~~ be acquired in the name of the State of Wisconsin by the Highway Commission pursuant to the provisions of Section 84.09(1) or (2), Wisconsin Statutes.

(3) Buildings, fixtures or chattels acquired incident to the acquisition of lands or rights in lands under this order, and to be removed, shall, ~~subject to approval of the Highway Commission,~~ be sold by the ~~County~~ ^{State} Highway ~~Commission~~ at public or private sale to the highest bidder, and the net proceeds of such sale paid into the state highway fund.

(4) This order supersedes and amends the previous order issued by the Commission on ~~June 7, 1963.~~


* * * * *

The foregoing order was issued by the State Highway Commission and entered in the minutes of its meeting on August 25, 1964


 Secretary, State Highway Commission of Wisconsin

COUNTY AND HIGHWAY	ROUTE AND SECTION	CLASS AND AGREEMENT	FEDERAL AGENCY OFFICE	FILE NUMBER	FINAL SHEET
22.1	17.1	2.17	4	4	
CONST. PROJECT					

END RELOCATION ORDER
 PROJECT T 017-1(17) AUX 8.1
 STA. 152+25 =
 STA. 153+00 PROJECT F 017-1(20)
 STA. 153+05 PROJECT F 017-1(23)
 770' EAST AND 400' NORTH OF THE
 SOUTH 1/4 COR. SEC. 15, TEN, R3W.

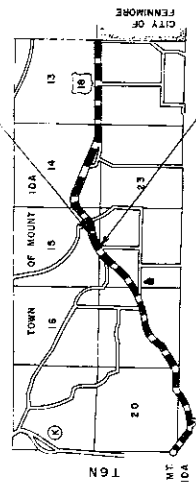

LOCATION SKETCH
 SCALE 0 1 2 MILES

BEGIN RELOCATION ORDER
 PROJECT T 017-1(17) AUX 8.1
 STA. 144+25 PROJECT F 017-1(20)
 STA. 144+30 PROJECT F 017-1(23)
 233' NORTH OF THE SOUTH 1/4 COR.
 SEC. 15, TEN, R3W.

SCHEDULE OF LANDS & INTERESTS REQUIRED			
PARCEL NUMBER	OWNER	INTERESTS REQUIRED	ACRES
1	CECIL HOWELL	RESTRICTED DEVELOPMENT EASEMENT	4.97
2			
3			
4			
5			

STANDARD ABBREVIATIONS
 CONC. - CONCRETE
 FDN. - FOUNDATIONS
 H. - HOUSE
 P.L. - PROPERTY LINE
 S. - SHED
 S.B.P. - SEPTIC BREAKER PIPE

P.I. = 140+31.3
 L. = 226'-20'
 A. = 46'-20'
 D. = 3'-30'
 T. = 700.5'
 L. = 1323.8'
 E. = 143.58'
 R. = 1637.1'

P.I. = 158+70.1
 L. = 158'-26'
 A. = 21'-34'
 D. = 3'-30'
 T. = 3118'
 L. = 616.2'
 E. = 29.43'
 R. = 1637.1'

NOTE:
 DIMENSIONS SHOWN ON THIS PLAN ARE THE TRUE BEARINGS OF EACH TANGENT TO THE NEAREST MINUTE.

TOWN OF MOUNT IDA

STATE HIGHWAY COMMISSION OF WISCONSIN
 PLAT OF RIGHT OF WAY REQUIRED
 PROJECT T 017-1(17) AUX 8.1
 FENNIMORE - MOUNT IDA ROAD
 U.S.H. 16 GRANT COUNTY

REVISION DATE 11/20/84

LENGTH 0.68 MILES

SCALE 0 100 200 FEET

DATED MAY 17, 1985