


Original order called for 33' lanes w/ 10' side narrow lanes 25' + intend to stay inside it.


See Revised Cross Section

No.	OWNER	ADDRESS	ACRES	MORTGAGEE	ADDRESS	AMOUNT PAID			REMARKS
						R/W	FENCE	TOTAL PAID	
1	ED MUNTZ	DUBUQUE, IOWA	1.67						
2	JOHN MERZ	"	0.02				50.00		Lump Sum
3	MRS. LENA VONDRAN	"	3.18				25.00		"
4	CARL VONDRAN	"	0.09			636.00	111.50	747.50	"
5	FRANK SCHOLMEYER	"	1.57	JOHN RICHARDS	KIELER	314.00	72.50	386.50	"

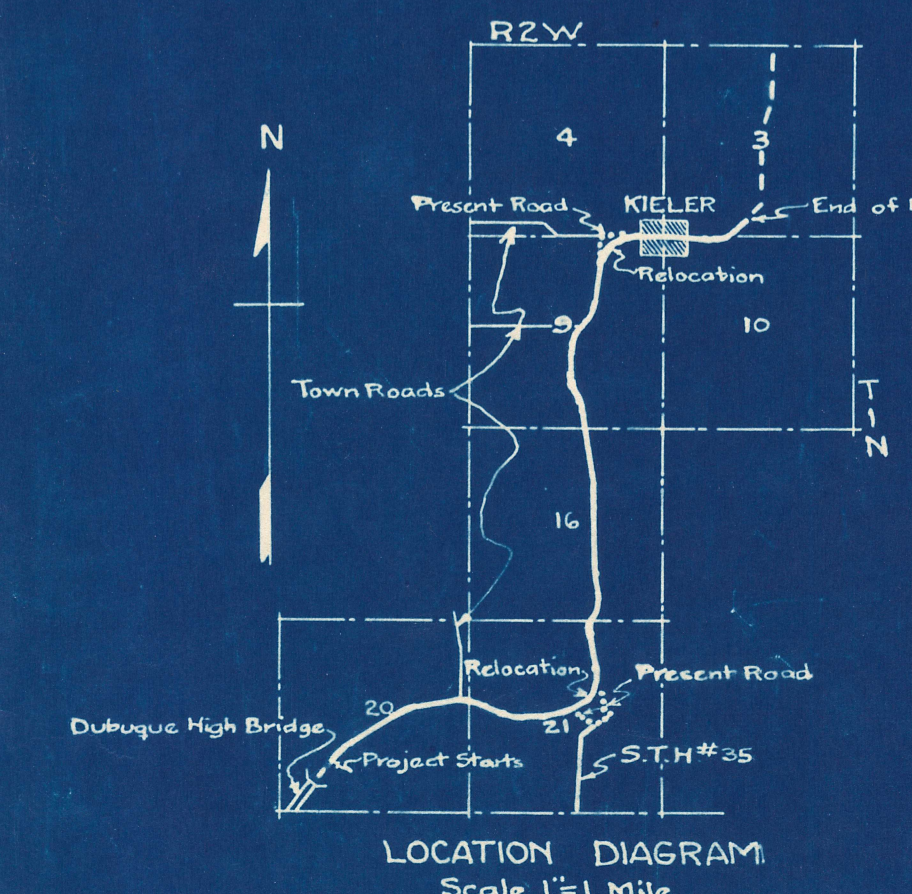

REVISED - 1-16-29
 PLAT OF RIGHT OF WAY REQUIRED
 FEDERAL AID PROJECT NO. 451A
 DUBUQUE-PLATTEVILLE ROAD
 U.S.H. #61 GRANT COUNTY
 SCALE 1"=400'

End Area		Yardage	
Cut	Fill	Cut	Fill
115	0	185	0
85	0		
241	0		
45	3		
	83	85	

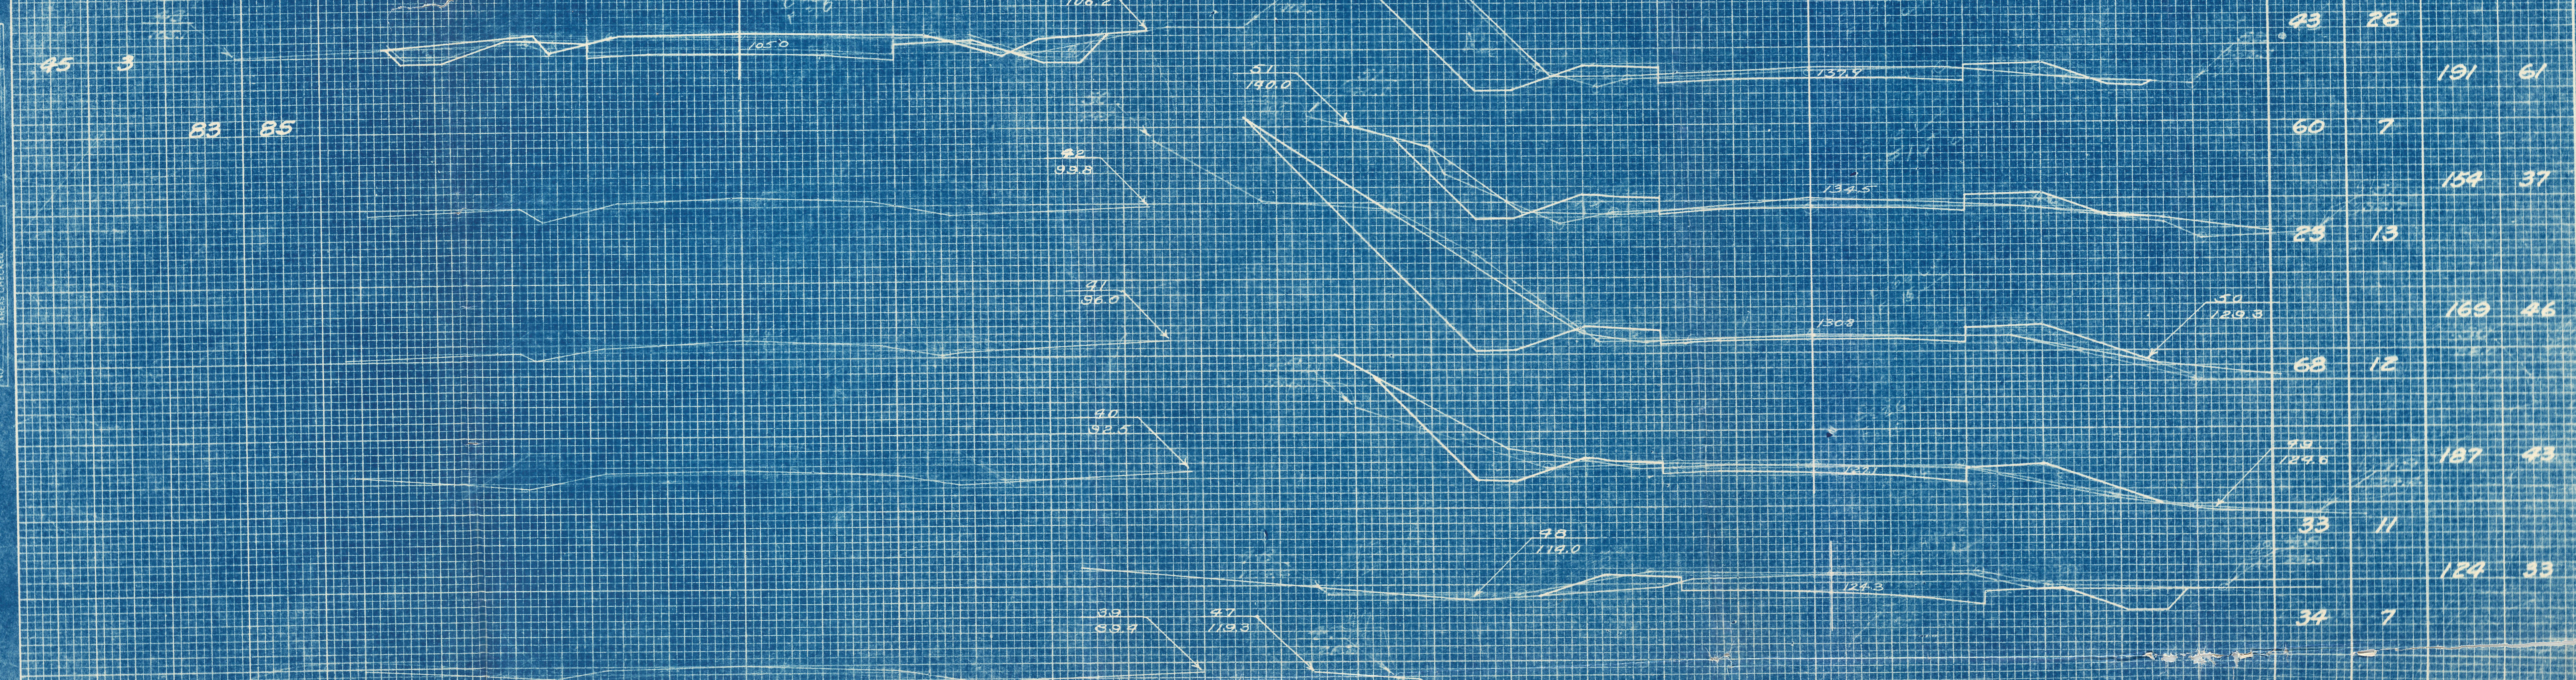

End Area		Yardage	
Cut	Fill	Cut	Fill
7	59		
		33	57
43	26		
		191	61
60	7		
		154	37
25	13		
		169	46
68	12		
		187	43
33	11		
		124	33
34	7		
		315	13
		109	0
		85	57
		39	0
		331	0
		180	0
		398	0
		576	0
		1080	0
		130	0
		226	0
		755	0
		2415	0
Column Total		3536	349
Sheet Total		3980	430

REVISED STA. 43 TO STA. 47

WISCONSIN HIGHWAY COMMISSION MADISON WIS.	U.S. DEPARTMENT OF AGRICULTURE BUREAU OF PUBLIC ROADS
Surveyor: Note Book	RECOMMENDED FOR APPROVAL
Div. Computer: MIO Checker	
Div. Checker: Correct	
COLECT 1/17/29 E. H. Holmes C. F. Borge G. J. Smith 1/22	DISTRICT ENGINEER
RECOMMENDED FOR APPROVAL	CHIEF ENGINEER
W. C. Buefaus DESIGN ENGINEER	APPROVED
APPROVED: DATE Feb. 21 1929	DIRECTOR
W. C. Buefaus STATE HIGHWAY ENGINEER	


FINAL SURVEY PLOTTED FROM NOTE BOOK PAGES 115, 116, 117, 999, 1000

Column Total ~~444~~ 509 87

W. C. BUETOW
STATE HIGHWAY ENGINEER

COMMISSIONERS

- R. C. ERETTING, CHAIRMAN
- ASHLAND
- F. E. TURNHAUER
- MADISON
- D. S. WELCH
- BARABOO
- E. F. BEAN
- MADISON
- P. WALTER PETERSEN
- RACINE

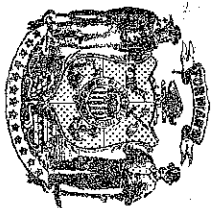

WISCONSIN HIGHWAY COMMISSION

CHAS. A. HALSBERT
STATE CHIEF ENGINEER

STATE CAPITOL ANNEX

MADISON

January 25, 1929.

- C. R. WEYMOUTH
DEPUTY STATE HIGHWAY ENGINEER
- O. C. ROLLMAN
CONSTRUCTION ENGINEER
- J. R. MCLEAN
MAINTENANCE ENGINEER
- C. R. STOKES
MATERIALS ENGINEER
- C. H. KIRCH
BRIDGE ENGINEER
- K. G. KURTENACKER
CHIEF ACCOUNTANT

Mr. J. P. Webb
County Clerk, Grant County
Lancaster, Wisconsin

Mr. A. W. Divali, Chairman
Grant County Highway Committee
Montfort, Wisconsin

Gentlemen:

SUBJECT: Revision of Relocation Order,
Federal Aid Project No. 451-A,
U. S. Highway No. 61,
Dubuque-Platteville Road,
Grant County.
(Revision of Relocation Order
noted in Paragraph 46 of the
Minutes of the Wisconsin High-
way Commission Meeting of April 17,
1928)

It having been deemed necessary for the proper improvement of a state trunk highway to relocate or widen a portion thereof, a plat showing the old and the new locations and a copy of the order of the State Highway Commission are hereby filed with each of you, as required by law.

Very truly yours,

WISCONSIN HIGHWAY COMMISSION,

By *Chas. A. Halsbert*
Secretary.

CRW-EH
CC-DE#9
Henry Mink, Lancaster
K.G.K.

Filed Jan 28 1929
J.P. Webb
Grant Co.

