

Wisconsin Department of Transportation

NOV 11 1988

RECEIVED

NOV 08 1988

DIVISION OF HIGHWAYS AND
TRANSPORTATION SERVICES

4802 Sheboygan Avenue
P.O. Box 7916
Madison, WI 53707-7916

Mr. John Huth, Commissioner
Richland County Highway Dept.
P. O. Box 508
179 W. Gage Street
Richland Center, Wisconsin 53581

Mr. Stan Abing, Commissioner
Grant County Highway Dept.
Box 150
Lancaster, Wisconsin 53813

Mr. Bernal W. Coy,
Richland County Clerk
Courthouse
Richland Center, Wisconsin 53581

Ms. Dorothea Eck,
Grant County Clerk
Courthouse-130 West Maple Street
Lancaster, Wisconsin 53813

Project I.D. 5550-02-21
Muscoda - Richland Center Road
S.T.H. 80
Richland & Grant Counties

The Department of Transportation deems it necessary to make certain revisions on a previously approved right of way plat and to acquire certain lands and interests in lands, according to such revisions, for the proper improvement or maintenance of the above-designated project and highway. The revised relocation order of the Department and the map showing the highway as laid out and established and the lands and interests to be acquired are transmitted herewith.

The attached relocation order sets forth the provisions by whom the right of way will be acquired.

Sincerely,

T. McCarthy, P.E.
State Real Estate Manager-Highways

Enc.

CC: Trans. Dist. 5 & 1
Real Estate

RELOCATION ORDER

R-0-572

State of Wisconsin/Department of Transportation DIVISION OF HIGHWAYS AND TRANSPORTATION SERVICES

PROJECT	NAME OF ROAD	HIGHWAY	COUNTY
5550-02-21	Muscoda - Richland Center Road	S.T.H. 80	Richland & Grant
RIGHT OF WAY PLAT DATE	PLAT SHEET NUMBERS	DATE OF PREVIOUS ORDER	
October 28, 1988	4.0 through 4.13	May 5, 1988	

Description of Termini of Project

Beginning at a point located N 27°-10'-42"W, 110.65 feet from the southwest corner of Lot 8, Block 19, Village of Muscoda, thence in a northerly direction to a point located N82°-03'-00"E, 697.18 feet from the center of Section 12, Township 9 North, Range 1 West.

To properly establish, lay out, widen, enlarge, extend, construct, reconstruct, improve, or maintain a portion of the highway designated above, it is necessary to relocate or change and acquire certain lands or interests in lands as shown on the right of way plat for the above project.

To effect this change, pursuant to authority granted under Sections 84.02(3) and 84.09, Wisconsin Statutes, the Department of Transportation hereby orders that:

1. The said highway is hereby laid out and established to the lines and widths as shown on the plat.
2. The required lands or interests in lands as shown on the plat shall be acquired by the Division of Highways and Transportation Services, in the name of the State of Wisconsin, pursuant to the provisions of Section 84.09(1) or (2), Wisconsin Statutes.
3. This order supersedes and amends any previous order issued by the Department.

NOV 08 1988

Date


for Administrator

[illegible]

ABBREVIATIONS

A.P. ACCESS POINT

NOTES

COORDINATES AND BEARINGS ARE ORIENTED TO THE WISCONSIN
COORDINATE SYSTEM. SOUTH -- ZONE DISTANCES ARE GROUND LENGTHS
AND MAY BE CONVERTED TO GRID LENGTHS BY MULTIPLYING THE DISTANCE
BY THE GRID FACTOR PROVIDED ON THE DETAIL SHEET.

RIGHT OF WAY BOUNDARIES ARE DEFINED WITH COURSES OF THE PERIMETER OF THE HIGHWAY LANDS REFERENCED TO THE PUBLIC LAND SURVEY OR OTHER SURVEY OF PUBLIC RECORD.


RIGHT OF WAY MONUMENTS ARE TYPE #2 AND ARE PLACED AT OR PRIOR TO THE TIME OF LAND TITLE TRANSFER

STA. 343+00
N 82°-03'-00" E 697.18

FROM THE CENTER
OF SECTION 12,
TOWNSHIP 9 NORTH
RANGE 1 WEST

STA. 48+00
1+4
N 27°-10'-42" W 110.65' FROM THE

STA. 48+00 ¹⁴⁴
N 27°-10'-42" W 110.65' FROM THE
SOUTHWEST CORNER OF LOT 8,
BLOCK 19, VILLAGE OF MUSCODA, WIS.

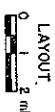

TOTAL NET LENGTH OF CENTERLINE = 5.687 MILES

REVISION
DATE

STATE OF WISCONSIN
DEPARTMENT OF TRANSPORTATION

ID-27-B7

[illegible]

REVISION DATE
10-27-87
4-11-88
10-28-88

ROUTE
S.T.H. 80

COUNTY
GRANT &
RICHLAND

DATE
9-25-87


R/W PROJECT NUMBER
5550-02-21
FEDERAL PROJECT NUMBER

SHEET NUMBER
4.1

SCHEDULE OF LANDS & INTERESTS REQUIRED

AREAS SHOWN IN THE TOTAL ACRES COLUMN MAY BE APPROXIMATE AND ARE DERIVED FROM TAX ROLLS OR OTHER AVAILABLE SOURCES AND MAY NOT INCLUDE LANDS OF THE OWNER WHICH ARE NOT CONTIGUOUS TO THE AREA TO BE ACQUIRED.

PARCEL NUMBER	SHEET NUMBER	OWNER	INTERESTS REQUIRED	TOTAL BEFORE AC./S.F.	AC./S.F. REQUIRED			TOTAL REM. AC./S.F.	L.H.E. AC./S.F.	
					NEW	EXIST.	TOTAL		PERM.	TEMP.
1	4.4.5	STATE OF WISCONSIN (ONR - EASEMENT RIGHTS)		-	-	-	-	-	-	-
2	4.4.4.5	THOMAS L. IVERSON	FEE, L.H.E. & ACCESS RTS.	7.00	0.04	1.09	1.13	5.87	-	0.51
3	4.4	GORDON M. GRIBBLE L.C. TO LARRY MEYER	FEE	0.23	0.23	0.00	0.23	0.00	-	-
4	4.4.4.5	DONALD J. STADELE	FEE, L.H.E. & ACCESS RTS.	277.02	1.27	0.95	2.22	274.80	0.12	0.10
5	4.4.4.5	DEAN COOLEY	FEE, L.H.E. & ACCESS RTS.	22.00	0.02	0.15	0.17	21.83	-	0.06
6	4.5	MAE RUTH THOMPSON	FEE & ACCESS RTS.	220.00	1.40	2.02	3.42	216.58	-	-
7	4.5	GEORGE L. GRANKEY	FEE, L.H.E. & ACCESS RTS.	177.31	1.92	1.48	3.40	173.91	-	0.15
8	4.5.4.6	GERALD E. GRANKEY	FEE, L.H.E. & ACCESS RTS.	290.13	2.85	2.02	4.87	285.26	0.14	-
9	4.6	KEITH ANDERSON	FEE	45.05	0.02	0.01	0.03	45.02	-	-
10	4.6.4.7	ALAN & JOHN BAKER	FEE & L.H.E.	322.83	0.56	0.40	0.96	321.87	-	0.20
11	4.7.4.8	JOSEPH B. MAKOVEC	FEE, L.H.E. & ACCESS RTS.	311.00	4.04	5.15	9.19	301.81	0.78	0.13
12		HUGH J. HONER L.C. TO								
13	4.7.4.8	LOWELL D. EWING	FEE, L.H.E. & ACCESS RTS.	120.00	1.35	0.95	2.31	117.69	0.36	0.35
14	4.8	FRANK J. STORK	FEE & ACCESS RTS.	24.35	8.67	1.61	10.28	14.07	-	-
15	4.8.4.9	RAY K. JENNINGS	FEE & ACCESS RTS.	2.65	1.08	0.27	1.35	1.30	-	-
16	4.9.4.10	LOUIS J. ZAHALKA	FEE, L.H.E. & ACCESS RTS.	348.00	4.29	4.80	9.09	358.91	0.15	0.12
17	4.9	DONALD C. STORMS	FEE, L.H.E. & ACCESS RTS.	163.81	5.20	2.92	8.16	155.65	0.34	-
18	4.9.4.10	DAVID STORMS	FEE	0.69	0.08	0.08	0.16	0.53	-	-
19	4.10	VILLAGE OF MUSCODA	FEE & ACCESS RTS.	2.15	0.47	0.20	0.67	1.48	-	-
20		GARY S. ENDERS	FEE	5.00	0.36	0.48	0.84	4.16	-	-
21	4.9.4.10	MARTHA R. MILLER L.C. TO	FEE, L.H.E. & ACCESS RTS.	30.65	1.59	1.96	3.55	27.10	0.10	-
22	4.10	ROGER VENHUIZEN, ET. AL.	FEE & ACCESS RTS.	1.18	0.02	0.34	0.36	0.82	-	-
23	4.10	RUBY PARISH								
24	4.10	RUBY PARISH L.C. TO								
25	4.10	JOSEPH E. BLOK	FEE, L.H.E. & ACCESS RTS.	0.72	0.02	0.38	0.40	0.32	0.21	-
26	4.10	GARY CANNON	FEE & ACCESS RTS.	6.50	0.75	0.73	1.48	5.02	-	-
27	4.10-4.13	ANTHONY STADELE	FEE, L.H.E. & ACCESS RTS.	1619.74	10.11	7.61	17.72	1602.02	1.68	1.18
28	4.11.4.12	CARL L. LEWIS L.C. TO								
29	4.11	ANTHONY STADELE	FEE, L.H.E. & ACCESS RTS.	95.00	5.54	2.55	8.09	86.91	0.39	2.01
30	4.12.4.13	ERMA Z. JANNEY	FEE, L.H.E. & ACCESS RTS.	3.00	0.28	0.35	0.63	2.37	0.06	-
31	4.13	MICHAEL A. WINDSTRUP	FEE, L.H.E. & ACCESS RTS.	106.27	2.81	1.58	4.39	101.88	0.31	-
32	4.13	DAIRYLAND POWER CO-OP	FEE, L.H.E. & ACCESS RTS.	169	0.22	0.27	0.49	1.20	-	0.04
33	4.13	RALPH KOBITTER	FEE, L.H.E. & ACCESS RTS.	351.35	1.20	2.14	3.34	348.01	0.09	-
34	4.13	STEVEN L. HOTH	FEE & ACCESS RTS.	7.60	0.30	0.50	0.80	6.80	-	-
35	4.4.4.5	GTE NORTH INCORPORATED	RELEASE OF RIGHTS	-	-	-	-	-	-	-
36	4.7.4.8									
37	4.8	NORTHERN NATURAL GAS (42)	RELEASE OF RIGHTS	-	-	-	-	-	-	-
38	4.9.4.10	RICHLAND ELECTRIC (43)	RELEASE OF RIGHTS	-	-	-	-	-	-	-
39	4.13									
40	4.13	DAIRYLAND POWER COOP. (44)	RELEASE OF RIGHTS	-	-	-	-	-	-	-
41	4.4	ROBERT I. GRIFFIN	FEE & ACCESS RTS.	1.40	0.09	-	0.09	1.31	-	-
42	4.4	DONALD J. STADELE	FEE & ACCESS RTS.	1.61	0.36	-	0.36	1.25	-	-
43	4.4	HENNESSEY MOTORS, INC.	ACCESS RTS.	-	-	-	-	-	-	-
44	4.4	AMY J. BROWN, ET. AL.	ACCESS RTS.	-	-	-	-	-	-	-
45	4.5-4.7	JAMES M. MILLER	ACCESS RTS.	-	-	-	-	-	0.40	-
46	4.9	DAWSON CEMETERY ASSOC.	ACCESS RTS.	-	-	-	-	-	-	-
47	4.5	EDWARD W. STACKMAN	ACCESS RTS.	-	-	-	-	-	-	-
48	4.4	RGTR. FED. 581 L.G. TO JACK FRAZIER	L.H.E.	-	-	-	-	-	-	0.08

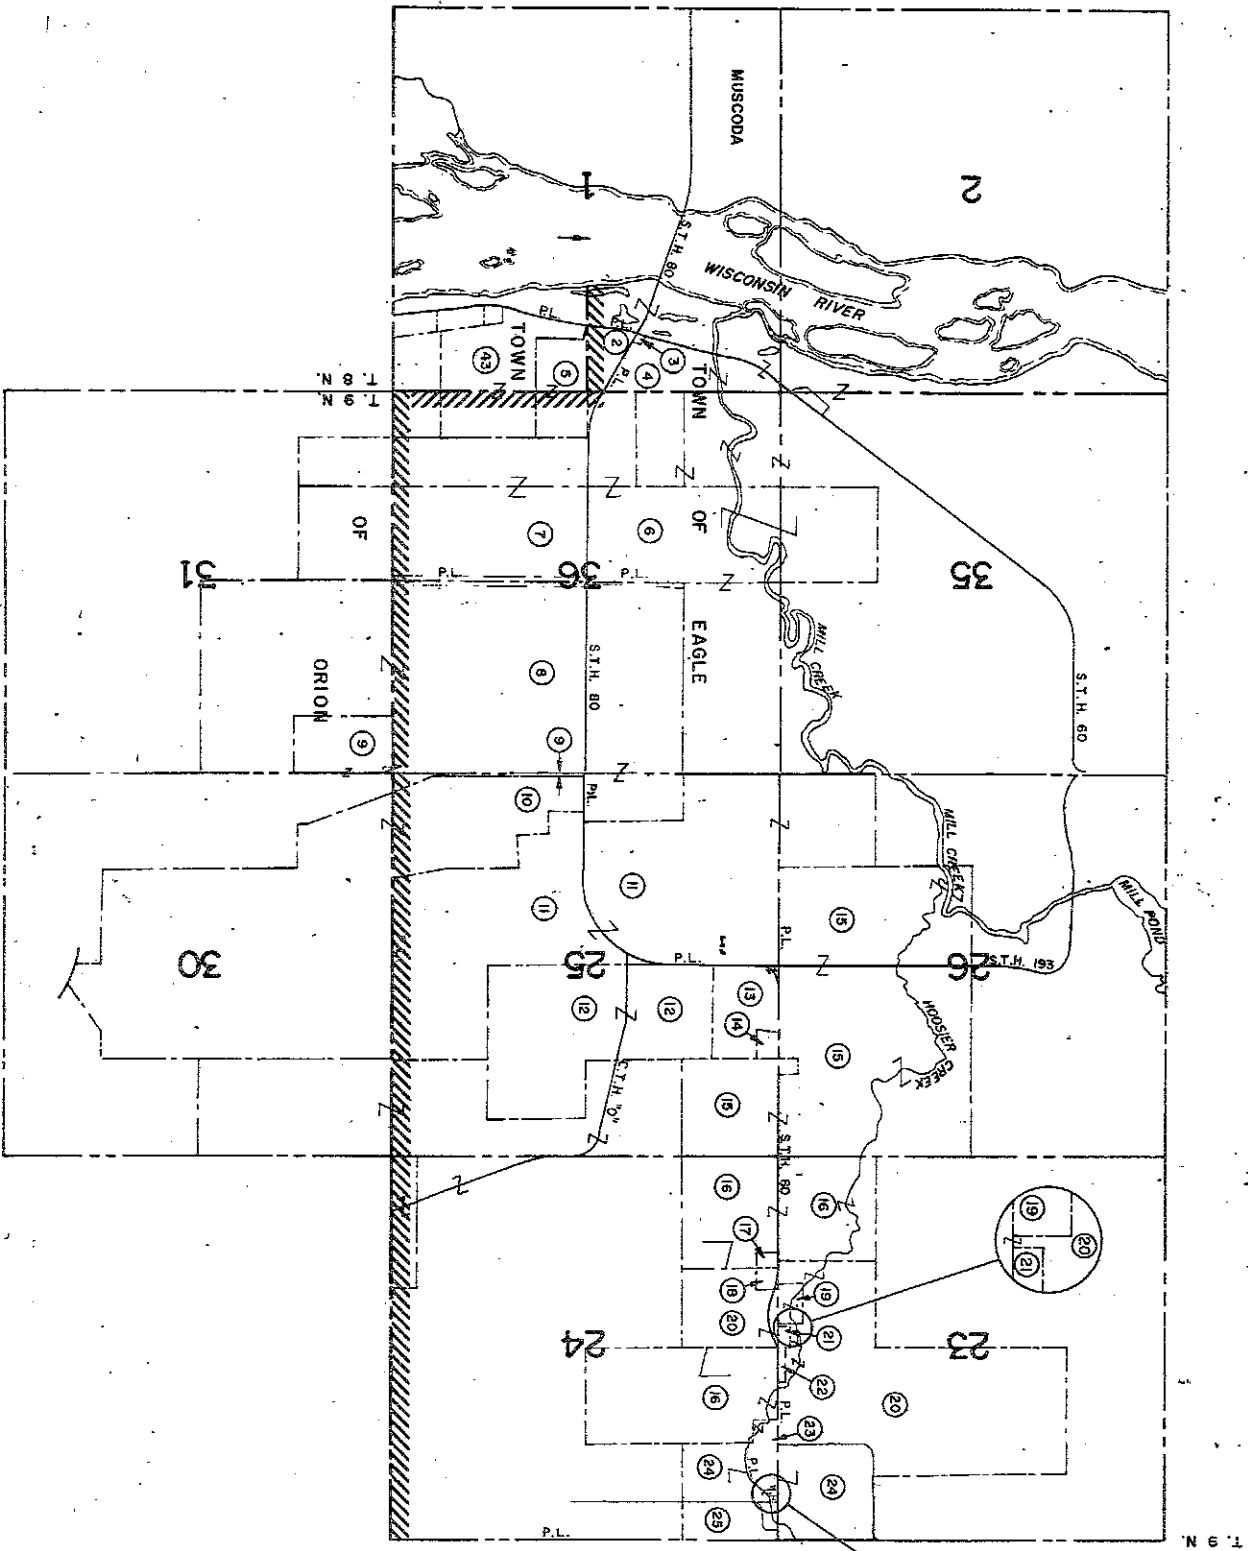


REVISION DATE 10-27-87 4-11-88 10-28-88 N.C.		ROUTE S.T.H. 80		COUNTY GRANT & RICHLAND		DATE 6-25-87		R/W PROJECT NUMBER 5550-02-21*		FEDERAL PROJECT NUMBER		SHEET NUMBER 4.2	
NOT TO SCALE													




R. 10 E.
T. 9 N.

REVISION DATE 10-27-87 4-11-88 NC 10-28-88 N.C.	ROUTE S.H. 80	COUNTY GRANT & RICHLAND	DATE 6-25-87	N/W PROJECT NUMBER 5560-02-21 FEDERAL PROJECT NUMBER	SHEET NUMBER 4.3
NOT TO SCALE					

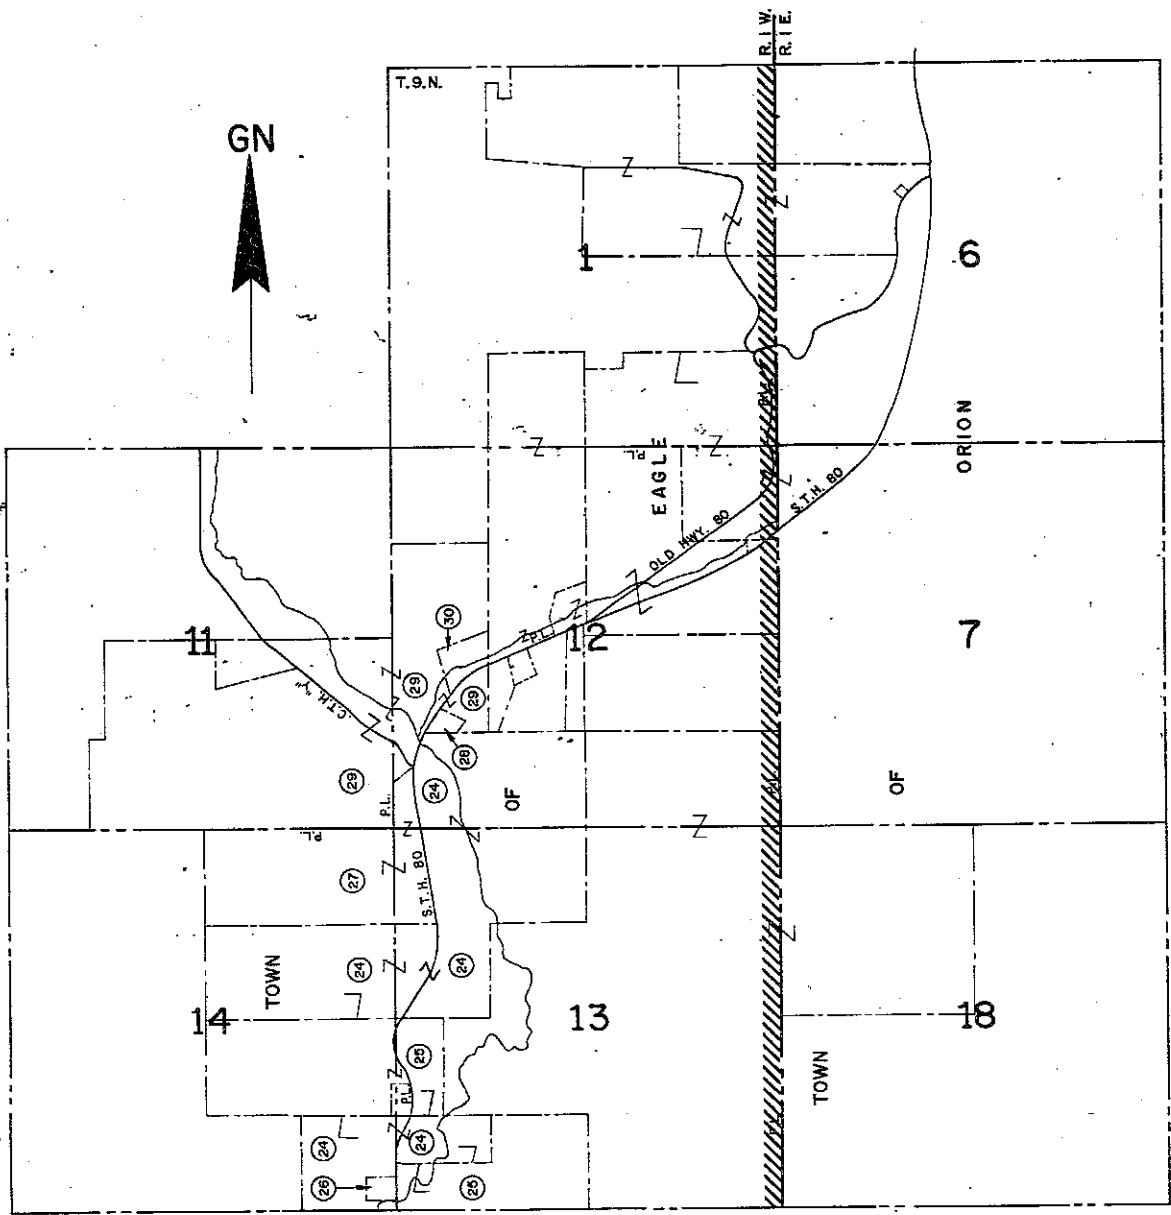

FILE NAME: B55002-010101

LEVELS ON

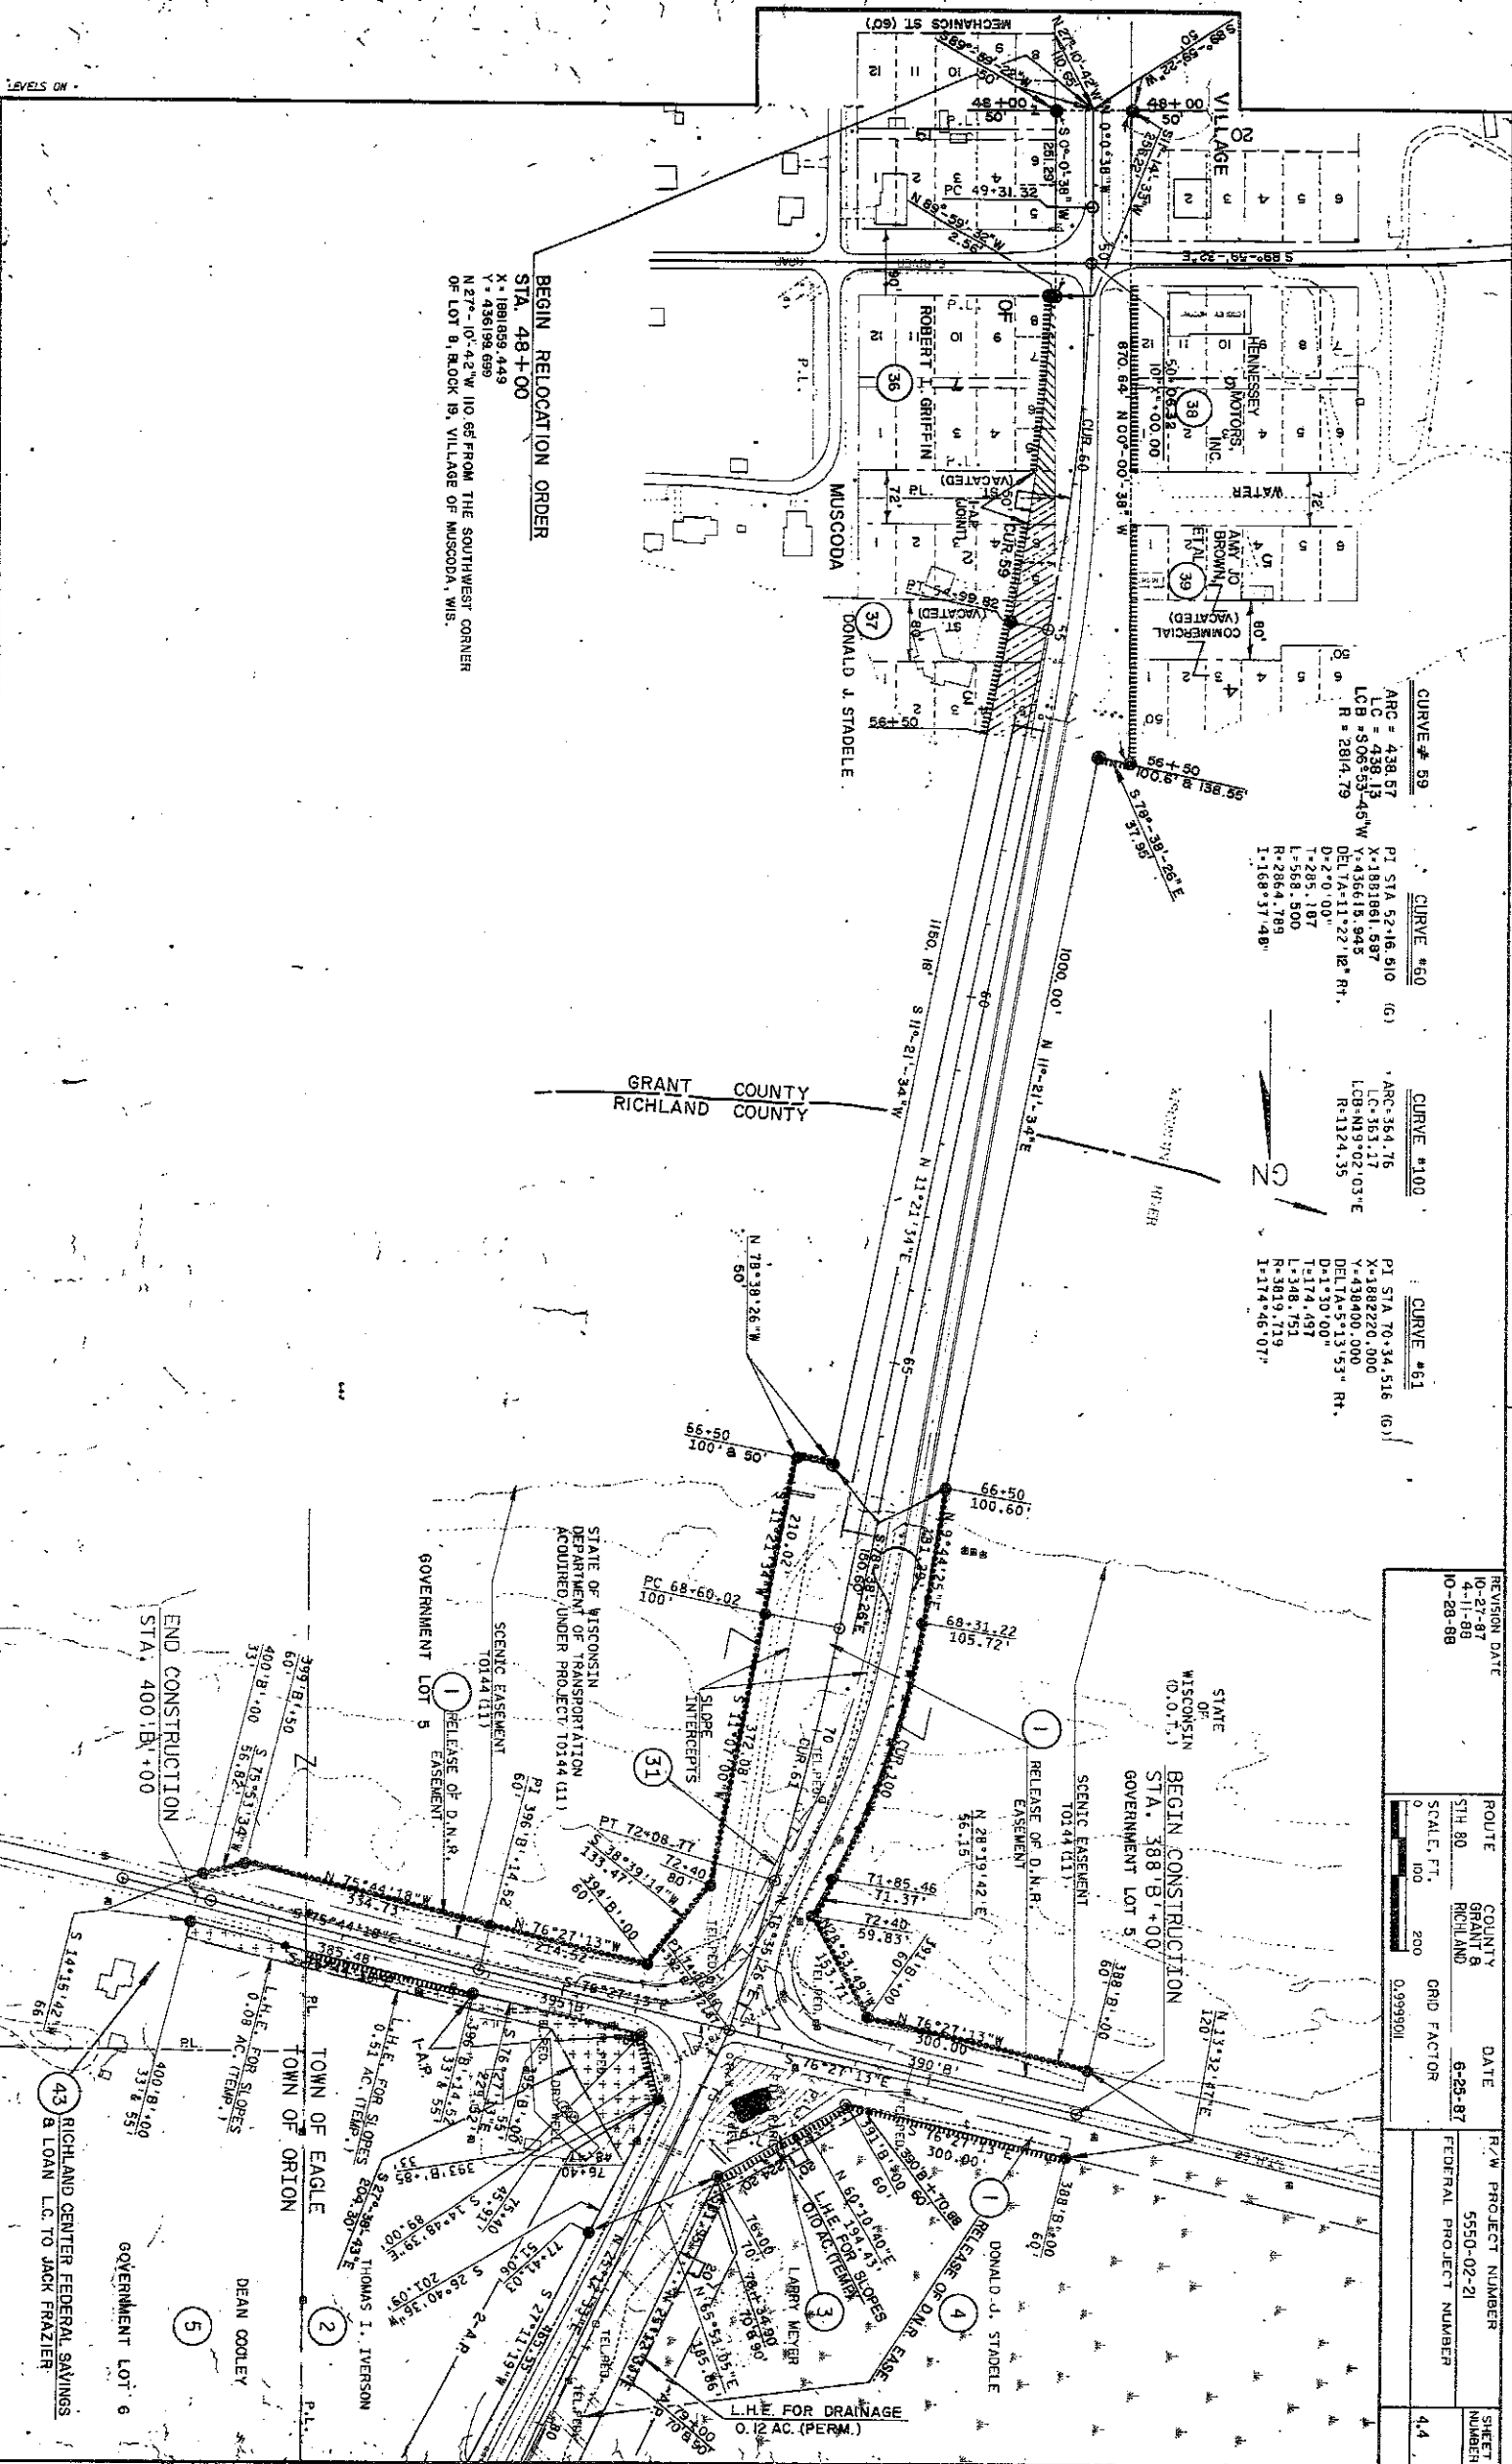

BEGIN RELOCATION ORDER
STA. 48+00
X = 189188.448
Y = 436192.693
N 27°-10'-42" W 10.65' FROM THE SOUTHWEST CORNER
OF LOT 9, BLOCK 19, VILLAGE OF MUSCODA, WIS.


CURVE #59
ARC = 438.67
LC = 438.19
LCB = 506.53-45 W
R = 2814.79
PI STA 52+16.910 (G)
X = 189181.587
Y = 436619.945
DELTA = 11°22'12" Rt.
D = 2°0'00"
T = 285.187
L = 568.500
R = 2864.789
I = 168°37'48"

CURVE #60
ARC = 354.76
LC = 353.17
LCB = 429°02'03"E
R = 1124.35
PI STA 70+34.516 (G)
X = 188220.000
Y = 430400.000
DELTA = 5°13'53" Rt.
D = 1°30'00"
T = 174.497
L = 348.751
R = 3819.719
I = 114°46'07"

CURVE #100
ARC = 354.76
LC = 353.17
LCB = 429°02'03"E
R = 1124.35
PI STA 70+34.516 (G)
X = 188220.000
Y = 430400.000
DELTA = 5°13'53" Rt.
D = 1°30'00"
T = 174.497
L = 348.751
R = 3819.719
I = 114°46'07"

REVISION DATE	ROUTE	COUNTY	DATE	R.W. PROJECT NUMBER	SHEET NUMBER
10-27-87 4-11-88 10-28-88	STH 80	GRANT & RICHLAND	6-25-87	5550-02-21	44
	SCALE, FT.		GRID FACTOR	FEDERAL PROJECT NUMBER	
	0 100 200		0.999901		


REVISION DATE	ROUTE	COUNTY	R/W PROJECT NUMBER	SHEET NUMBER
10-27-87	5TH 80	GRANT & RICHLAND	5550-02-21	
4-11-88	SCALE, FT.		FEDERAL PROJECT NUMBER	
10-28-88	0 100 200			4.5
	GRID FACTOR			
	0.9959011			

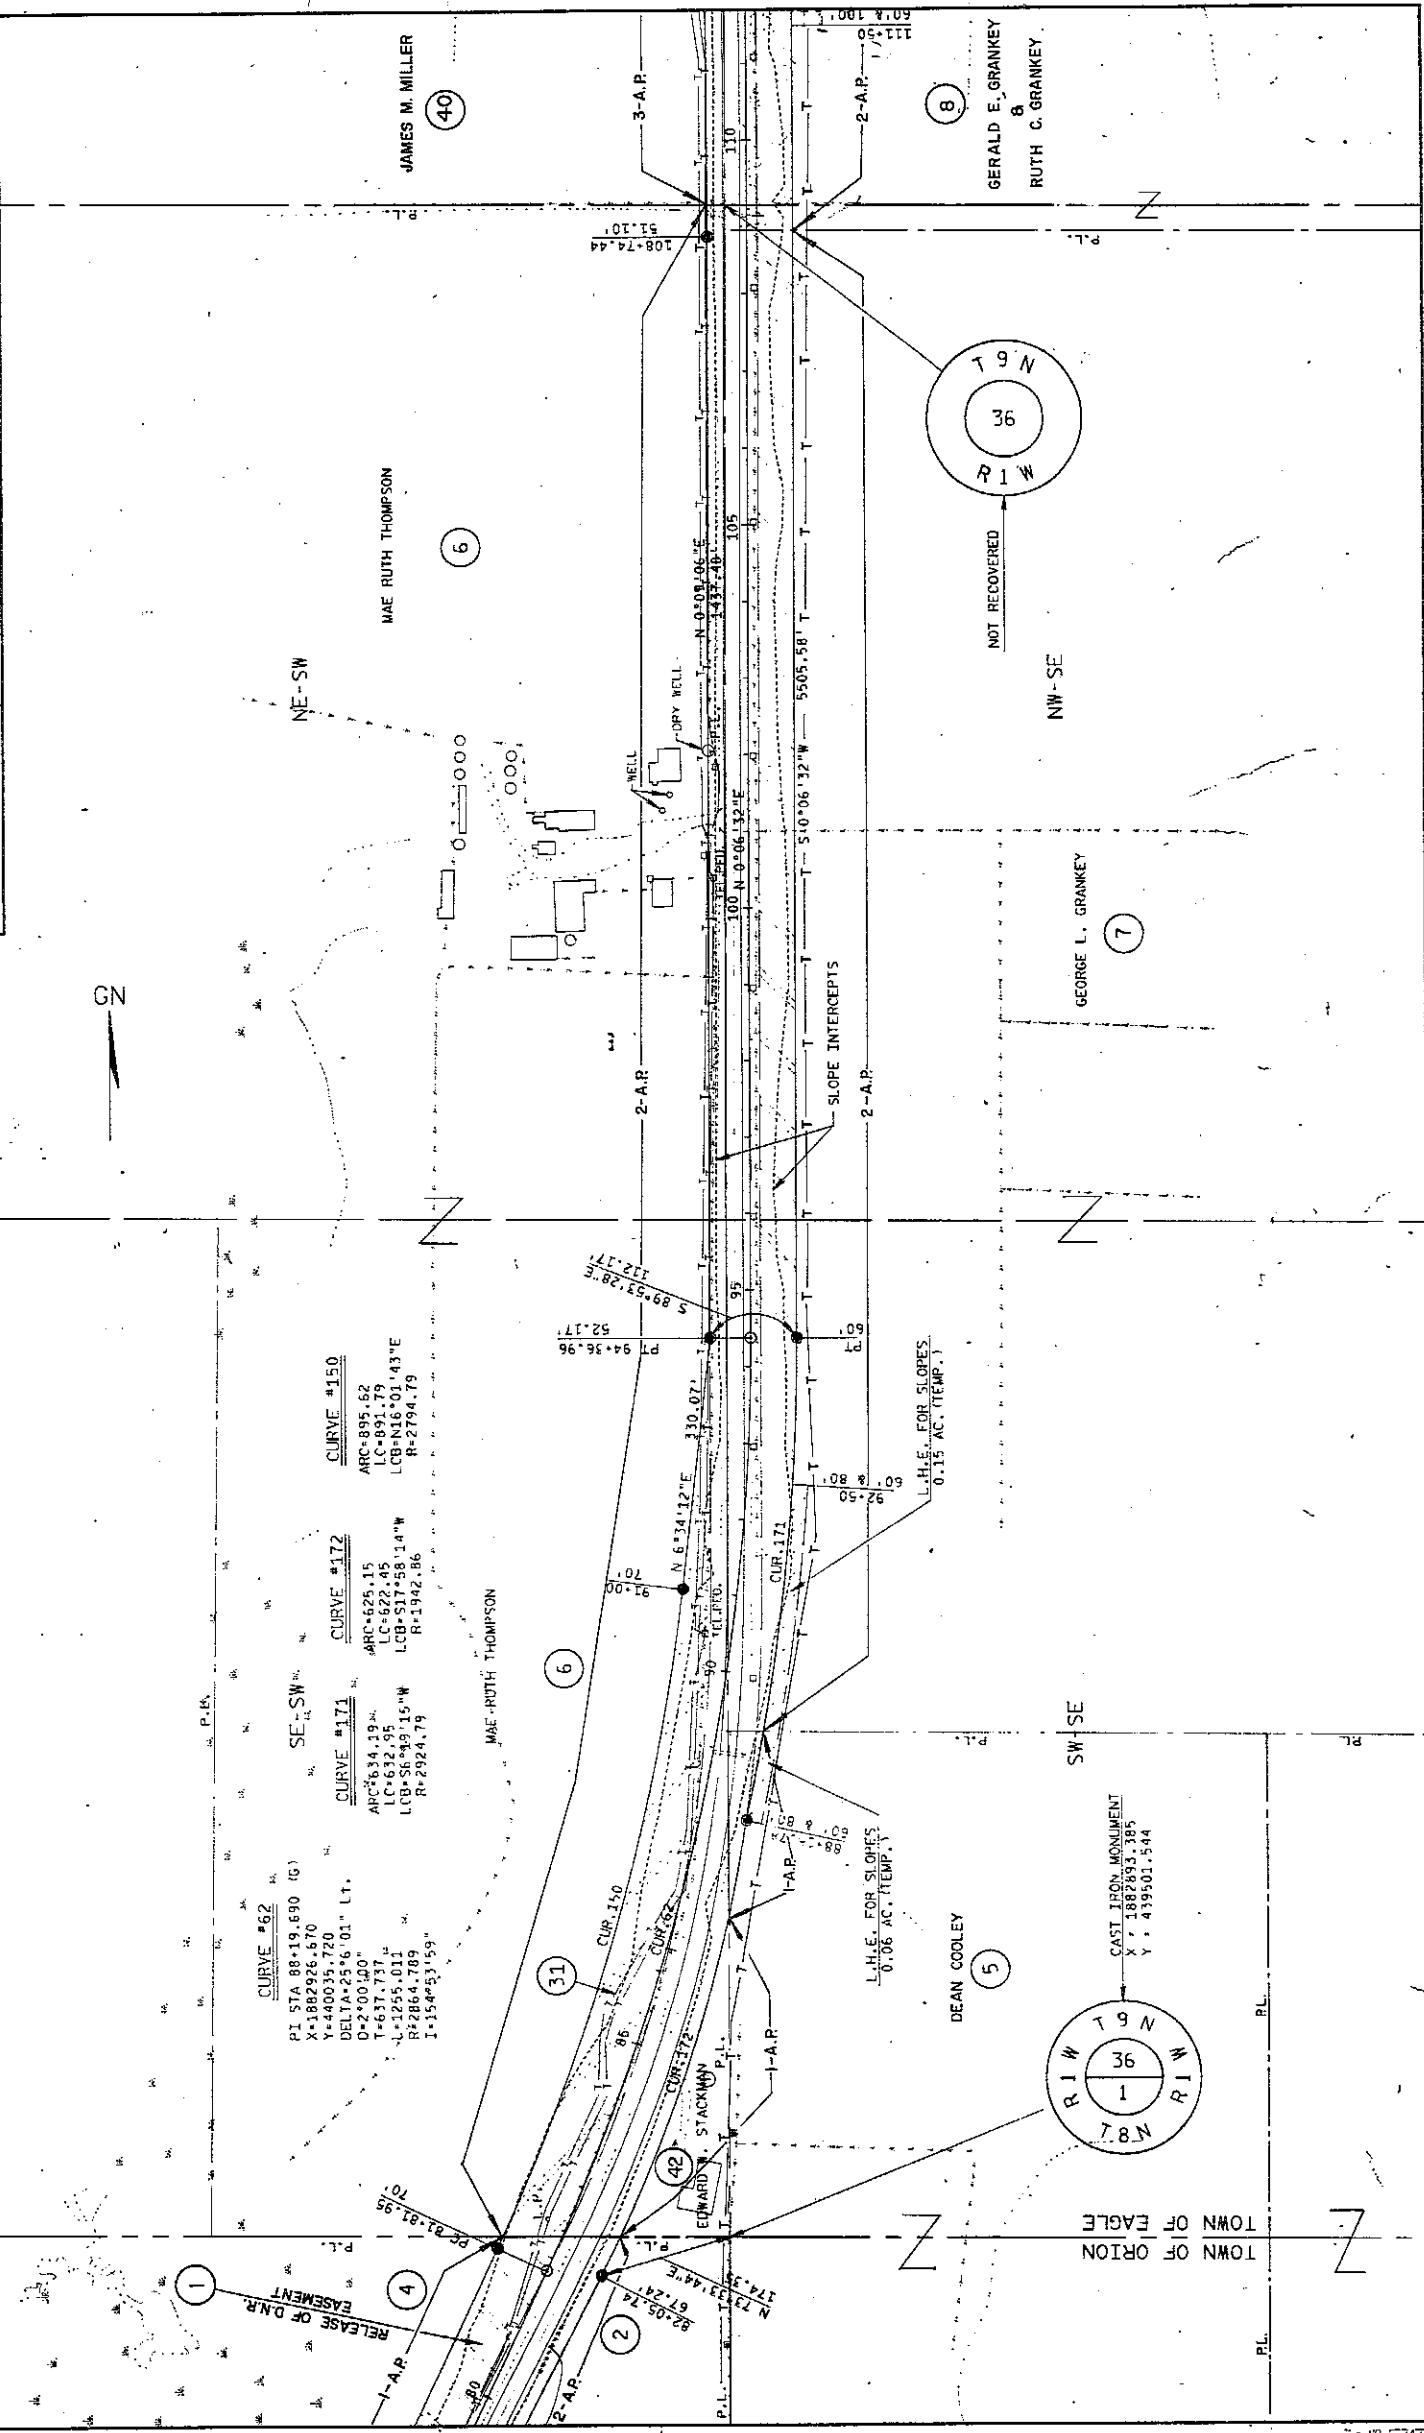

LEVELS ON +1


FILE NAME: 55502403.000


WISDOT/CADD'S SHEET 75

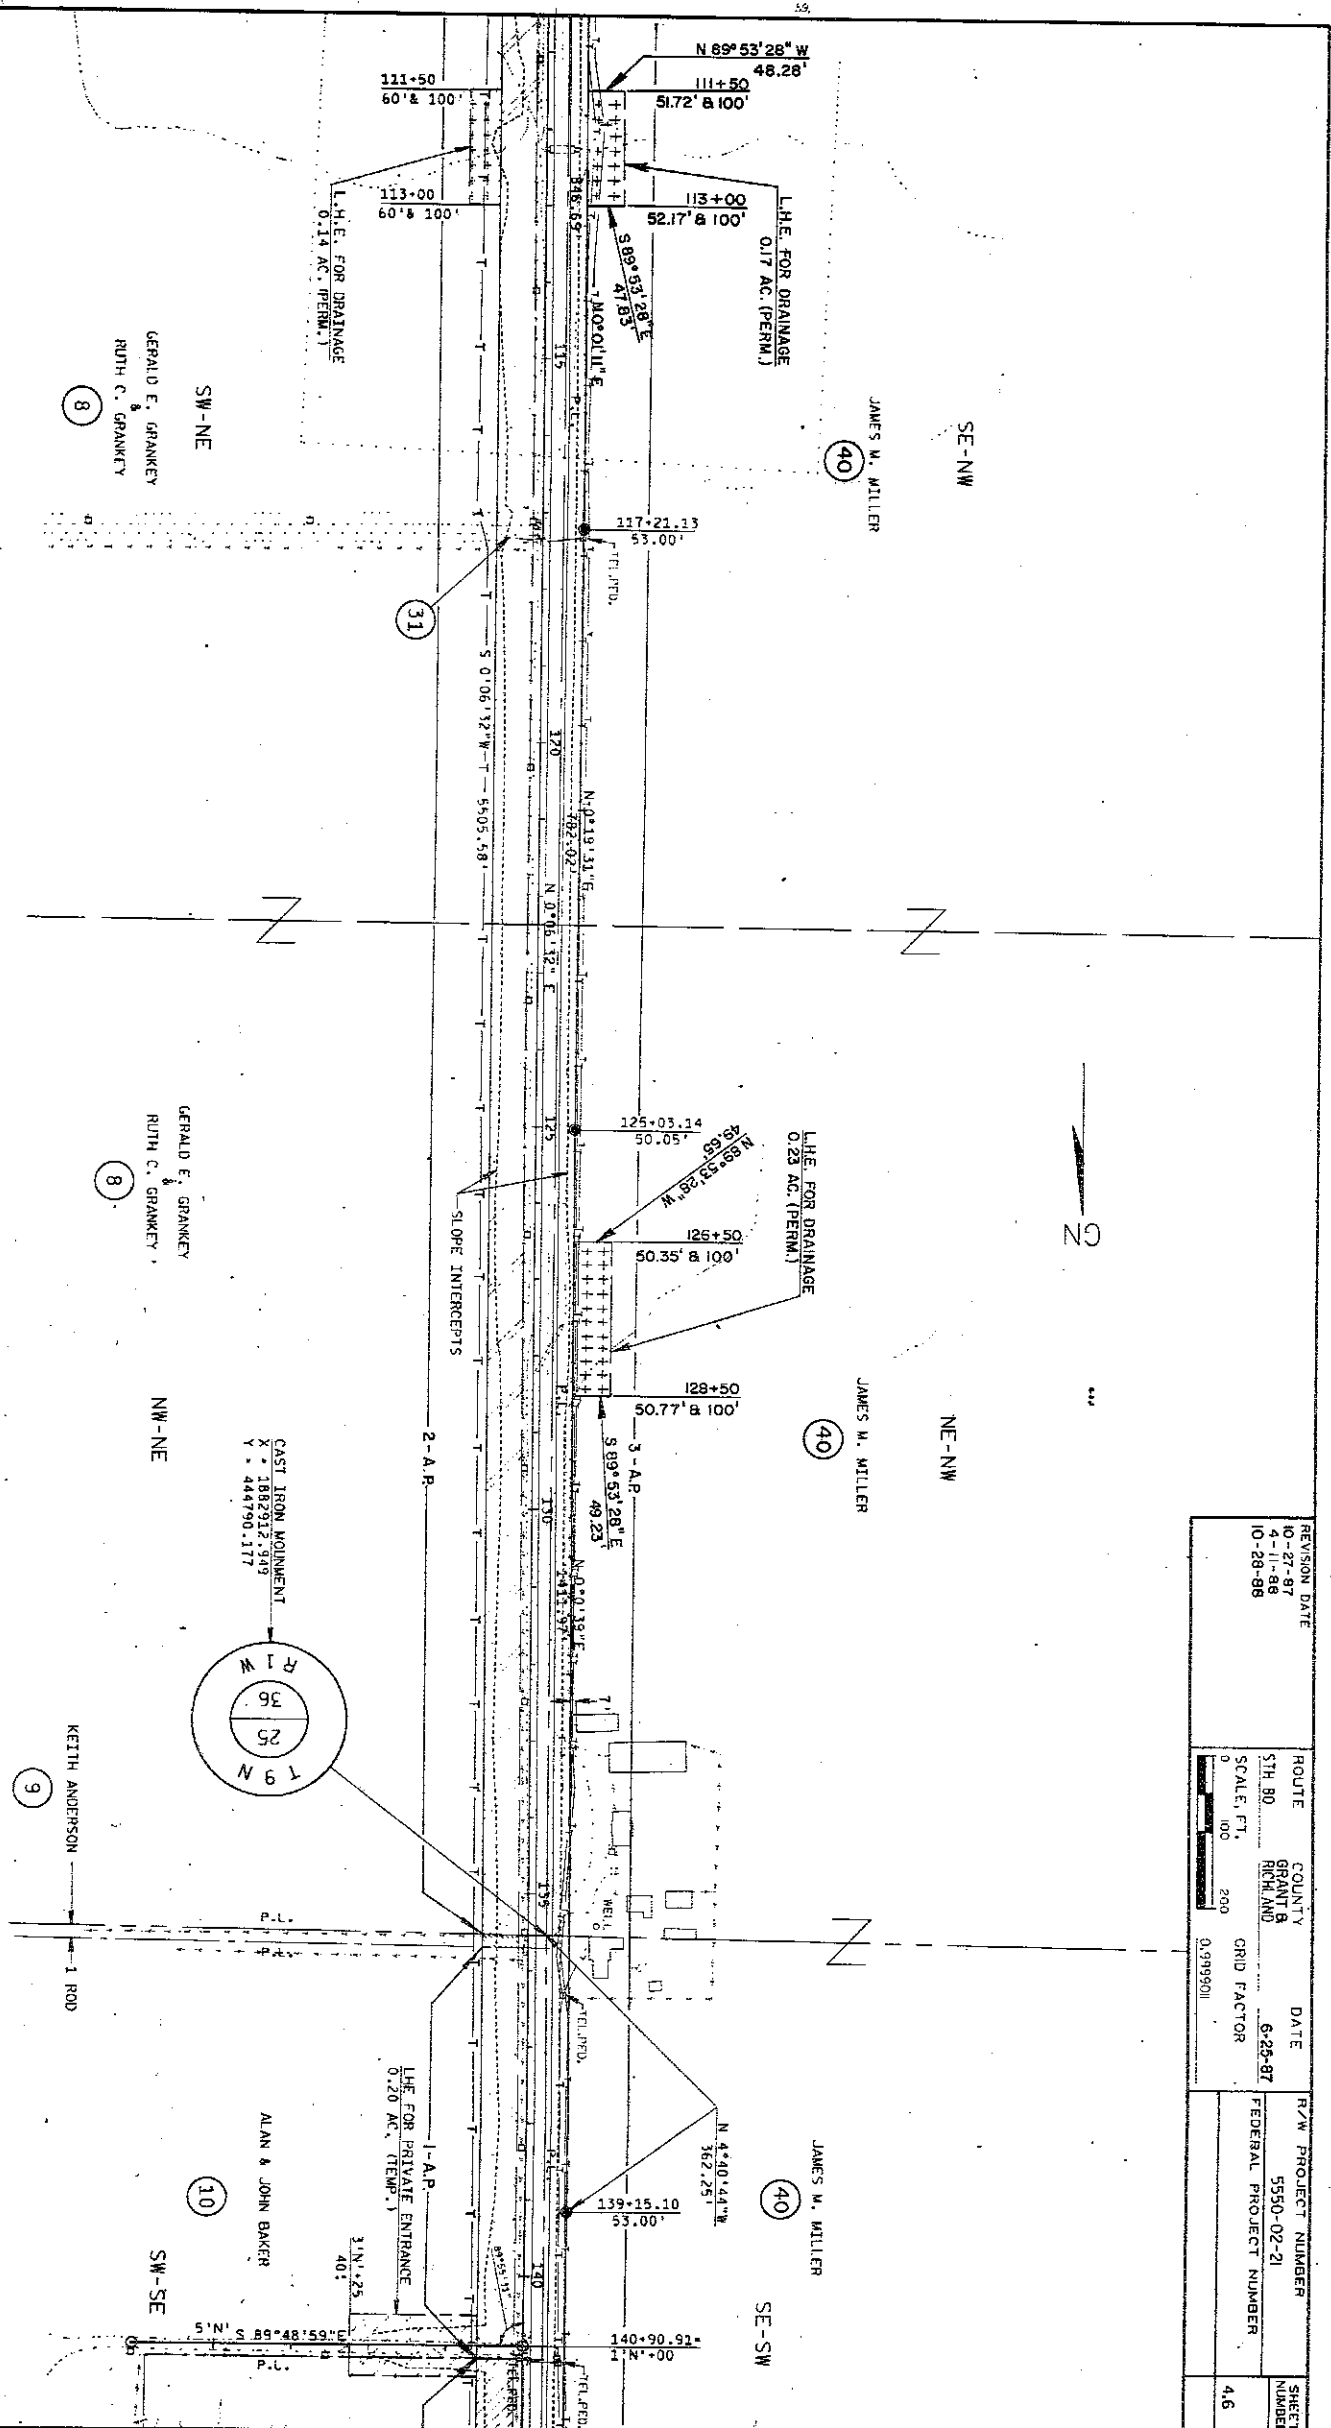

REVISION DATE	ROUTE	COUNTY	DATE	R/W PROJECT NUMBER	SHEET NUMBER
10-27-87 4-11-88 10-28-98	STH 80	GRANT A	6-28-87	5550-02-21	4.6
	SCALE, FT.	RICHMOND	GRID FACTOR	FEDERAL PROJECT NUMBER	
	0 100 200		0.999501		

REVISION DATE	ROUTE	COUNTY	DATE	RAW PROJECT NUMBER	SHEET NUMBER
10-27-87 4-11-88 NC 10-28-88	STH 80	GRANT & RICHLAND	6-28-87	5550-02-21	4.7
	SCALE, FT.	GRID FACTOR			
	0	0.9999011			

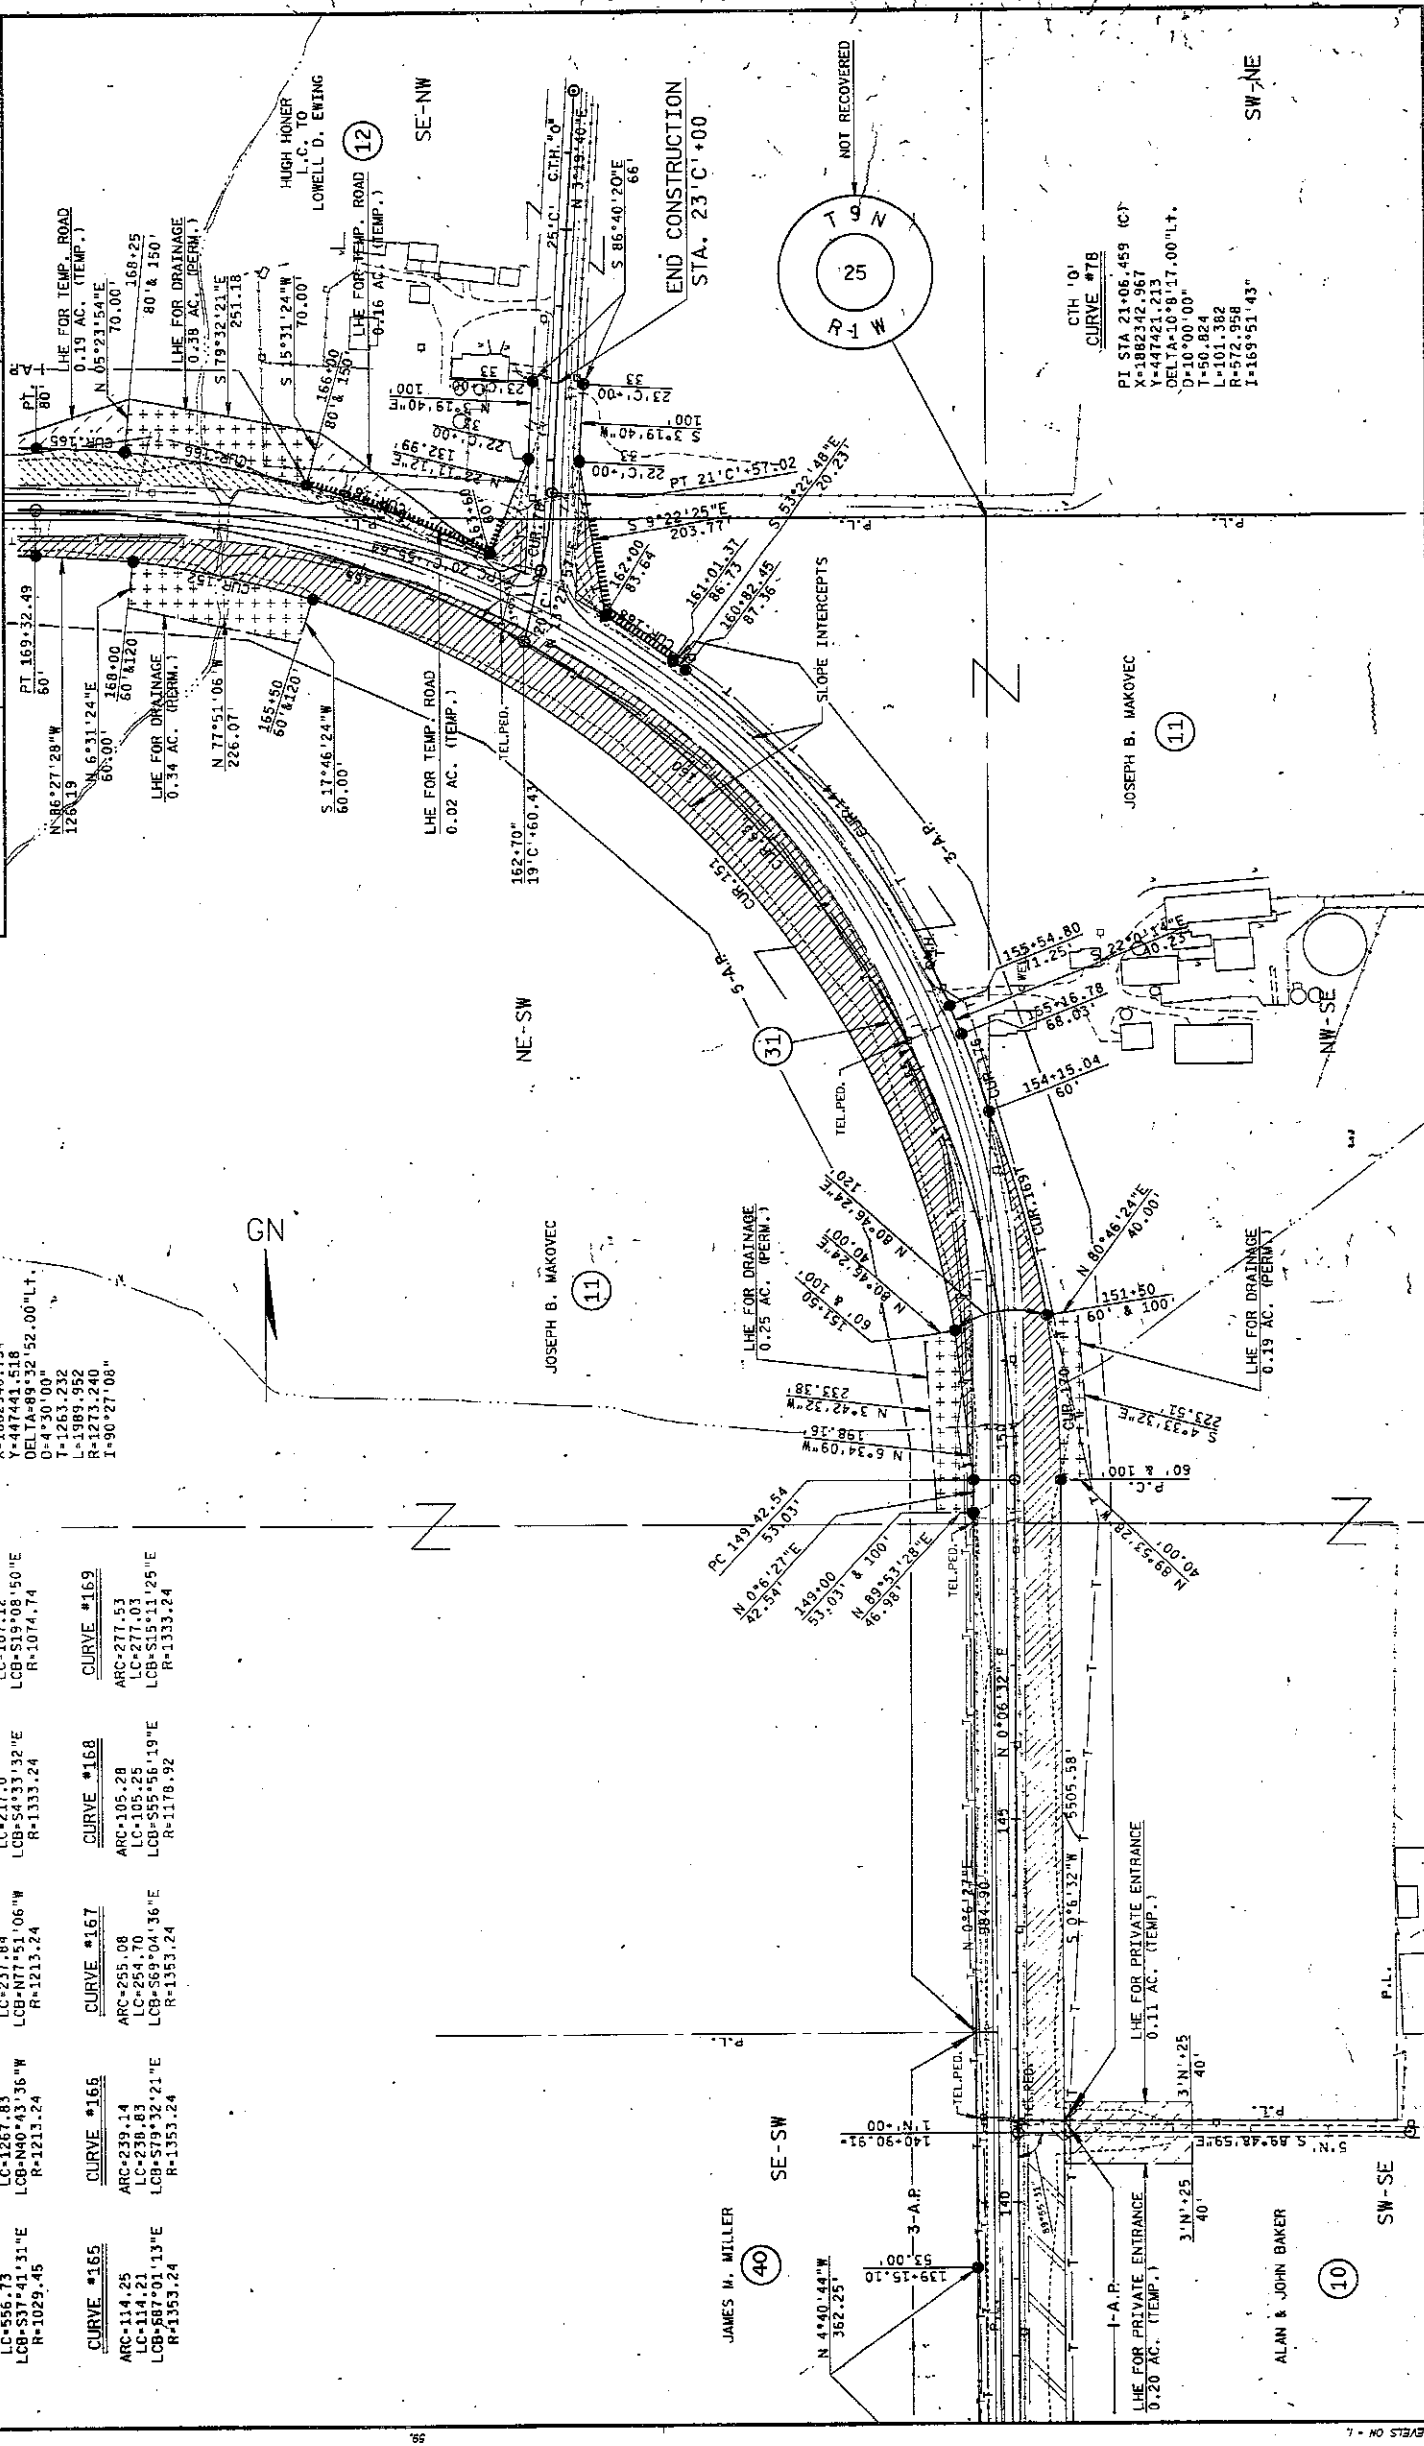


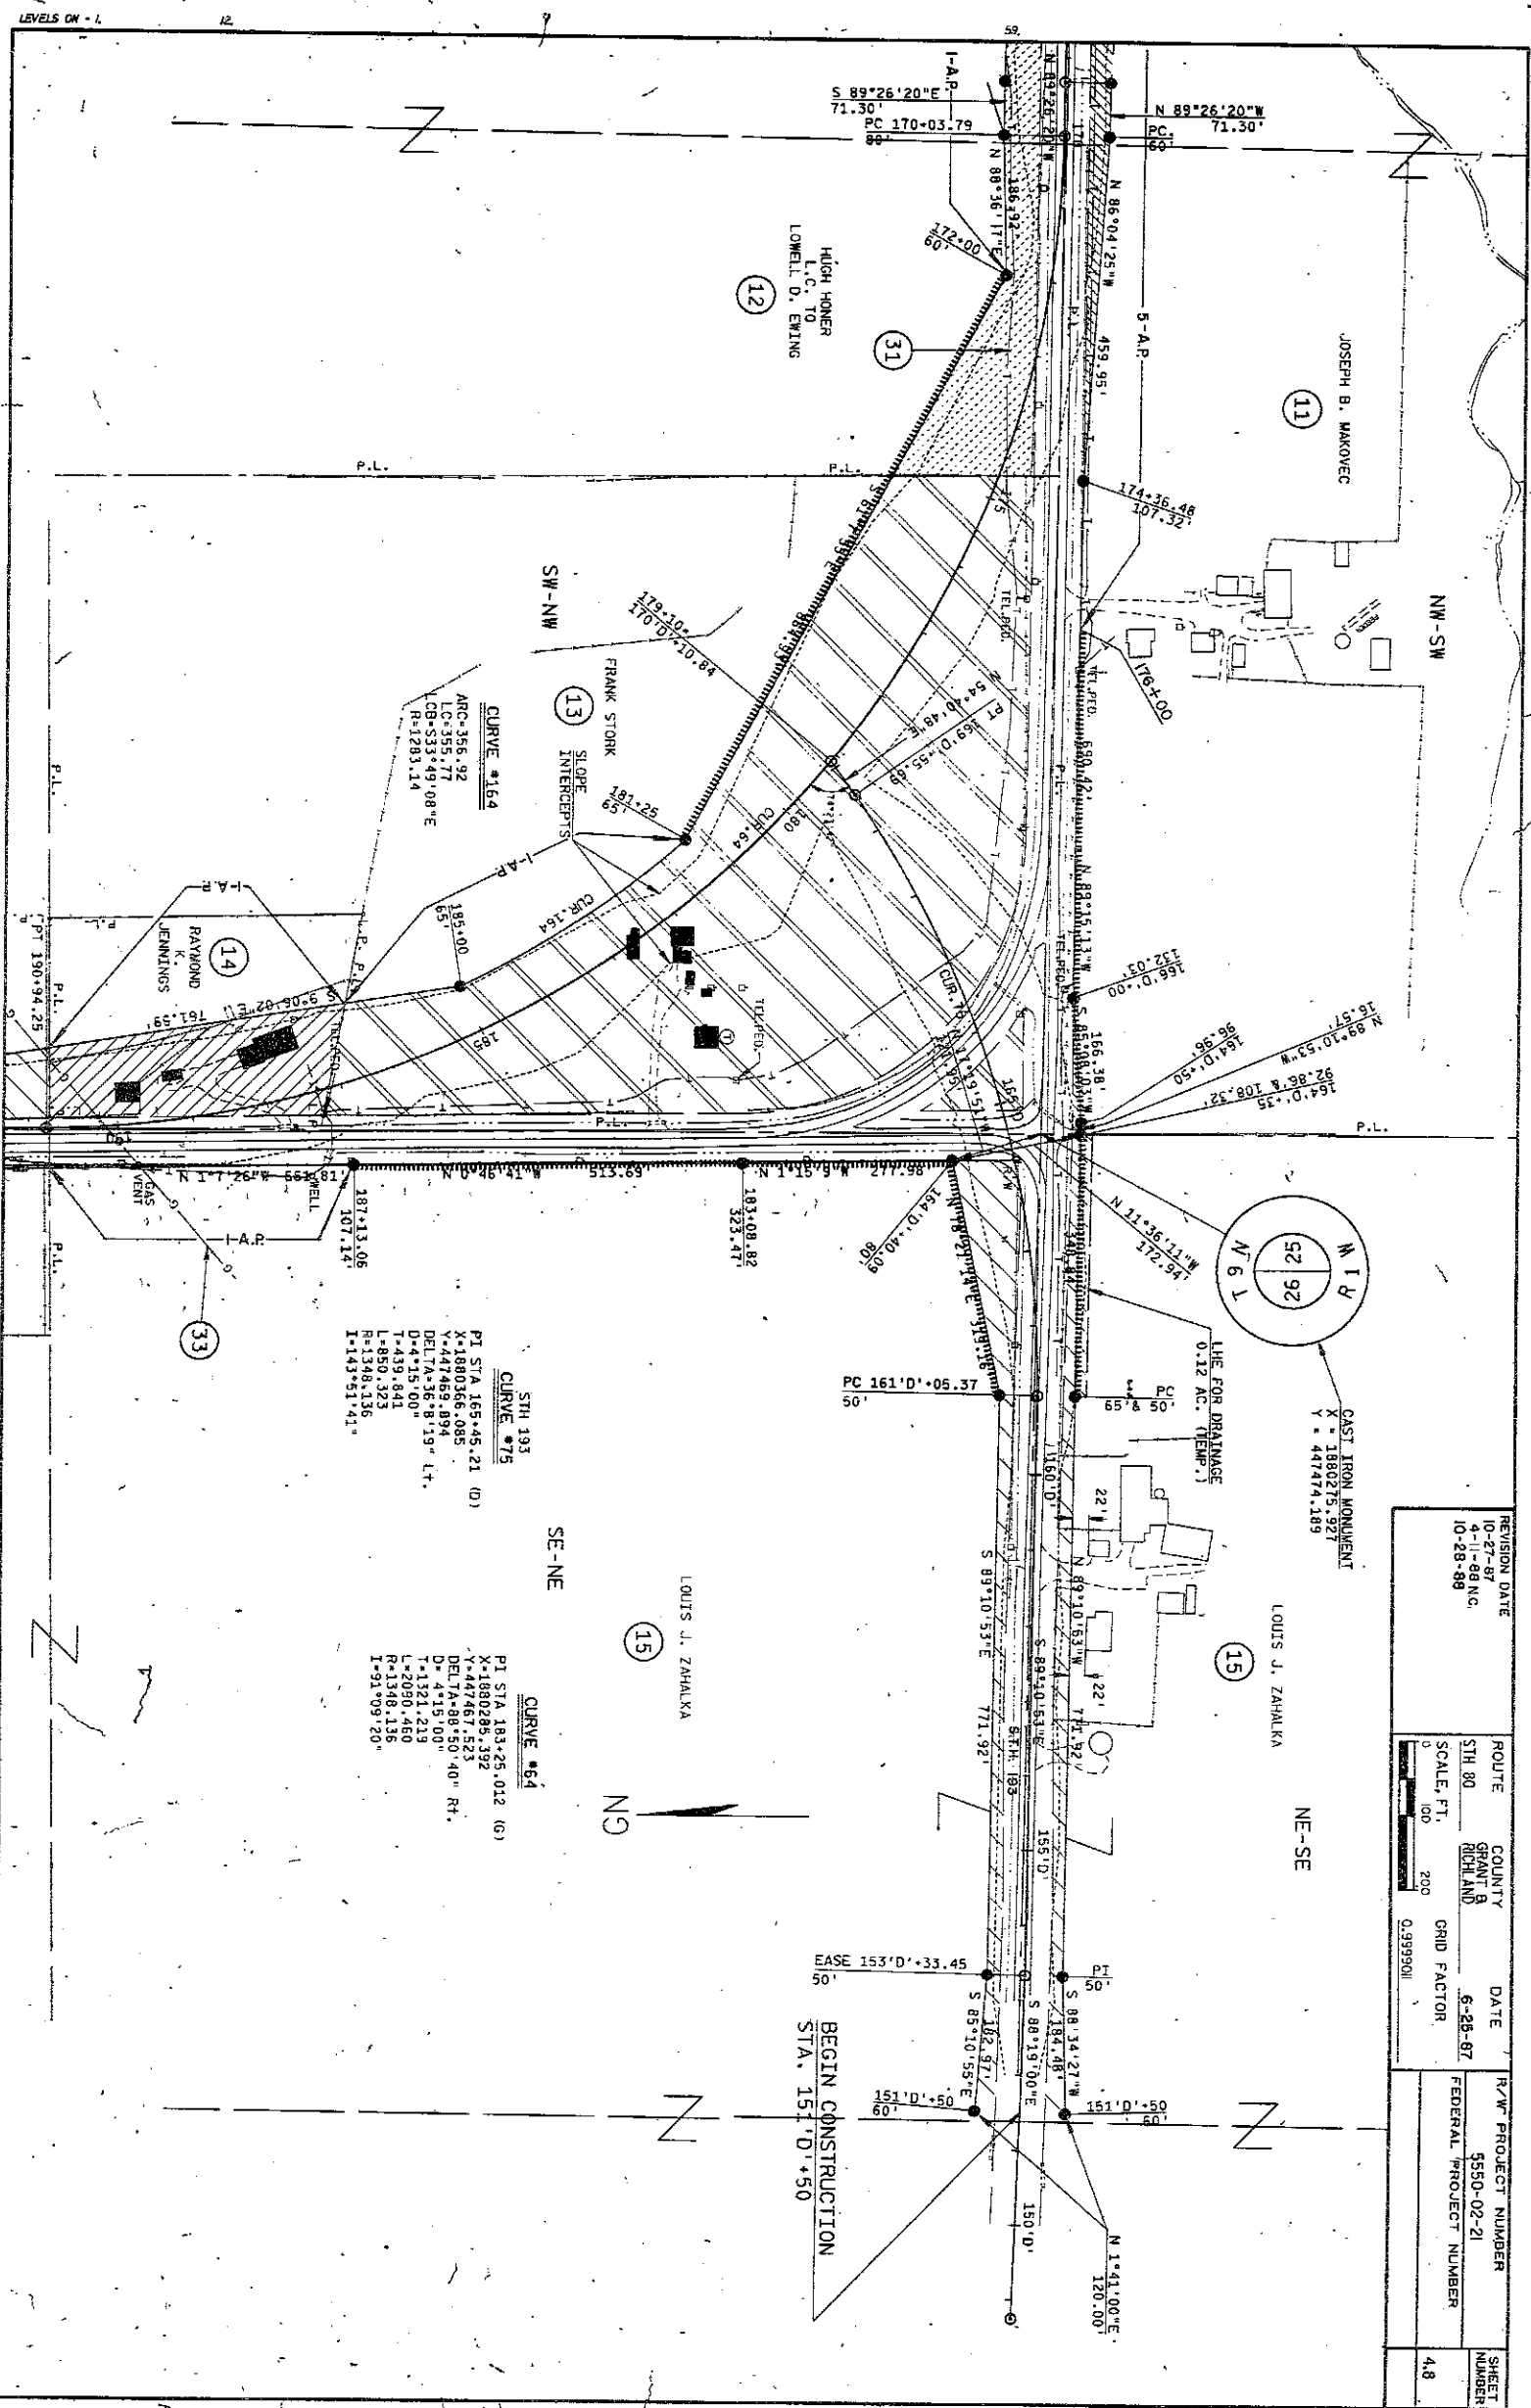



REVISION DATE		ROUTE		COUNTY		DATE		R/W PROJECT NUMBER		SHEET	
10-27-87		4-11-88 NC		STH 80		GRANT B		5550-02-21		4.8	
10-28-88		SCALE, FT.		1" = 200'		GRID FACTOR		FEDERAL PROJECT NUMBER			
		0.999901									

REVISION DATE	ROUTE	COUNTY	DATE	R/W PROJECT NUMBER	SHEET NUMBER
10-27-87 4-11-88 NC 10-28-88	S.I.H. 80	GRANT & RICHLAND	6-25-87	5550-02-21	4,9
	SCALE, FT.	GRID FACTOR			
	0 100 200	0.999901			

CURVE #66
 PT STA 212+99.458 (G)
 X=1880248.816
 Y=450993.409
 DELTA=3°54'02" Lt.
 D=1°30'00"
 L=130.072
 R=260.043
 R=3819.719
 I=176°14'58"

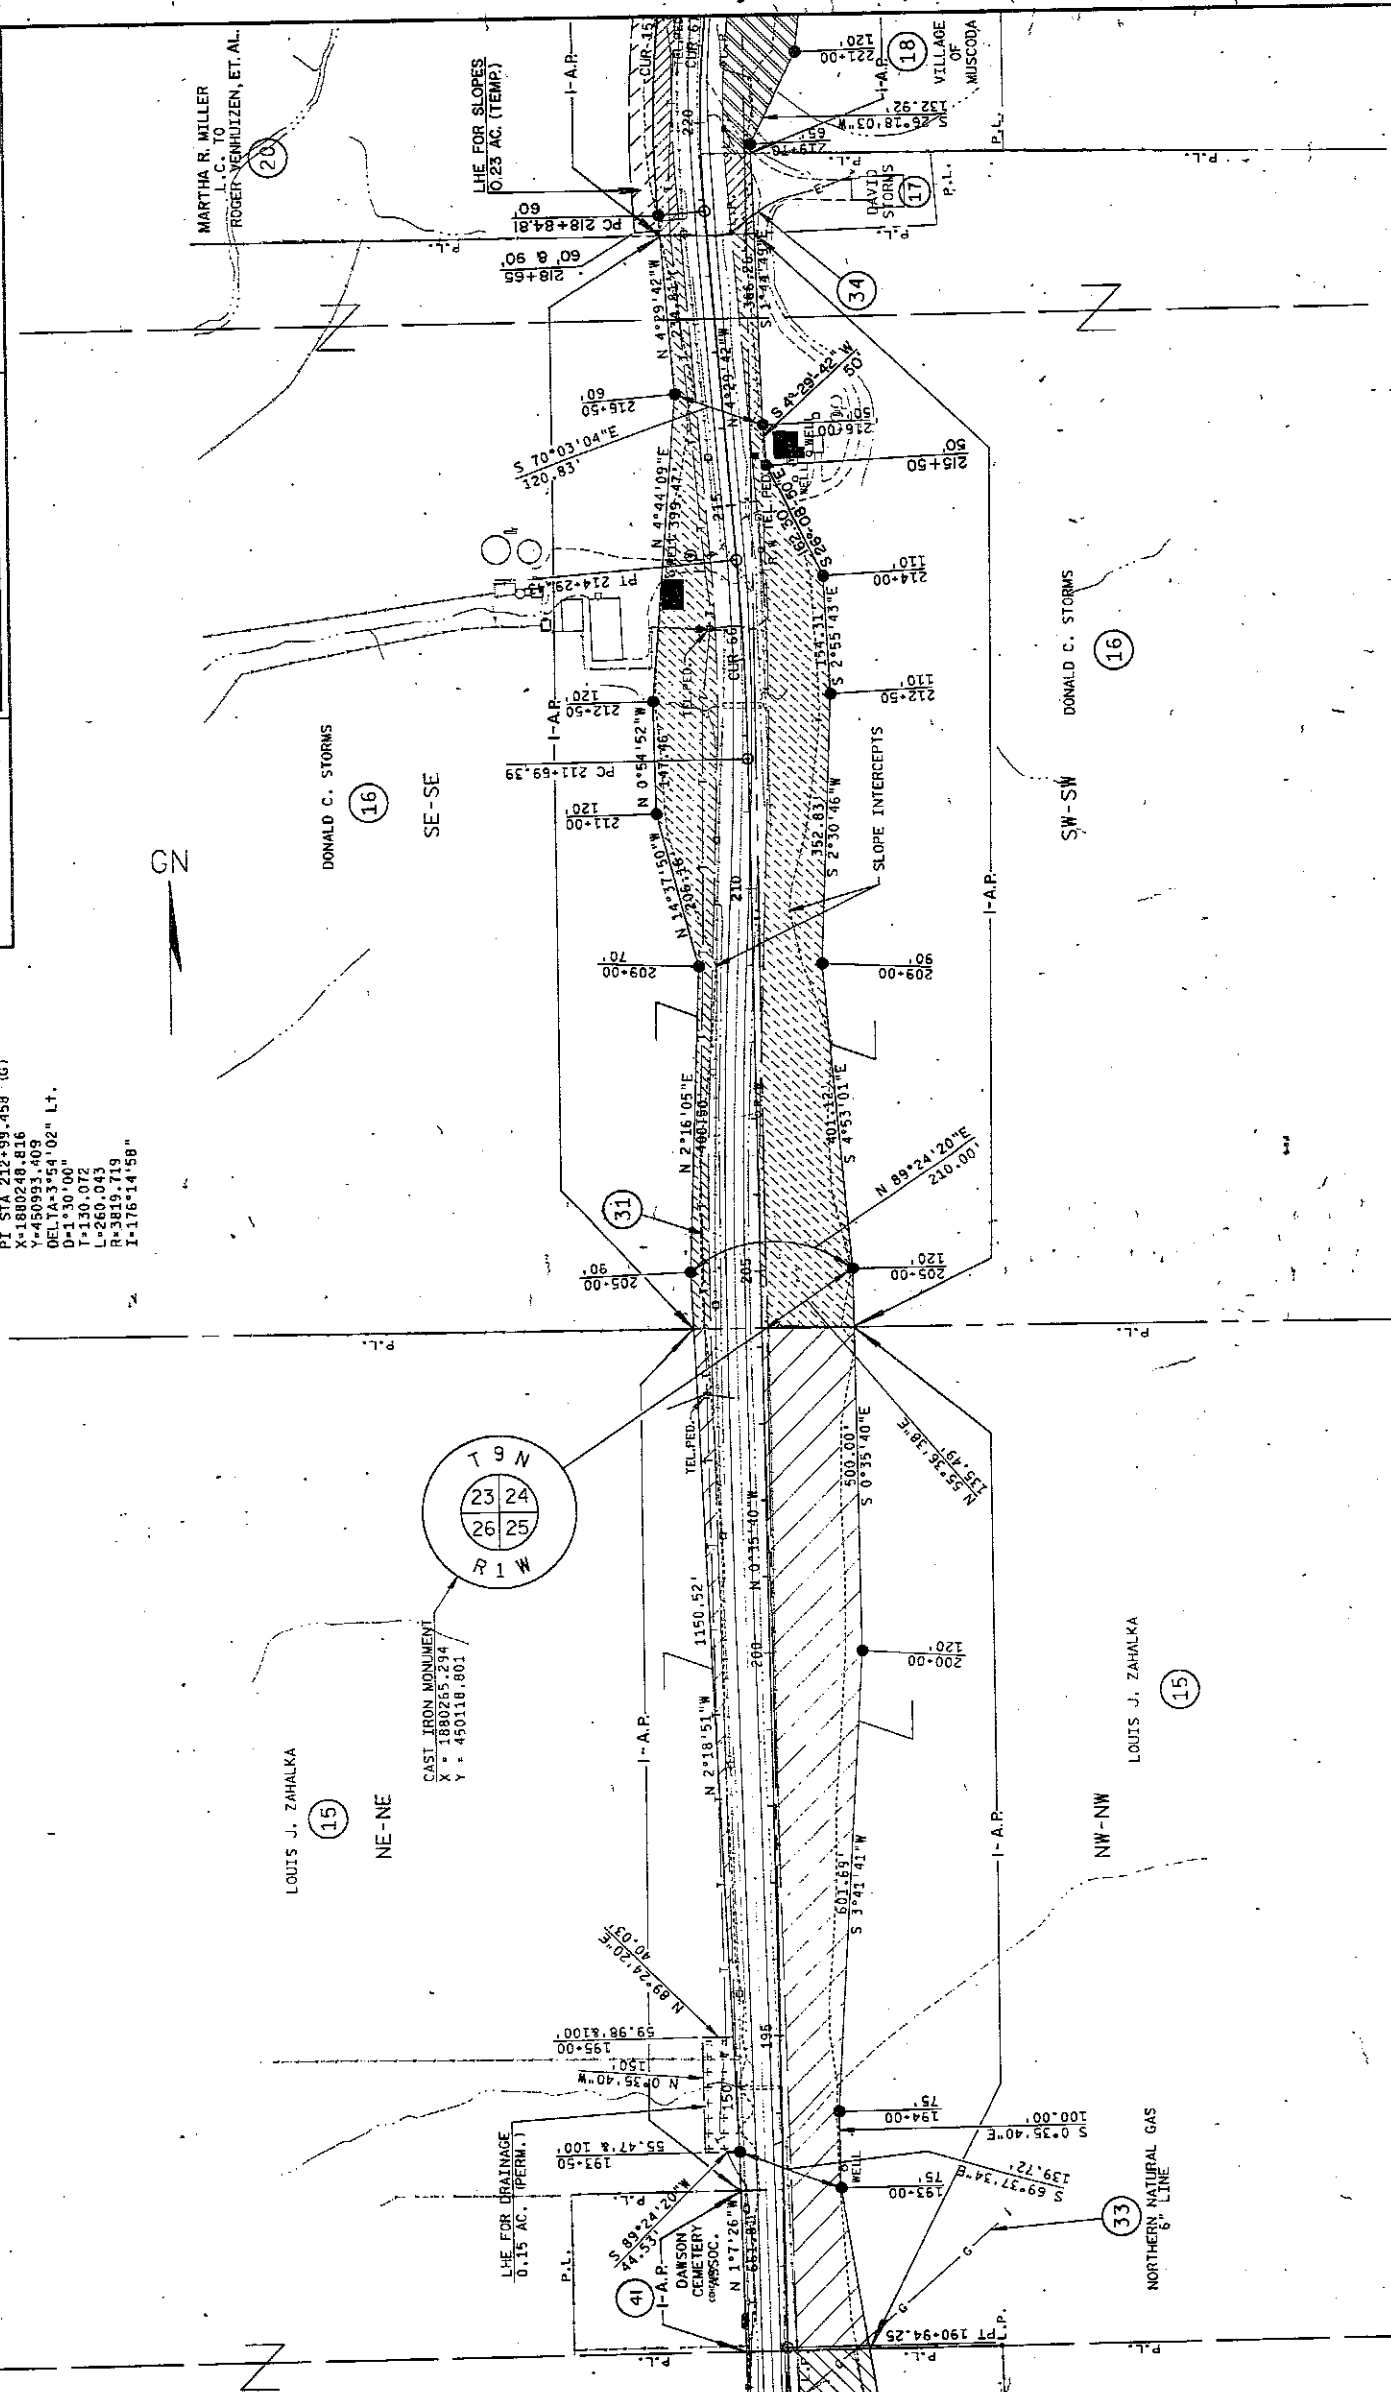


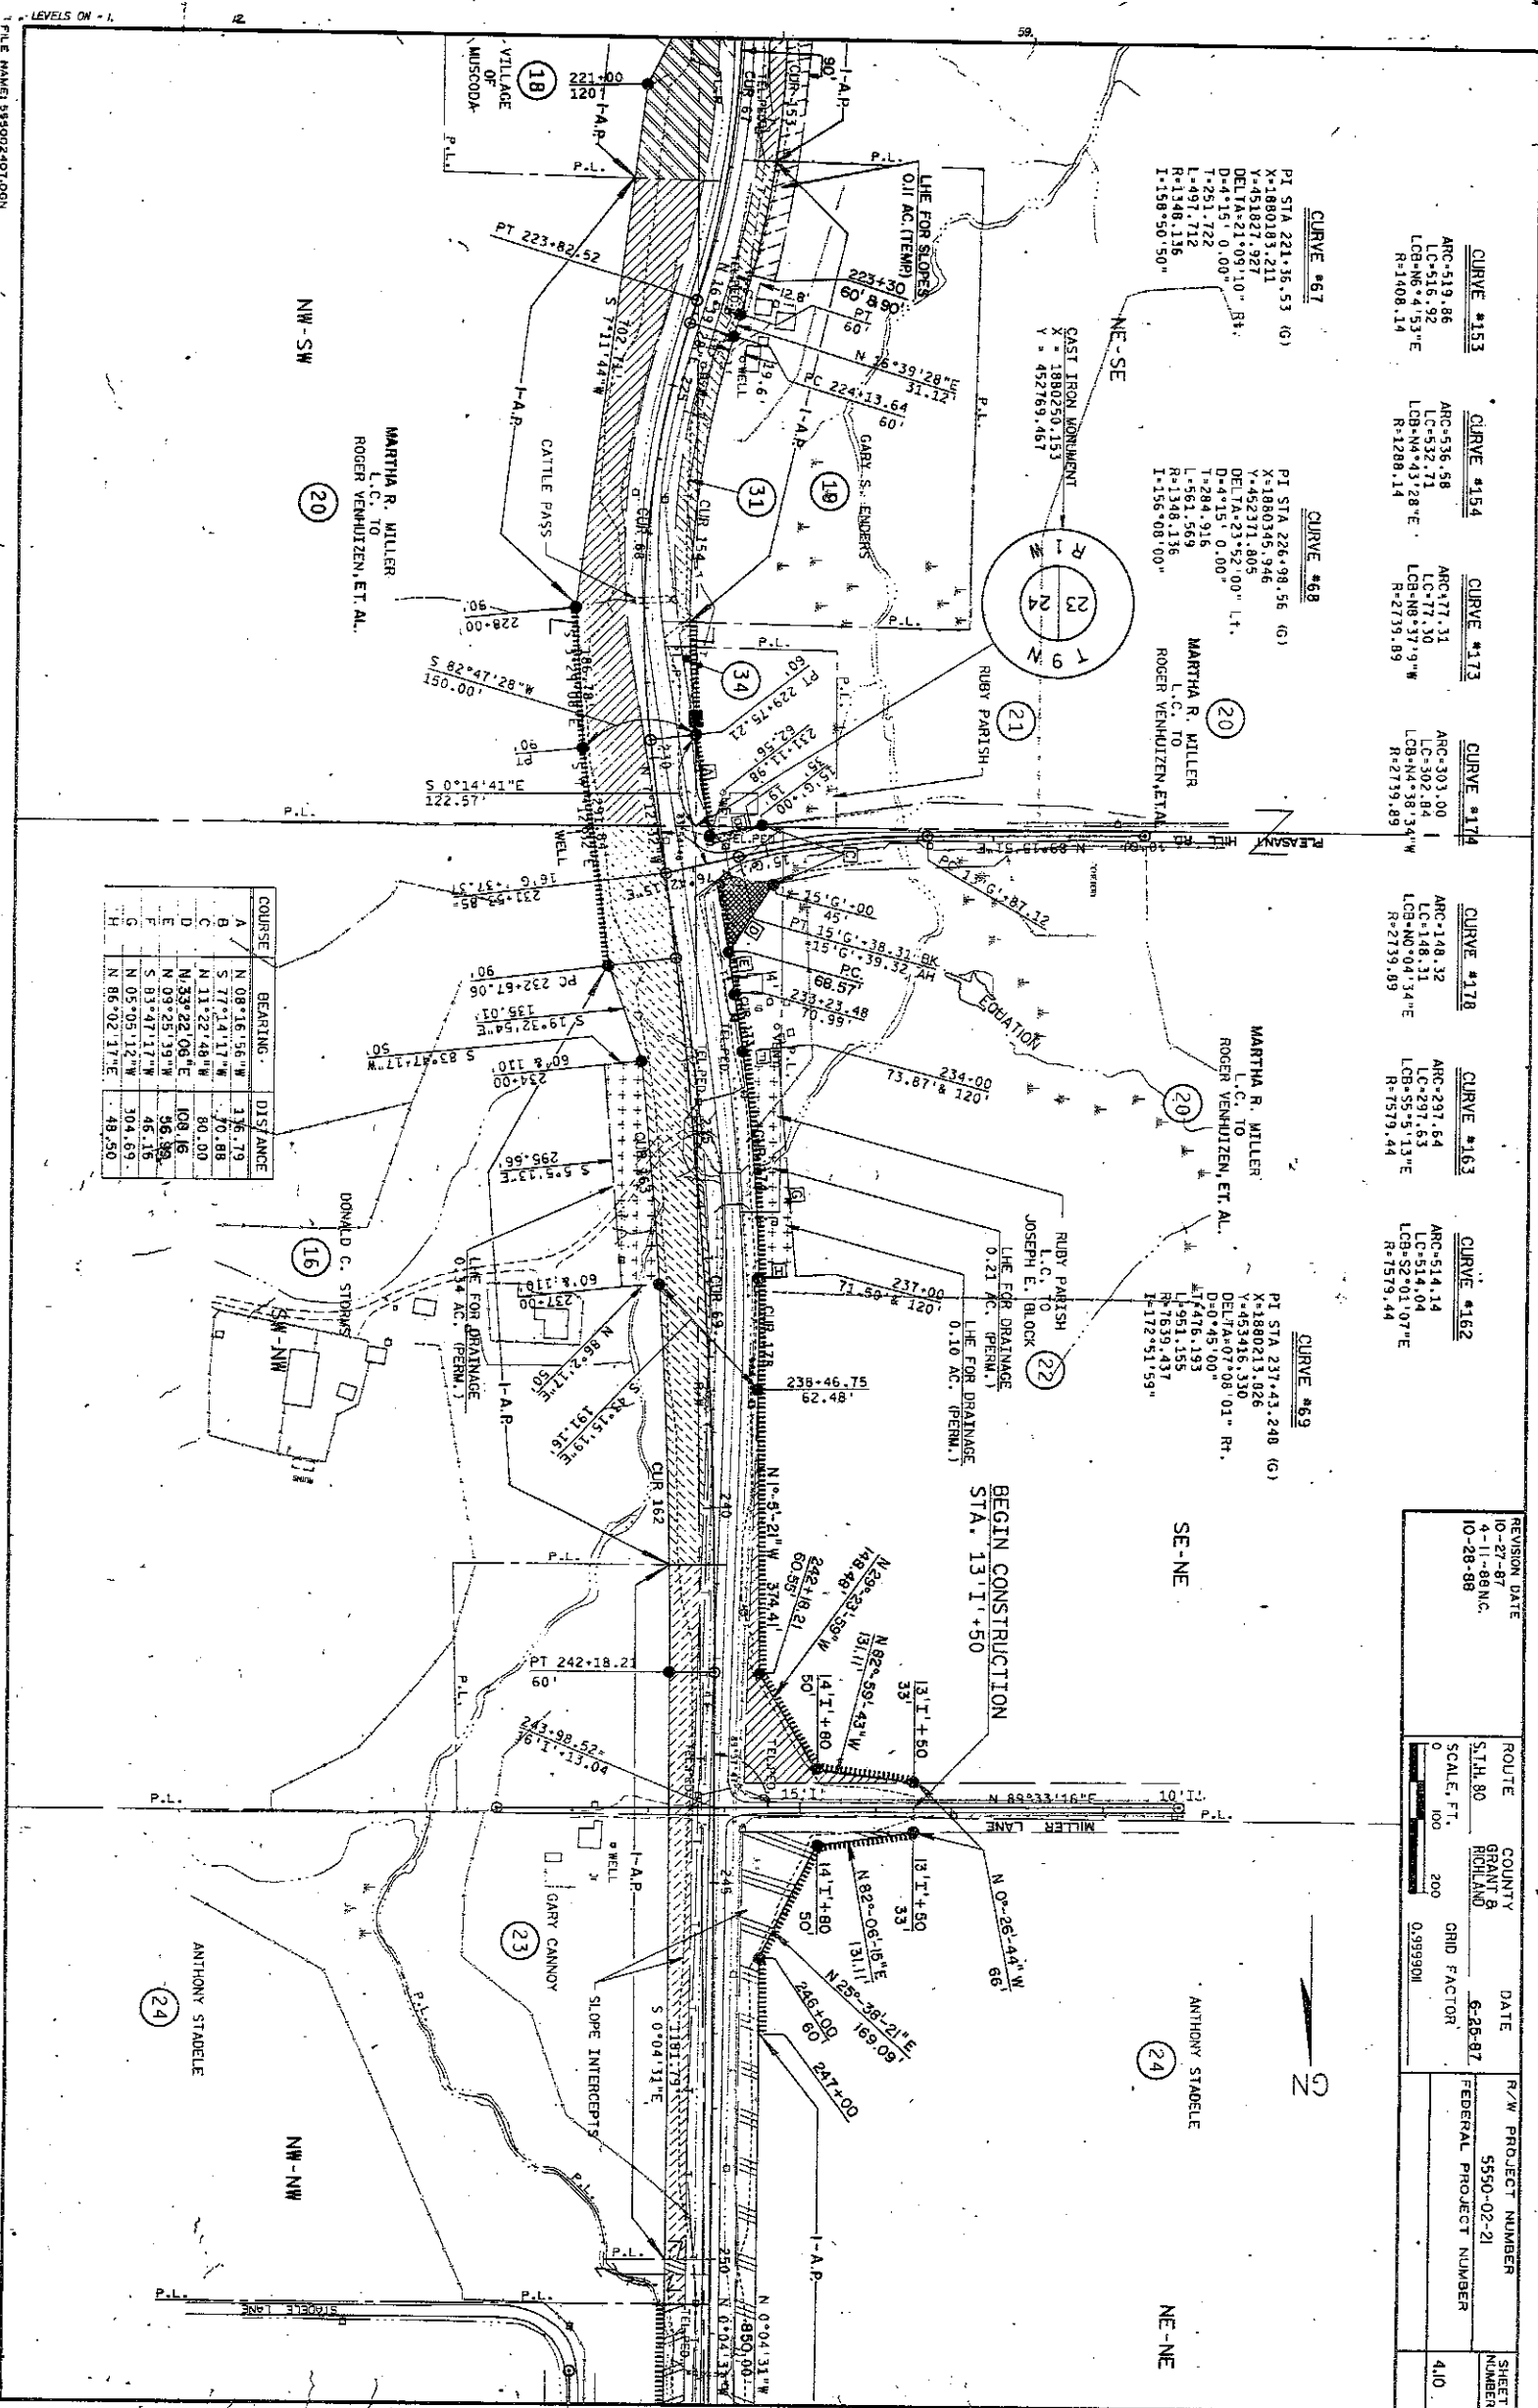

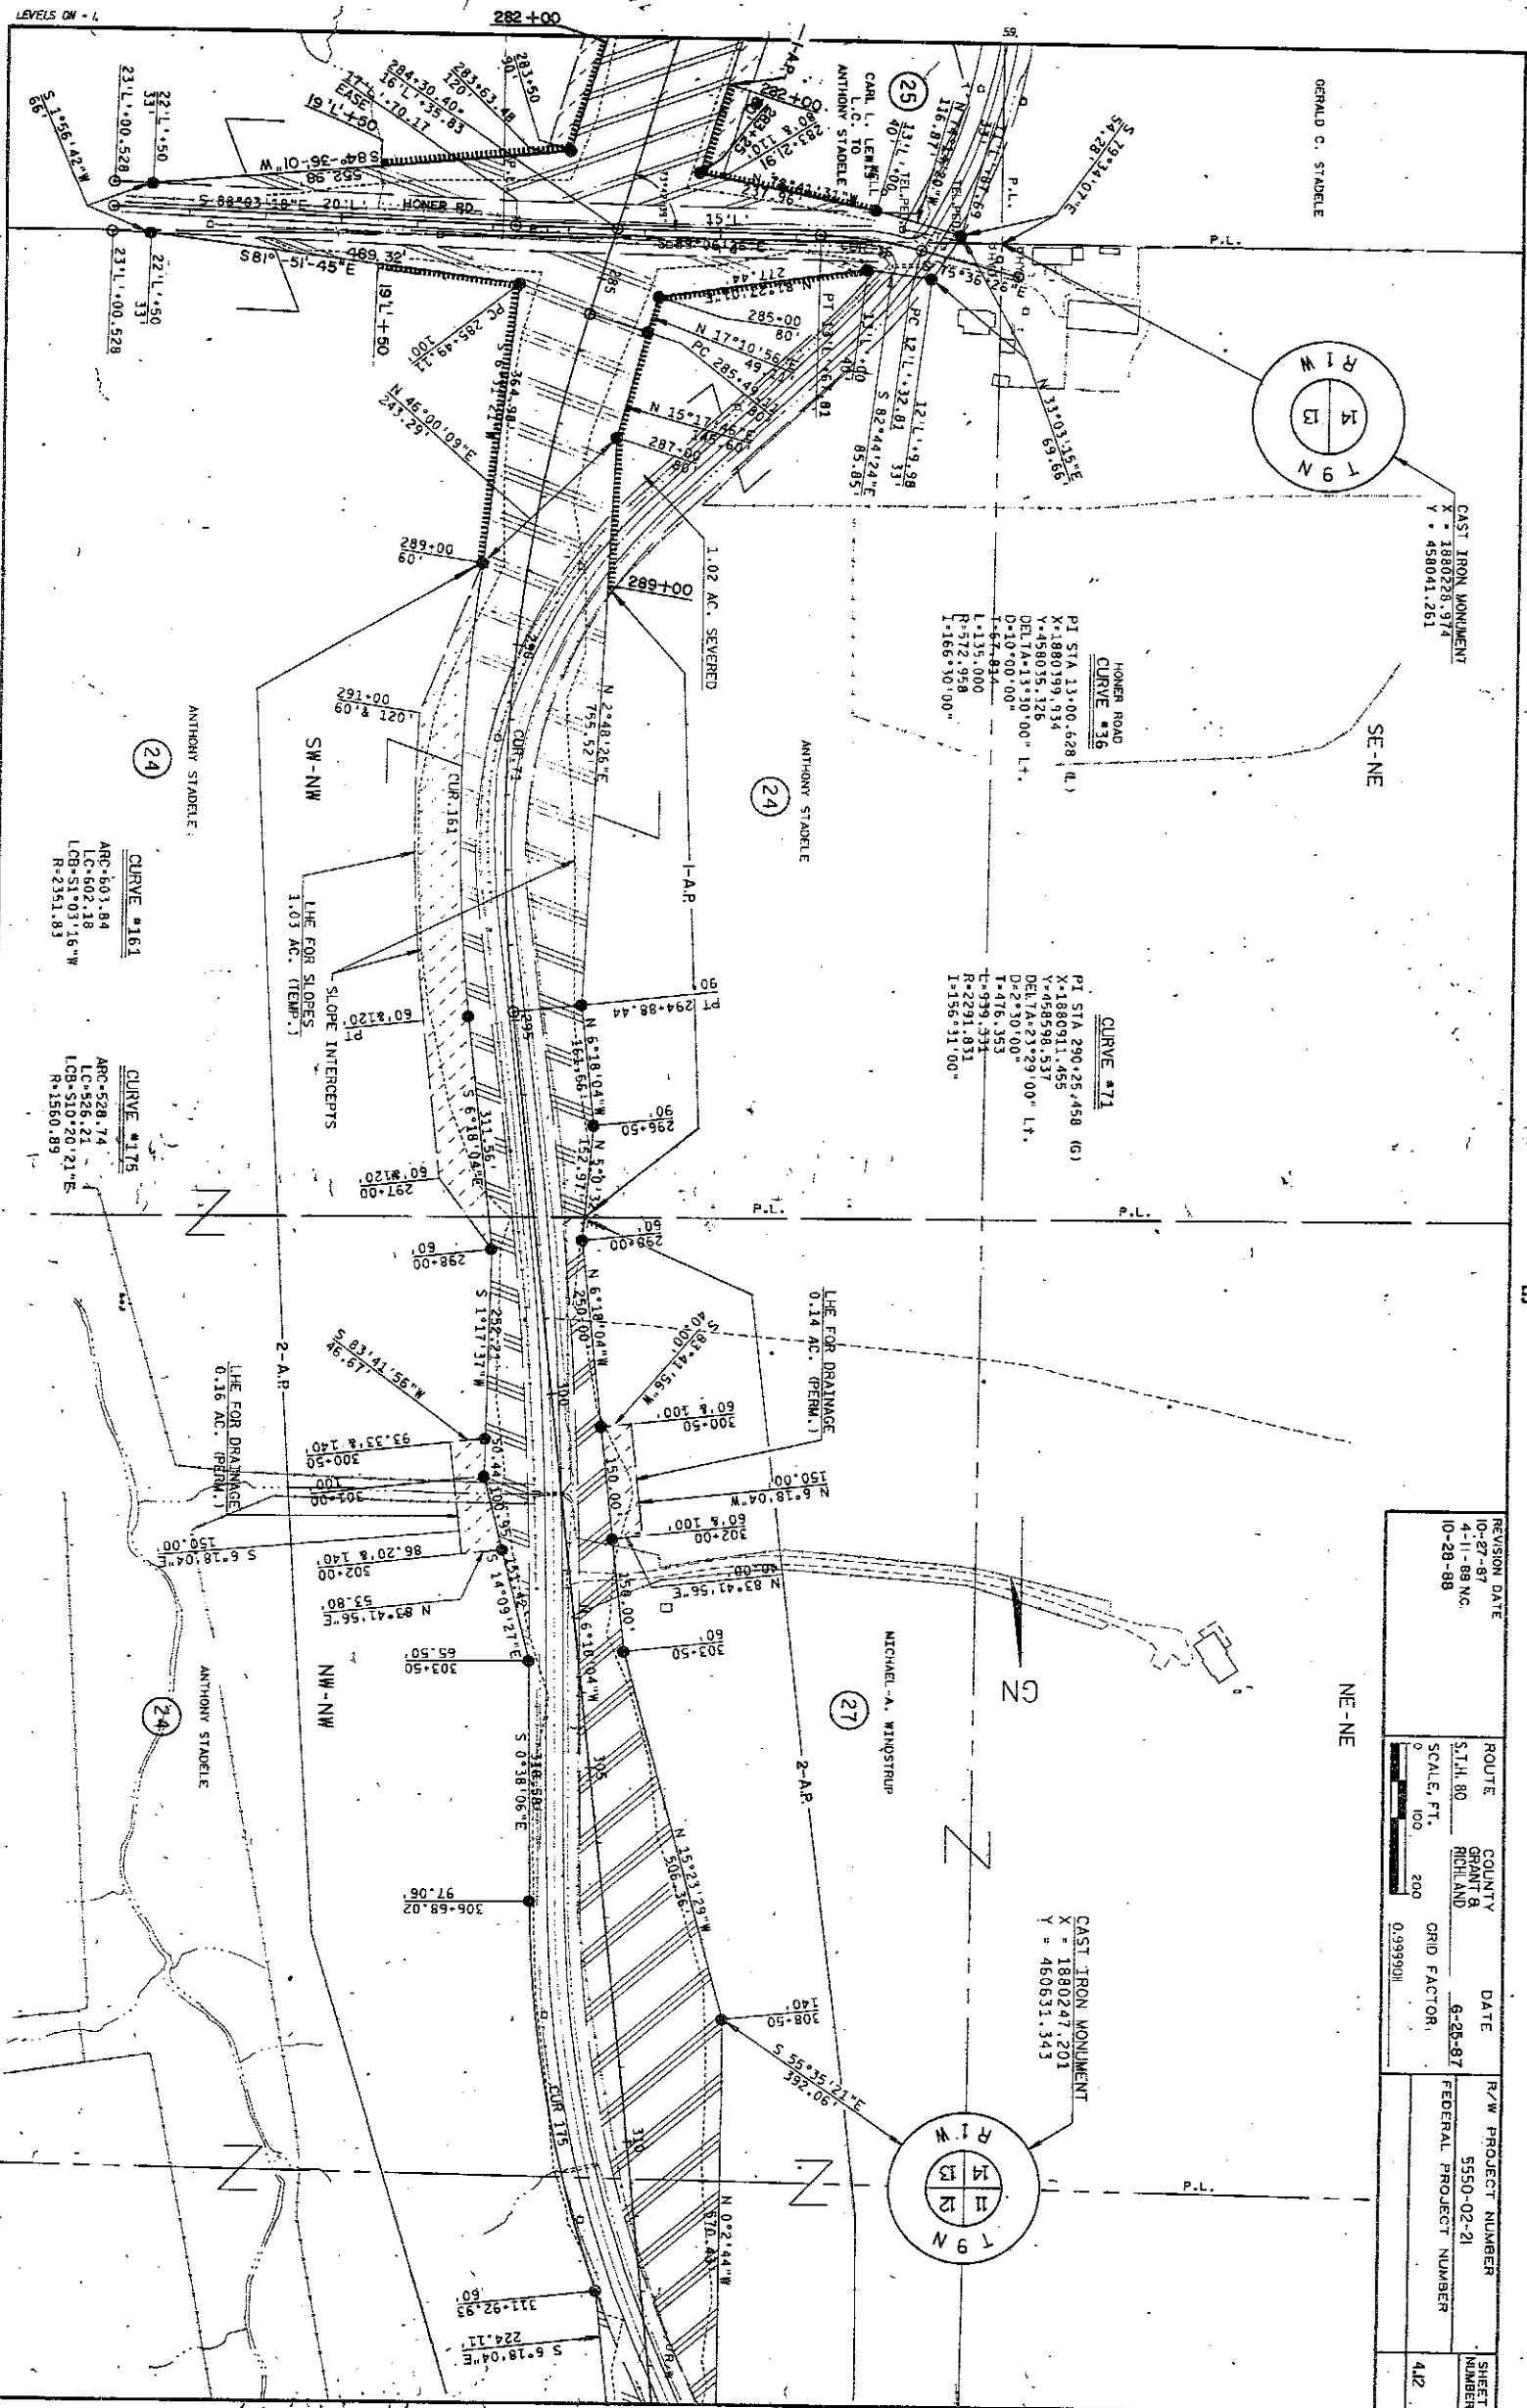

REVISION DATE	ROUTE	COUNTY	DATE	R/W PROJECT NUMBER	SHEET NUMBER
10-27-87	S.T.H. 80	GRANT & RICHLAND	6-26-87	5550-02-21	412
4-11-88 N.C.	SCALE, FT.	GRID FACTOR,		FEDERAL PROJECT NUMBER	
10-28-88	0 100 200	0.9999001			

REVISION DATE: 10-27-87
 4-11-88 NC
 10-28-88 NC
 ROUTE: COUNTY GRANT B
 S.I.H. 80
 SCALE: FT. 100
 GRID FACTOR: 0.9993011
 R/W PROJECT NUMBER: 5550-02-2
 DATE: 6-25-87
 FEDERAL PROJECT NUMBER: 4J3
 SHEET NUMBER: 4J3

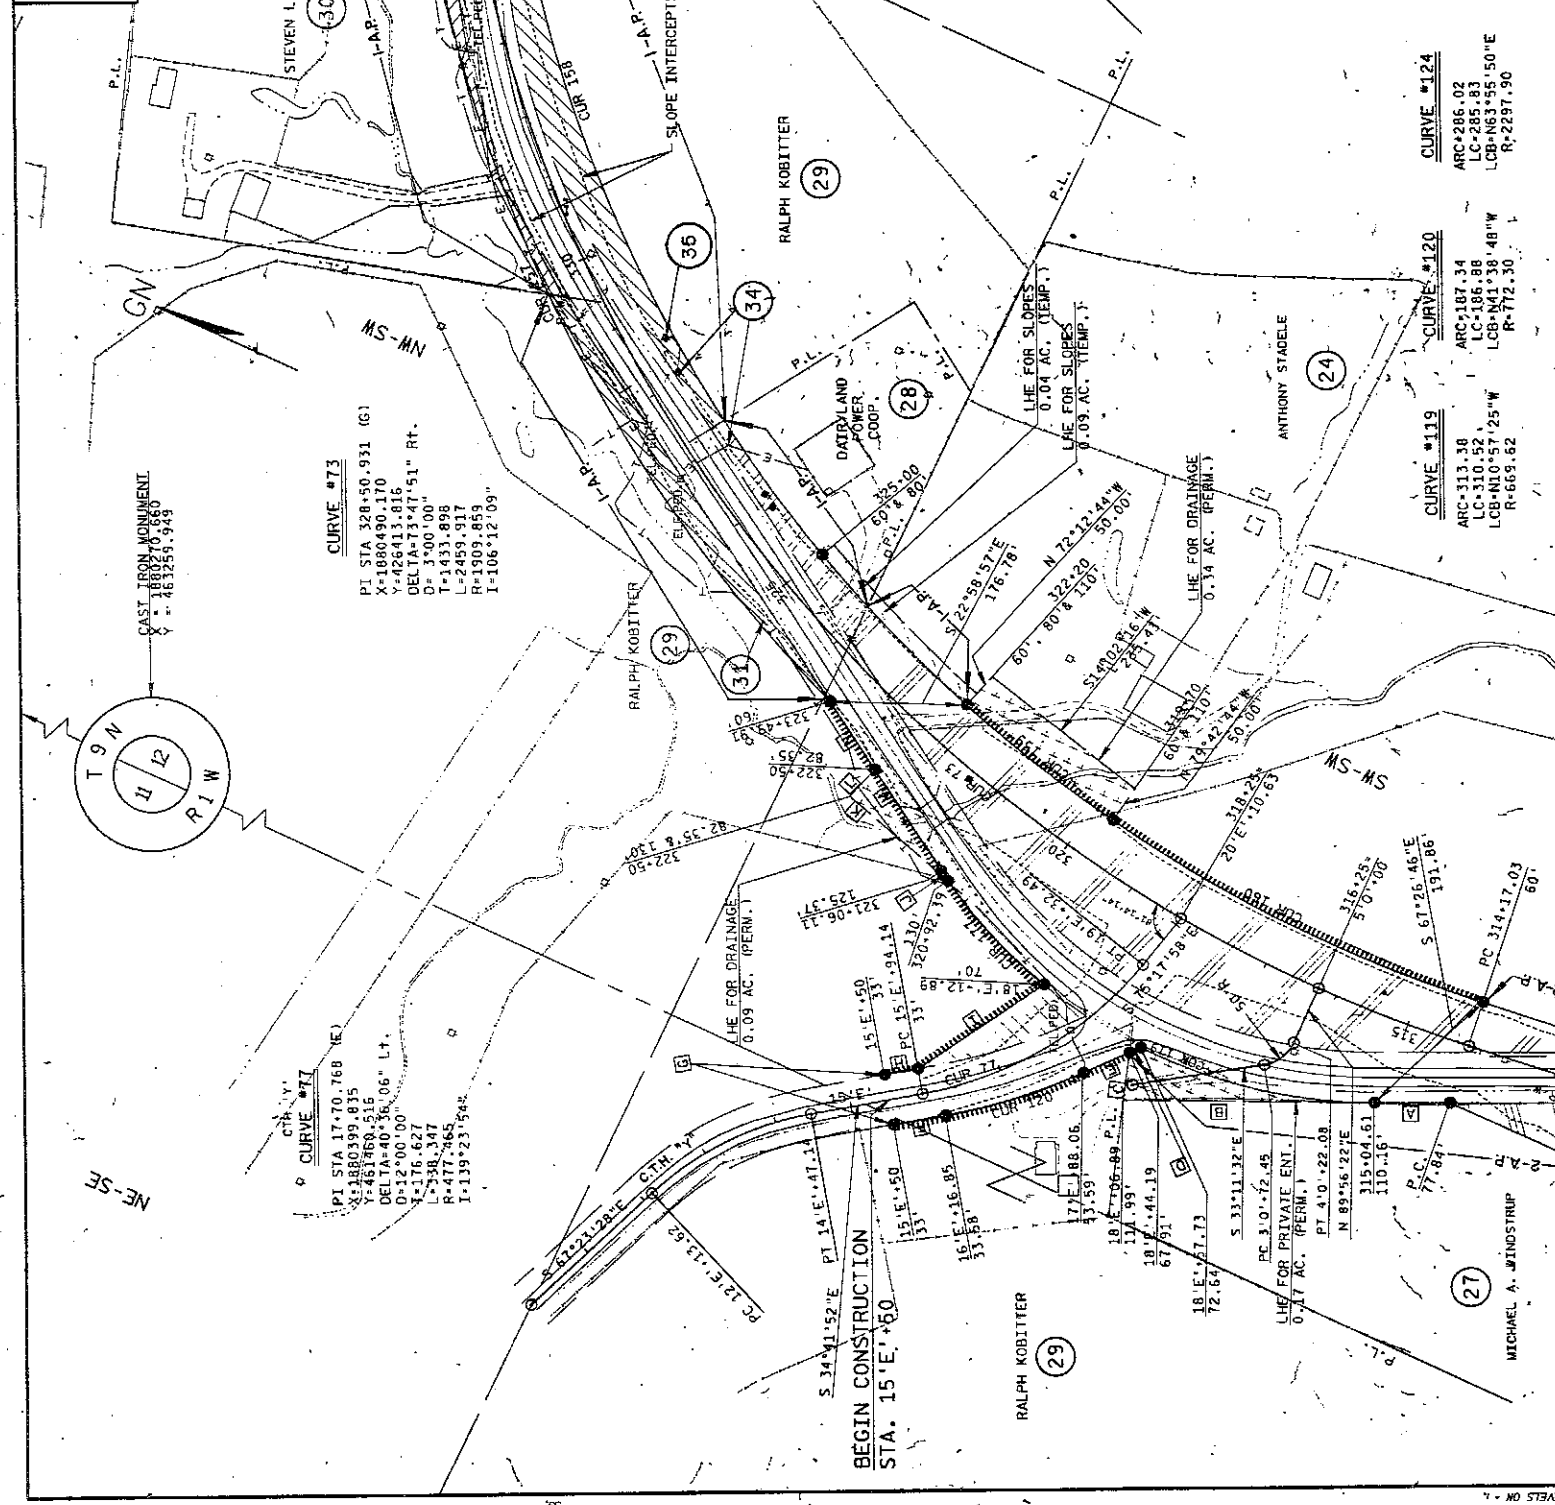

COURSE	BEARING	DISTANCE
A	N24°21'50"W	97.39
B	N23°46'31"W	324.57
C	N72°42'12"E	62.48
D	N48°35'45"W	16.24
E	N48°35'45"W	64.83
F	N34°41'52"W	68.44
G	N58°10'08"E	66.00
H	S34°41'52"E	44.14
I	S38°22'26"E	196.78
J	N18°41'53"E	15.36
K	N18°37'25"E	169.29
L	S71°10'44"E	47.63
M	N32°21'18"E	157.65
N	N32°21'18"E	106.00

- CURVE #177**
 ARC=184.43
 LC=183.85
 LCB=233°09'02"E
 R=669.62
- CURVE #160**
 ARC=535.60
 LC=231°37'19"W
 LCB=214°59'36"W
 R=1049.86
- CURVE #159**
 ARC=242.15
 LC=241°37'16"W
 LCB=214°59'36"W
 R=1049.86
- CURVE #158**
 ARC=1604.90
 LC=1555°03'
 LCB=514°2'16"W
 R=1849.86
- CURVE #157**
 ARC=1340.69
 LC=11314.36
 LCB=N41°10'58"E
 R=1969.86
- CURVE #124**
 ARC=286.02
 LC=285.83
 LCB=N63°55'50"E
 R=2297.90
- CURVE #120**
 ARC=187.34
 LC=186.88
 LCB=N41°38'48"W
 R=772.30
- CURVE #119**
 ARC=313.38
 LC=310.52
 LCB=N10°57'25"W
 R=669.62