



The State of Wisconsin

HIGHWAY COMMISSION

STATE OFFICE BUILDING

MADISON 2

August 22, 1951

Mr. Eugene Graft
Grant County Highway Commissioner
Lancaster, Wisconsin

Mr. Alonzo Aupperle
County Clerk, Grant County
Lancaster, Wisconsin

Gentlemen:

SUBJECT: Project S 0517(1)
Cuba City-Platteville Road
S.T.H. 80
Grant County

The Highway Commission deems it necessary to make certain revisions on a previously approved right-of-way plat and to acquire certain lands and interests in lands according to such revisions, for the proper improvement or maintenance of the above-designated project and highway. The revised relocation order of the Commission and the map showing the highway as laid out and established and the lands and interests to be acquired are transmitted herewith.

The enclosed relocation order provides that the county highway committee shall make the necessary acquisitions of lands and interests not previously acquired, pursuant to Section 84.09(3), Wisconsin Statutes.

Very truly yours

STATE HIGHWAY COMMISSION OF WISCONSIN


O. J. Hughes
Secretary

OJH:MC
CC: DE#9
WBB
Enc.

FILED

AUG 23 1951
ALONZO AUPPERLE
COUNTY CLERK
GRANT COUNTY, WIS.

RELOCATION ORDER
BY STATE HIGHWAY COMMISSION OF WISCONSIN

* * * * *

THE STATE HIGHWAY COMMISSION FINDS AND DETERMINES THAT:

The proper establishing, laying out, widening, enlarging, extending, constructing, reconstructing, improving, or maintaining a portion of the highway now designated as State Trunk Highway 80 from a point 1120 feet east and 1320 feet north of the south one-quarter corner of Section 25, Township 2 North, Range 1 West, thence north and northwesterly to a point 830 feet north and 215 feet west of the south one-quarter corner of Section 15, Township 3 North, Range 1 West,

and on roads or lands in and about and along and leading to same, requires certain relocation or change and the acquisition of lands or interests in lands as shown on the map or copy thereof marked

"PLAT OF RIGHT OF WAY REQUIRED, PROJECT S 0517(1),"

for the Cuba City-Platteville Road,

S.T. H. 80, Grant County, dated August 14, 1951,

the same being sheet No. 4, 4.1, 4.2, 4.3, and 4.4 of the plans for said project, and

Pursuant to its authority under Sections 84.02 (3) and 84.09, Wisconsin Statutes,

THE STATE HIGHWAY COMMISSION HEREBY ORDERS THAT:

(1) The said highway is hereby laid out and established to the lines and widths as shown on the said plat.

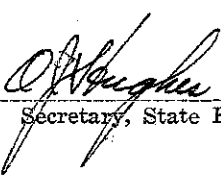
(2) The required lands or interests in lands as shown on the plat shall be acquired by the County Highway Committee of the county in which the lands are situate, pursuant to the provisions of Section 84.09 (3), Wisconsin Statutes. However, said County Highway Committee shall have no authority to settle or compromise any action or proceeding which might arise because of acts done by it in complying with this order, without prior written approval by the State Highway Commission.

(3) Buildings, fixtures or chattels acquired incident to the acquisition of lands or rights in lands under this order, and to be removed, shall, subject to approval of the Highway Commission, be sold by the County Highway Committee at public or private sale to the highest bidder, and the net proceeds of such sale paid into the state highway fund.

(4) This order supersedes and amends the previous order issued by the Commission on August 17, 1948.

* * * * *

The foregoing order was issued by the State Highway Commission and entered in the minutes of its meeting on August 21, 1951


 Secretary, State Highway Commission of Wisconsin

COUNTY AND SECTION					SHEET NUMBER		TOTAL SHEETS	
COUNTY	ROUTE AND SECTION	CLASS AND AGREEMENT	DATE	FEEDBACK	WIS. DIV.	BN	4	128

PLAT FOR 0517(1)

SCHEDULE OF LANDS AND INTERESTS REQUIRED			ACRES	
PAR. NO.	OWNER	INTERESTS REQUIRED		
1	OTTO WEBER, JR.	HIGHWAY EASEMENT	0.13	
2	EDWARD HARTUNG	"	0.32	
3	CYRIL P. BYRNE	"	1.29	
4	T. F. BANFIELD, EST.	"	0.07	
5	LORAINE BODDEN	"	1.49	
6	WM. BANFIELD, EST.	"	7.00	
7	GRVILLE M. KETTLER	"	2.84	
8	ISABEL MCNETT	"	1.67	
9	JOHN KETTLER, EST.	"	1.43	
10	HARRY KUHL	"	2.22	
11	JOHN KETTLER, EST.	"	1.49	
12	ERNEST DE BUIR	"	0.95	
13	FRITZ VOLGITS	"	1.55	
14	ELSON ANDERSON	"	1.44	
15	ANTON YONDR	"	2.16	
16	ERNEST R. RASQUE	"	3.82	
17	FRANK BOLDT	"	2.32	
18	JOHN WEIGEL	"	2.18	
19	HENRY G. WEIGEL	"	3.72	
20	ELMER WEIGEL	"	5.70	
21	GUERDON T. SHERWIN	"	2.27	
22	HENRY G. WEIGEL	"	3.53	
23	ALBERT RIEGE	"	2.72	
24	EMERY BELLMAYER	"	0.47	
25	ARTHUR W. GORE	"	5.12	
26	FRANK BELLMAYER	"	6.14	
27	NORMAN MASK	"	0.57	
28	C. & NW. RR.	"	1.205	



STA. 488+50.8
END OF RELOC. ORDER
PROJ. S 0517(1)

STA. 0+0.017
BEG. OF RELOC. ORDER
PROJ. S 0517(1)

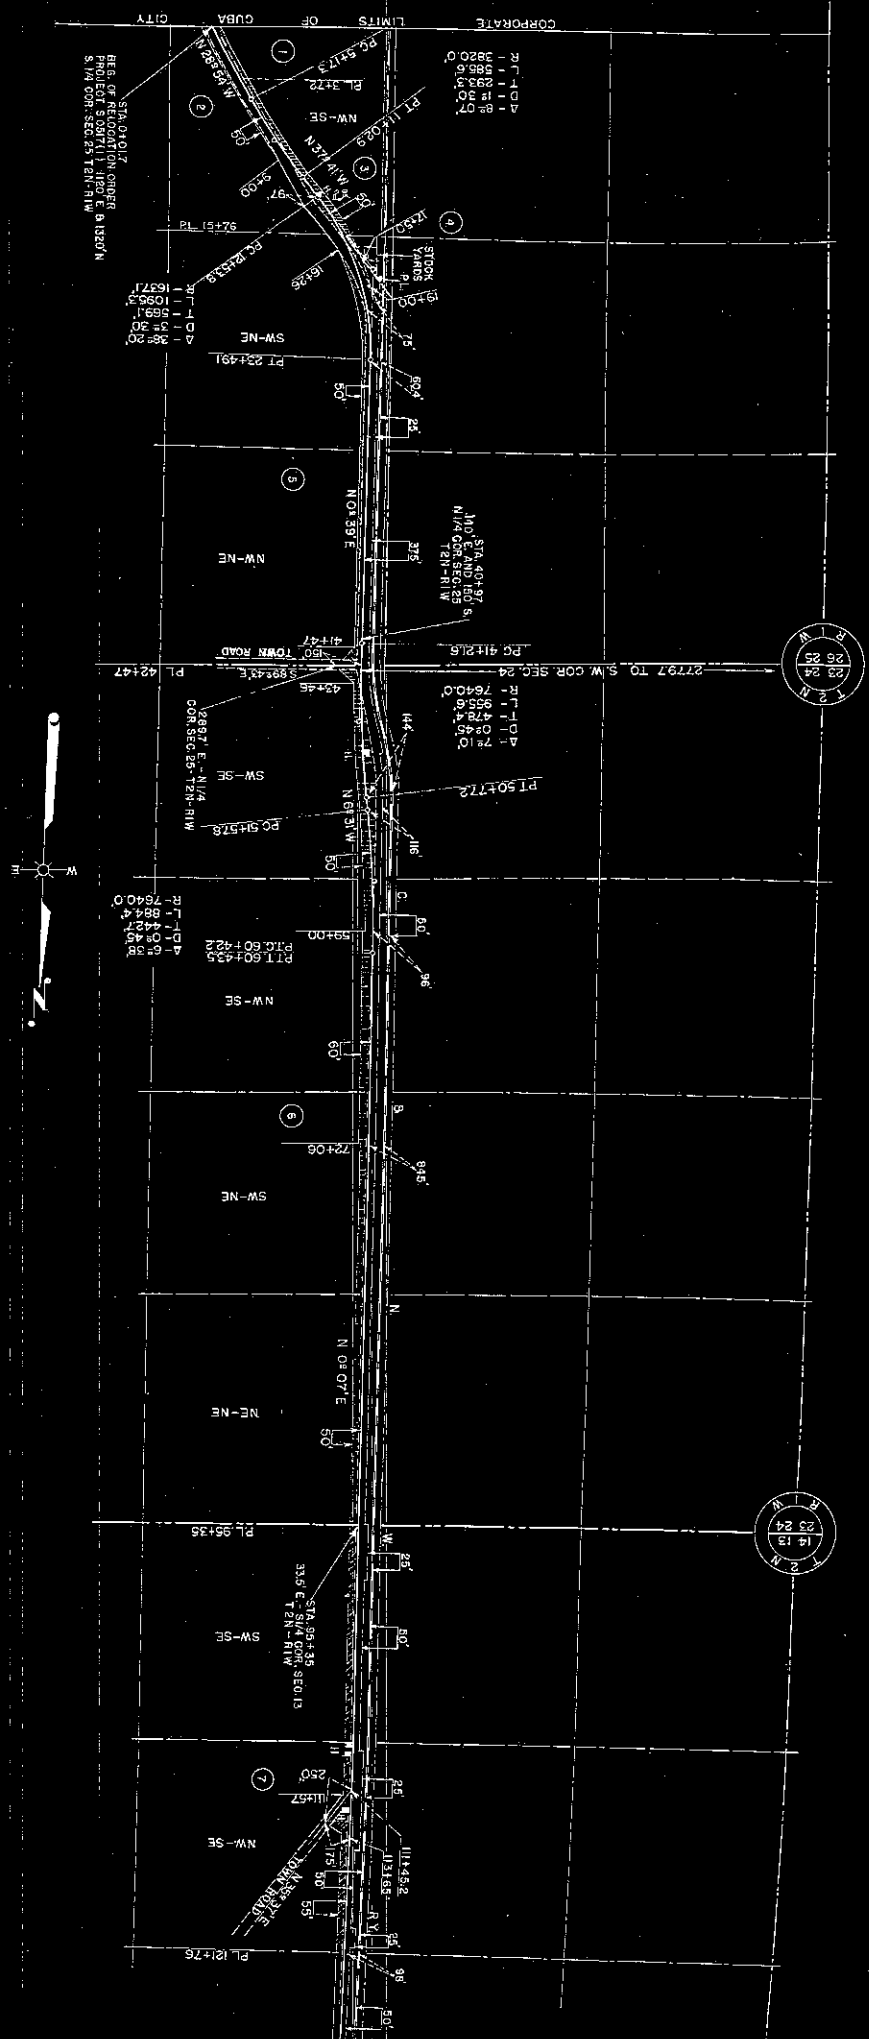
STATE HIGHWAY COMMISSION OF WISCONSIN
PLAT OF RIGHT OF WAY REQUIRED
PROJECT S 0517(1)

CUBA CITY — PLATTEVILLE ROAD
S.H. NO. 80 GRANT COUNTY

SCALE 1" = 1 MILE
AUG. 14, 1981
AUG. 11, 1981
DATED APRIL 1, 1981

PROJ. ETS (217)

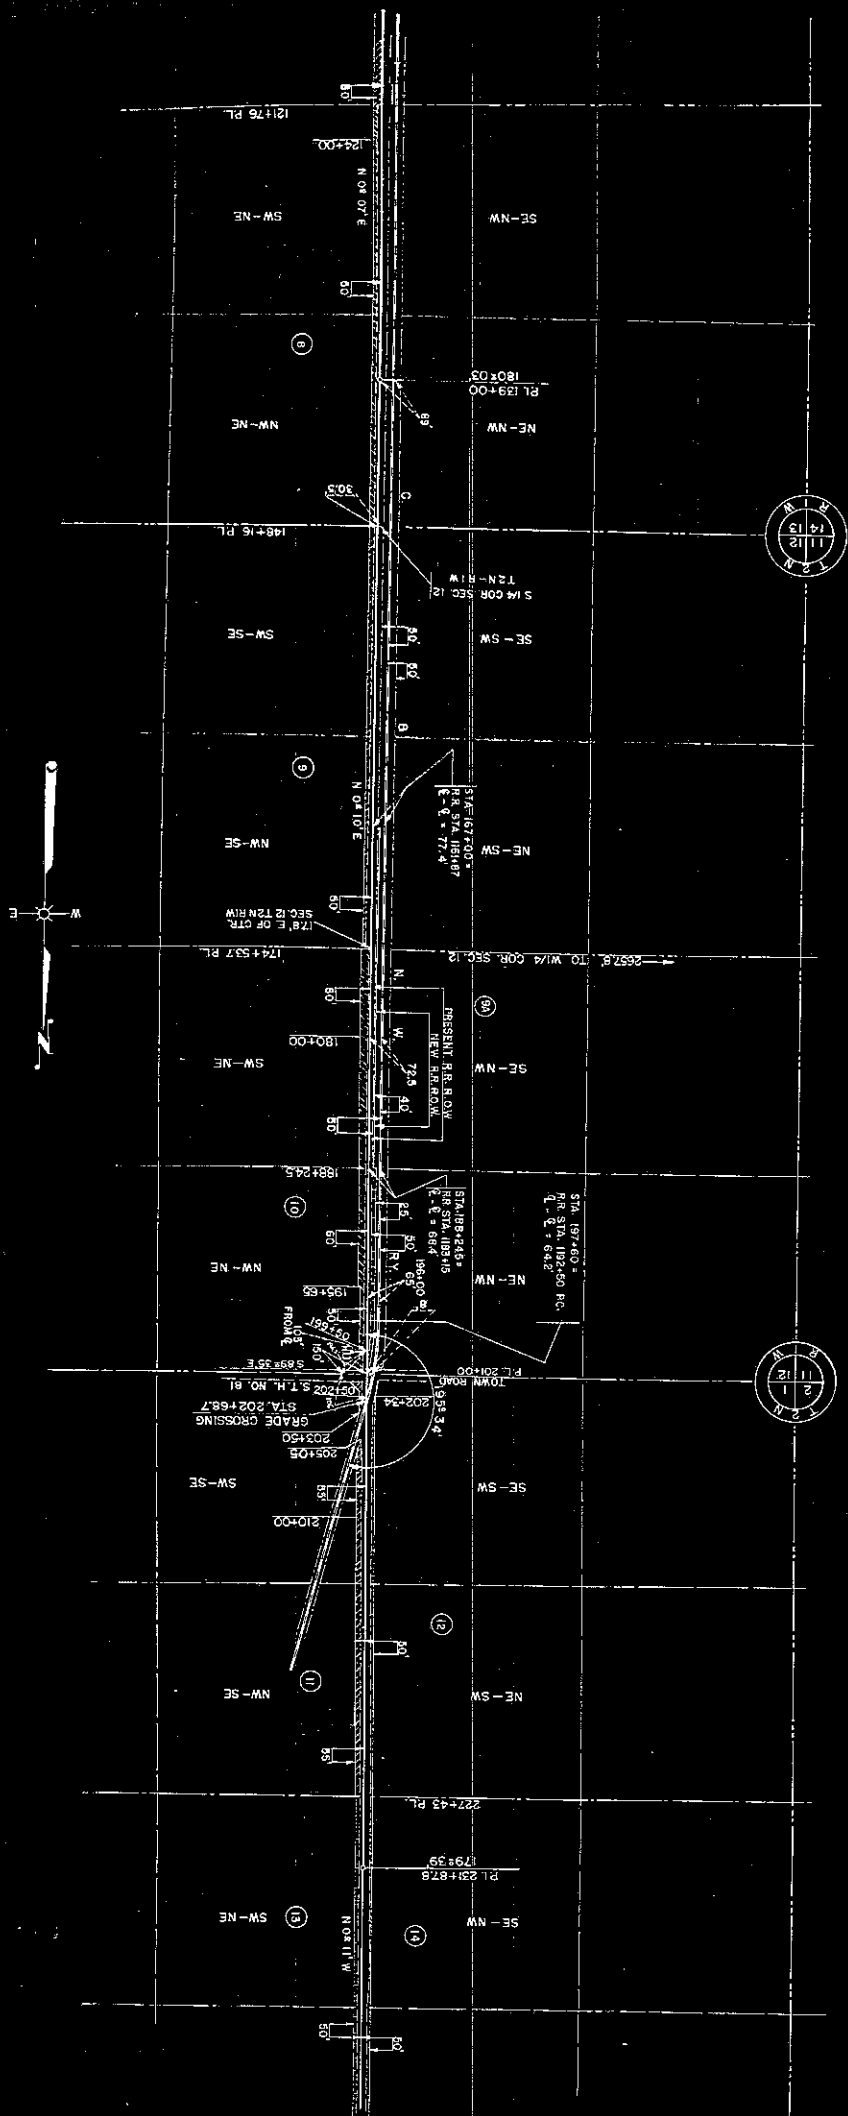
COUNTY	ROUTE	CLASS AND AMENDMENT	PERMANENT	WIS.	4.1	128
HIGHWAY	SECTION	STATE	PERMANENT	OFFICE	NUMBER	TOTAL
				SN		SHEETS



STATE HIGHWAY COMMISSION OF WISCONSIN
 PLAT OF RIGHT OF WAY REQUIRED
 PROJECT S 0517(1)
 CUBA CITY — PLATTEVILLE ROAD
 S.H. NO. 80 GRANT COUNTY
 SCALE 1" = 400'
 LENGTH 8.873 MILES
 AUG. 14, 1991
 AUG. 11, 1948
 DATE APRIL 1, 1948

PROV. FAS. 95(711)					
COUNTRY	ROUTE	CLASS AND DESCRIPTION	FEDERAL	FEDERAL DOWNS	TOTAL SHEETS
AND TERRITORY	NO.	STATE		WIS.	
				5N	
					42
					128

PEOL EAS 051711)

STATE HIGHWAY COMMISSION OF WISCONSIN
PLAT OF RIGHT OF WAY REQUIRED

PROJECT 5 0517(1)

CUBA CITY — PLATTEVILLE

S.T.H. NO. 80

GRANT

ROAD
COUNTY

MIG. 14, 1951

LENGTH • 8.873 MILES

SCALE
0 200 400 600
AUG. 14, 1951
AUG. 11, 1944
DATED APRIL 1, 1948



PROJ. FNS 0517(1)

STA. 468+50.9
END OF RELOC. ORDER
PROJ. S 0617 (1)
830' N. & 215' W. OF S 1/4 COR.
SECTION 15, T3N-R1W

STATE HIGHWAY COMMISSION OF WISCONSIN
PLAT OF RIGHT OF WAY REQUIRED
PROJECT S 0517(1)
CUBA CITY — PLATTEVILLE
S.H. NO. 80 GRANT COUNTY

LENGTH = 0.873 MILES

0 200 400 800

NO. 14,507
AUG. 11, 1948
DATED APRIL 1, 1948