



State of Wisconsin \ DEPARTMENT OF TRANSPORTATION



DIVISION OF HIGHWAYS AND
TRANSPORTATION FACILITIES

P. O. Box 7916
Madison, WI 53707

August 3, 1979

Mr. Nelson Huske, Commissioner
Grant County Highway Department
P.O. Box 150,
1011 N. Adams Street
Lancaster, Wisconsin 53813

Ms. Dorothy Eck
Grant County Clerk
Courthouse, Box 191
Lancaster, Wisconsin 53813

Dear Sir and Madame:

Project 1208-0-21 F 012(8)
Dubuque - Dickeyville Road (City Island Bridge Approach)
U.S.H. 151
Grant County

The Department of Transportation deems it necessary to make certain revisions on a previously approved right of way plat and to acquire certain lands and interests in lands, according to such revisions, for the proper improvement or maintenance of the above-designated project and highway. The revised relocation order of the Department and the map showing the highway as laid out and established and the lands and interests to be acquired are transmitted herewith.

The enclosed relocation order provides that the necessary acquisitions of lands and interests not previously acquired shall be made by the Division of Highways and Transportation Facilities, pursuant to Section 84.09(1) or (2), Wisconsin Statutes.

Sincerely,

H. L. Fiedler
Administrator

HLF:bjm
Enc.

CC: DD# 1
R/E

CONVENTIONAL SIGNS


STATE LINE	-----	HIGHWAY HIGHWAY SEPARATION	=====	CEMETERY FOUNDATION	⊞
COUNTY LINE	-----	HIGHWAY OVERPASS	=====	GAS PUMP ISLAND BUILDING	⊞
TOWNSHIP AND RANGE LINES	-----	* RAIL LINE OVERPASS	=====	IRON PIN	⊞
SECTION LINE	-----	ALL OTHER BRIDGES	=====	POWER POLE	⊞
QUARTER LINE	-----	STREAM OR RIVER	=====	TELEPHONE POLE	⊞
SIXTEENTH LINE	-----	LAKE	=====	RAIL LINE	=====
NEW CENTERLINE	-----	CATTLE PASS	=====	TRANSMISSION TOWER AND LINE	=====
OLD R/W LINE	-----	* TRAVELED WAY (Shown only in area of Frontage Roads, Interchanges or Dual Lanes)	=====	UNDERGROUND CABLE MARKER	=====
PROPERTY LINE	-----	NO ACCESS	=====	WELL	⊞
CORPORATE LIMITS	-----			STONE MONUMENT	⊞
NO ACCESS (ACQUISITION)	-----			SEPTIC TANK	⊞
* LIMITED HIGHWAY EASEMENT (Shading omitted on Aerial Halftones)	-----			WINDMILL	⊞
				R/W POINT	⊞
				R/W MONUMENT	⊞

STANDARD ABBREVIATIONS

ALUMINUM MONUMENT	ALUM. MON.
PROPERTY LINE	P.L.

BEGIN RELOCATION ORDER PROJECT 1208-0-21
 FEDERAL PROJECT F02181
 STA. 97+99.07
 Y 193,071.43
 X 1,834,620.67
 671.07' S, 82.472' 98" E. of the W. 1/4 Cor.,
 Sec. 28, T.1N, R.2W

END RELOCATION ORDER PROJECT 1208-0-21
 FEDERAL PROJECT F02181
 STA. 104+63.17
 Y 193,730.98
 X 1,834,728.38
 11.54' S, 82.550' 69" E. of the W. 1/4 Cor.,
 Sec. 28, T.1N, R.2W

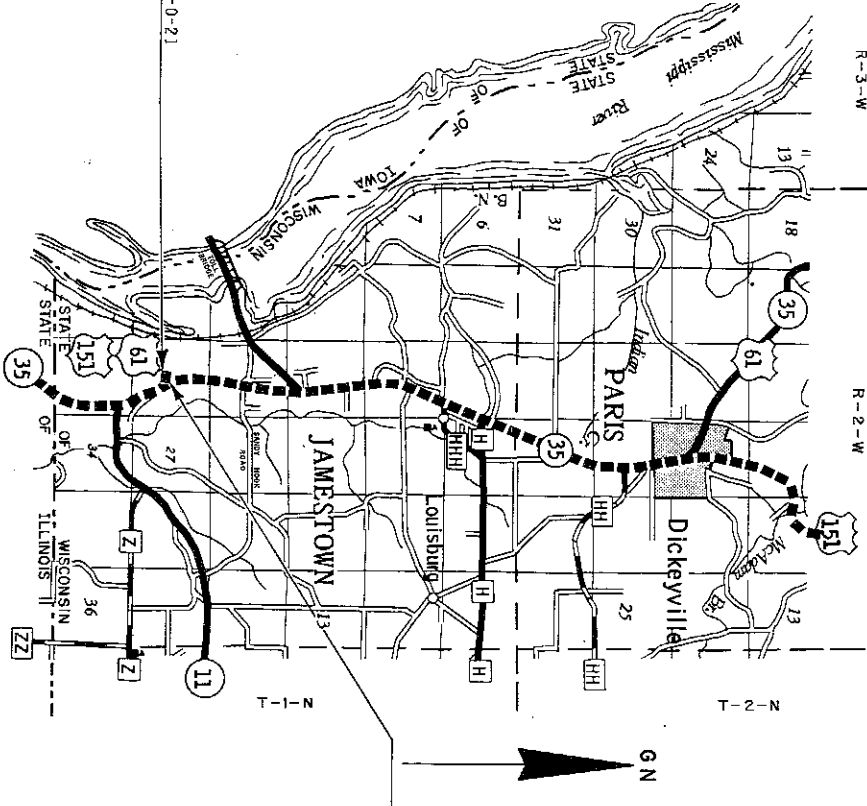

LAYOUT SCALE



TOTAL NET LENGTH OF CENTERLINE = 0.126 MILES

All coordinates shown on this plat are referenced to the WISCONSIN COORDINATE SYSTEM SOUTH ZONE.

1/4 PROJECT NUMBER 1208-0-21		SHEET NUMBER 4.0		TOTAL SHEETS 8	
FEDERAL PROJECT NUMBER F 02181		PLAT OF RIGHT OF WAY REQUIRED FOR 1208-0-04 DUBOUCHE - DICKEYVILLE ROAD (CITY ISLAND BRIDGE APPROACH)			
U.S.H. 151		GRANT COUNTY			
CONSTRUCTION PROJECT NUMBER		PARCEL NO. 20			
SHEET NO. 4.6		OWNER Telegraph Herald, Inc.			

REVISION DATE	STATE OF WISCONSIN DEPARTMENT OF TRANSPORTATION DIVISION OF HIGHWAYS
APPROVED: _____ DATE: _____	Director, Bureau of Right of Way
APPROVED: _____ DATE: _____	Chief of Facilities Development
APPROVED: _____ DATE: _____	Director, Bureau of Right of Way
APPROVED: _____ DATE: _____	U.S. DEPARTMENT OF TRANSPORTATION FEDERAL HIGHWAY ADMINISTRATION REGION 5 WISCONSIN DIVISION

SCHEDULE OF LANDS AND INTERESTS REQUIRED

PARCEL SHEET	OWNER	INTEREST REQUIRED	L.H.E.	R/W ACRES REQ'D.	TOTAL ACRES REQ'D.	TOTAL OPERATIONS PROJECT NUMBER
20	4, 6 TELEGRAPH HERALD, INC.	5.30	0.08	5.38	4.61	1208-0-40

BEARING ORIENTATION AND GRID CONVERSION
 COORDINATE SYSTEM WITH O DEGREES, O MINUTES, O SECONDS BEING GRID NORTH, THE DIFFERENCE BETWEEN PROJECT PLAT BEARINGS REPRESENT PLANE ANGLES IN DEGREES, MINUTES AND SECONDS TO THE NEAREST SECOND. R/W PLAT DISTANCES ARE GRID LENGTHS UNLESS OTHERWISE NOTED AND MAY BE CONVERTED TO GRID LENGTHS BY MULTIPLYING PLAT DISTANCES BY 1.00002

TELEGRAPH HERALD INC., PURCHASE OPTION
 RECORD # 1978
 MAR 24 1978
 VOL. 536 RECORDS, P. 626
 DOC. # 468982



REVISION	DATE	R/W PROJECT NUMBER	SHEET NUMBER
		-1208-0-21	46

FEDERAL PROJECT NUMBER: F 012(9)

PLAT OF RIGHT OF WAY REQUIRED FOR
DUBUQUE - DICKEYVILLE ROAD
 (CITY ISLAND BRIDGE APPROACH)
 U.S.H. 161
 SCALE: 200 FT. AUGUST 22, 1978
 CONSTRUCTION PROJECT NUMBER: GRANT COUNTY GATE

PL. = 111 + 71.99
 Y 194,434.94
 X 1,834,791.33
 I = 183°-02'-02"
 A. = 3°-02'-02"
 D. = 1°-30"
 T. = 101.16'
 L. = 202.26'
 E. = 1.34'
 R. = 3,819.72'

END RELOCATION ORDER, PROJECT 1208-0-21
 FEDERAL PROJECT F012(9)
 STA. 104+63.17
 STA. 97+93.07
 X 1,834,791.33
 Y 194,434.94
 I = 183°-02'-02"
 A. = 3°-02'-02"
 D. = 1°-30"
 T. = 101.16'
 L. = 202.26'
 E. = 1.34'
 R. = 3,819.72'

BEGIN RELOCATION ORDER, PROJECT 1208-0-21
 FEDERAL PROJECT F012(9)
 STA. 97+93.07
 STA. 97+93.07
 X 1,834,791.33
 Y 194,434.94
 I = 183°-02'-02"
 A. = 3°-02'-02"
 D. = 1°-30"
 T. = 101.16'
 L. = 202.26'
 E. = 1.34'
 R. = 3,819.72'

