


PLAT OF SURVEY

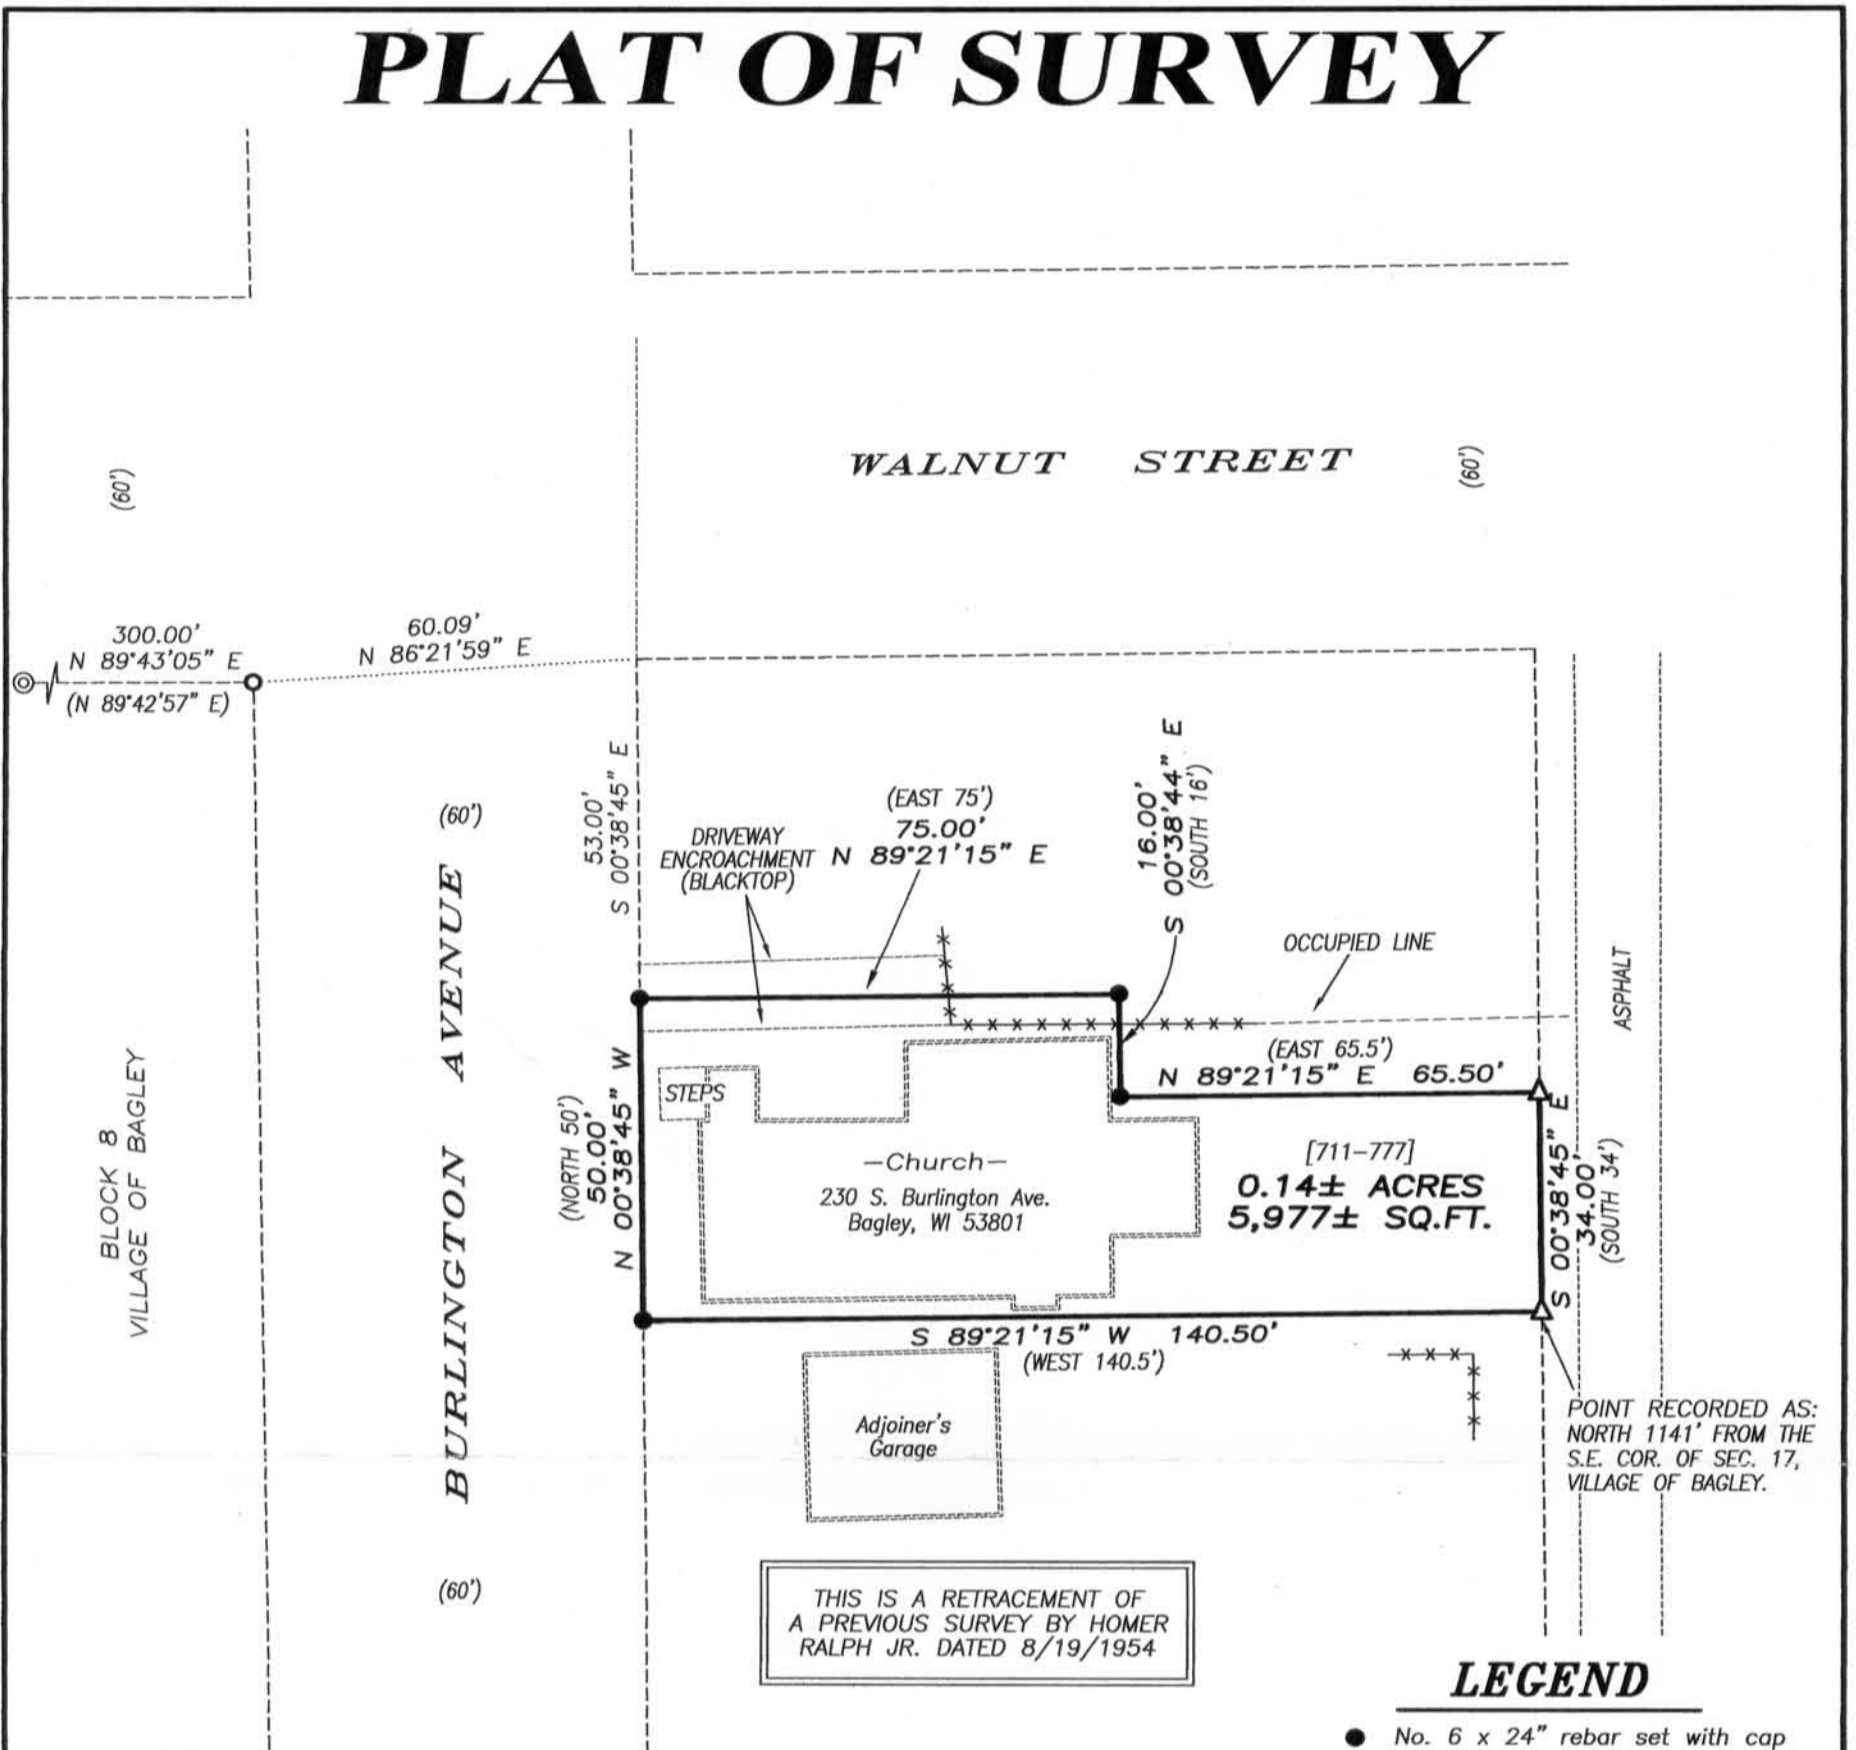

DESCRIPTION PROVIDED:

Property described in Quit Claim Deed recorded in Volume 711, Page 777 as Document No. 559423, Grant County Registry and being described as follows:

The following Tract in the Village of Bagley, Grant County, WI, described as follows:

Begin at a point which is 1141 feet North of the Southeast corner of Section 17, Town Five (5) North, Range Six (6) West of the 4th P.M. in Grant County, WI, thence West 140.5 feet, thence North 50 feet, thence East 75 feet, thence South 16 feet, thence East 65.5 feet, thence South 34 feet to the place of beginning.

SURVEYOR'S CERTIFICATE:

I, Aaron J. Austin, Registered Wisconsin Land Surveyor, hereby certify:

That the above description was surveyed, mapped and monumented as shown on this plat by me or under my direct supervision.
That conformance with local ordinances are not guaranteed with this survey.
That this survey was prepared under the instructions of Alma Nolan.
That to the best of my knowledge and belief, this plat is an accurate representation thereof.
That all plans that do not show a seal imprint in red ink may contain unauthorized alterations.
The certification contained on this document shall not apply to any copies.

Dated this 17th day of March, 2011.

Aaron J. Austin
Aaron J. Austin, S-2922
LANCASTER WI

SURVEYOR'S NOTES:


Surveyor has made no investigation for easements of record, encumbrances, restrictive covenants, ownership title evidence except as specifically shown on this plat. No distance should be assumed by scaling. No improvements have been located unless shown and noted. No representation as to ownership, use or possession should be hereon implied. Refer to abstract, title or local ordinances for any additional restriction, easements or building setback lines. No abstract, nor title commitment, nor results of title searches were furnished the surveyor.

LEGEND

- No. 6 x 24" rebar set with cap
- ▲ 1" diameter iron pipe found
- No. 6 rebar found
- ⊙ 1/4" Drill hole found
- () Recorded as
- [-] Property described in Volume and Page, Grant County Registry
- *** Approximate fence location



The North line of Block 8, Village of Bagley is assumed to bear N 89°43'05" E.

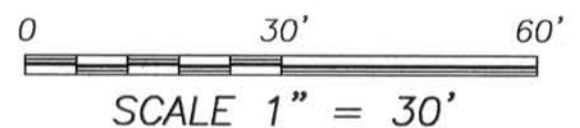

Prepared for: ALMA NOLAN

Austin Engineering LLC
austinengineeringllc.com
4211 HWY 81 E, LANCASTER, WI 53813
PHONE: 608-723-6363 FAX: 608-723-6702

JOB NO: 11s020
G:\T5NR6W\17MG
H:\PLAT\BAGLEY\11s020-NOLAN

FIELDBOOK: TDSR
DRAWN BY: AJ AUSTIN
CREW: BS-SA-BD