



# PLAT OF SURVEY

## DESCRIPTION PROVIDED:

Beginning 660 feet East and 90 feet South of the Northeast corner of Block 7 of the Original Plat of the Village (now City) of Fennimore, Grant County, Wisconsin, according to the recorded map or plat thereof;

thence East 120 feet;

thence South 90 feet;

thence West 120 feet;

thence North 90 feet to the place of beginning.

Said lands also described as Outlos One Hundred Thirteen (113) and One Hundred Fourteen (114) of the Assessment Plat of the City of Fennimore, Grant County, Wisconsin, according to the recorded map or plat thereof.

## SURVEYOR'S CERTIFICATE:

I, Aaron J. Austin, Registered Wisconsin Land Surveyor, hereby certify:

That the above description was surveyed, mapped and monumented as shown on this plat by me or under my direct supervision.

That conformance with local ordinances are not guaranteed with this survey.

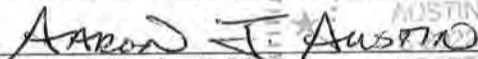
That this survey was prepared under the instructions of Sharlene Templin.

That to the best of my knowledge and belief, this plat is an accurate representation thereof.

That all plans that do not show a seal imprint in red ink may contain unauthorized alterations.

The certification contained on this document shall not apply to any copies.

Dated this 7th day of September, 2011.

  
Aaron J. Austin, S-2922



## SURVEYOR'S NOTES:

Property described in a Warranty Deed recorded in Volume 1166, Page 650 as Document No. 706781, Grant County Registry. No improvements have been located unless shown and noted. No representation as to ownership, use or possession should be hereon implied. Refer to abstract, title or local ordinances for any additional restriction, easements or building setback lines. No abstract, nor title commitment, nor results of title searches were furnished the surveyor.



Austin  
Engineering LLC  
austinengineeringllc.com

4211 HWY 81 E, LANCASTER, WI 53813  
PHONE: 608-723-6363 FAX: 608-723-6702

Prepared for: SHARLENE TEMPLIN

JOB NO: 11s190  
G:\FENNMORE\FENNMORE  
H:\PLAT\FENNMORE\OUTLOT\11s190-TEMPLIN

FIELDBOOK: TDSR  
DRAWN BY: AJ AUSTIN  
CREW: BS-SB

SHEET 2 OF 2