

Broadway Street Remonumentation Map



Surveyor's Notes:

- Surveyor has made no investigation with regard to the correctness or accuracy of the found monumentation.
- Existing Monuments that were not disturbed during construction are not shown on this map.

Node ID	Previous Monument
52268	#6_IB
52269	#6_IB
52270	1" IP_LEAN(S)
52272	#6_IB
52273	1" IB
52275	PK
52276	1" IB
52277	1" IP
52285	1" IP
52289	#6_IB

I, Stanley J. King, Registered Wisconsin Land Surveyor, do hereby certify:

That monuments described on this map were reset under my direct supervision and at the direction of the City of Platteville. The purpose of this monumentation was to reset any existing monuments along Broadway Street that were disturbed during construction completed in 2014. Monuments found and reset have not been checked for correctness in relation to property lines and right-of-way.


Dated this 24th day of April, 2015.

Stanley J. King
Stanley J. King, S-2001



Legend

- Set No. 6 x 18" rebar - wt = 1.50 #/l.f.
- Set Brass Stem Marker in Concrete
- [500] Street Address

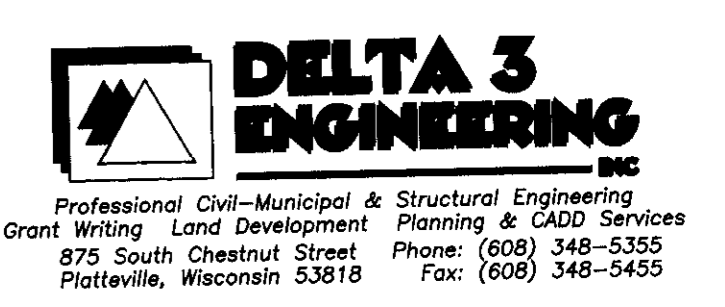

Project No: D12-006-2
Date: November 25th, 2014
Drawn by: LAR