

MORTGAGE INSPECTION

PREPARED FOR:
MIDWEST TITLE CORP.
129 S. JEFFERSON ST.
LANCASTER, WI

CASE # 1384

STATEMENT REGARDING WORK TO BE DONE: AS CLIENT(S) OF BRUCE D. BOWDEN, WISCONSIN LAND SURVEYOR, I/WE HEREBY REQUEST THAT THE SURVEY BE MADE ACCORDING TO THE FOLLOWING SPECIFICATIONS:

1. ONLY ENOUGH WORK BE PERFORMED TO SATISFY THE REQUIREMENTS OF BANKERS MORTGAGE CO.
2. NO STAKES BE SET TO MARK THE CORNERS OF THE PARCEL.
3. THE EXACT LENGTH AND BEARING OF THE BOUNDARIES OF THE PARCEL NEED NOT BE SHOWN.
4. MEASUREMENTS NEED NOT BE TAKEN AS SPECIFIED IN A-E 5.01(6) OF THE WISCONSIN ADMINISTRATIVE CODE. IT IS SPECIFICALLY INTENDED TO EXEMPT THIS SURVEY FROM THE REQUIREMENTS OF A-E 5.01(5)(C) & (D) AND A-E 5.01(6) OF THE WISCONSIN ADM. CODE.

Bruce D. Bowden

DATE 1-20-87

DESCRIPTION:

COMMENCING AT A STAKE FROM WHICH THE 1/8 SEC. CORNER BETWEEN THE N.E. 1/4 AND THE S.E. 1/4 OF SEC. 15, T3N, R1W. BEARS S. 64 1/4° AND THE E. 212 FEET DISTANT THENCE N. 72 3/4° W. 149 FEET 4 INCHES, THENCE N. 46° E. 65 FEET 3 INCHES, THENCE S. 72 3/4° E. 100 FEET, THENCE S. 60 FEET TO BEGINNING, SAID PARCEL CORRESPONDING IN GENERAL TO LOT 3 IN MILLER'S ADDITION TO THE CITY OF PLATTEVILLE, GRANT CO., WIS.

SURVEYOR'S CERTIFICATE

I, BRUCE D. BOWDEN, HEREBY CERTIFY THAT I HAVE SURVEYED THE ABOVE DESCRIBED PARCEL AND THAT THE MAP SHOWN HEREON IS A TRUE AND CORRECT REPRESENTATION THEREOF TO THE BEST OF MY KNOWLEDGE AND BELIEF, AND SHOWS THE SIZE AND LOCATION OF THE PARCEL, ITS RECORDED EXTERIOR BOUNDARIES, THE LOCATION OF VISIBLE ROADWAYS AND ENCROACHMENTS, IF ANY. THIS SURVEY IS MADE FOR THE PRESENT OWNERS OF THE PROPERTY AND THOSE WHO PURCHASE, MORTGAGE, OR GUARANTEE THE TITLE THERETO WITHIN ONE YEAR FROM THE DATE HEREON.


Bruce D. Bowden - DATE 1-20-87

BRUCE D. BOWDEN #1250

1/8 SEC. CORNER BETWEEN
NE 1/4 + SE 1/4 SEC. 15, T3N,
R1W



FEB 16 1987

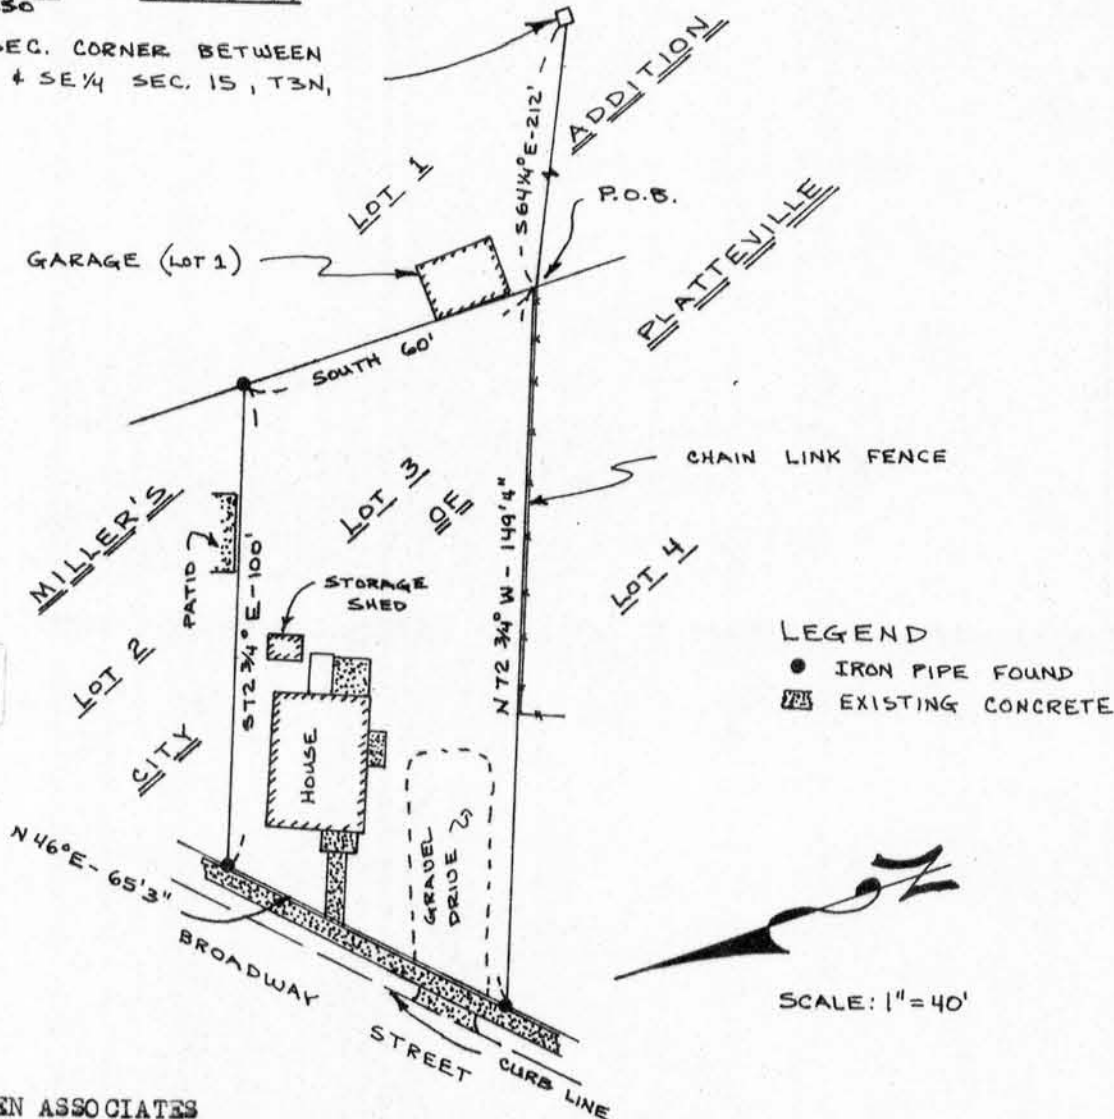

AUSTIN-BOWDEN ASSOCIATES
BRUCE D. BOWDEN
704 N. MAIN ST.
LODGEVILLE, WI. 53533
PHONE (608) 935-5513

LARRY L. AUSTIN
RT. 3 BOX 86A
PLATTEVILLE, WI. 53818
PHONE (608) 348-9993