

BENCHMARK SURVEYS, INC.
P.O. BOX 486 608-583-2333
RICHLAND CENTER, WISCONSIN. 53581

81

LOCATION REPORT
PLAT OF SURVEY

FOR

EARL & ELLEN PAGE



SURVEYING - PLANNING




SCALE 1" = 60'

AGENT: Southwest Wisconsin Land Title Corp.

FURNISHED DESCRIPTION:

A tract of land in the SW 1/4 of the NE 1/4 of Section 11, T8N, R1W, Grant County, Wisconsin, described as follows: Commencing at an iron pipe set at the Northwest Corner of the said SW 1/4 of the NE 1/4 of Section 11, Thence run East

EAST 520'
INW COR. SW 1/4,
NE 1/4, SECT. 11.

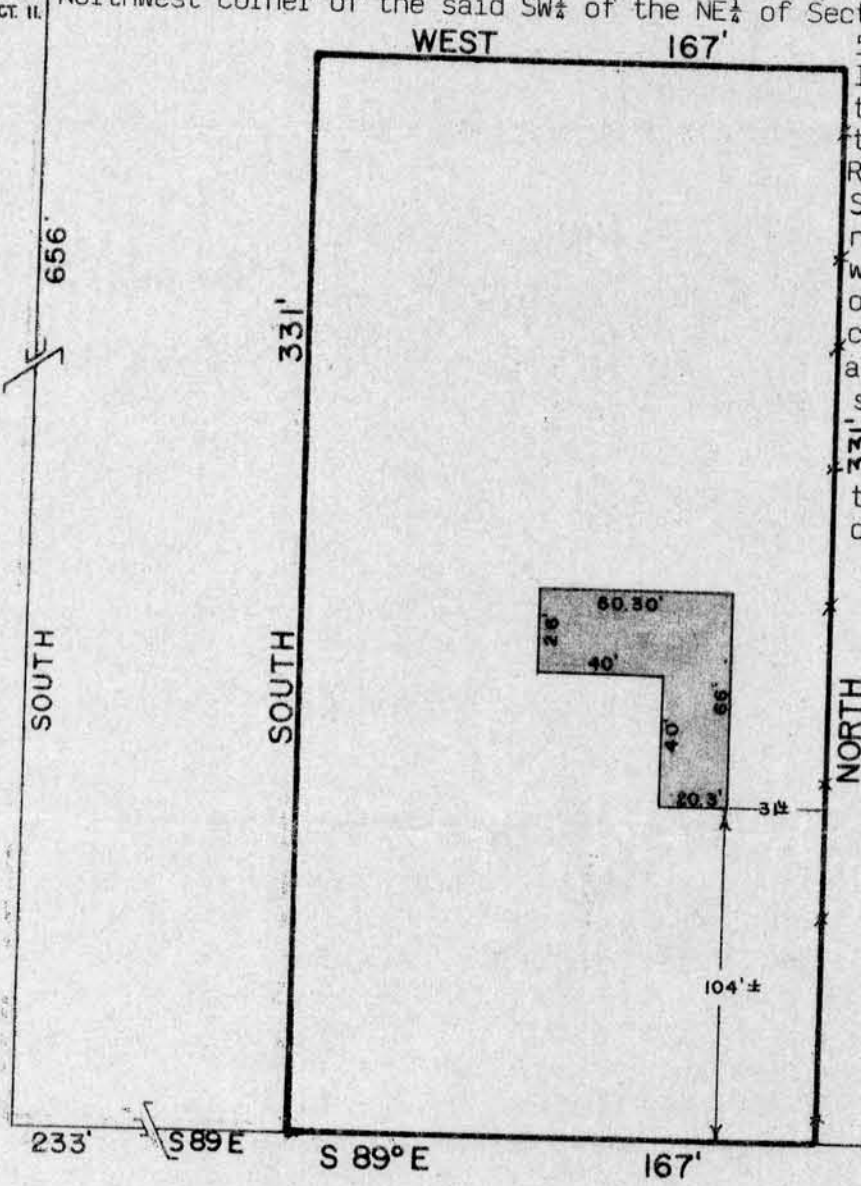

520 feet along the North line of the said SW 1/4, thence South 656 feet to the North Line of the Blue River Highway, thence run South 89° East along the north line of said highway, 233 feet to the point of beginning, Thence continuing South 89° East along the North line of said highway, 167 feet, thence North 331 feet, thence West, 167 feet, thence South to the point of beginning.

S.T.H. 133
(BLUE RIVER HIGHWAY)

WAIVER

We hereby acknowledge that all standards set forth in the Wisconsin Administrative Code Chapter A-E 5.01 for minimum surveying Standards are being waived.

OCT 27 1986
RECEIVED

Owner/Agent _____ Date _____

Owner/Agent _____ Date _____

I HAVE SURVEYED THE ABOVE DESCRIBED PROPERTY, AND THE ABOVE MAP IS A TRUE REPRESENTATION THEREOF AND SHOWS THE SIZE AND LOCATION OF THE PROPERTY, ITS EXTERIOR BOUNDARIES, THE LOCATION AND DIMENSIONS OF ALL STRUCTURES THEREON, FENCES, ROADWAYS, APPARENT EASEMENTS AND ENCROACHMENTS, IF ANY.

THIS SURVEY IS MADE FOR THE EXCLUSIVE USE OF THE PRESENT OWNERS OF THE PROPERTY, AND ALSO THOSE WHO PURCHASE, MORTGAGE OR GUARANTEE THE TITLE THEREOF, WITHIN ONE (1) YEAR FROM DATE HEREOF; AND AS TO THEM I HEREBY CERTIFY THAT SAID SURVEY AND THE ABOVE MAP WERE MADE IN ACCORDANCE WITH ACCEPTABLE PROFESSIONAL STANDARDS AND THAT THE INFORMATION CONTAINED HEREON IS, TO THE BEST OF MY KNOWLEDGE, INFORMATION AND BELIEF A TRUE AND ACCURATE REPRESENTATION THEREOF.

DATED Oct 9, 1986



DRAFTED BY: S. WALSH

JOB NO. 325