

BENCHMARK SURVEYS, INC.
P.O. BOX 486 608-583-2333
RICHLAND CENTER, WISCONSIN. 53581



LOCATION REPORT
PLAT OF SURVEY

FOR


SCALE 1" = 50' ±

DARRYL K. & TAMMY E. EGGERS

Agent: 1st National Bank of Dubuque

FURNISHED DESCRIPTION

Part of the N.E. 1/4 of N.E. 1/4 of Section 9, T 1 N, R 2 W, of the 4th P.M., Grant County, Wisconsin, described as follows, to-wit: Begin at a point which is 378 feet West of the Northeast corner of said Section 9; thence South 08° 28' East 242 feet, more or less; thence South 87° 24' West 80 feet along the Northern boundary of lands described in deed recorded in Volume 340 of Deeds on page 302; thence North 08° 28' West 250 feet, more or less; thence East 80 feet, more or less, to the place of beginning.

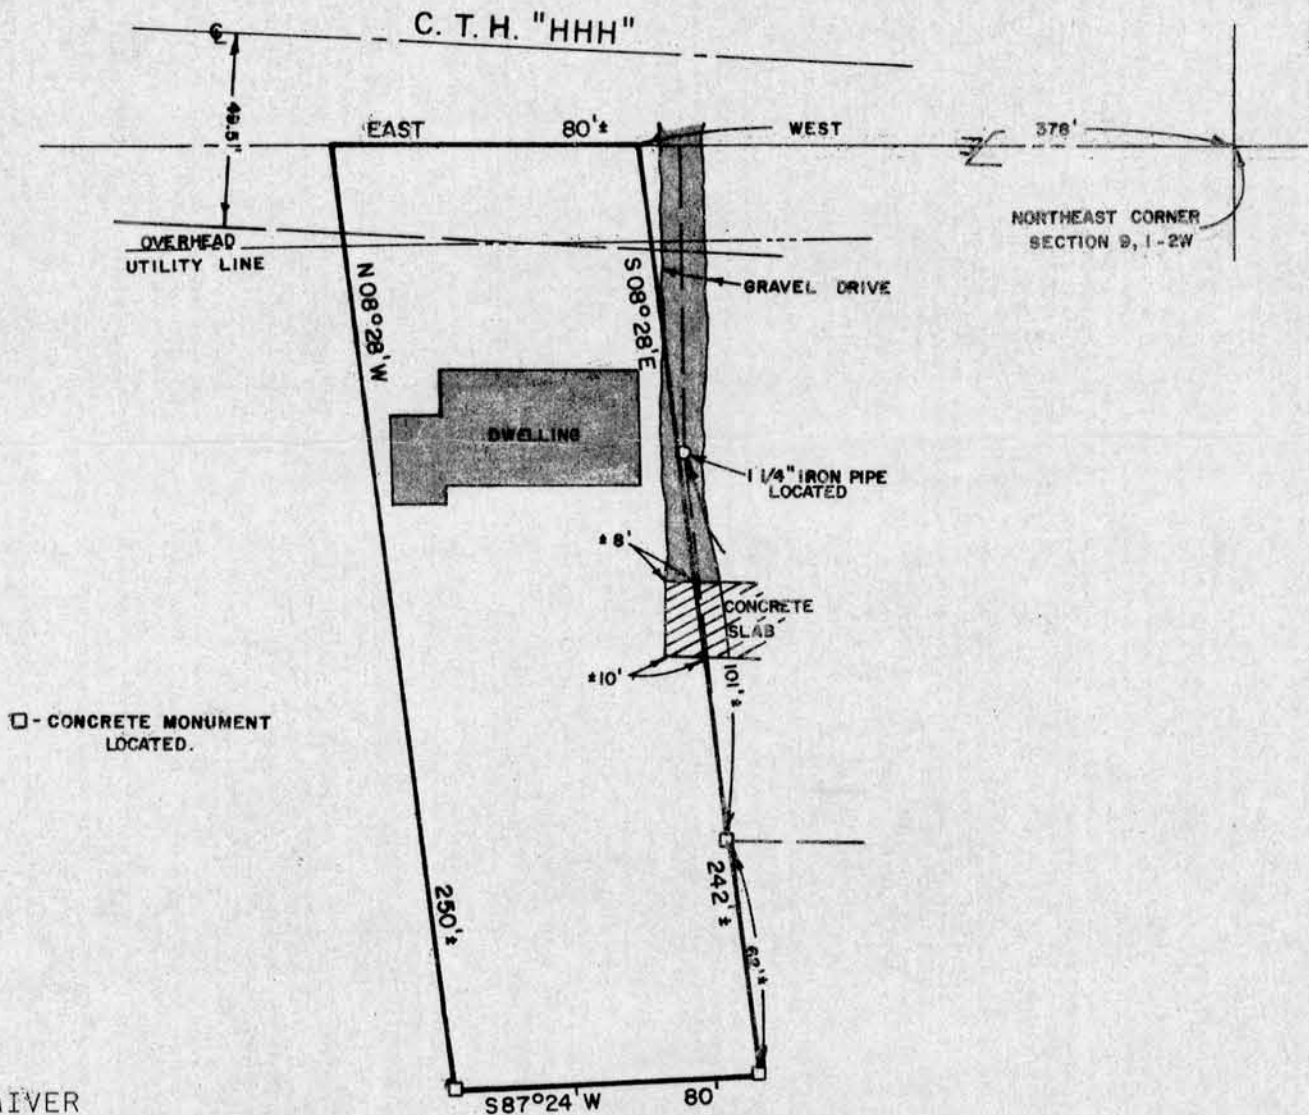

□ - CONCRETE MONUMENT LOCATED.

WAIVER

We hereby acknowledge that all standards set forth in the Wisconsin Administrative Code chapter A-E 5.01, for minimum surveying standards, are being waived.

Owner/Agent _____

Date _____

Owner/Agent _____

Date _____

I HAVE SURVEYED THE ABOVE DESCRIBED PROPERTY, AND THE ABOVE MAP IS A TRUE REPRESENTATION THEREOF AND SHOWS THE SIZE AND LOCATION OF THE PROPERTY, ITS EXTERIOR BOUNDARIES, THE LOCATION AND DIMENSIONS OF ALL STRUCTURES THEREON, FENCES, ROADWAYS, APPARENT EASEMENTS AND ENCROACHMENTS, IF ANY.

THIS SURVEY IS MADE FOR THE EXCLUSIVE USE OF THE PRESENT OWNERS OF THE PROPERTY, AND ALSO THOSE WHO PURCHASE, MORTGAGE OR GUARANTEE THE TITLE THEREOF, WITHIN ONE (1) YEAR FROM DATE HEREOF; AND AS TO THEM I HEREBY CERTIFY THAT SAID SURVEY AND THE ABOVE MAP WERE MADE IN ACCORDANCE WITH ACCEPTABLE PROFESSIONAL STANDARDS AND THAT THE INFORMATION CONTAINED HEREON IS, TO THE BEST OF MY KNOWLEDGE, INFORMATION AND BELIEF A TRUE AND ACCURATE REPRESENTATION THEREOF.

DATED March 24, 1986

