



MORTGAGE INSPECTION SURVEY

BRUCE & MARY WEGMUELLER

SHEET 2 OF 2

LEGEND

- 1/4" Round, Solid, Iron Rod - Found
- 1" x 24" Iron Pipe - Found
- Existing Fence

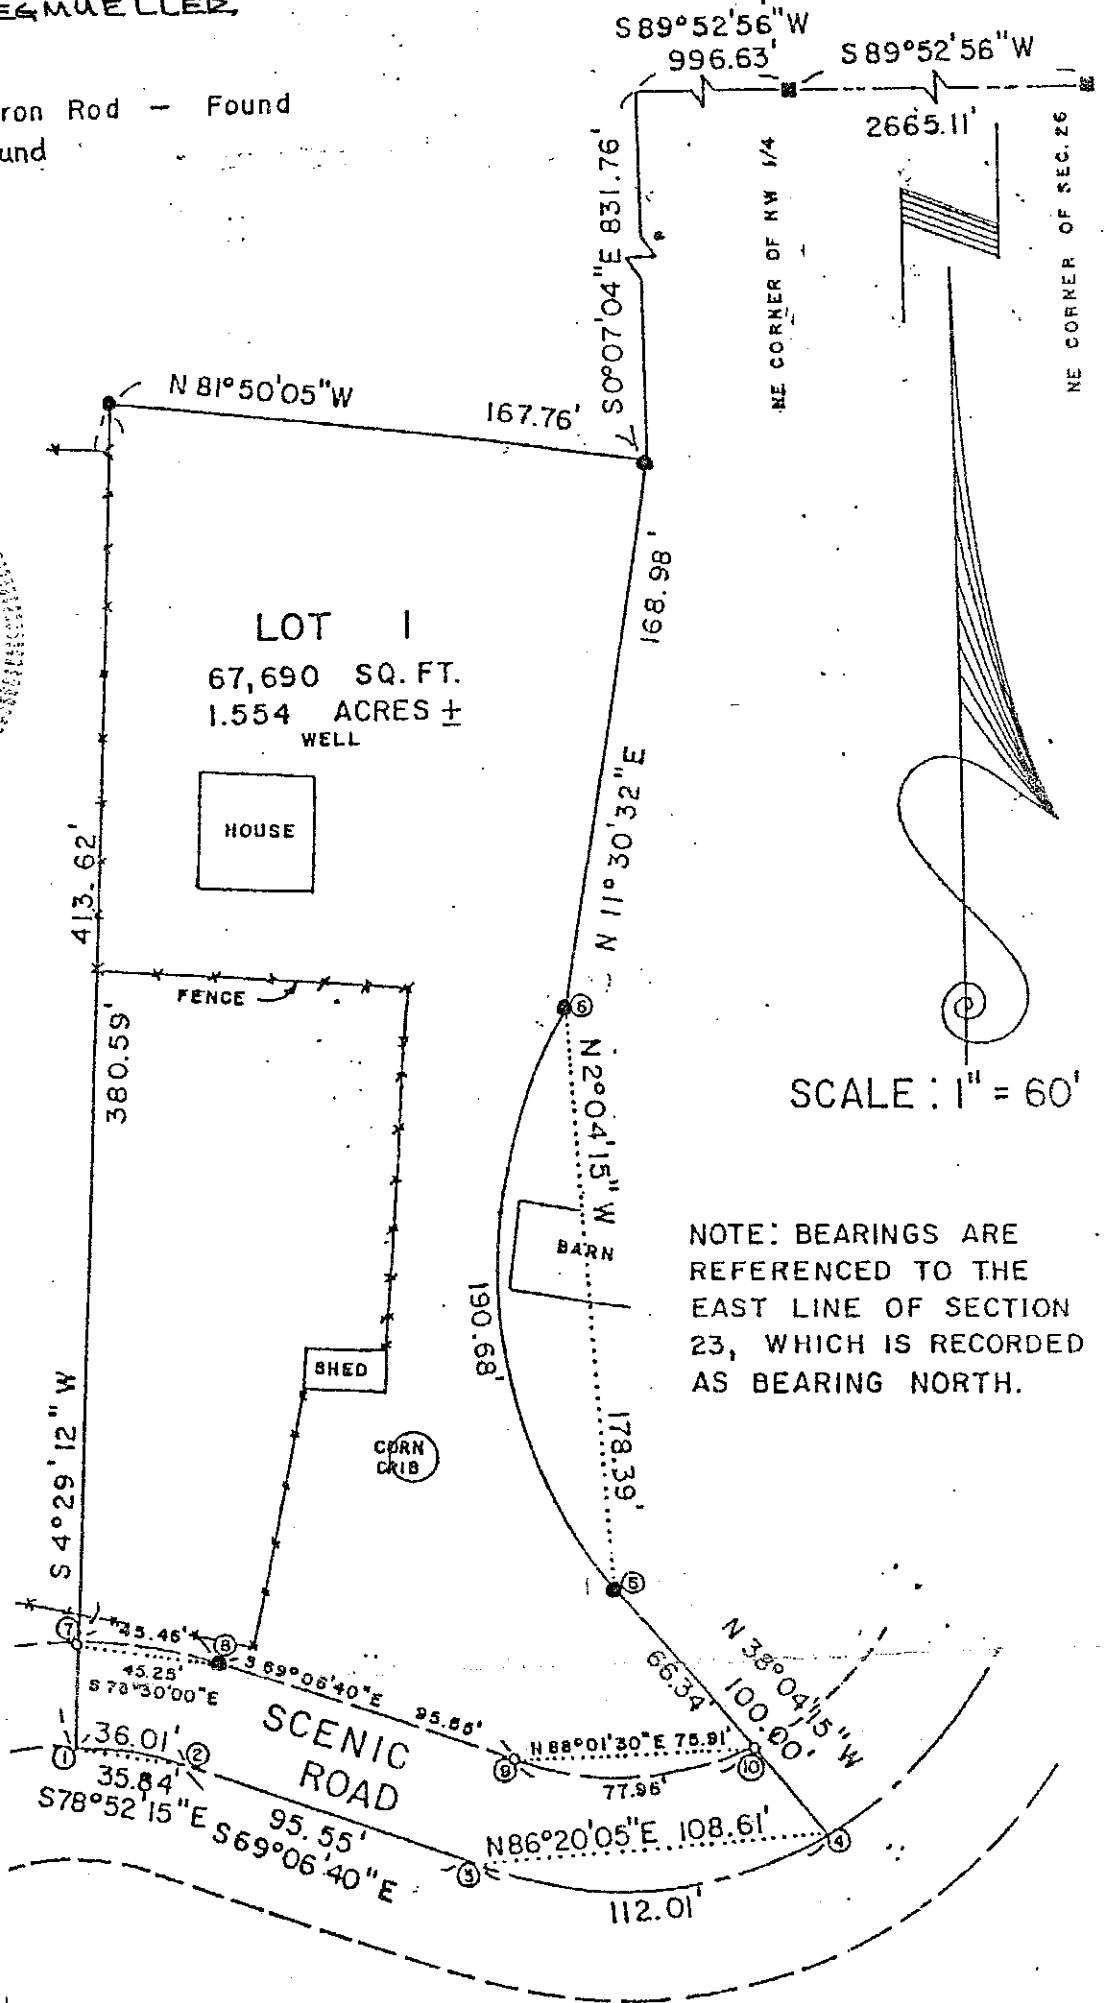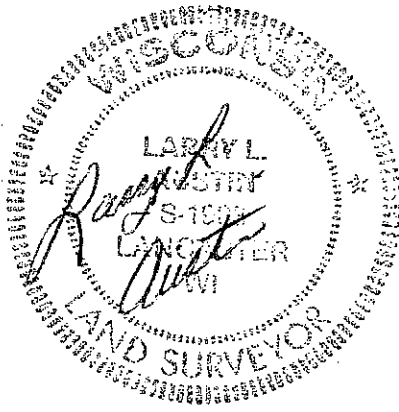

SCALE: 1" = 60'

NOTE: BEARINGS ARE REFERENCED TO THE EAST LINE OF SECTION 23, WHICH IS RECORDED AS BEARING NORTH.

NUMBER	RADIUS	CENTRAL ANGLE
①-②	105.70	19° 31' 10"
⑦-⑧	138.70	18° 46' 40"
③-④	130.69	49° 06' 30"
⑨-⑩	97.69	22° 51' 50"
⑤-⑥	151.74	172° 00' 00"

AUSTIN - BOWDEN ASSOCIATES

LARRY AUSTIN, RE, RLS
RT 2 LANCASTER, WI
608-723-6363

BRUCE BOWDEN, RLS
N. MAIN ST. DODGEVILLE, WI
608-935-5513