

MORTGAGE INSPECTION SURVEY

FOR: MIDWEST TITLE CORP. LANCASTER, WI.

CASE # 1181T-OLIETT/AUG 10 1987

STATEMENT REGARDING WORK TO BE DONE:

AS CLIENT(S) OF LARRY L. AUSTIN, WISCONSIN LAND SURVEYOR, I/WE HEREBY REQUEST THAT THE SURVEY BE MADE ACCORDING TO THE FOLLOWING SPECIFICATIONS:

- 1) ONLY ENOUGH WORK BE PERFORMED TO SATISFY THE REQUIREMENTS OF MIDWEST TITLE CORP. OF LANCASTER
2) NO STAKES BE SET TO MARK THE CORNERS OF THE PARCEL.
3) THE EXACT LENGTH AND BEARINGS OF THE BOUNDARIES OF THE PARCEL NEED NOT BE SHOWN.
4) MEASUREMENTS NEED NOT BE TAKEN AS SPECIFIED IN A-E 7.06 OF THE WISCONSIN ADMINISTRATIVE CODE. IT IS SPECIFICALLY INTENDED TO EXEMPT THIS SURVEY FROM THE REQUIREMENTS OF A-E 7.05(3), 7.06 AND A-E 7.07 OF THE WISCONSIN ADMINISTRATIVE CODE.

Marnie K. Boyer

8-7-87

DATE

SURVEYOR'S CERTIFICATE: I HEREBY CERTIFY THAT I HAVE SURVEYED THE ABOVE DESCRIBED PARCEL AND THAT THE MAP SHOWN HEREON IS A TRUE AND CORRECT REPRESENTATION THEREOF TO THE BEST OF MY KNOWLEDGE AND BELIEF, AND SHOWS THE SIZE AND LOCATION OF THE PARCEL, ITS RECORDED EXTERIOR BOUNDARIES, THE LOCATION OF VISIBLE ROADWAYS AND ENCROACHMENTS, IF ANY. THIS SURVEY IS MADE FOR THE USE OF THE PRESENT OWNERS OF THE PROPERTY AND THOSE WHO PURCHASE, MORTGAGE, OR GUARANTEE THE TITLE THERETO WITHIN ONE YEAR FROM THE DATE HEREON.

Larry L. Austin

LARRY L. AUSTIN # 1903

8-7-87


DATE

LEGAL DESCRIPTION: LOT 1, BLOCK 1, DEVINE'S ADDITION, CITY OF BOSCOBEL, GRANT COUNTY, WISCONSIN.



LEGEND

EXIST. CONC.

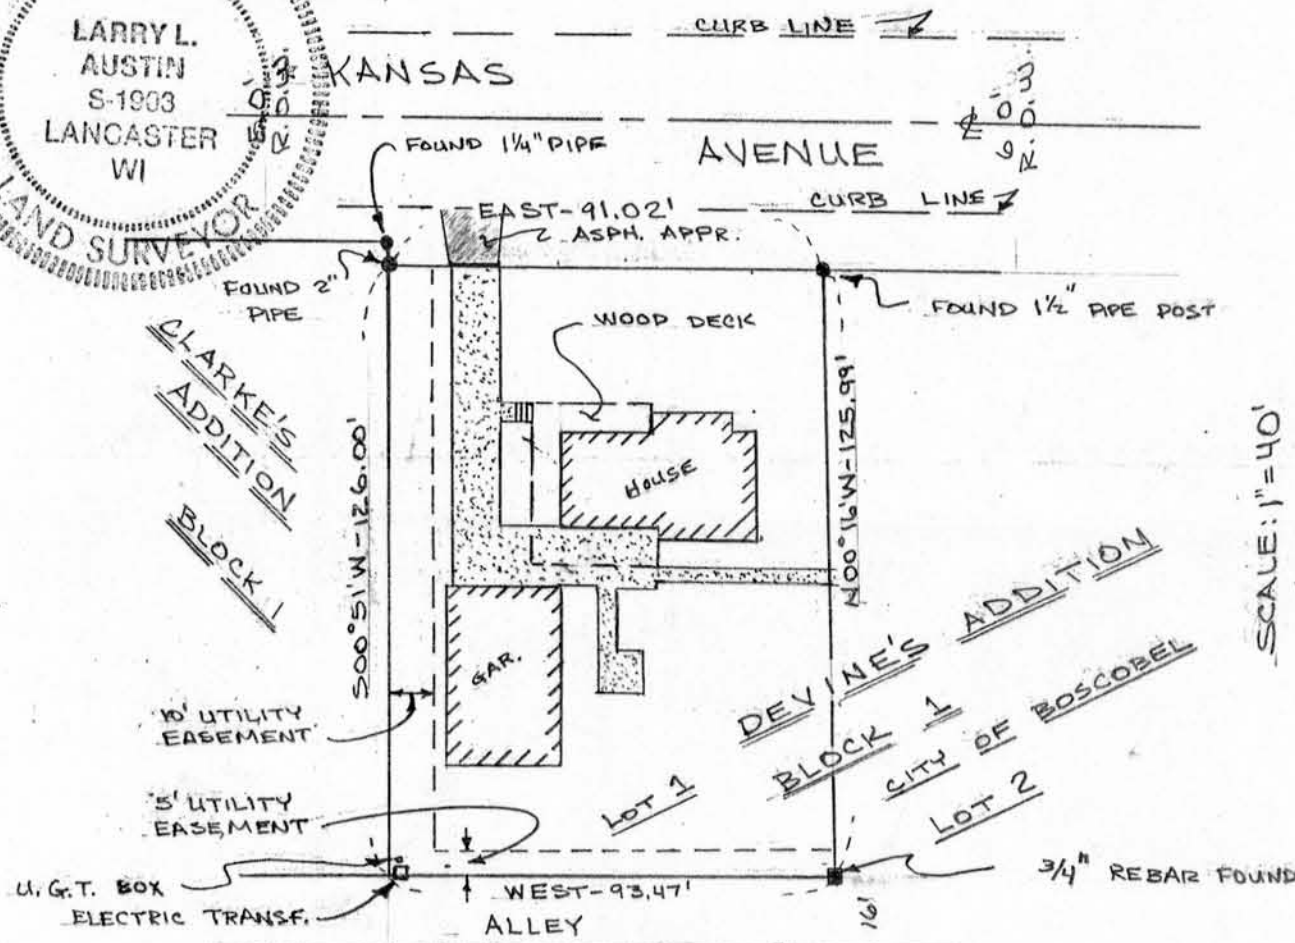

SCALE: 1"=40'

AUSTIN-BOWDEN ASSOCIATES

LARRY L. AUSTIN RT 2 LANCASTER, WI 608-723-6363

BRUCE BOWDEN MAIN ST. DODGEVILLE 608-935-5513