


MORTGAGE INSPECTION SURVEY

** JONES **

PREPARED FOR: MIDWEST TITLE CORP. LANCASTER, WIS.

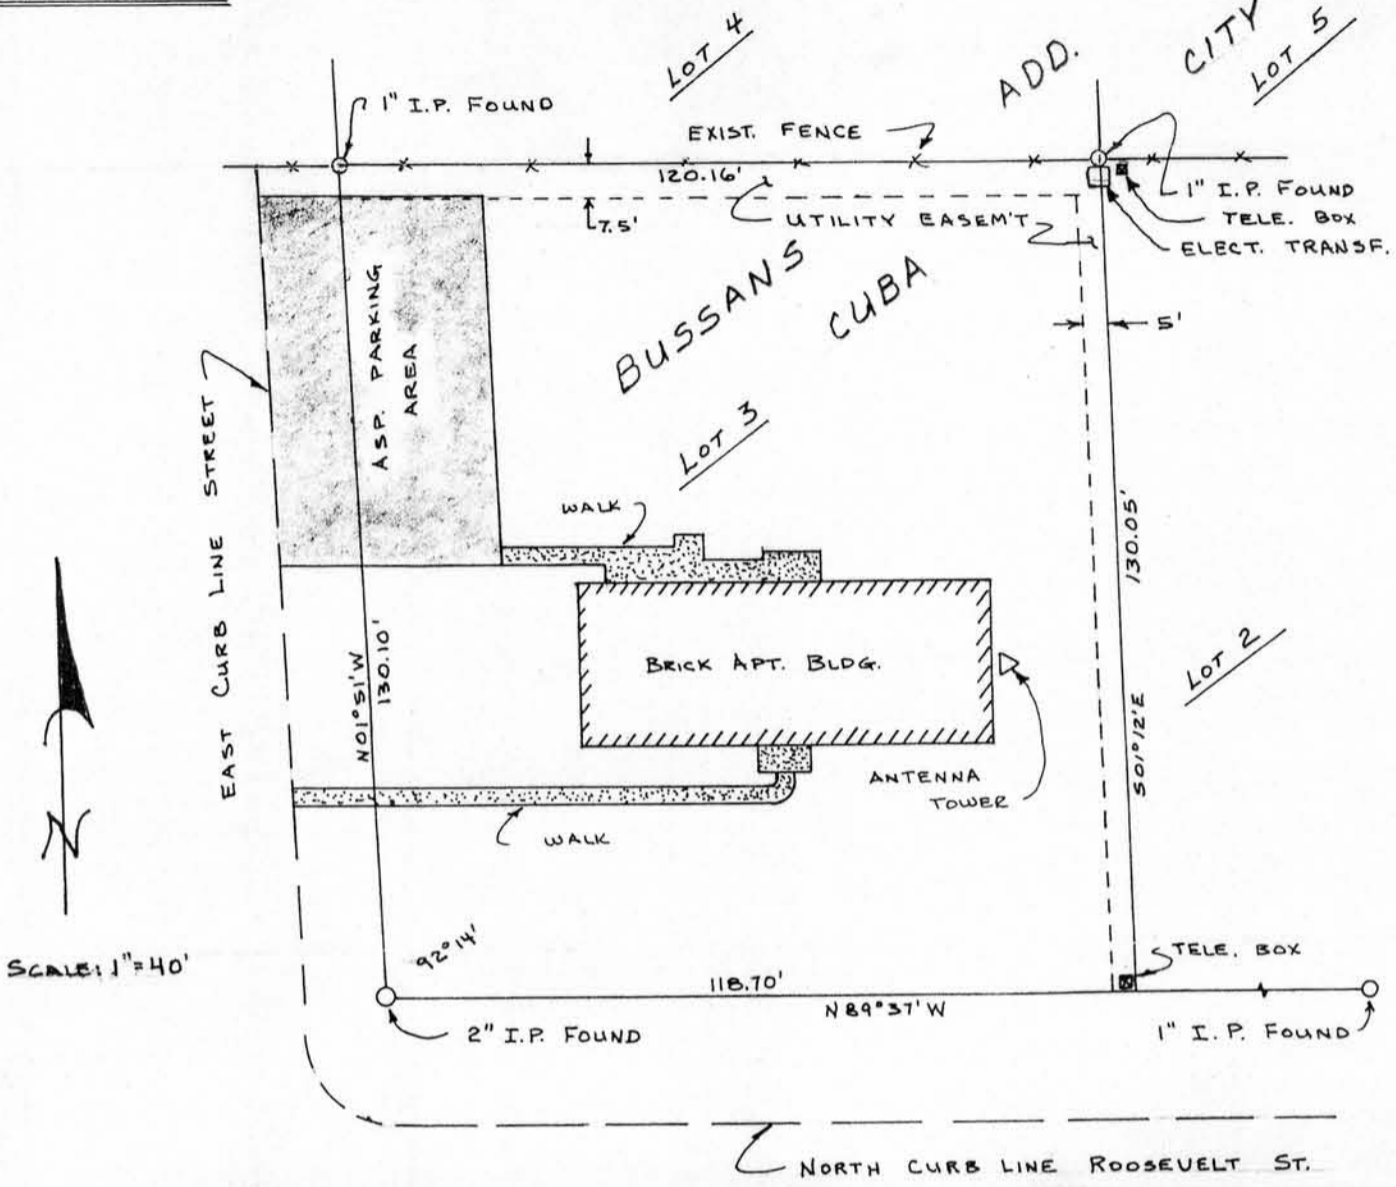

DESCRIPTION: LOT 3 OF BUSSANS ADDITION TO THE CITY OF CUBA CITY, GRANT COUNTY, WI.

REQUEST REGARDING WORK TO BE DONE:
 IN REGARD TO A SURVEY MADE BY BRUCE D. BOWDEN, R.L.S., DODGEVILLE, WI., OF THE ABOVE DESCRIBED PARCEL FOR THE BENEFIT OF MIDWEST TITLE CORP. AND/OR ASSIGNS: AS A CLIENT OF BRUCE D. BOWDEN, REGISTERED LAND SURVEYOR, I/WE HEREBY REQUEST THAT ONLY ENOUGH WORK BE PERFORMED TO SATISFY THE REQUIREMENTS OF MIDWEST TITLE CORP. AND/OR ASSIGNS AND THAT NO MONUMENTATION BE SET.

B. D. Bowden 4-3-86
 _____ DATE

SURVEYOR'S CERTIFICATE:
 I, BRUCE D. BOWDEN, REGISTERED LAND SURVEYOR, HEREBY CERTIFY THAT A SURVEY HAS BEEN PERFORMED BY ME OR UNDER MY DIRECT SUPERVISION, OF THE ABOVE DESCRIBED PARCEL AND THAT THE ABOVE MAP IS A TRUE REPRESENTATION THEREOF, AND SHOWS THE SIZE AND LOCATION OF THE PARCEL, ITS RECORDED EXTERIOR DIMENSIONS, ITS LOCATED IMPROVEMENTS, AND THAT THERE ARE NO APPARENT ENCROACHMENTS EXCEPT AS SHOWN ON THE ACCOMPANYING DRAWING.

Bruce D. Bowden
 BRUCE D. BOWDEN, RLS 1250
 DODGEVILLE, WI.

April 3, 1986
 DATE

