

RECEIVED

268

SEP 30 1985


Dwg: 85050A

City of Lancaster


MORTGAGE INSPECTION SURVEY



For: RICHARD CALEY
Lancaster, WI
% ANCHOR
SAVINGS & LOAN

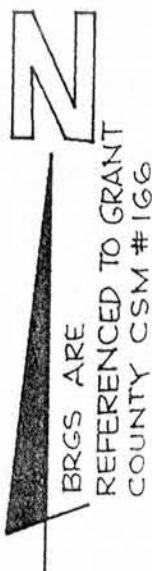

West 1/4 Corner,
Sec. 5, T4N, R2W

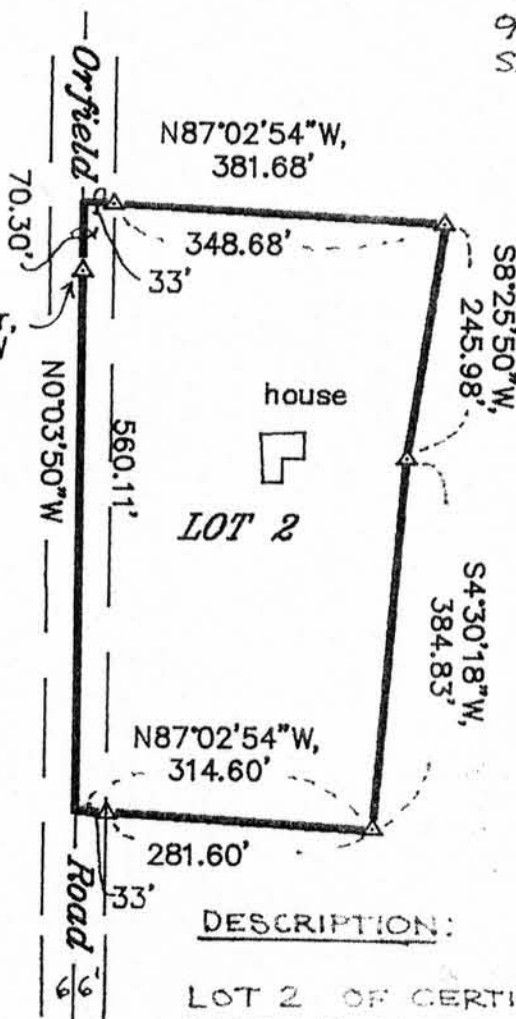

DESCRIPTION:


LOT 2 OF CERTIFIED SURVEY
MAP NO. 166 OF GRANT
COUNTY, WI

LEGEND

△ 1" x 24" IRON PIPE

OFFICE DATA

JOB NO. 85S-065
SURVEY CREW: TS & KP
PPLE FILE: 201-5
FIELD BK. NO. 85-3
DRAWN: ACAD/TS
DRAWING NO.

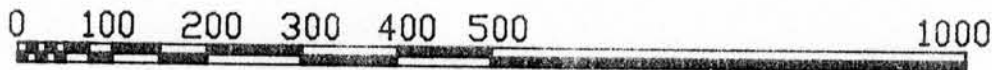

GRAPHIC SCALE - FEET

ORIG DWG - 1"=200'

SURVEYOR'S CERTIFICATE

I hereby certify that I have surveyed the above described parcel and that the map is a true representation thereof and shows the size and location of the parcel, its recorded exterior boundaries, the location of visible roadways and encroachments, if any. This survey is made for the use of the present owners of the property and also those who purchase mortgage, or guarantee the title thereto within one year from the date hereof.

Laurence E. Schmit 7-30-85

Laurence E. Schmit S-1312

SCHMIT ENGINEERING & SURVEYING

206 S Iowa St - Dodgeville Wi. - 608-935-2721