

FEB 10 1989

Sec. 19, T7N, R1W

PLAT OF SURVEY

For: Mr. David Hulits.
1819 Giehler Road
Stoughton, Wi. 53589


Those parts of the Southwest 1/4 and the Southeast 1/4 of the Southwest 1/4 of Section 19, Town 7 North, Range 1 West, Castle Rock Township, Grant County, Wisconsin, being more fully described as :

Beginning at the Southwest corner of the said Southwest 1/4; thence N 0° 19' 09" W along the West line thereof, 1325.30' to the Northwest corner of the Southwest 1/4 of the Southwest 1/4; thence S 89° 16' 45" E, 1181.20' to the Northeast corner of the Southwest 1/4 of the Southwest 1/4; thence S 89° 16' 45" E along the North line of the Southeast 1/4 of the said Southwest 1/4, 365.23' (22 1/2 rods); thence S 28° 42' 17" W, 747.19' to a point on the West line of the Southeast 1/4 of the said Southwest 1/4 that is 660' (40 rods) South of the Northwest corner thereof; thence S 0° 35' 00" E, 663.11' to the Southeast corner of the Southwest 1/4 of the Southwest 1/4; thence N 89° 23' 27" W, 1187.27' to the point of beginning. Containing 38.762 acres, more or less, and being subject to any and all recorded easements and rights-of-way.

I, Bruce D. Bowden, Registered Wisconsin Land Surveyor, do hereby certify that I have surveyed, mapped and monumented that property described hereon and that this map is a correct representation thereof to the best of my knowledge and belief in accordance with the instructions of Mr. David Hulits.

Bruce D. Bowden

Dec 21, 1988
Date

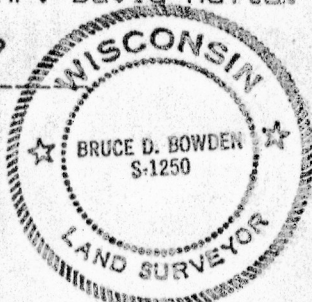

Bruce D. Bowden R.L.S. - 1250
Austin - Bowden Assoc.
704 North Main Street
Dodgeville, Wi. 53533
Phone (608) 935 - 5513

Larry L. Austin
Route 3 Box 86A
Platteville, Wi. 53818
Phone (608) 348 - 9993

Note : Bearings are referenced to the West line of the Southwest 1/4 of Section 19, which is recorded as bearing S 0° 19' 09" E.

