

SURVEY PLAT

41

NODOLF REALITY &
STATE NAT'L BANK
PLATTEVILLE WISC.


OF LOT 15, WUNDERLIN SUBDIVISION NO. 2, CITY OF PLATTEVILLE,
GRANT COUNTY, WISCONSIN.

SURVEYOR'S CERTIFICATE:

I, LARRY L. AUSTIN, REGISTERED WISCONSIN LAND SURVEYOR, DO HEREBY
CERTIFY THAT I HAVE SURVEYED, MONUMENTED, AND MAPPED THAT PROPERTY
DESCRIBED HEREON IN ACCORDANCE WITH THE INSTRUCTIONS OF MR. CARL NODOLF
OF NODOLF REALITY, PLATTEVILLE WISCONSIN, AND THAT THIS MAP IS A
CORRECT REPRESENTATION THEREOF, TO THE BEST OF MY KNOWLEDGE AND BELIEF.


Larry L. Austin
LARRY L. AUSTIN R.L.S.#1903

LARRY AUSTIN ENGINEERING
RT. 2
LANCASTER, WI 53813
(608) 723-6363

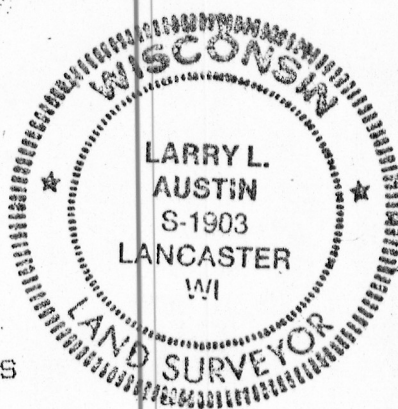

9/16/88
DATE

BEARING REFERENCE: FOR PURPOSE OF THIS
SURVEY, BEARINGS ARE REFERENCE TO THE
WEST LINE OF LOT 15: ASSUME N 00° 01' 39" E

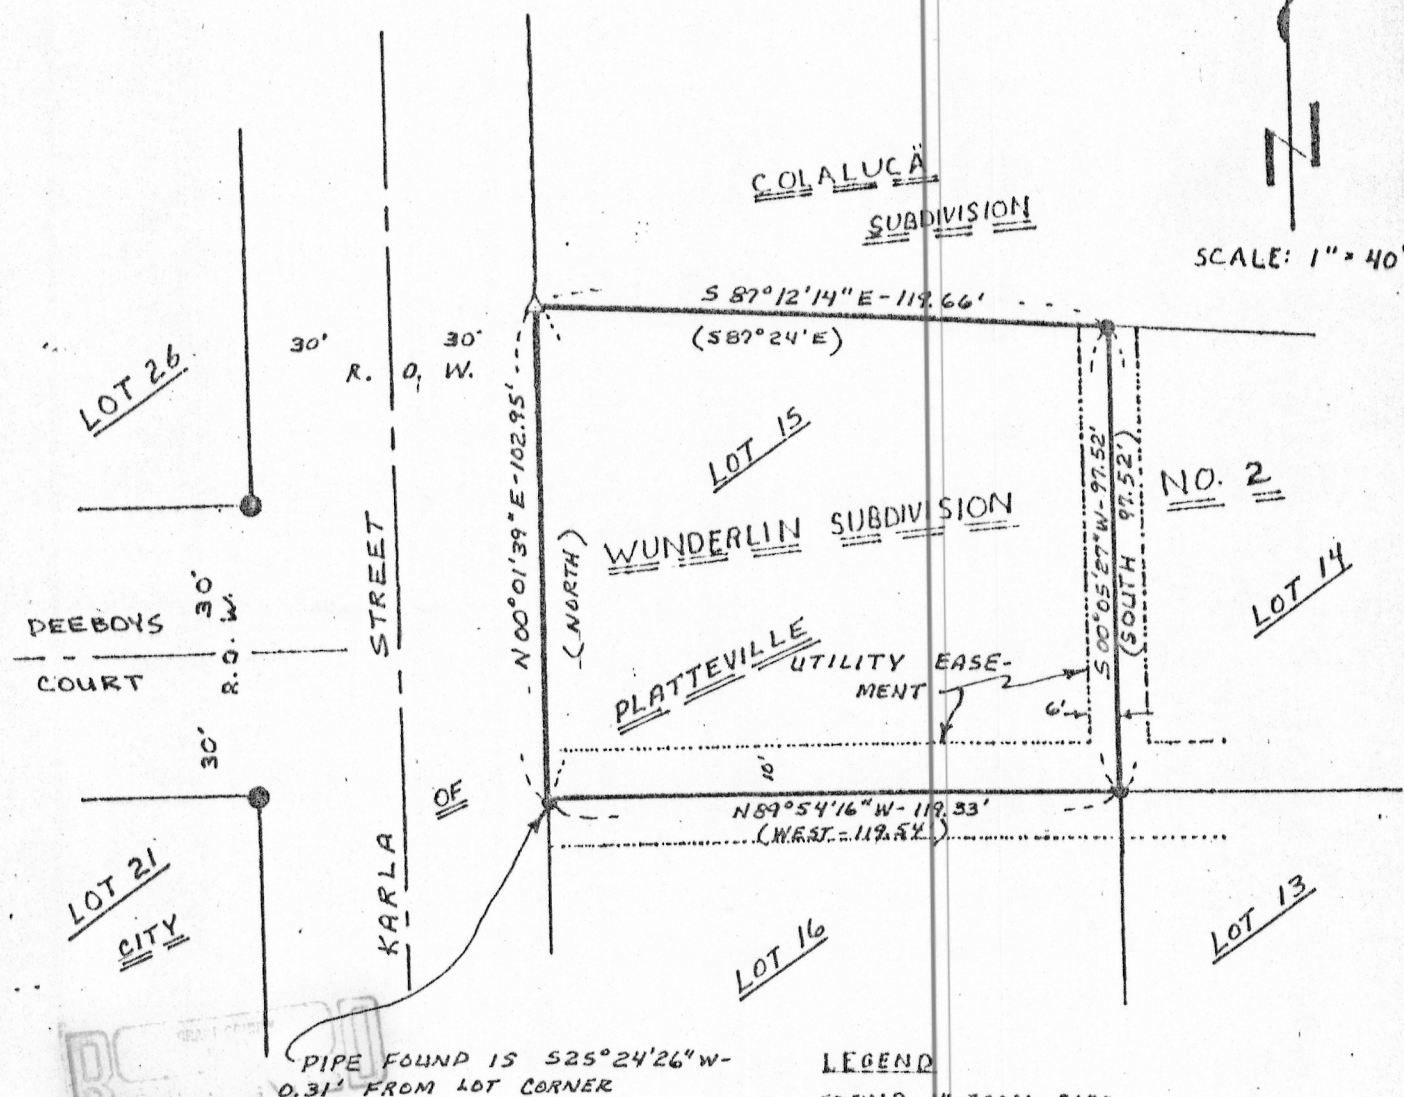

- LEGEND
- FOUND 1" IRON PIPE
 - FOUND 2" IRON PIPE
 - △ 2"x30" IRON PIPE SET - 3.65# / L.F.

FEB 27 1989