

BESTOR PROPERTY
PLATTEVILLE TOWNSHIP
GRANT COUNTY, WIS.
11/14177

LEGRAUD


51

Sec 30, T3N, R1W

DESCRIPTION:

Commencing at the SE corner of the SW $\frac{1}{4}$ of the SE $\frac{1}{4}$ of Sec. 30, T3N, R1W, 4th P.M. Grant County, Wisconsin; thence North, 1857.58 ft. to the centerline of C.T.H. "O"; thence S 63°16'W, 300.00 ft. along said centerline to the Point of beginning; thence S 63°16'W, 200.00 ft. along said centerline; thence South, 200.00 ft.; thence S 16°42'E, 355.49 ft.; thence East, 76.47 ft.; thence North, 630.47 ft. to the point of beginning, containing 2.002 acres more or less.

*from
Return to the Grade*

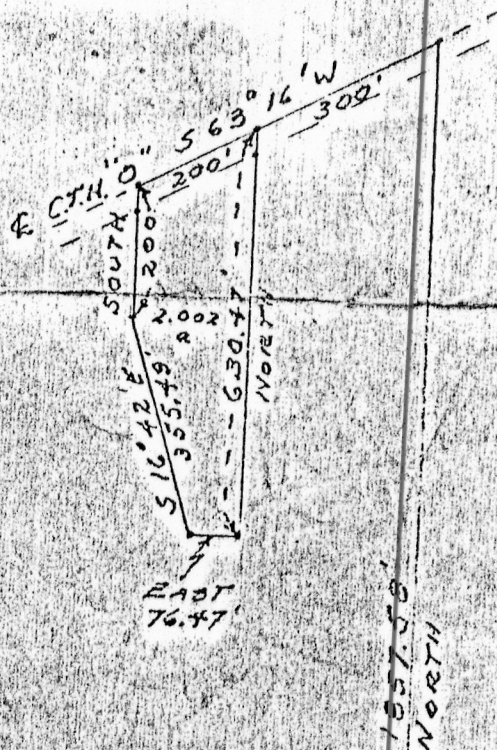

SCALE 1"=300'

GRANT COUNTY
CLERK
RECEIVED

MAY 2 1889



SE CORNER
SW $\frac{1}{4}$ SE $\frac{1}{4}$ SEC. 30
T3N, R1W, 4TH P.M.

I, D.C. Dixon, registered surveyor, hereby certify that I surveyed the above described land and that the above plat is a correct representation thereof.

D.C. Dixon S-304
D.C. Dixon

LEGRAUD LAND DESCRIPTION