


PLAT OF SURVEY

SCALE: 1" = 30'

LOT 4, BLOCK 11, VILLAGE OF WYALUSING, LOCATED IN SECTION 36, T6N, R7W, TOWN OF WYALUSING, GRANT COUNTY, WISCONSIN. ALSO INCLUDING A LEASE WITH THE CHICAGO, BURLINGTON AND QUINCY RAILROAD COMPANY IDENTIFIED AS LEASE #982.3 AND LOCATED IN LOTS 3 AND 4, BLOCK 9, VILLAGE OF WYALUSING.

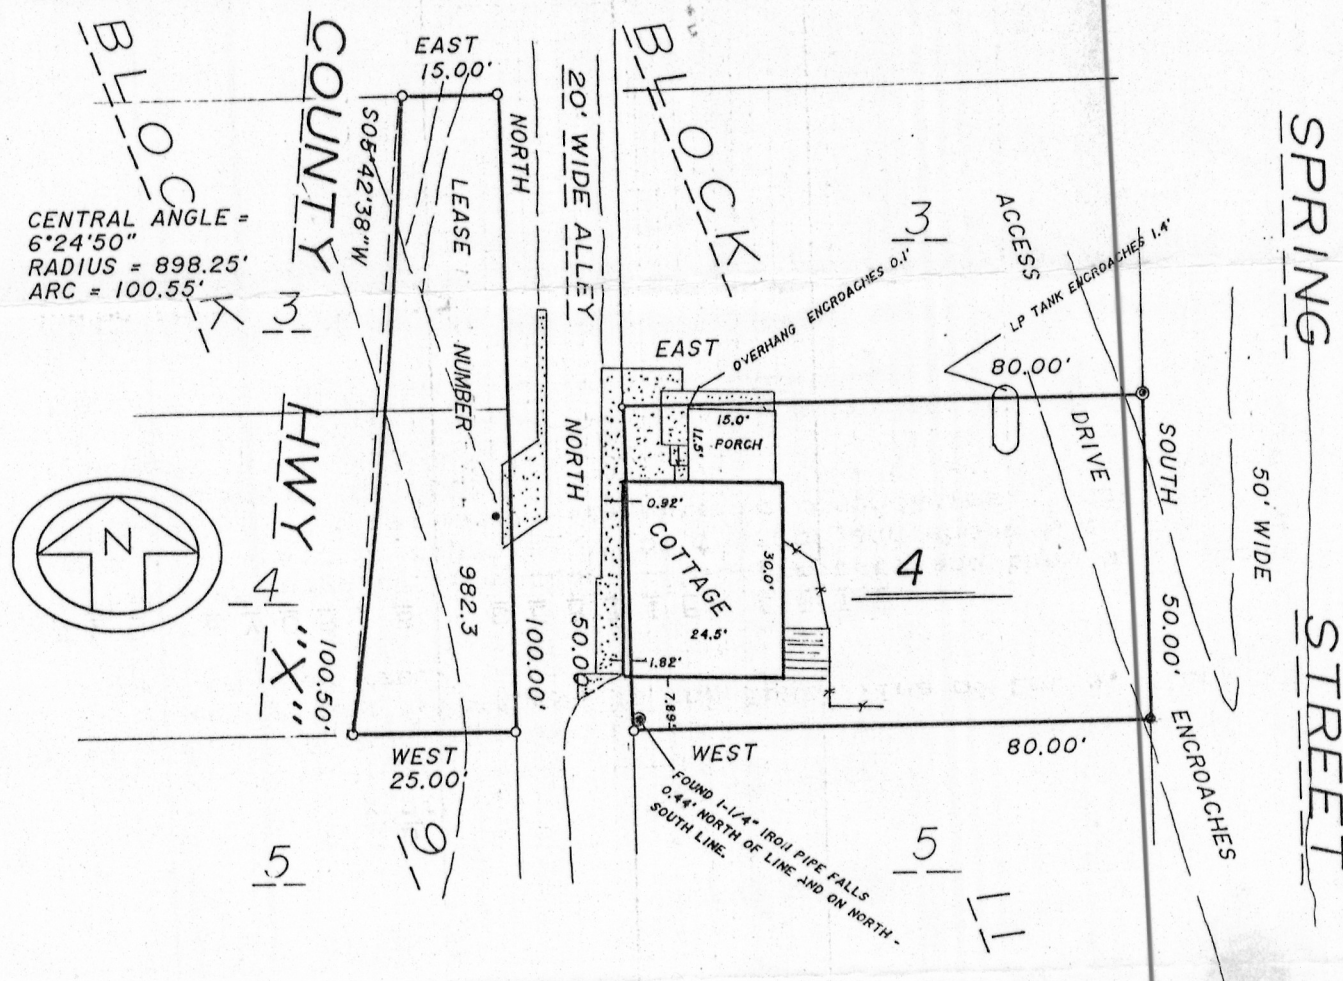

Prepared for:
Leo Havlick
Bagley, WI

L E G E N D A N D N O T E S

- Denotes 3/4" X 24" solid round iron rod set.
- Denotes 1-1/4" iron pipe found.
- Denotes 3/4" hole drilled in concrete.

1.) Bearings are referenced to the South line of Lot 4, Block 11 assumed to bear West.



SURVEYOR'S CERTIFICATE

SURVEYOR'S CERTIFICATE
I have surveyed the above described property and the map shown here on is a true representation thereof and shows the size and location of the property, its exterior boundaries, location of all permanent structures thereon, apparent easements, public roadways and visible encroachments if any. This survey is made for the exclusive use of the present owners of the property and those who purchase, mortgage or guarantee the title thereto within one year from the date here on. As to them I warrant the accuracy of said survey and map.

accuracy of said survey and map.
Dated this 24th day of January, 1989

~~Richard Marks~~

S-1473

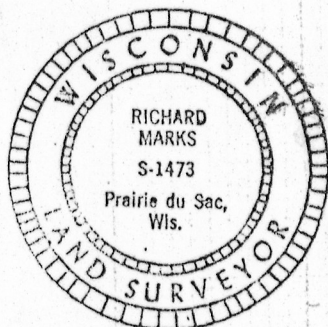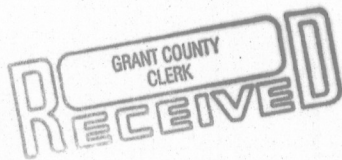

MAY 23 1989

River Valley
Land Surveying

1502 LORI COURT
SAUK CITY, WISCONSIN 53583