

SURVEY PLAT

LEGEND

- △ FOUND # 6 BAR
- ▲ SET # 6 BAR
- FOUND 1" PIPE
- SET 1" PIPE
- ⊠ FOUND # 10 BAR
- ⊡ SET # 10 BAR
- FOUND 2" PIPE
- SET 2" PIPE

Scale 1" = 200'

Bearings are referenced to the East line of the SE 1/4 of Section 30 T3N, R1W, Grant County, WI., assumed to bear N 00°38'47"W

Survey for:
Richard Calvin
Platteville, WI

Note: The parcel was established in an unrecorded survey performed by Dale C. Dixon S-304, 10-29-77

Douglas J. Malliet
Douglas J. Malliet
S-1266
Registered Land Surveyor
May 19, 1989



S 1/4 corner
Section 30, T3N, R1W
Found 3/4" drill bit

N89°28'47"W 1324.24'

Centerline of CTH "0"

S 62°18'58"W 300.00'
(S 63°16'W, 300' Rec.)

Area = 6.8776 Acres
(6.91 Acres Recorded)

S89°27'14"E
267.54'

(S88°51'E
267.98' Rec.)

N 00°46'31"W 22.80'

N 00°46'31"W 1190.94'
(North 1193.99' Rec.)

N00°09'51"W 662.58'
(North 663.59' Rec.)

SE corner of the
SW 1/4 of the
SE 1/4 Sect. 30
Found 1" iron pipe

LEGAL DESCRIPTION

I, Douglas J. Malliet, Registered Land Surveyor, hereby certify that I have resurveyed a parcel of land located in the West 1/2 Southeast 1/4 of Section 30, T3N, R1W, Grant County, Wisconsin, originally described as follows:

Commencing at the SE corner of the SW 1/4 of the SE 1/4 of Sec. 30, T3N, R1W, 4th p.m., Grant County, Wisconsin; thence North, 663.59 ft. to the point of beginning; thence North, 1193.99 ft. to the centerline of C.T.H.. "0"; thence S 63 degrees 16' W, 300.00 ft. along said centerline; thence South, 1053.66 ft.; thence S 88 degrees, 51' E, 267.98 ft. to the point of beginning.


Said parcel contains 6.91 acres and is subject to any and all easements and right-of-ways of record.

I further certify such survey and the representation thereof hereon are true and correct to the best of my knowledge and belief.

Douglas J. Malliet

Douglas J. Malliet
S-1266

Registered Land Surveyor
May 19, 1989

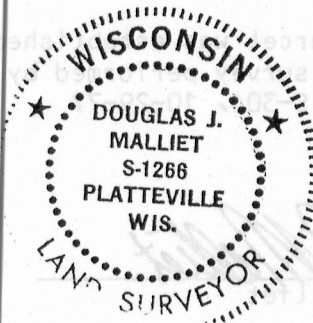

D. F. BURBACH MUNICIPAL & CIVIL ENGINEERS

Box 96B, Highway 80 South • Platteville, Wisconsin 53818 • (608) 348-3262