


PLAT OF SURVEY

LOTS 1, 2, 3 AND 4, BLOCK 1 OF THE ORIGINAL PLAT OF THE VILLAGE OF WOODMAN, LOCATED IN THE SW1/4 OF THE SW1/4 OF SECTION 12, T7N, R4W, VILLAGE OF WOODMAN, GRANT COUNTY, WISCONSIN.

JUN 14 1989

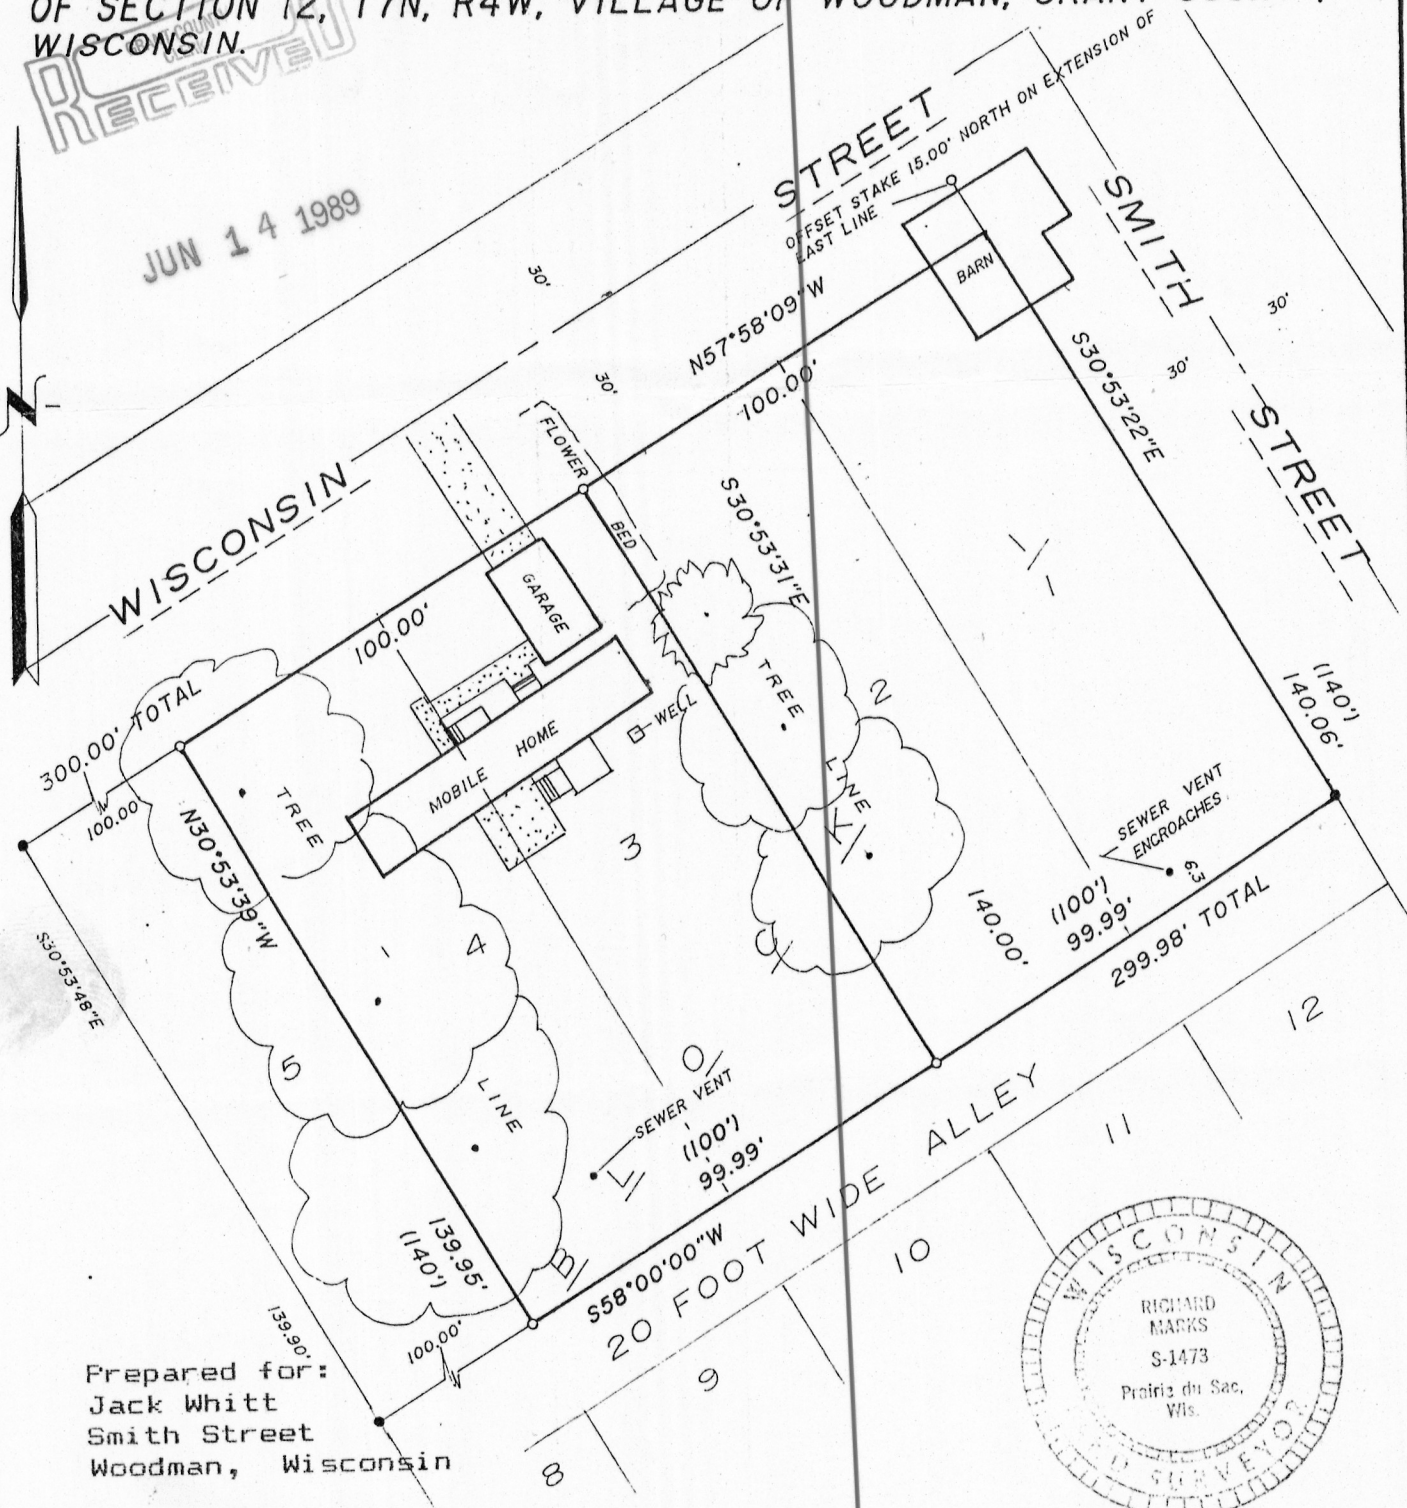

Prepared for:
Jack Whitt
Smith Street
Woodman, Wisconsin

LEGEND AND NOTES


- o Denotes 3/4" X 24" solid round iron rod set.
 - Denotes 1" iron pipe found.
- 1.) When different "recorded as" distances are shown in parentheses.
- 2.) Bearings are referenced to the South line of Lots 1 - 6 of Block 1, assumed to bear and recorded as S58°00'00"W.

SURVEYOR'S CERTIFICATE

I have surveyed the above described property and the map shown here on is a true representation thereof and shows the size and location of the property, its exterior boundaries, location of all permanent structures thereon, apparent easements, public roadways and visible encroachments if any. This survey is made for the exclusive use of the present owners of the property and those who purchase, mortgage or guarantee the title thereto within one year from the date here on. As to them I warrant the accuracy of said survey and map.

Dated this 17 day of June, 1989

Richard Marks S-1473

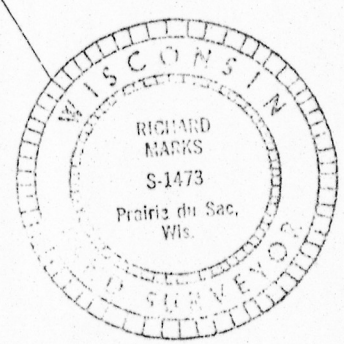

River Valley
Land Surveying

1502 LORI COURT
SAUK CITY, WISCONSIN 53583