

PLAT OF SURVEY
Sheet 1 of 1

SURVEY FOR: JAMES MARLOWE

REVISED: June 28, 1989
June 17, 1988



A SURVEY OF LOTS 5, 6, 7, & 8 of Block 101 of the Original Plat,
Village of Muscoda, Grant County, Wisconsin.

I certify that I have surveyed the above described parcel of land and that the following Plat is an accurate survey and a true representation thereof and correctly shows the exterior boundary lines of said parcel and the correct measurements thereof to the best of my knowledge and belief.

AWC 6/28/89
Paul W. Chafer 6/17/88
 Paul W.-Chafer S-1821 date
 Registered Land Surveyor
 Rt. 1, Box 83
 Lone Rock, Wisconsin 53556

LEGEND:

- 2" iron pipe located
 ▲ 5/8" iron bar located
 △ 3/4" X 24" iron bar set
 Apparent encroachment(driveway)

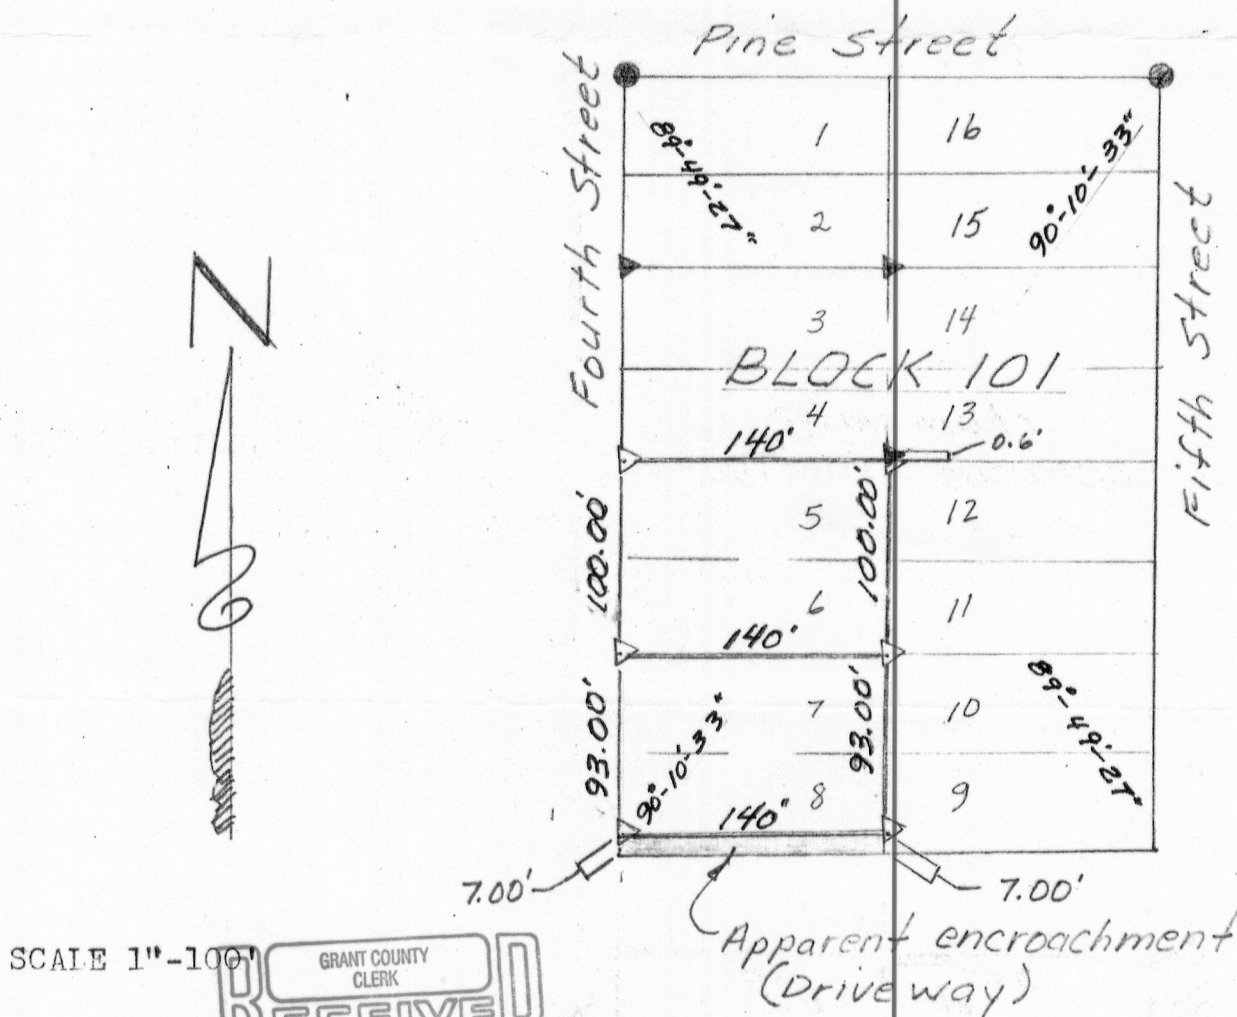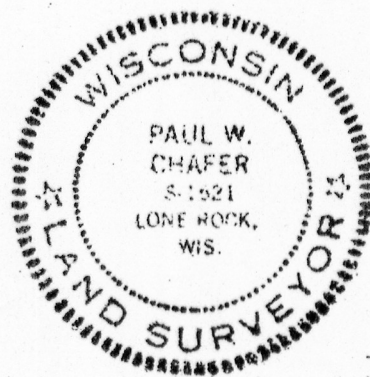

SCALE 1"-100'

GRANT COUNTY
CLERK

GRANT COUNTY
CLERK

JUL 3 1989