

BENCHMARK SURVEYS, INC.
P.O. BOX 486 608 / 647-8533
RICHLAND CENTER, WISCONSIN. 53581



SCALE 1" = 100'


MORTGAGE INSPECTION
PLAT OF SURVEY
FOR
**ANCHOR SAVINGS
AND LOAN**

FURNISHED DESCRIPTION

A parcel of land located in the Southeast Quarter (SE $\frac{1}{4}$) of the Northeast Quarter (NE $\frac{1}{4}$) of Section Thirty Five (35), Township Eight (8) North, Range Three (3) West of the 4th P.M., in Grant County, Wisconsin, described as follows:
Commence at the Northeast Corner of (SE $\frac{1}{4}$) of NE $\frac{1}{4}$ of said Section 35; thence South 200.00 feet along barbed wire fence; thence West 643.89 feet to the Eastern right of way line of County Trunk Highway "M"; thence North 18° 25' West, 210.48 feet along said right of way line; thence East 710.39 feet to the place of beginning.

LEGEND

O - 1" IRON PIPE FOUND
*- *- EXISTING FENCE

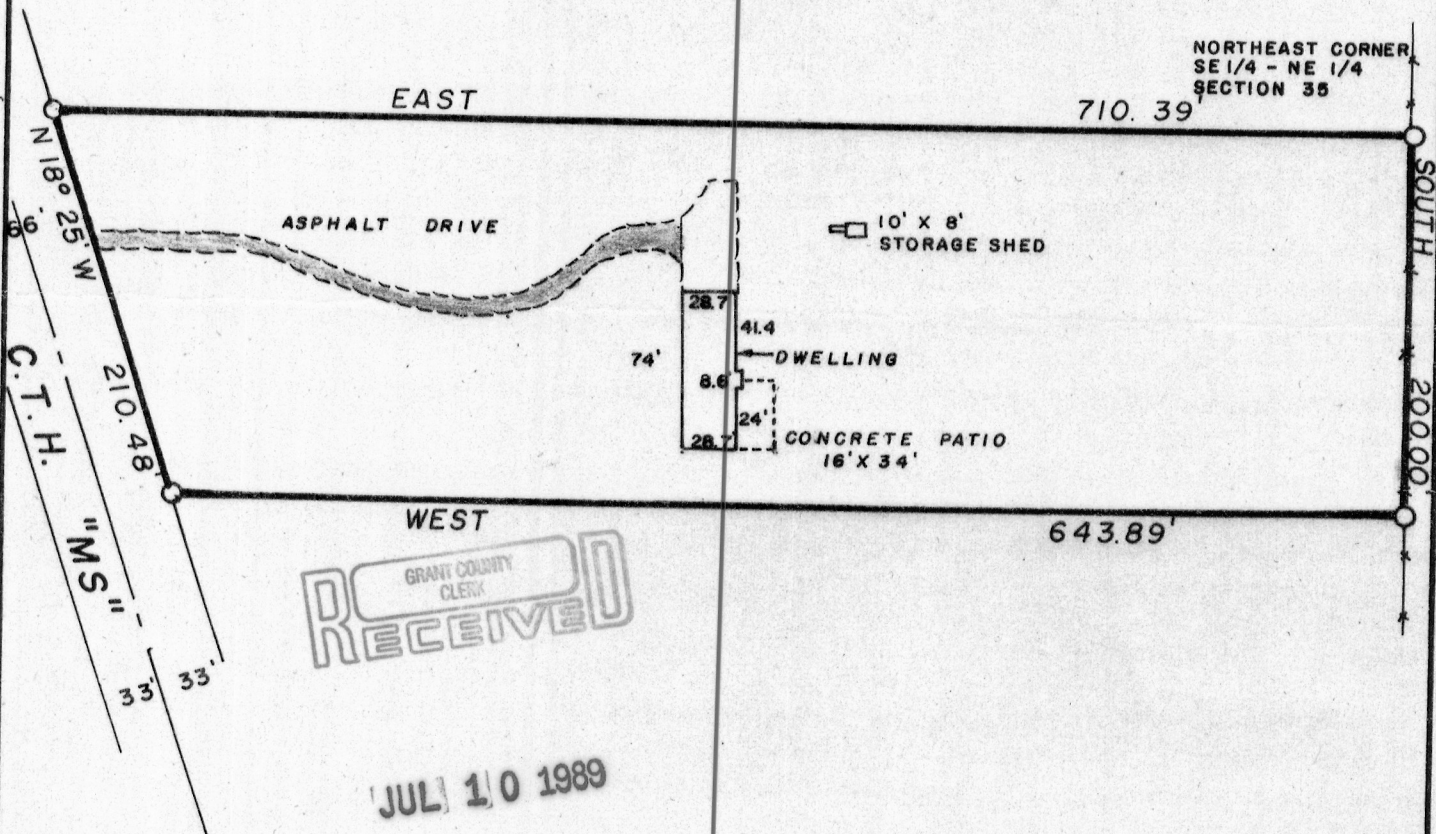

"WAIVER"

We hereby acknowledge that all standards set forth in the Wisconsin Administrative Code, A-E, 7, are being waived for minimum surveying requirements.


Owner/Agent _____ Date _____

Owner/Agent _____ Date _____

"I HAVE SURVEYED THE ABOVE DESCRIBED PROPERTY, AND THE ABOVE MAP IS A TRUE REPRESENTATION THEREOF AND SHOWS THE SIZE AND LOCATION OF THE PROPERTY, ITS EXTERIOR BOUNDARIES, THE LOCATION AND DIMENSIONS OF ALL STRUCTURES THEREON, FENCES, ROADWAYS, APPARENT EASEMENTS AND ENCROACHMENTS, IF ANY.

THIS SURVEY IS MADE FOR THE EXCLUSIVE USE OF THE PRESENT OWNERS OF THE PROPERTY, AND ALSO THOSE WHO PURCHASE, MORTGAGE OR GUARANTEE THE TITLE THEREOF, WITHIN ONE (1) YEAR FROM DATE HEREOF; AND AS TO THEM, I HEREBY CERTIFY THAT SAID SURVEY AND THE ABOVE MAP WERE MADE IN ACCORDANCE WITH ACCEPTABLE PROFESSIONAL STANDARDS AND THAT THE INFORMATION CONTAINED HEREON IS, TO THE BEST OF MY KNOWLEDGE, INFORMATION AND BELIEF A TRUE AND ACCURATE REPRESENTATION THEREOF.

DATED JULY 6, 1989

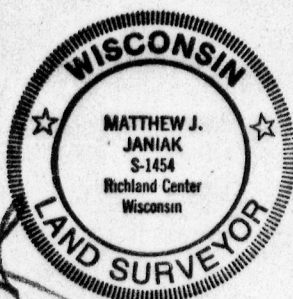

DRAFTED BY: S. WALSH

SHEET 1 OF 1

JOB NO. 586