


73

JUL 26 1989

JUL 26 1989


RECEIVED

SURVEY PLAT

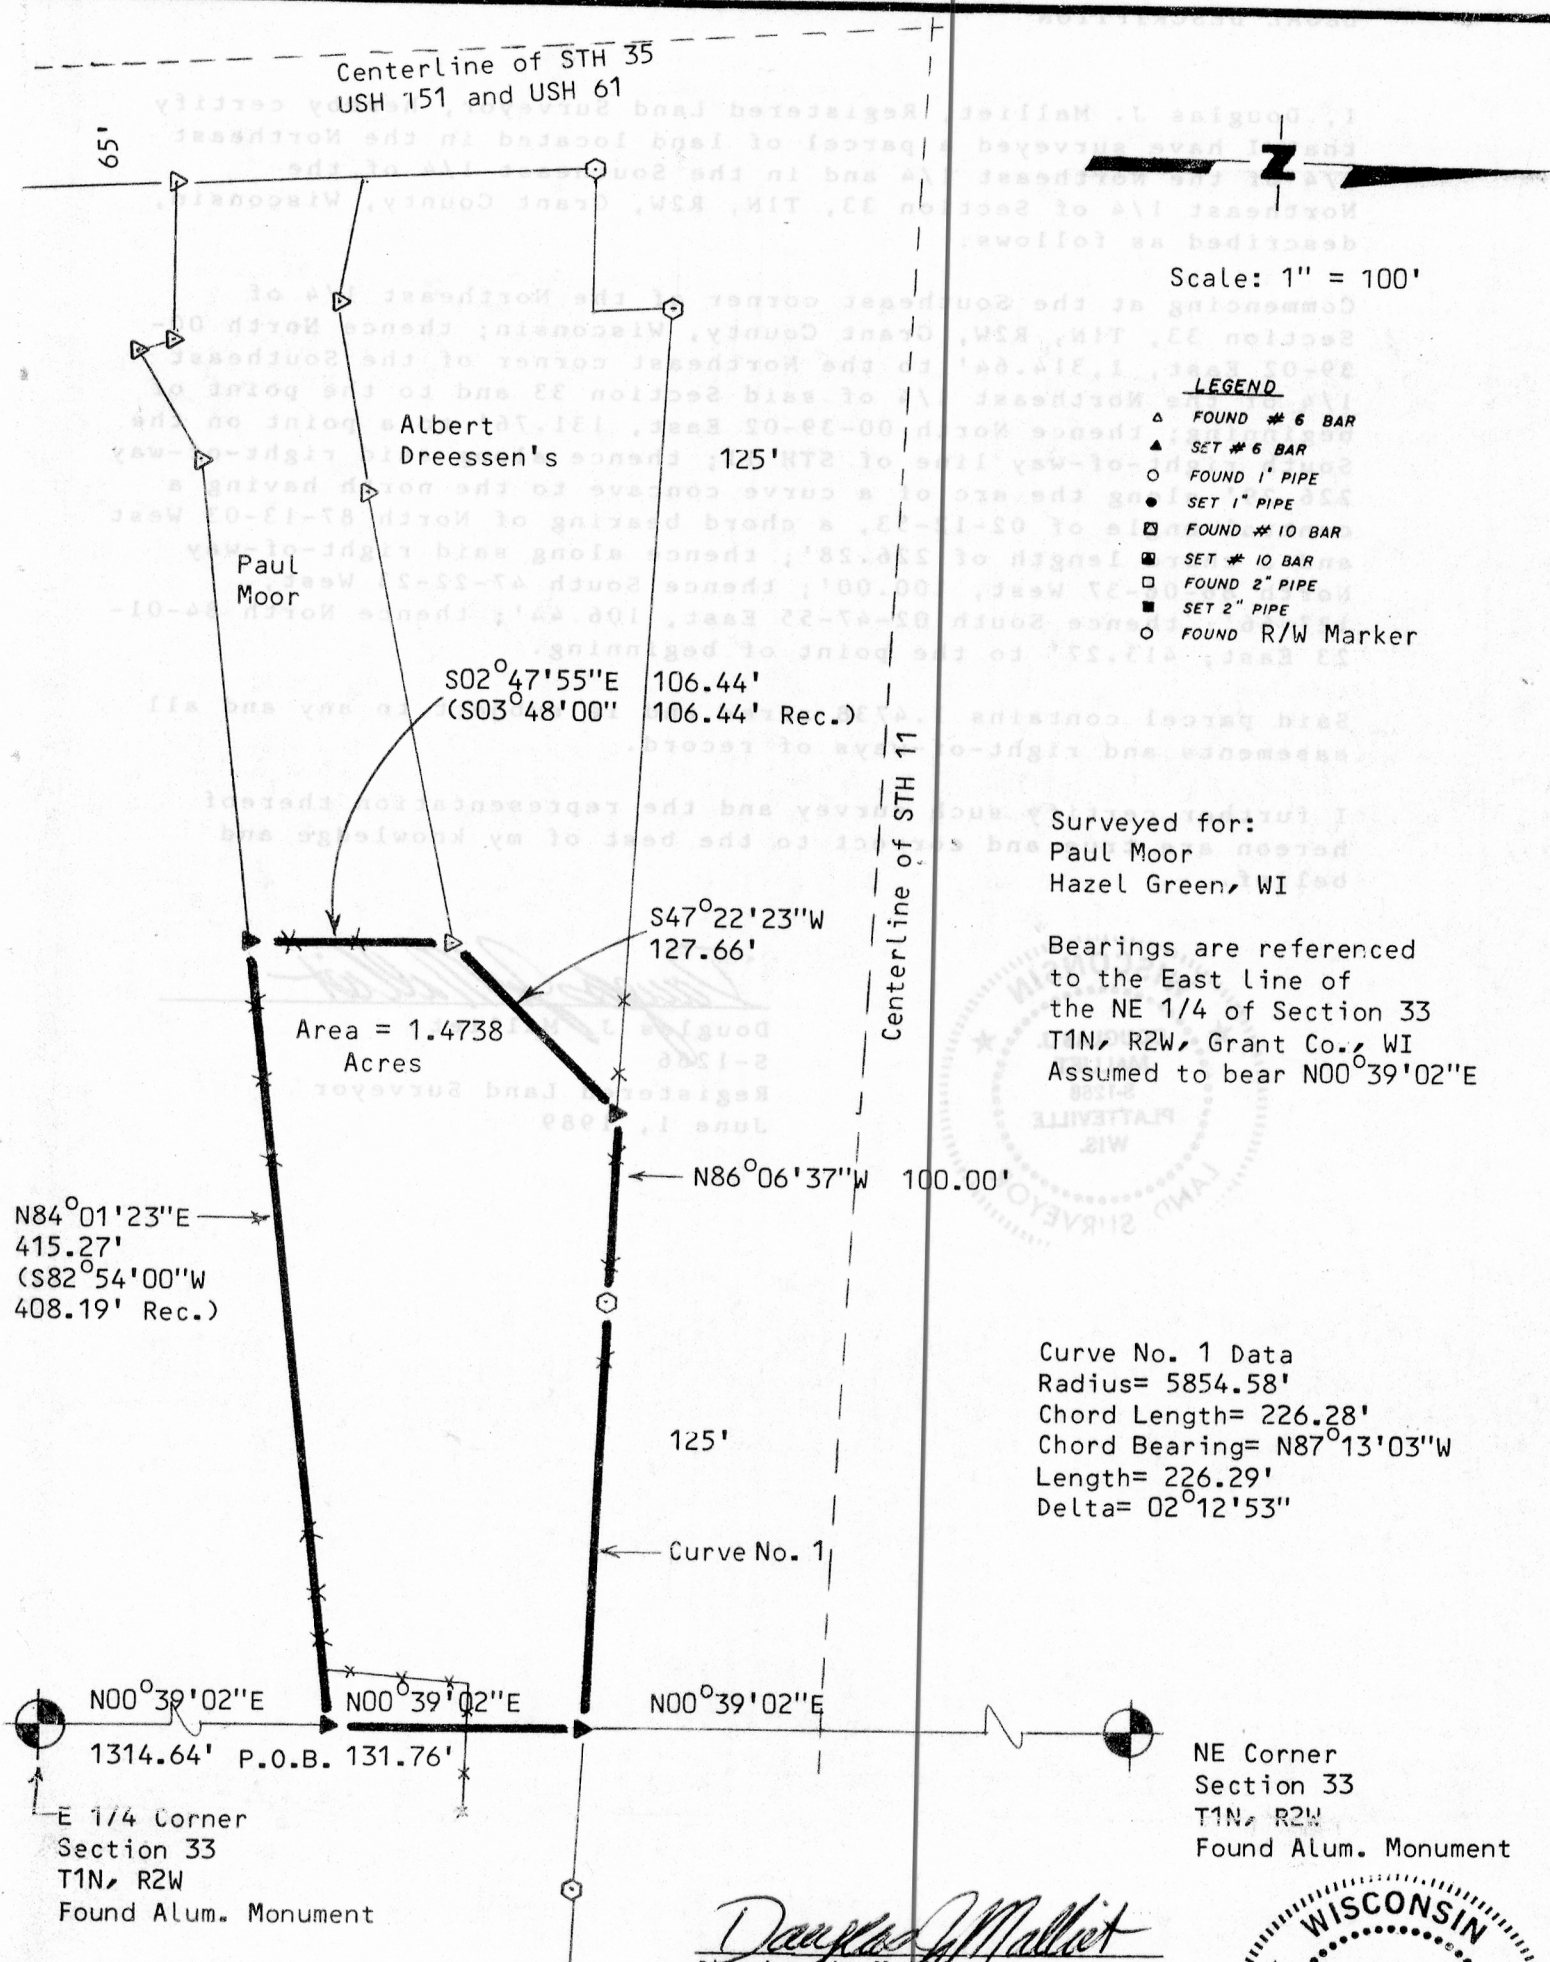

Douglas J. Malliet
Douglas J. Malliet
S-1266
Registered Land Surveyor
June 1, 1989

NE Corner
Section 33
T1N, R2W
Found Alum. Monument

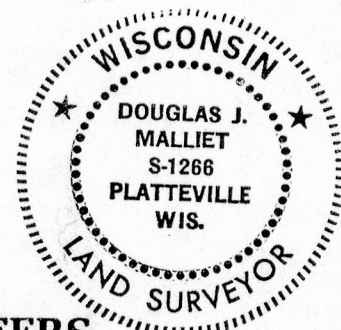

D. F. BURBACH MUNICIPAL & CIVIL ENGINEERS

Box 96B, Highway 80 South • PLATTEVILLE, WISCONSIN 53818 • (608) 348-3262

LEGAL DESCRIPTION

I, Douglas J. Malliet, Registered Land Surveyor, hereby certify that I have surveyed a parcel of land located in the Northeast 1/4 of the Northeast 1/4 and in the Southeast 1/4 of the Northeast 1/4 of Section 33, T1N, R2W, Grant County, Wisconsin, described as follows:

Commencing at the Southeast corner of the Northeast 1/4 of Section 33, T1N, R2W, Grant County, Wisconsin; thence North 00-39-02 East, 1,314.64' to the Northeast corner of the Southeast 1/4 of the Northeast 1/4 of said Section 33 and to the point of beginning; thence North 00-39-02 East, 131.76' to a point on the South right-of-way line of STH 11; thence along said right-of-way 226.29' along the arc of a curve concave to the north having a central angle of 02-12-53, a chord bearing of North 87-13-03 West and a chord length of 226.28'; thence along said right-of-way North 86-06-37 West, 100.00'; thence South 47-22-23 West, 127.66'; thence South 02-47-55 East, 106.44'; thence North 84-01-23 East, 415.27' to the point of beginning.

Said parcel contains 1.4738 acres and is subject to any and all easements and right-of-ways of record.

I further certify such survey and the representation thereof hereon are true and correct to the best of my knowledge and belief.



Douglas J. Malliet
Douglas J. Malliet
S-1266
Registered Land Surveyor
June 1, 1989

D. F. BURBACH MUNICIPAL & CIVIL ENGINEERS

Box 96B, Highway 80 South • Platteville, Wisconsin 53818 • (608) 348-3262