

82

GRANT COUNTY
CLERK
RECEIVED



PLAT OF SURVEY

FOR: PAT ROGERS

AUG 2 1989



PLAT BEARINGS ARE REFERENCED TO THE
SOUTH LINE OF THE SOUTHWEST 1/4 OF
SEC25, T2N, R1W, WHICH IS ASSUMED
TO BEAR S89°51'30"E BETWEEN
MONUMENTED CORNERS.

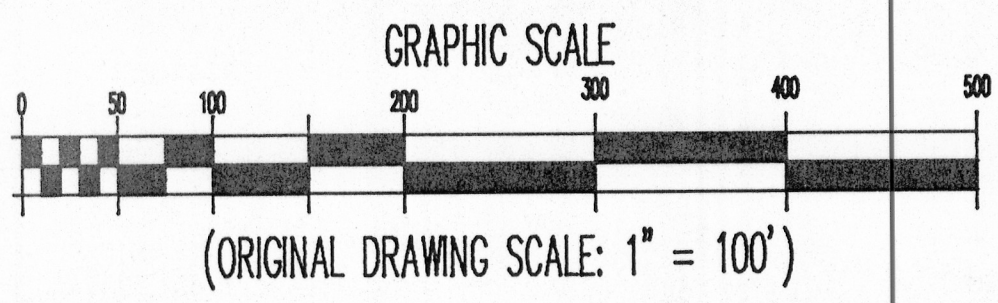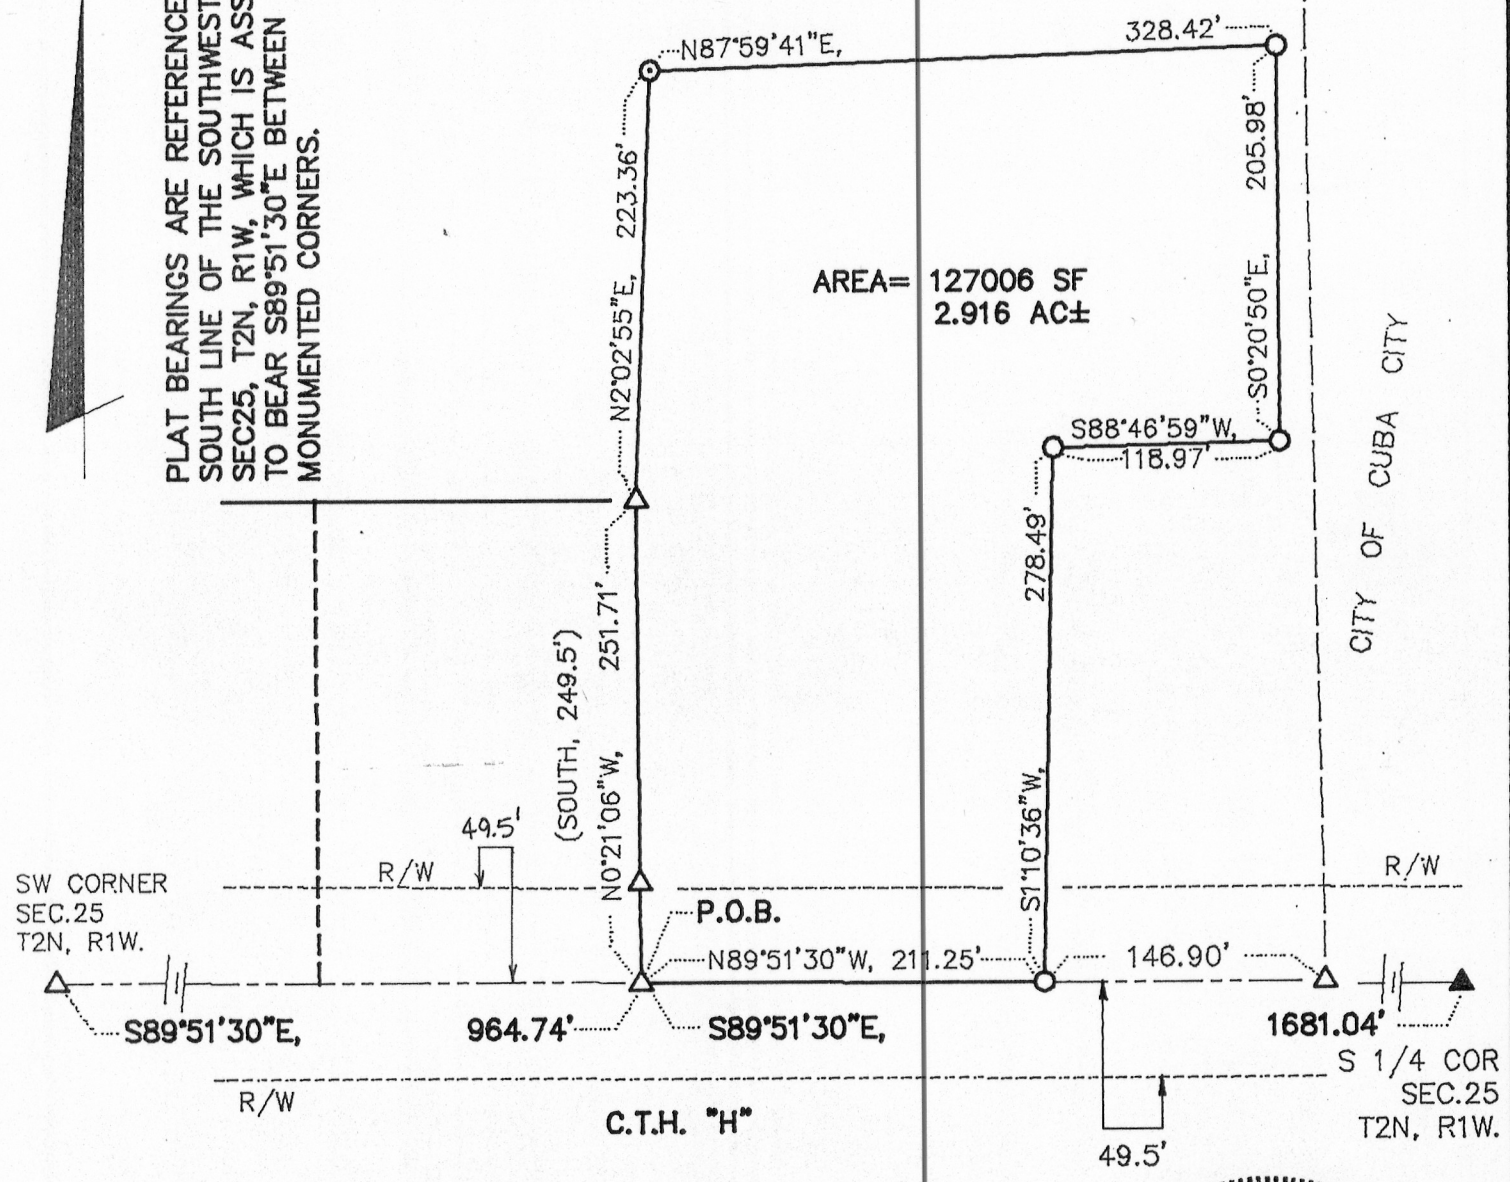

OFFICE DATA:	
JOB I.D.	89S-82
SURVEY CREW:	TSS & MAS
FIELD BOOK NO.:	89-2
DWG. STORED:	F:89S-82
DRAWN BY:	TSS
DRAWING NO.:	
DATA FILE NO.:	IBM 89-2

- LEGEND:
- 1"X24"X1.13 #/LF IRON PIPE SET
 - ⊙ 1-1/4"X24"X1.13 #/LF(MIN. WT.) IRON PIPE SET
 - ▲ RAILROAD SPIKE FOUND
 - △ IRON PIPE FOUND
 - () RECORDED AS

FOR: PAT ROGERS

Sheet 2 of 2
Job #89S-82

DESCRIPTION

A parcel of land located in the SW1/4 of Section 25, T2N, R1W, Grant County, Wisconsin, described as follows:

Commencing at the SW corner of said Section 25; thence S89°51'30"E, 964.74' to the point of beginning; thence N0°21'06"W, 251.71'; thence N2°02'55"E, 223.36' thence N87°59'41"E, 328.42'; thence S0°20'50"E, 205.98'; thence S88°46'59"W, 118.97'; thence S1°10'36"W, 278.49'; thence N89°51'30"W, 211.25' to the point of beginning. Parcel contains 2.916 acres, more or less, and is subject to any and all recorded easements or right-of-ways.

SURVEYOR'S CERTIFICATE

I hereby certify that I have made a survey according to the description and/or instructions furnished me and that the plat drawn hereon is a correct representation of that survey to the best of my knowledge & belief.

Laurence E. Schmit

Date: 7/19/89

Job #89S-084
2:08
889-3

