

RECEIVED

86




LEGEND

- | | |
|---|-----------------|
| △ | FOUND # 6 BAR |
| ▲ | SET # 6 BAR |
| ○ | FOUND 1" PIPE |
| ● | SET 1" PIPE |
| ◻ | FOUND # 10 BAR |
| ◼ | SET # 10 BAR |
| □ | FOUND 2" PIPE |
| ■ | SET 2" PIPE |
| ○ | FOUND R/R SPIKE |


Bearings are referenced to the West line of Block 12 of the Original Plat of the Village (now City) of Cuba City, T2N, R1W, Grant County, Wisconsin, assumed to bear N01-03-20E

SCALE: 1" = 30'

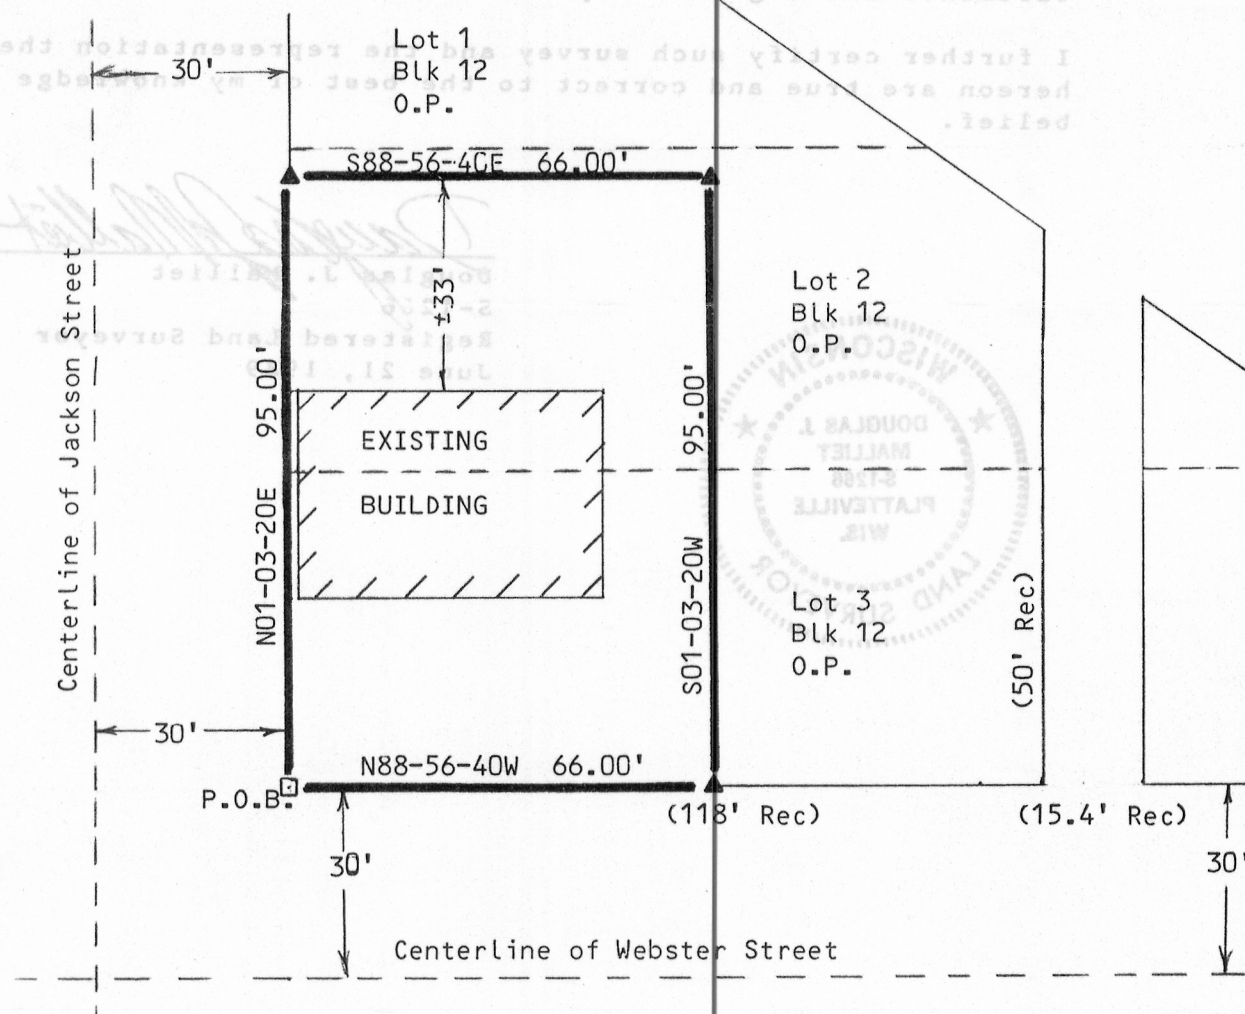

Mound City Bank
Platteville, WI

Douglas J. Malliet
S-1266
Registered Land Surveyor
June 21, 1989

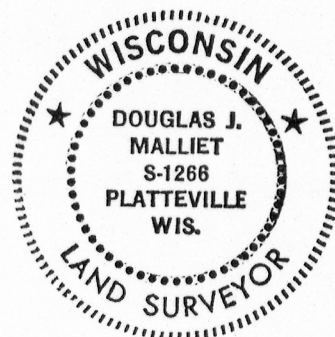

D. F. BURBACH MUNICIPAL & CIVIL ENGINEERS

82

SURVEY PLAT

LEGAL DESCRIPTION

I, Douglas J. Malliet, Registered Land Surveyor, hereby certify that I have surveyed a parcel of land located in the Block 12 of the Original Plat of the Village (now City) of Cuba City, T2N, R1W, Grant County, Wisconsin, described as follows:

Beginning at the Southwest Corner of Block 12 of the Original Plat of the Village (now City) of Cuba City; thence North 01-03-20 East, 95.00' along the West line of said Block 12; thence South 88-56-40 East, 66.00'; thence South 01-03-20 West, 95.00' to a point on the South line of said Block 12; thence North 88-56-40 West, 66.00' to the point of beginning.

Said parcel contains 0.1439 acres and is subject to any and all easements and right-of-ways of record.

I further certify such survey and the representation thereof hereon are true and correct to the best of my knowledge and belief.

Douglas J. Malliet
Douglas J. Malliet

S-1266
Registered Land Surveyor
June 21, 1989

