

BENCHMARK SURVEYS, INC.
P. O. BOX 486 608 / 647-8533
RICHLAND CENTER, WISCONSIN. 53581



SCALE 1" = 30'

Mortgage Inspection
PLAT OF SURVEY

FOR

F&M BANK
FENNIMORE

DESCRIPTION

Lot 31 of Foxmoor Heights being located in part of the Southwest One-quarter of Section 19, Township 6 North, Range 2 West, City of Fennimore, Grant County, Wisconsin.

15th STREET

(NOT CONSTRUCTED)


S 89°23'50"E

110.00'

N 00°36'10"E

110.00'

31

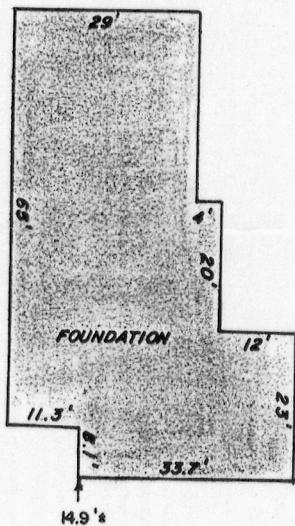

N 89°23'50"W

140.00'

S 00°36'10"W

80.00'

(NOT CONSTRUCTED)

FOXMOOR DRIVE

30'

30'

- - 2" IRON PIPE FOUND
- - 3" IRON PIPE FOUND

WAIVER

We hereby acknowledge that all standards set forth in the Wisconsin Administrative Code A-E 7, for minimum surveying standards, are being waived.

Owner/Agent

Date


Owner/Agent

Date

"I HAVE SURVEYED THE ABOVE DESCRIBED PROPERTY, AND THE ABOVE MAP IS A TRUE REPRESENTATION THEREOF AND SHOWS THE SIZE AND LOCATION OF THE PROPERTY, ITS EXTERIOR BOUNDARIES, THE LOCATION AND DIMENSIONS OF ALL STRUCTURES THEREON, FENCES, ROADWAYS, APPARENT EASEMENTS AND ENCROACHMENTS, IF ANY.

THIS SURVEY IS MADE FOR THE EXCLUSIVE USE OF THE PRESENT OWNERS OF THE PROPERTY, AND ALSO THOSE WHO PURCHASE, MORTGAGE OR GUARANTEE THE TITLE THEREOF, WITHIN ONE (1) YEAR FROM DATE HEREOF; AND AS TO THEM I HEREBY CERTIFY THAT SAID SURVEY AND THE ABOVE MAP WERE MADE IN ACCORDANCE WITH ACCEPTABLE PROFESSIONAL STANDARDS AND THAT THE INFORMATION CONTAINED HEREON IS, TO THE BEST OF MY KNOWLEDGE, INFORMATION AND BELIEF A TRUE AND ACCURATE REPRESENTATION THEREOF.

DATED August 22, 1989

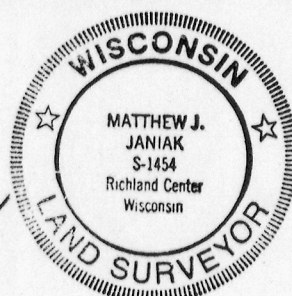

DRAFTED BY: MJJ

SHEET 1 OF 1

JOB NO. 600