

SURVEY PLAT

125

Survey for: Thomas A. Finney

August 28, 1989


SHEET 1 OF 1

SEP 14 1989

DESCRIPTION:

The WEST 15 feet of Lot 6 and the EAST 35 feet of Lot 7, Jack Oak Addition, Village of Cassville, Section 28, T 3 N, R 5 W, Grant County, Wisconsin.

PURPOSE: To locate the North and West Line of the above described property.

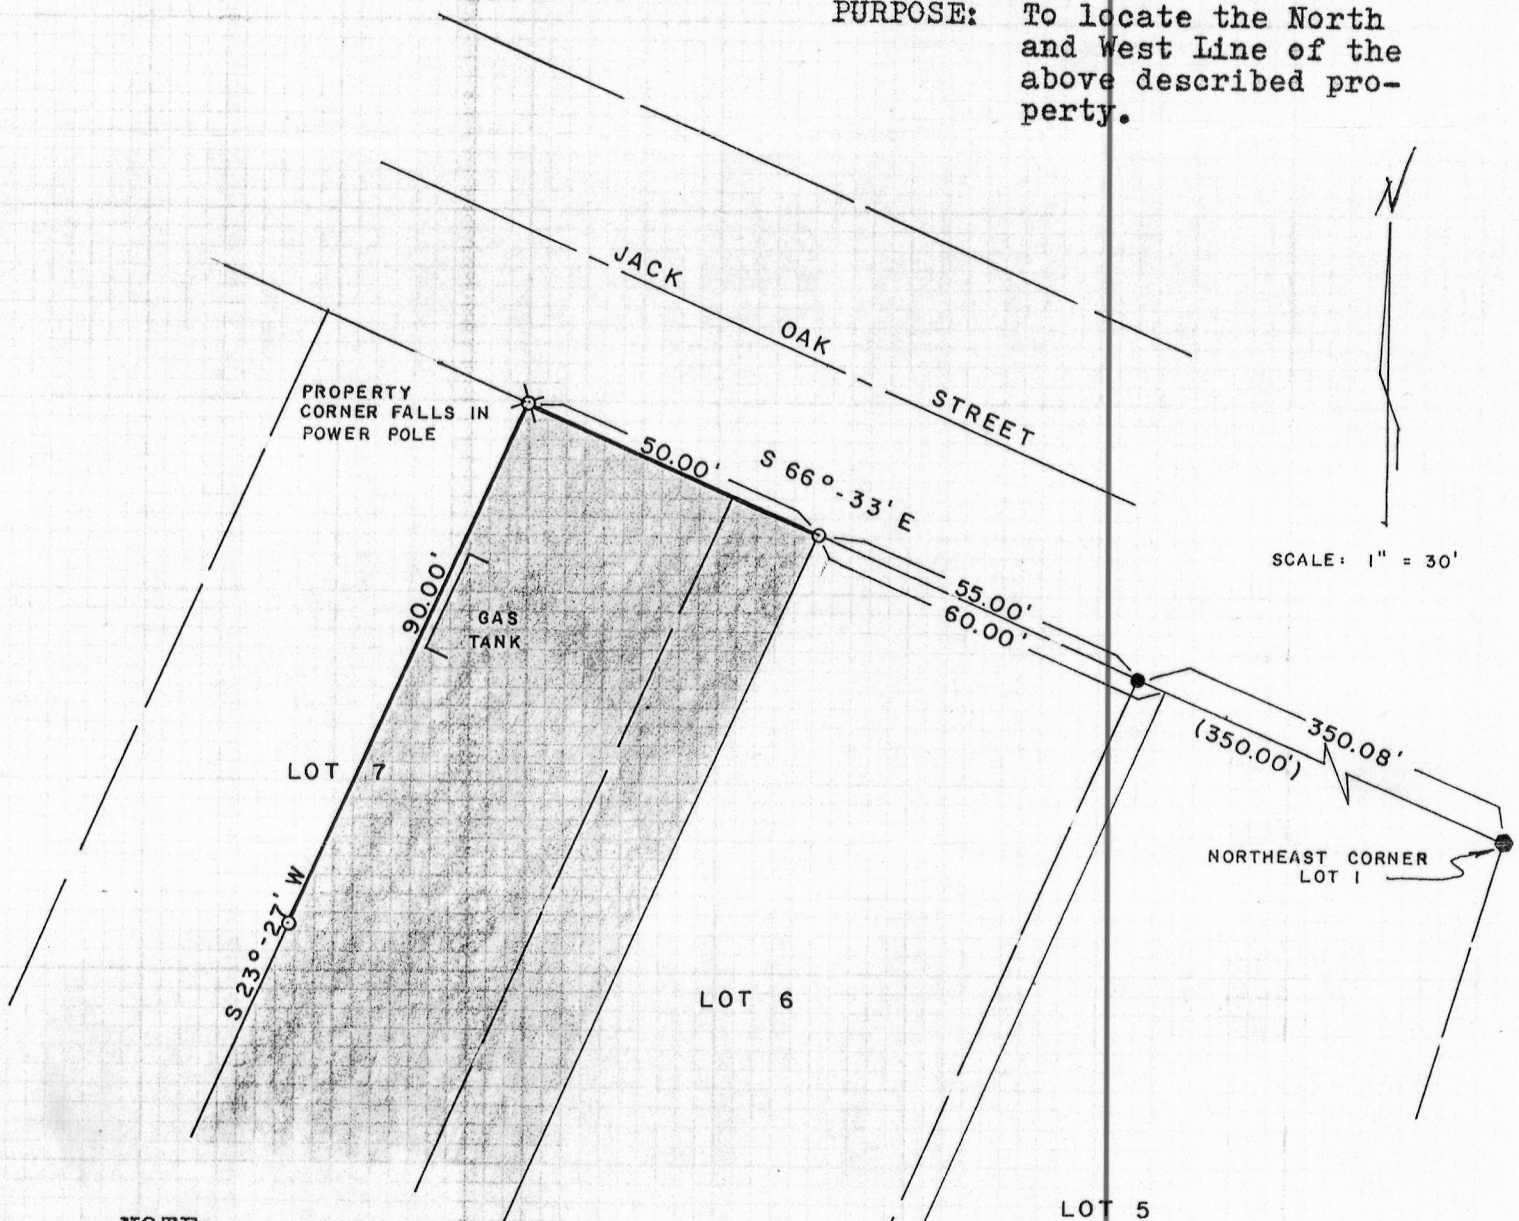

NOTE:

Bearings are referenced to the South Right-of-Way of Jack Oak Street, Platted S 66°-33' E.

LEGEND:

- 2" DIA. IRON PIPE LOCATED
- 1" DIA. IRON PIPE LOCATED
- ⊗ POWER POLE
- 1" ID x 24" IRON PIPE WEIGHING 1.13 lbs./lin. ft. or more PLACED
- (350.00') Previously Described As



I certify that I have surveyed the above described parcel of land and that the following Plat is an accurate survey and a true representation thereof and correctly shows the exterior boundary lines of said parcel and the correct measurements thereof to the best of my knowledge and belief.

WOODLAND CONSULTANTS, INC.

P.O. Box 548
755 Valley View Drive
Richland Center, WI 53581-0548
(608) 647-2191

Terry L. Cornell
TERRY L. CORNELL
REGISTERED LAND SURVEYOR S-1905