

SURVEY PLAT

Survey for: Miles Wolhowe

SHEET 1 OF 1


August 28, 1989

126

SEP 14 1989

DESCRIPTION:

Lot 5, Jack Oak Addition, except 5 feet off the East Side and except 5 feet off the West Side, Village of Cassville, Section 28, T3N, R5W, Grant County, Wisconsin.

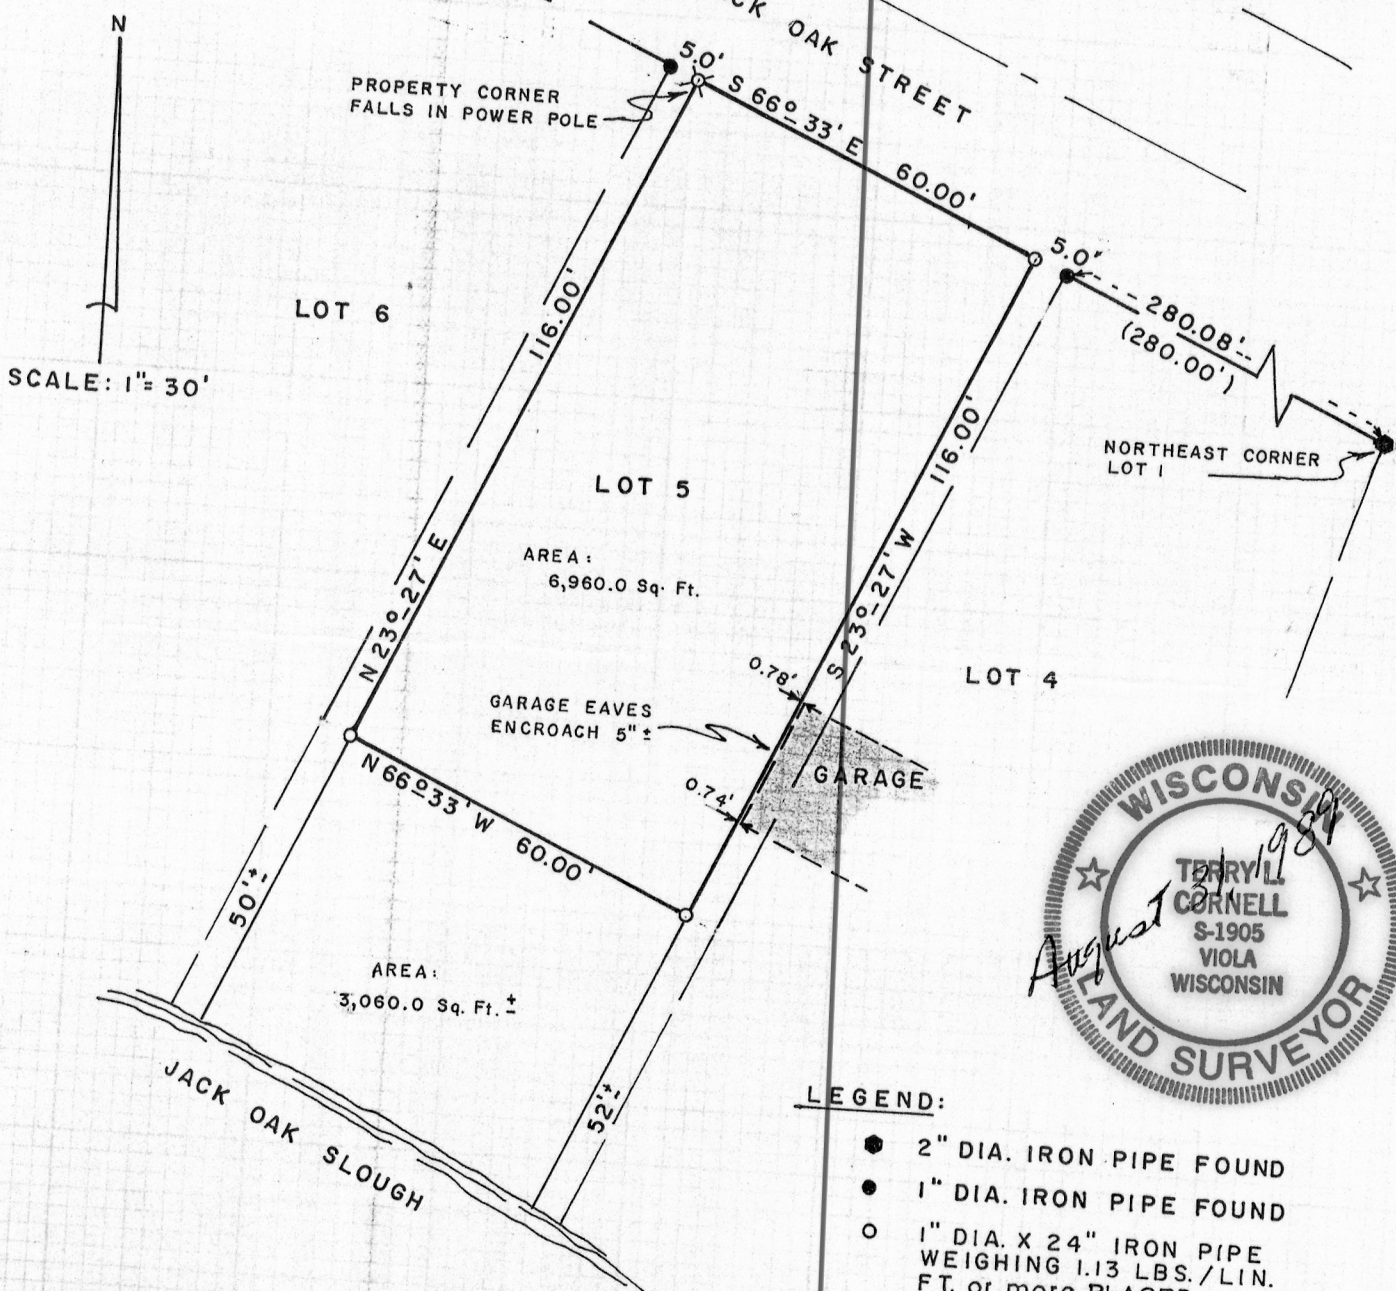

LEGEND:

- 2" DIA. IRON PIPE FOUND
- 1" DIA. IRON PIPE FOUND
- 1" DIA. X 24" IRON PIPE WEIGHING 1.13 LBS./LIN. FT. or more PLACED.
- ✕ POWER POLE
- (280.00') PREVIOUSLY RECORDED AS

NOTE:

Bearings are referenced to the South Right-of-Way of Jack Oak Street, Platted S 66°-33' E.

I certify that I have surveyed the above described parcel of land and that the following Plat is an accurate survey and a true representation thereof and correctly shows the exterior boundary lines of said parcel and the correct measurements thereof to the best of my knowledge and belief.

Terry L. Cornell
TERRY L. CORNELL
REGISTERED LAND SURVEYOR S-1905

WOODLAND CONSULTANTS, INC.

P.O. Box 548
755 Valley View Drive
Richland Center, WI 53581-0548
(608) 647-2191

770.001