


MORTGAGE SURVEY

APR 12 1990

APR 12 1990



SCALE 1" = 40'

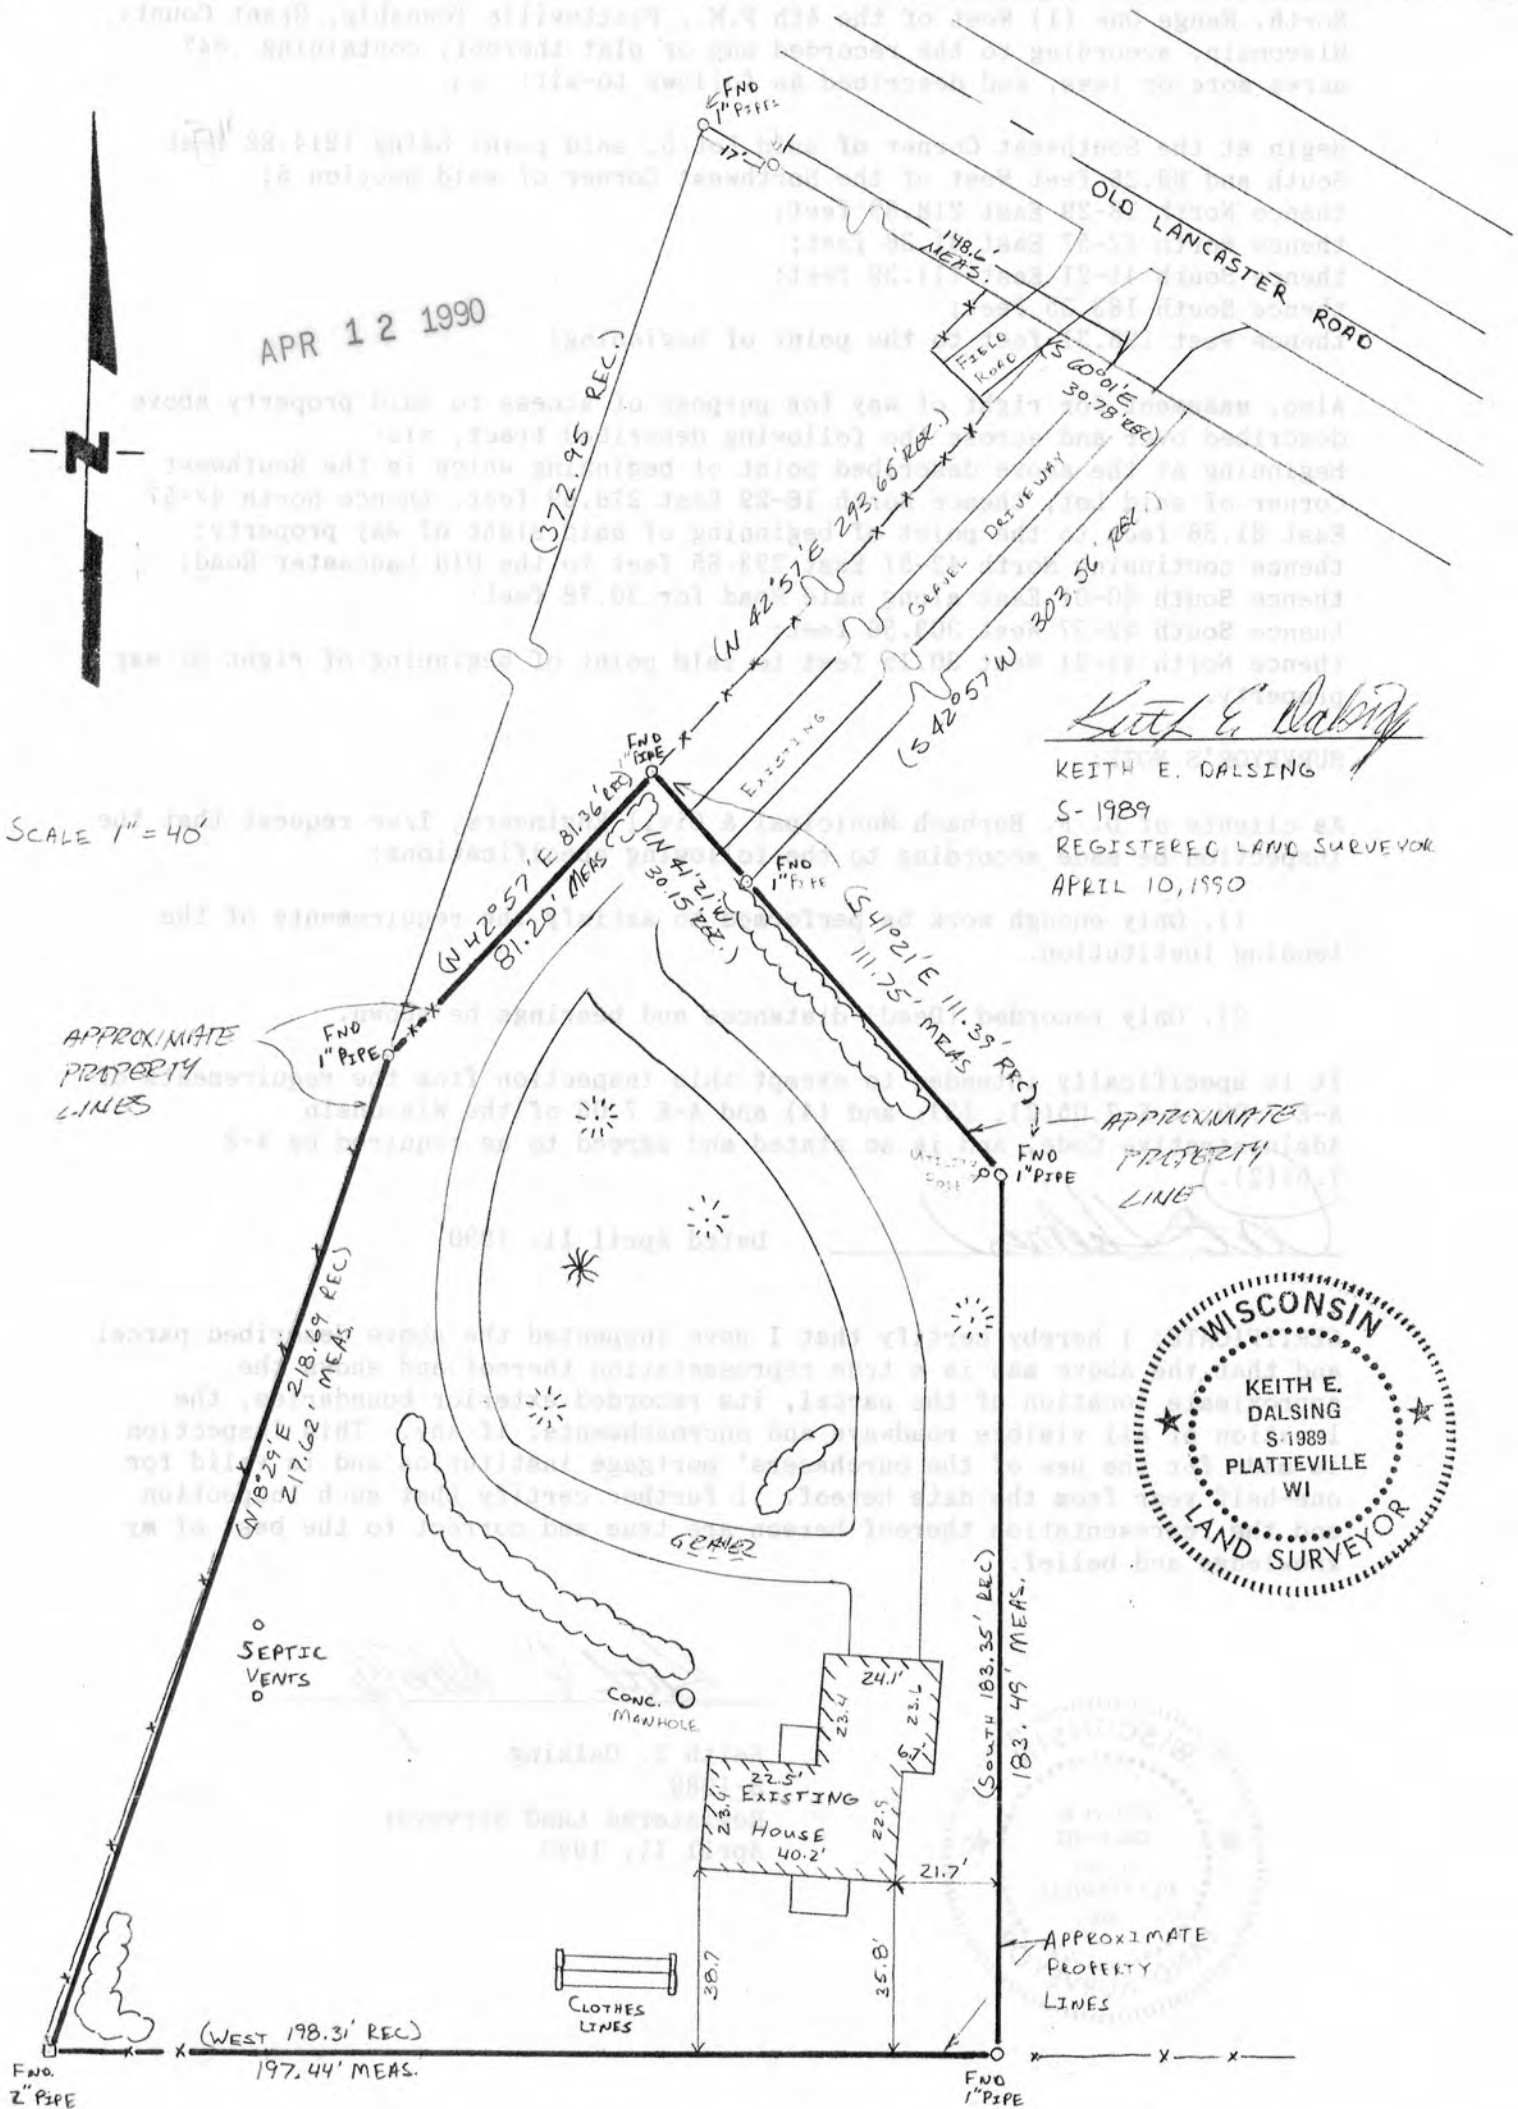

Keith E. Dalsing
 KEITH E. DALSSING
 S-1989
 REGISTERED LAND SURVEYOR
 APRIL 10, 1990



D. F. BURBACH MUNICIPAL & CIVIL ENGINEERS

5992 STATE HIGHWAY 80 SOUTH • PLATTEVILLE, WISCONSIN 53818 • (608) 348-3262

18

MORTGAGE SURVEY

LEGAL DESCRIPTION:

Part of Lot Five (5) of Blindert Acres, Section Five (5), Township Three (3) North, Range One (1) West of the 4th P.M., Platteville Township, Grant County, Wisconsin, according to the recorded map or plat thereof, containing .847 acres more or less, and described as follows to-wit:

Begin at the Southwest Corner of said Lot 5, said point being 1214.82 feet South and 89.26 feet West of the Northwest Corner of said Section 5; thence North 18-29 East 218.69 feet; thence North 42-57 East 81.36 feet; thence South 41-21 East 111.39 feet; thence South 183.35 feet; thence West 198.31 feet to the point of beginning;

DEED S I 871A

Also, easement for right of way for purpose of access to said property above described over and across the following described tract, viz: Beginning at the above described point of beginning which is the Southwest Corner of said Lot, thence North 18-29 East 218.69 feet, thence North 42-57 East 81.36 feet to the point of beginning of said right of way property; thence continuing North 42-57 East 293.65 feet to the Old Lancaster Road; thence South 60-01 East along said Road for 30.78 feet; thence South 42-57 West 303.56 feet; thence North 41-21 West 30.15 feet to said point of beginning of right of way property.

SURVEYOR'S NOTE:

As clients of D. F. Burbach Municipal & Civil Engineers, I/we request that the inspection be made according to the following specifications:

- 1). Only enough work be performed to satisfy the requirements of the lending institution.
- 2). Only recorded (Deed) distances and bearings be shown.

It is specifically intended to exempt this inspection from the requirements of A-E 7.03, A-E 7.05(2), (3), and (4) and A-E 7.06 of the Wisconsin Administrative Code, and is so stated and agreed to as required by A-E 7.01(2).

[Signature]

Dated April 11, 1990

CERTIFICATE: I hereby certify that I have inspected the above described parcel and that the above map is a true representation thereof and shows the approximate location of the parcel, its recorded exterior boundaries, the location of all visible roadways and encroachments, if any. This inspection is made for the use of the purchasers' mortgage institution and is valid for one-half year from the date hereof. I further certify that such inspection and the representation thereof hereon are true and correct to the best of my knowledge and belief.

[Signature]

Keith E. Dalsing
S-1989
Registered Land Surveyor
April 11, 1990

