

MORTGAGE SURVEY



SCALE 1" = 40'


Keith E. Dalsing

KEITH E. DALSIING

S-1989

REGISTERED LAND SURVEYOR

APRIL 24, 1990

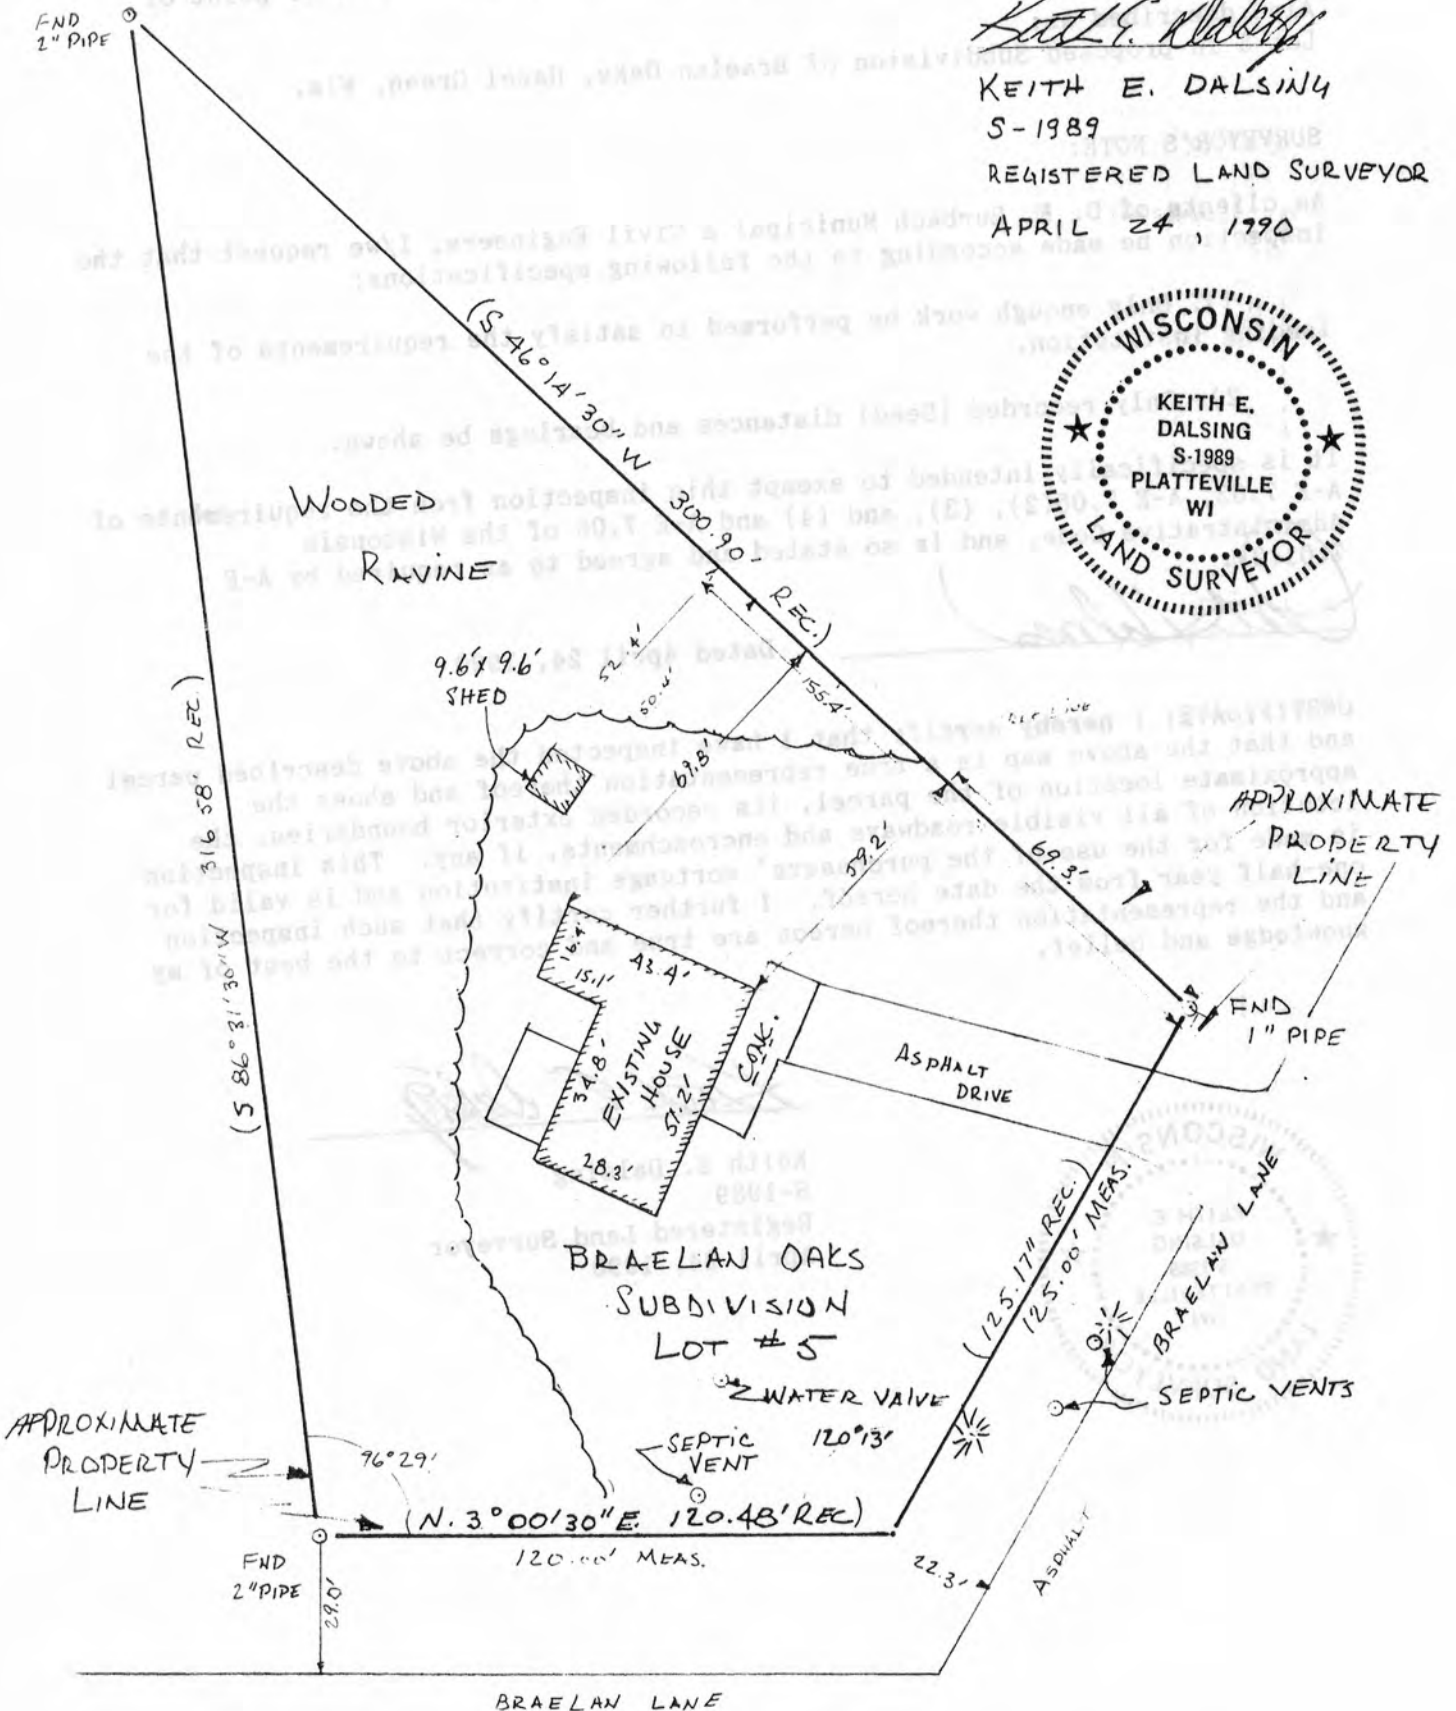

D. F. BURBACH MUNICIPAL & CIVIL ENGINEERS

04

MORTGAGE SURVEY

LEGAL DESCRIPTION:

A tract of land in the N.W.1/4, Section 21, T 1 N, R 2 W being in Jamestown Township, Grant Co., Wis., commencing at the Northeast Corner of the N.W.1/4, Section 21, T 1 N, R 2 W, thence South 00 degrees 11' West on the North-South quarter Section Line a distance of 579.95 ± feet, thence continuing South 00 degrees 11' West, 212.05 feet, thence South 2 degrees 37 1/2' West, 229.00 feet, thence South 2 degrees 02 1/2' West, 161.58 feet, thence continuing South 2 degrees 02 1/2' West, 119.70 feet, thence South 3 degrees 00 1/2' West, 95.29 feet, thence North 56 degrees 46 1/2' West, 0.87 feet, thence South 3 degrees 00 1/2' West, 150.88 feet, thence South 86 degrees 31 1/2' West, 66.42 feet, to point of beginning of the tract herein being described, thence continuing South 86 degrees 31 1/2' West, 316.58 feet, thence North 46 degrees 14 1/2' East, 300.90 feet, thence South 56 degrees 46 1/2' East, 125.17 feet, thence South 3 degrees 00 1/2' West, 120.48 feet to point of beginning.

Also described as:
Lot 5 in proposed Subdivision of Braelan Oaks, Hazel Green, Wis.

SURVEYOR'S NOTE:

As clients of D. F. Burbach Municipal & Civil Engineers, I/we request that the inspection be made according to the following specifications:

- 1). Only enough work be performed to satisfy the requirements of the lending institution.
- 2). Only recorded (Deed) distances and bearings be shown.

It is specifically intended to exempt this inspection from the requirements of A-E 7.03, A-E 7.05(2), (3), and (4) and A-E 7.06 of the Wisconsin Administrative Code, and is so stated and agreed to as required by A-E 7.01(2).

[Signature]

Dated April 24, 1990

CERTIFICATE; I hereby certify that I have inspected the above described parcel and that the above map is a true representation thereof and shows the approximate location of the parcel, its recorded exterior boundaries, the location of all visible roadways and encroachments, if any. This inspection is made for the use of the purchasers' mortgage institution and is valid for one-half year from the date hereof. I further certify that such inspection and the representation thereof hereon are true and correct to the best of my knowledge and belief.

[Signature]

Keith E. Dalsing
S-1989
Registered Land Surveyor
April 24, 1990



D. F. BURBACH MUNICIPAL & CIVIL ENGINEERS