

Sec. 1, T4N, R4W

PLAT OF SURVEY FOR RICHARD WEBER

REC'D APR 22 1998

WEST 1/4 CORNER, SECTION 1
T4N R4W, 4TH P.M., GRANT CO., WI
SET NO. 8 X 30" REBAR WITH
GRANT COUNTY ALUMINUM CAP

EAST 1/4 CORNER, SECTION 1
SET NO. 8 X 30" REBAR WITH
GRANT COUNTY ALUMINUM CAP

S 00°57'46" E 514.79'

N 89°37'24" W

5368.65'

POINT OF BEGINNING

S 00°57'46" E
2658.70'

N 77°14'23" E 28.23'
N 80°42'59" E 358.69'
N 82°41'20" E 315.33'
N 74°47'16" E 343.58'
N 69°19'30" E 440.33'
N 88°12'41" E 397.96'
S 84°16'03" E 405.15'

S 75°37'54" E 475.02'
N 81°52'21" E 162.62'
S 56°06'54" E 145.37'
N 79°40'24" E 322.56'
N 72°29'41" E 100.69'
N 61°13'40" E 190.06'
N 44°45'19" E 195.19'

257.84' TO NO. 6 REBAR
N 28°55'08" E 165.82'
N 32°14'31" E 280.21'

N 19°11'37" E TO THE EAST LINE OF THE
OF THE WEST 1/2 OF THE NORTHEAST 1/4
TO THE TERMINUS POINT



Larry L. Austin
3-18-98
Revised
3-23-98


LEGEND

- 3/4" X 24" REBAR SET
 - x-x- EXISTING FENCE - SHOWN FOR REFERENCE ONLY
- BEARINGS REFERENCED TO THE EAST-WEST 1/4 LINE OF SECTION 1, WHICH IS ASSUMED TO BEAR N 89°37'24" W.



SCALE 1" = 500'

SOUTHWEST CORNER, SECTION 1
NO. 6 REBAR WITH GRANT COUNTY
ALUMINUM CAP FOUND

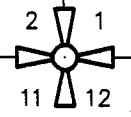

AUSTIN ENGINEERING, LLC. 4211 HWY 81 E, LANCASTER, WI 53813 PHONE 608-723-6363 FAX 608-723-6702	
DRAWN BY: AJ AUSTIN APPROVED: LL AUSTIN CREW: BS - DK SHEET 1 OF 2	FIELDBOOK: 9805 C:\SURVEY3\T4NR4W\03 C:\EPSA\PROGRAM\T4NR4W\01DW

PLAT OF SURVEY FOR RICHARD WEBER


A LINE BEING BEING DESCRIBED AS FOLLOWS:

COMMENCING AT THE WEST 1/4 CORNER OF SECTION 1, TOWN 4 NORTH, RANGE 4 WEST OF THE 4TH P.M., GRANT COUNTY, WISCONSIN;
THENCE S 00°57'46" E 514.79' ALONG THE WEST LINE OF SAID SECTION 1 TO THE POINT OF BEGINNING;
THENCE N 77°14'23" E 28.23' TO A NO. 6 REBAR;
THENCE N 80°42'59" E 358.69' TO A NO. 6 REBAR;
THENCE N 82°41'20" E 315.33' TO A NO. 6 REBAR;
THENCE N 74°47'16" E 343.58' TO A NO. 6 REBAR;
THENCE N 69°19'30" E 440.33' TO A NO. 6 REBAR;
THENCE N 88°12'41" E 397.96' TO A NO. 6 REBAR;
THENCE S 84°16'03" E 405.15' TO A NO. 6 REBAR;
THENCE S 75°37'54" E 475.02' TO A NO. 6 REBAR;
THENCE N 81°52'21" E 162.62' TO A NO. 6 REBAR;
THENCE S 56°06'54" E 145.37' TO A NO. 6 REBAR;
THENCE N 79°40'24" E 322.56' TO A NO. 6 REBAR;
THENCE N 72°29'41" E 100.69' TO A NO. 6 REBAR;
THENCE N 61°13'40" E 190.06' TO A NO. 6 REBAR;
THENCE N 44°45'19" E 195.19' TO A NO. 6 REBAR;
THENCE N 32°14'31" E 280.21' TO A NO. 6 REBAR;
THENCE N 28°55'08" E 165.82' TO A NO. 6 REBAR;
THENCE N 19°11'37" E TO THE EAST LINE OF THE WEST 1/2 OF THE NORTHEAST 1/4 AND THE TERMINUS POINT.

SURVEYOR'S CERTIFICATE:

I, LARRY L. AUSTIN, REGISTERED WISCONSIN LAND SURVEYOR, DO HEREBY CERTIFY THAT THE ABOVE DESCRIPTION WAS SURVEYED, MAPPED, AND MONUMENTED BY ME OR UNDER MY DIRECT SUPERVISION, ALL IN ACCORDANCE WITH THE INSTRUCTIONS OF RICHARD WEBER AND TO THE BEST OF MY KNOWLEDGE AND BELIEF, THIS PLAT IS AN ACCURATE REPRESENTATION THEREOF.

DATED THIS 18TH DAY OF MARCH, 1998
REVISED THIS 23RD DAY OF MARCH, 1998.

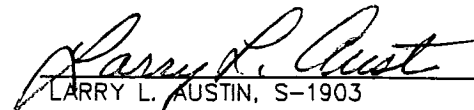
LARRY L. AUSTIN, S-1903

AUSTIN ENGINEERING, LLC.

4211 HWY 81 E, LANCASTER, WI 53813
PHONE 608-723-6363 FAX 608-723-6702

DRAWN BY: AJ AUSTIN
APPROVED: LL AUSTIN
CREW: BS - DK
SHEET 2 OF 2

FIELDBOOK: 9805
C:\SURVEY3\T4NR4W\03
C:\EPSA\PROGRAM\T4NR4W\01DW