

MAPLE


BOUNDARY AND SITE MAP

OF THE

GRANT COUNTY COURTHOUSE PARCEL

STREET

BEING THE PUBLIC SQUARE AS SHOWN ON THE ORIGINAL PLAT OF THE VILLAGE OF LANCASTER, LOCATED IN THE NORTHWEST QUARTER OF THE SOUTHEAST QUARTER OF SECTION 3, TOWN 4 NORTH, RANGE 3 WEST, GRANT COUNTY, WI.

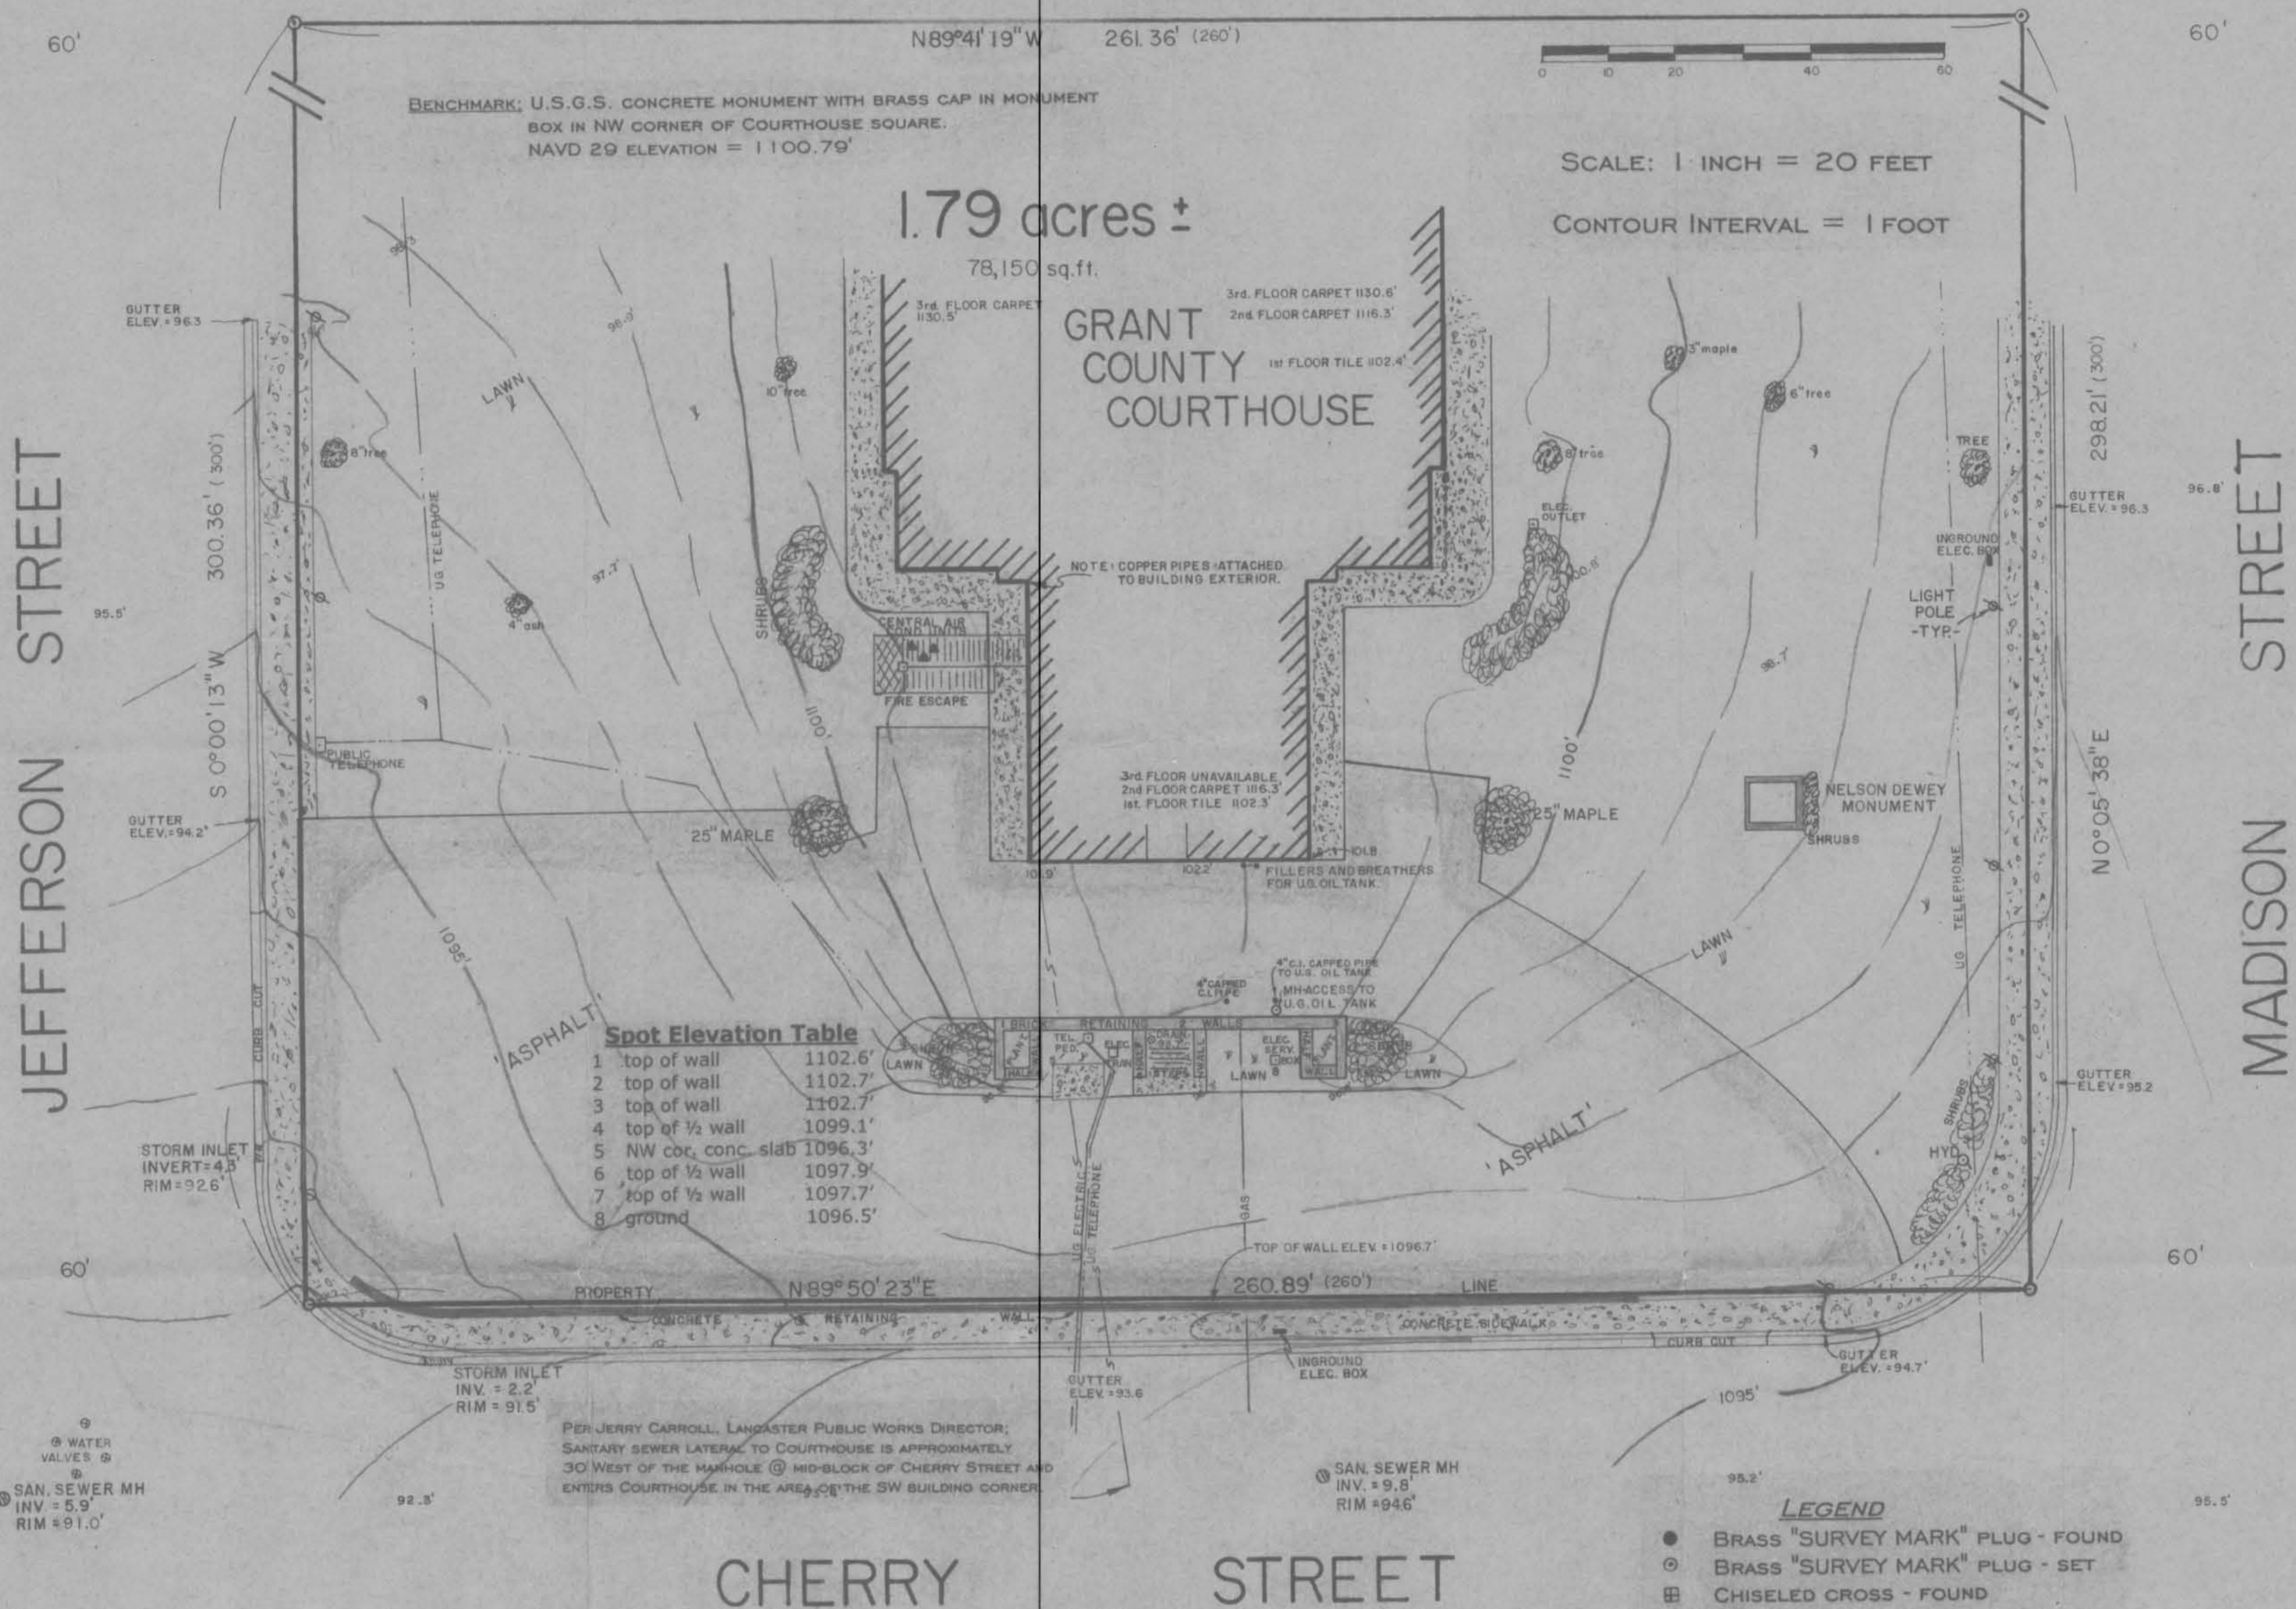

Spot Elevation Table

1	top of wall	1102.6'
2	top of wall	1102.7'
3	top of wall	1102.7'
4	top of 1/2 wall	1099.1'
5	NW cor. conc. slab	1096.3'
6	top of 1/2 wall	1097.9'
7	top of 1/2 wall	1097.7'
8	ground	1096.5'

LEGEND

- BRASS "SURVEY MARK" PLUG - FOUND
- ⊙ BRASS "SURVEY MARK" PLUG - SET
- ⊕ CHISELED CROSS - FOUND
- () RECORDED AS

UTILITY LOCATIONS SHOWN ARE APPROXIMATE. LOCATION SERVICES PROVIDED BY SMP, INC. AND THE CITY OF LANCASTER. CONTACT DIGGER'S HOTLINE (800-242-8511) BEFORE EXCAVATING.

SURVEYOR'S CERTIFICATE

I, BRUCE D. BOWDEN, REGISTERED WISCONSIN LAND SURVEYOR, S-1250, DO HEREBY CERTIFY THAT I HAVE SURVEYED, DESCRIBED, MAPPED AND MONUMENTED THE PROPERTY SHOWN HEREON IN ACCORDANCE WITH THE INSTRUCTIONS OF MS. CHRIS CASTA, GRANT COUNTY CLERK, AND THAT THIS MAP IS A CORRECT REPRESENTATION THEREOF TO THE BEST OF MY KNOWLEDGE AND BELIEF.

Bruce D. Bowden
BRUCE D. BOWDEN, R.L.S. - LAND SURVEYOR

JUNE 15, 1998
DATE

BOWDEN SURVEYING, LTD.

619 W. MERRIMAC STREET
DODGEVILLE, WI 53533
PHONE (608) 935-5513

NOTE: BEARINGS ARE REFERENCED TO THE EAST LINE OF BLOCK 22 OF THE ORIGINAL PLAT OF THE VILLAGE OF LANCASTER WHICH IS RECORDED AS BEARING S 0°00'13" W.

98032