

Village of Hazel Green

RETRACEMENT SURVEY for THOMAS RUNDE

DESCRIPTIONS PROVIDED:

"Lot 5, in Block 5, in Sunshine Acres No. 3 Subdivision, in the Village of Hazel Green, according to the recorded plat thereof.

"Lot five (5) in Block two (2) of the original plat of Sunshine Acres Addition to the Village of Hazel Green, Grant County, Wisconsin - according to the original plat of said Addition on record at Lancaster, in said County - located in the northeast quarter of the northwest quarter of section 25, town 1 north, range 1 west of the 4th P.M. - Grant County, Wisconsin."

SURVEYOR'S CERTIFICATE:

I, Larry L. Austin, registered land surveyor, do hereby certify that the description hereon was surveyed, mapped, and monumented by me or under my direct supervision. That this survey was prepared under the direction of Thomas Rundt. That to the best of my knowledge and belief, this plat is an accurate representation thereof.

Dated this 14th day of September, 1998.

Larry L. Austin
Larry L. Austin, S-1903




LEGEND

- NO. 6 X 24" REBAR SET WITH PLASTIC CAP
 - 7/8" REBAR FOUND
 - △ 1" IRON PIPE FOUND
 - 2" IRON PIPE FOUND
 - ⊗ 7/8" REBAR FOUND
- (EAST) RECORDED AS
[528-253] VOLUME AND PAGE, GRANT COUNTY
REGISTRY, LANCASTER, WISCONSIN

BEARINGS REFERENCED TO THE NORTH LINE OF BLOCK 5 OF SUNSHINE ACRES NUMBER 3 SUBDIVISION, WHICH IS ASSUMED TO BEAR WEST.



SCALE 1" = 100'

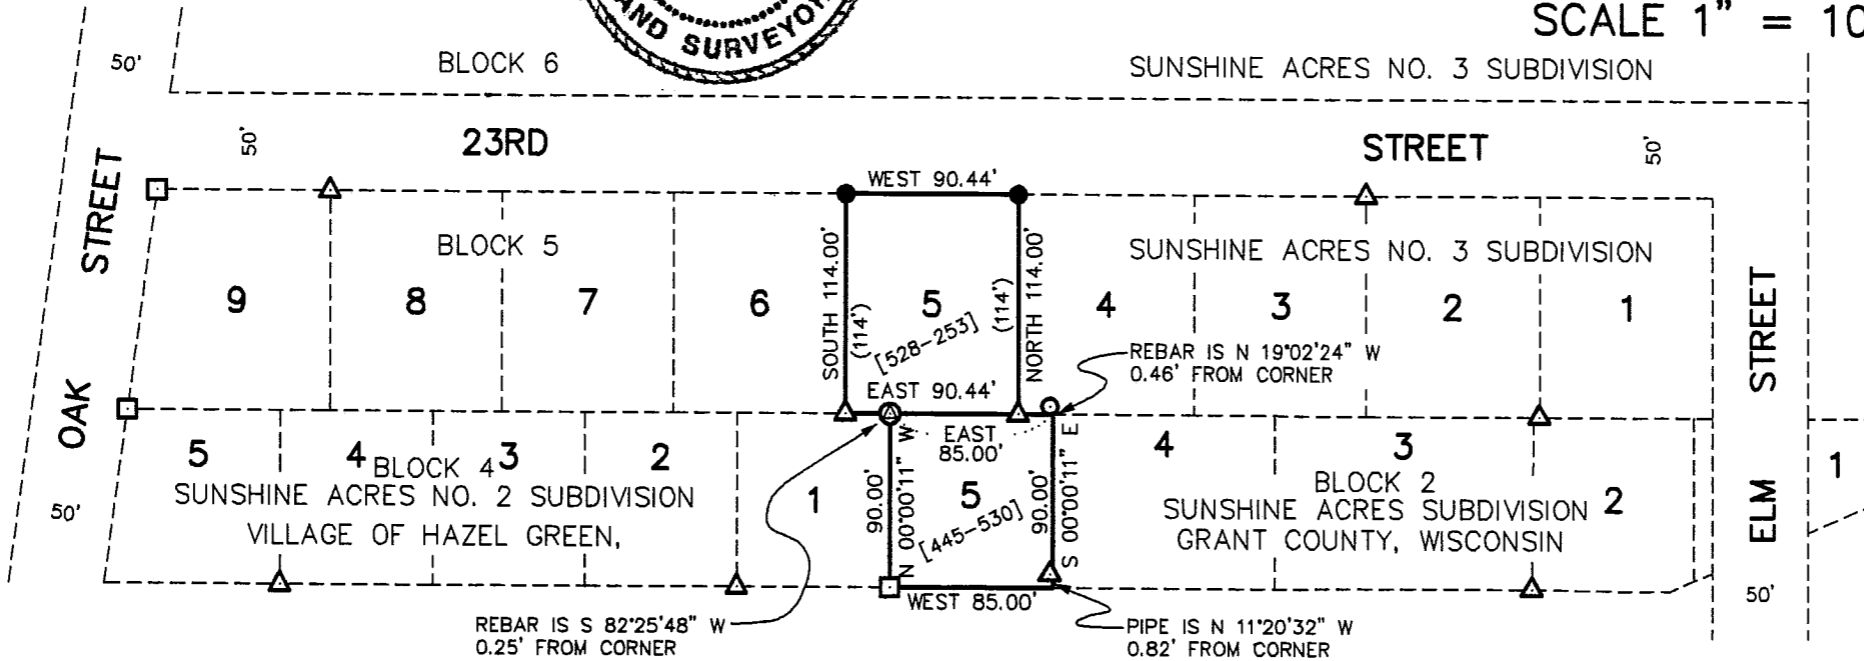

AUSTIN ENGINEERING, LLC 4211 HWY 81 E, LANCASTER, WI 53813 PHONE 608-723-6363 FAX 608-723-6702	FIELDBOOK: 9419 C: \SURVEY3\HZLGREEN\SUNSHINE C: \EPSA\PROGRAM\HZLGREEN\L5SSA3TR	DRAWN BY: AJ AUSTIN APPROVED: LL AUSTIN CREW: BS - SB
---	--	---