


334  
Sec. 34, T5N, R3W

# PLAT OF SURVEY for BEV JOHANSEN: SITCO INC. PROPERTY

SHEET 1 OF 1

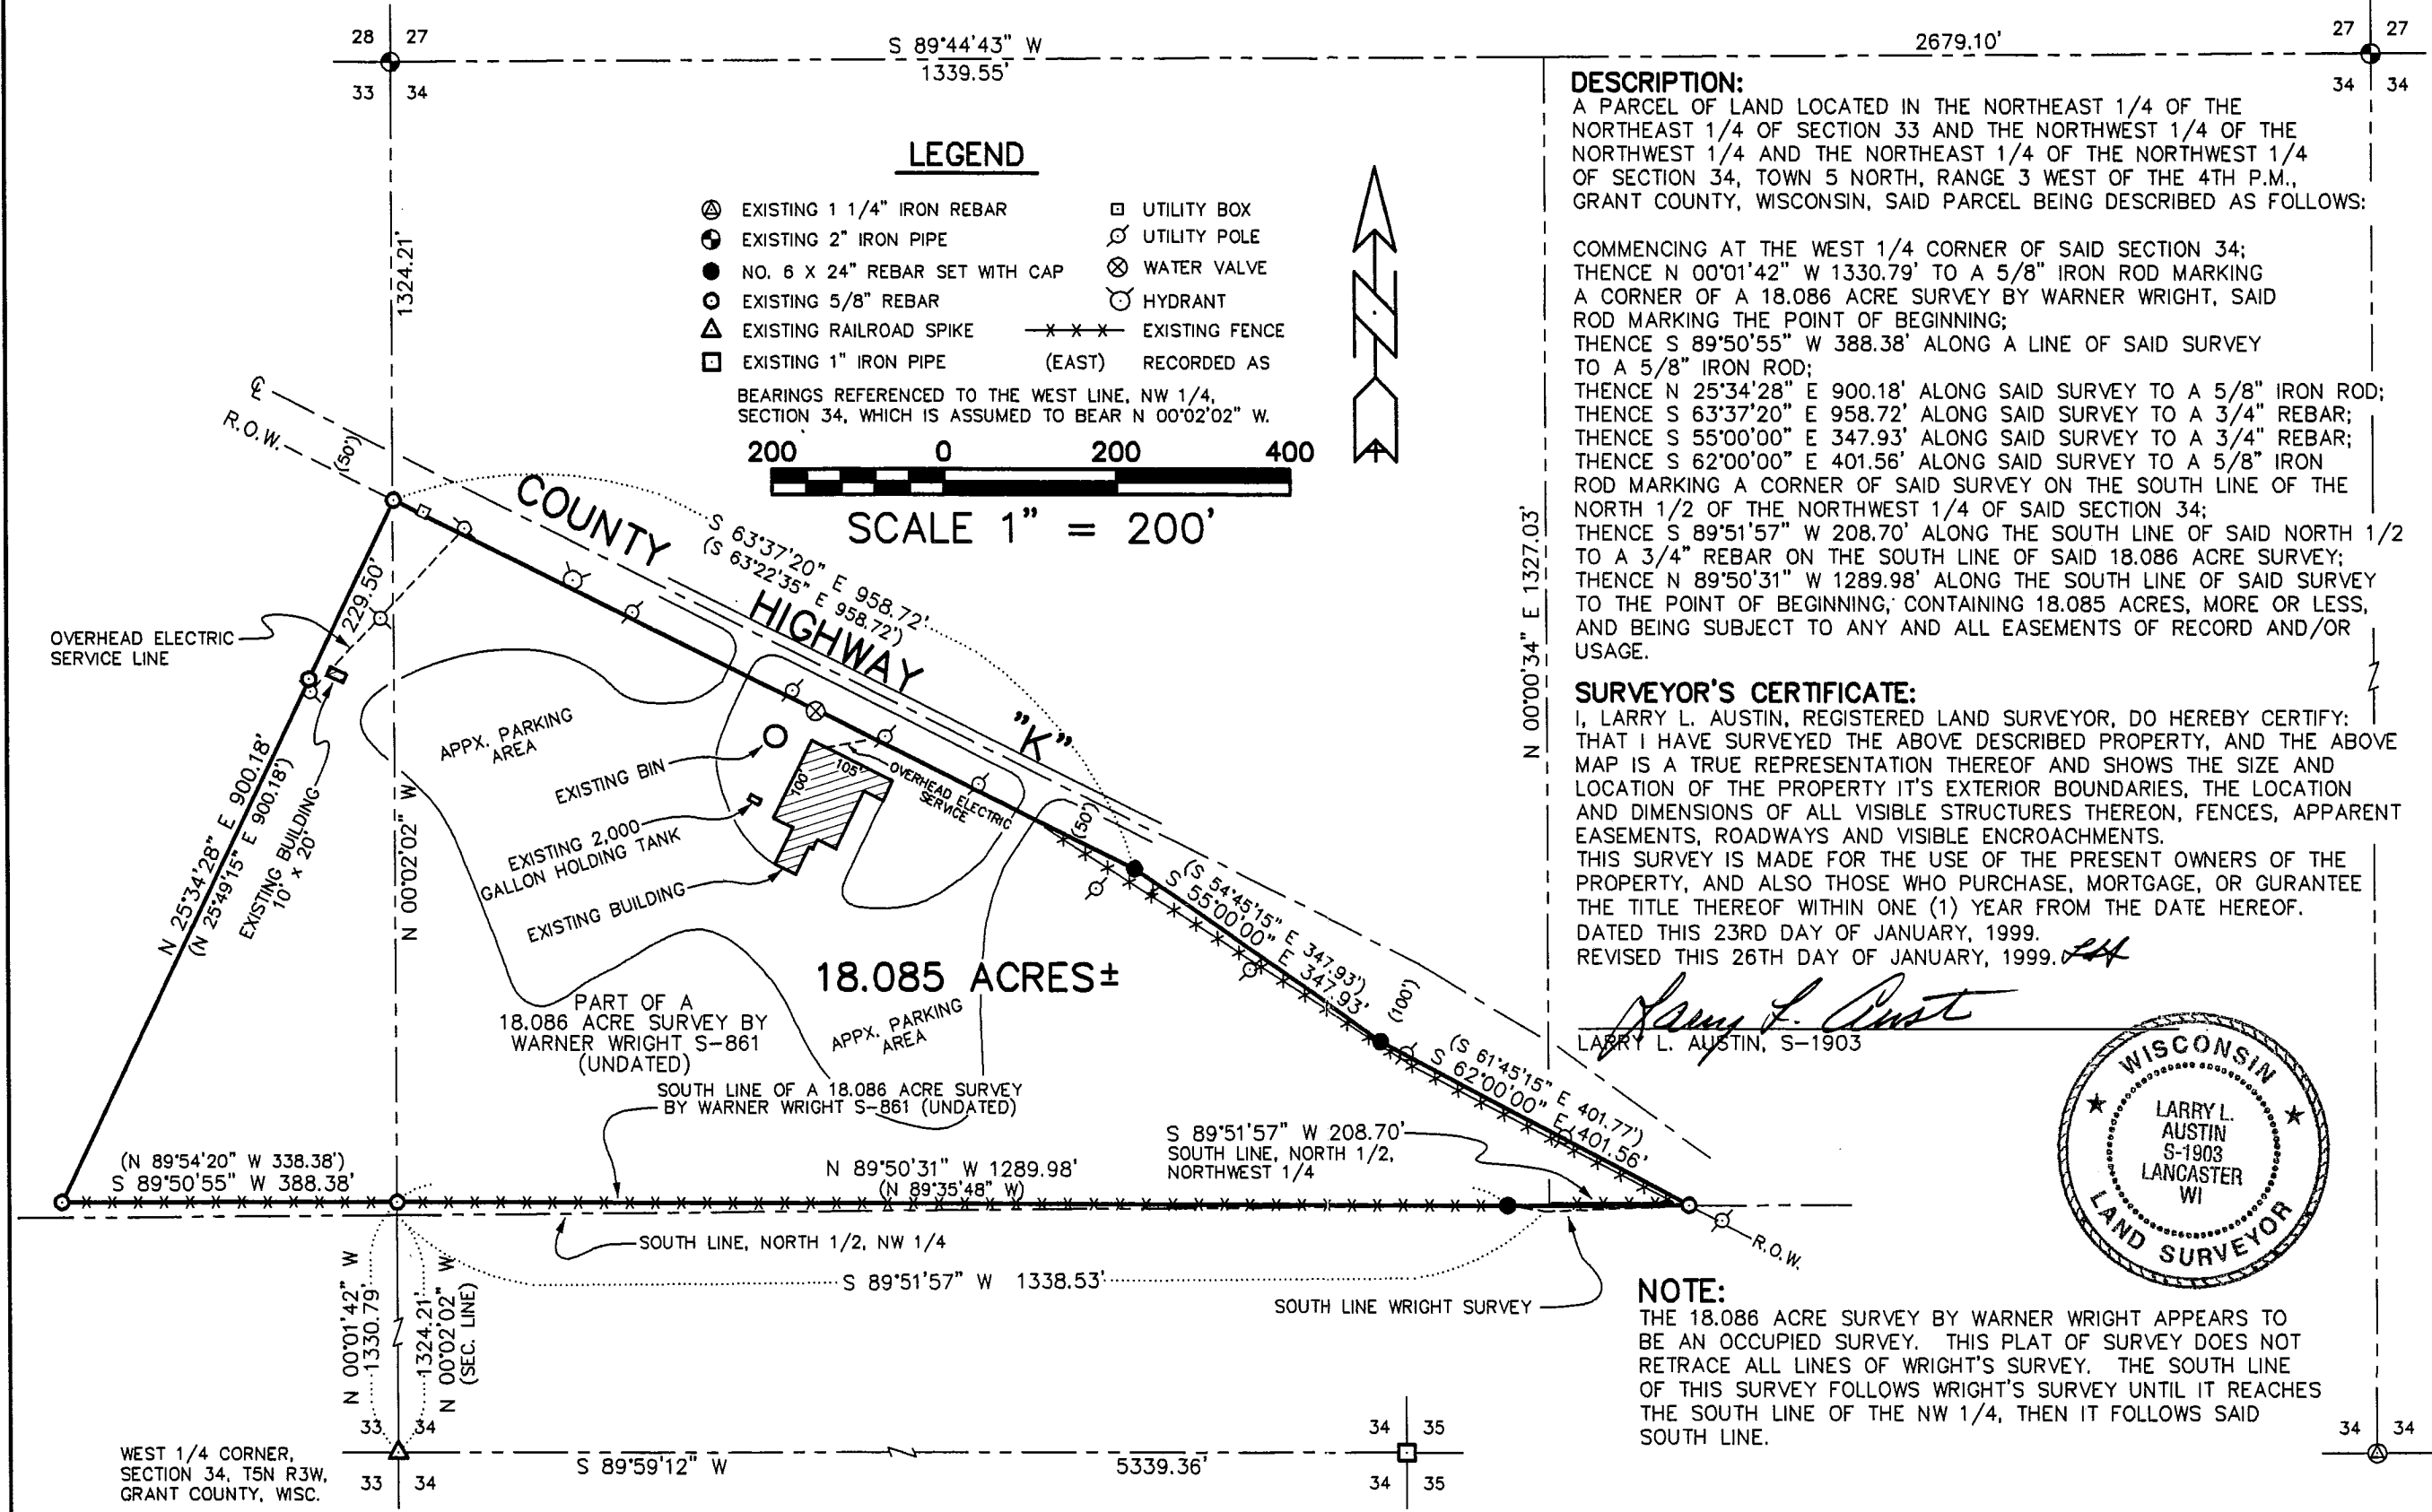

DRAWN BY: AJ AUSTIN  
APPROVED: LL AUSTIN  
CREW: BS - SB

FIELDBOOK: 9705  
C:\SURVEY3\15NR3W\34A  
C:\EPSA\PROGRAM\15NR3W\34BJ

AUSTIN ENGINEERING, LLC  
4211 HWY 81 E, LANCASTER, WI 53813  
PHONE 608-723-6363 FAX 608-723-6702

