


# PLAT OF SURVEY for MARK SPENSLEY

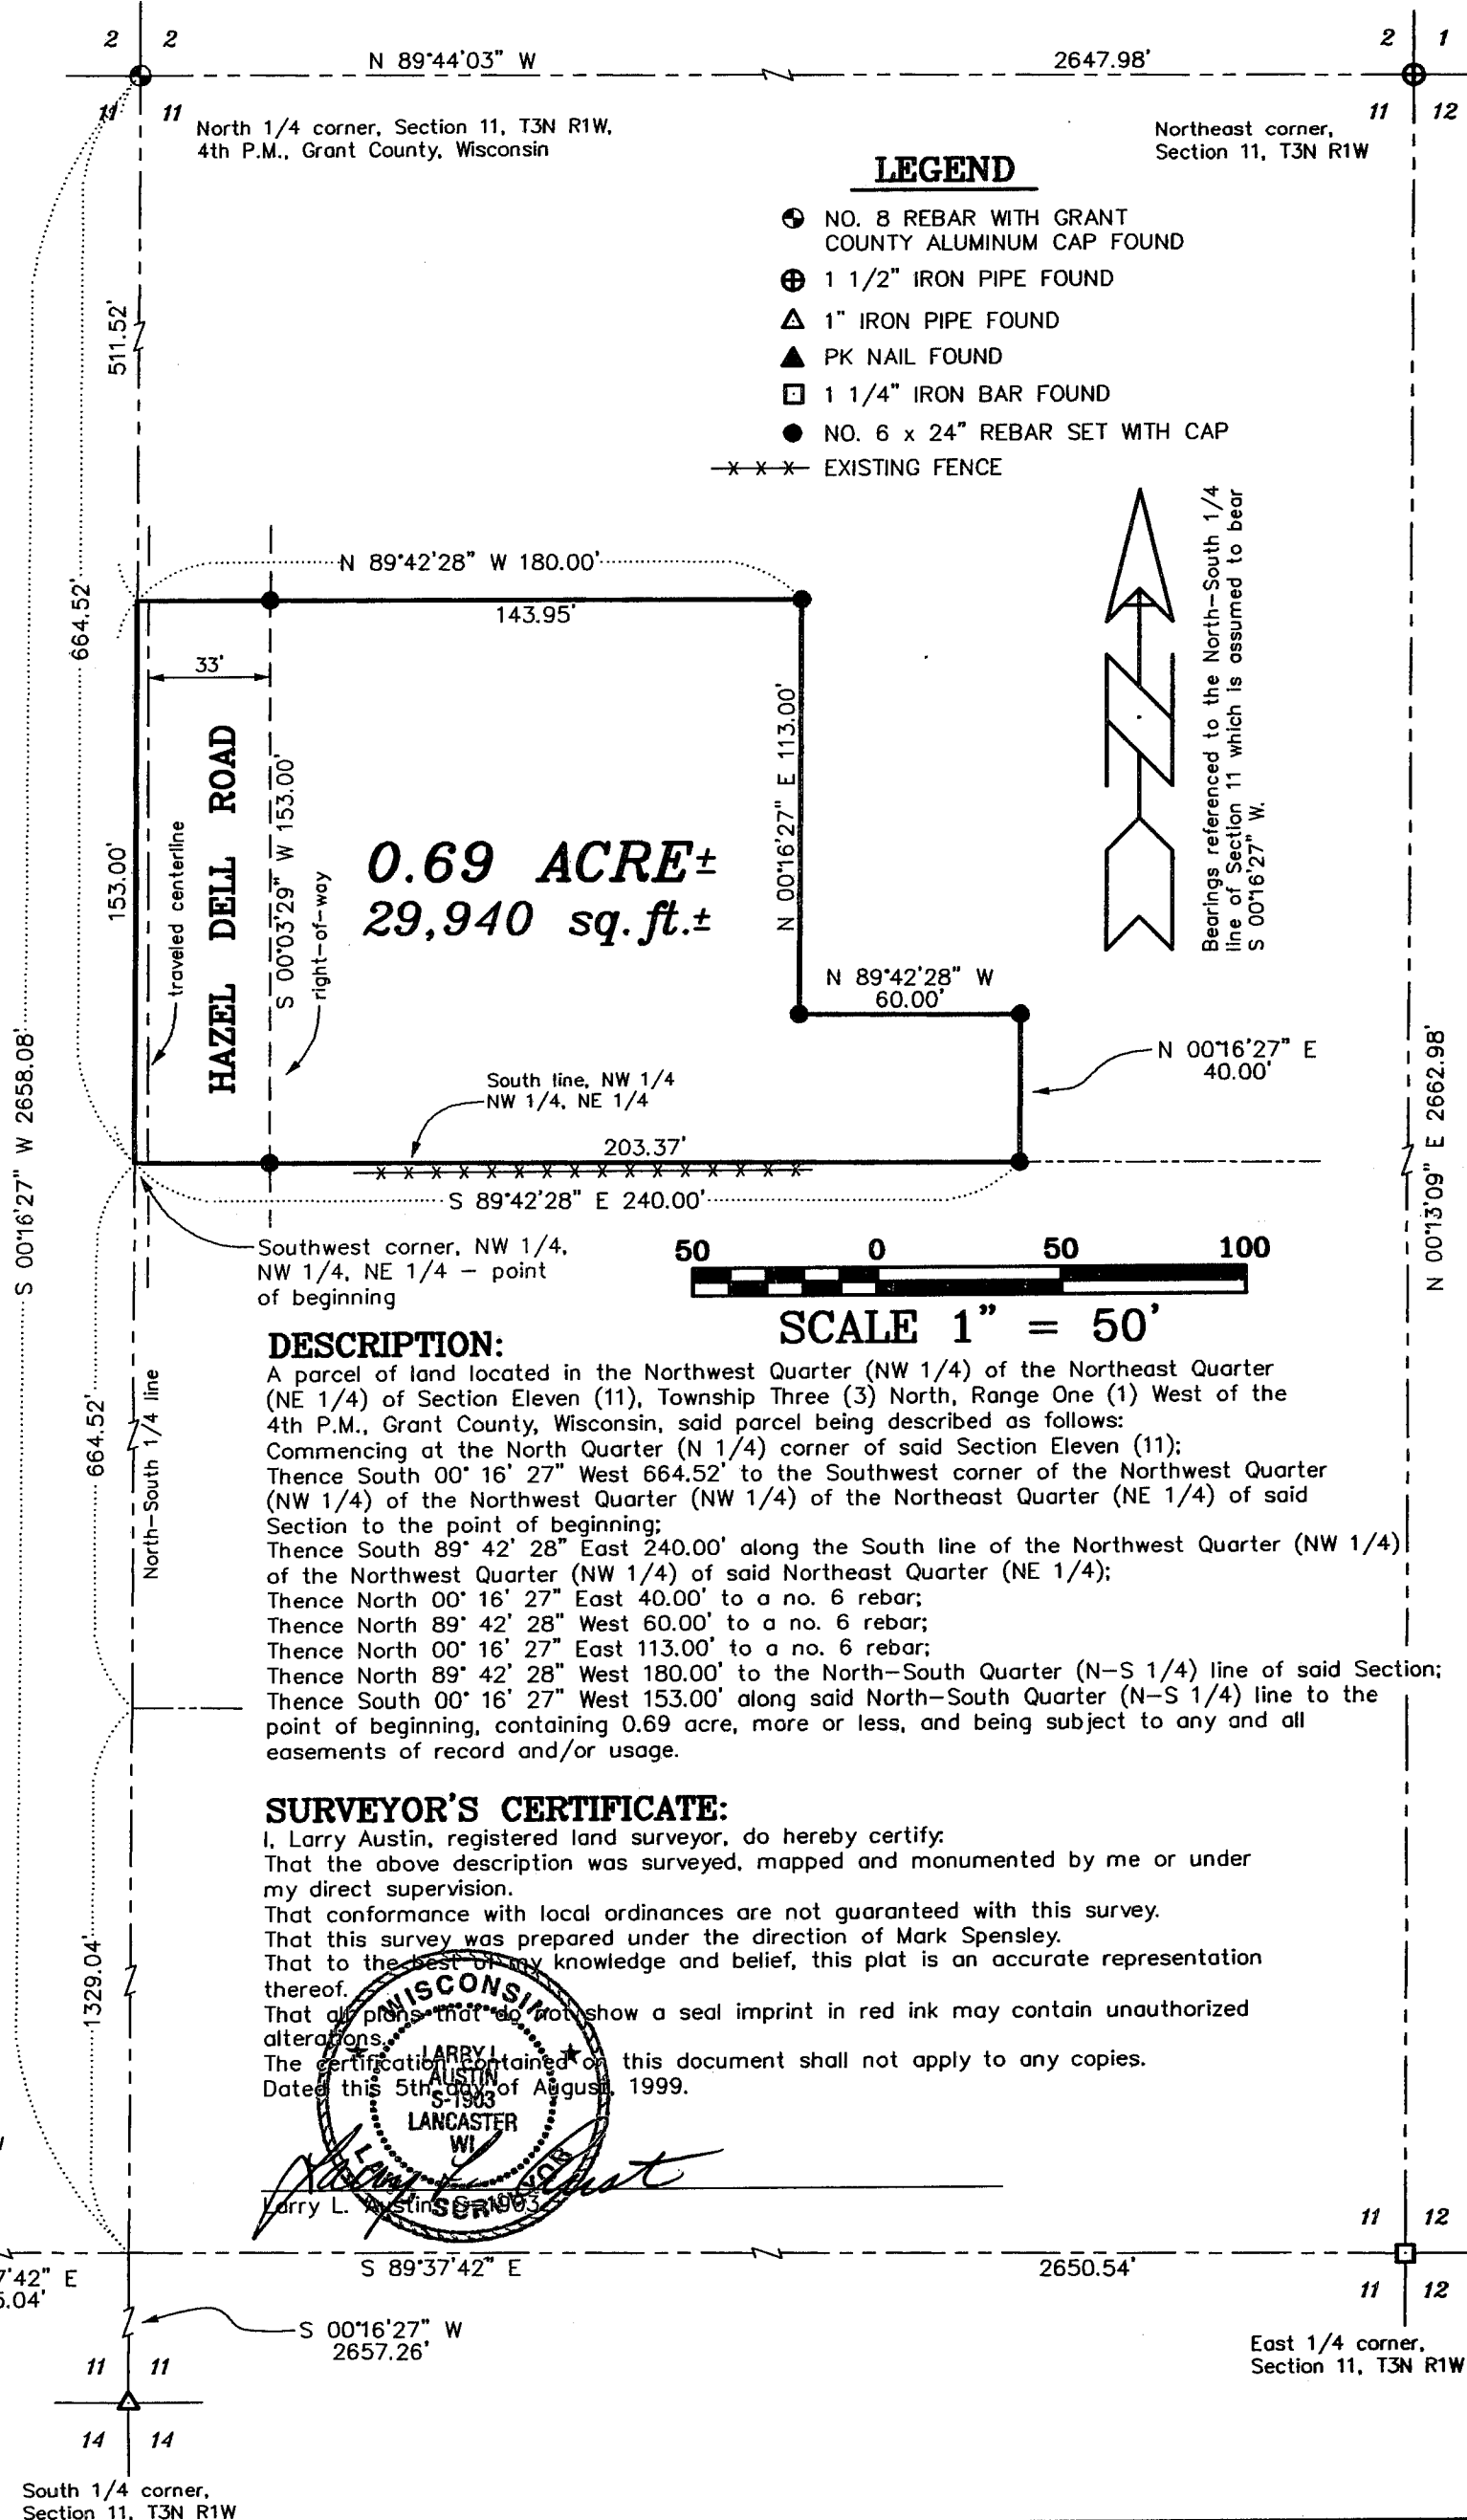

**AUSTIN ENGINEERING, LLC**  
 4211 HWY 81 E, LANCASTER, WI 53813  
 PHONE 608-723-6363 FAX 608-723-6702

FIELDBOOK: 9910, 9419  
 G:\PVILLE\FAHERTY  
 C:\EPSA\PROGRAM\T3NR1W\11MS

DRAWN BY: AJ AUSTIN  
 APPROVED: LL AUSTIN  
 CREW: BS - SB