


114 W. BLACKHAWK AVE. - P.O. BOX 542 - PRAIRIE DU CHIEN, WI 53821 - 608-326-1061



PLAT OF SURVEY

BLOCK 17, ORIGINAL PLAT OF MOUNT HOPE, GRANT COUNTY, WISCONSIN.

BEARINGS REFERENCED TO EAST RIGHT OF WAY LINE OF AARLOCHER STREET ASSUMED TO BEAR N00°00'53"W

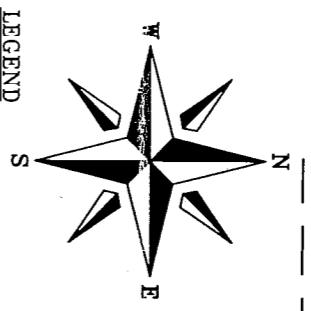

- LEGEND**
- EXISTING 1" IRON PIPE
 - 3/4" x 24" IRON ROD SET
 - ⊙ EXISTING 3/4" Ø IRON ROD 1.5 LBS./LIN. FT.
 - () RECORDED AS

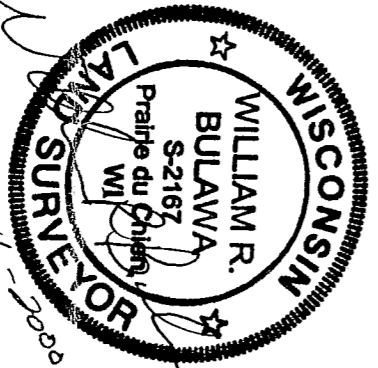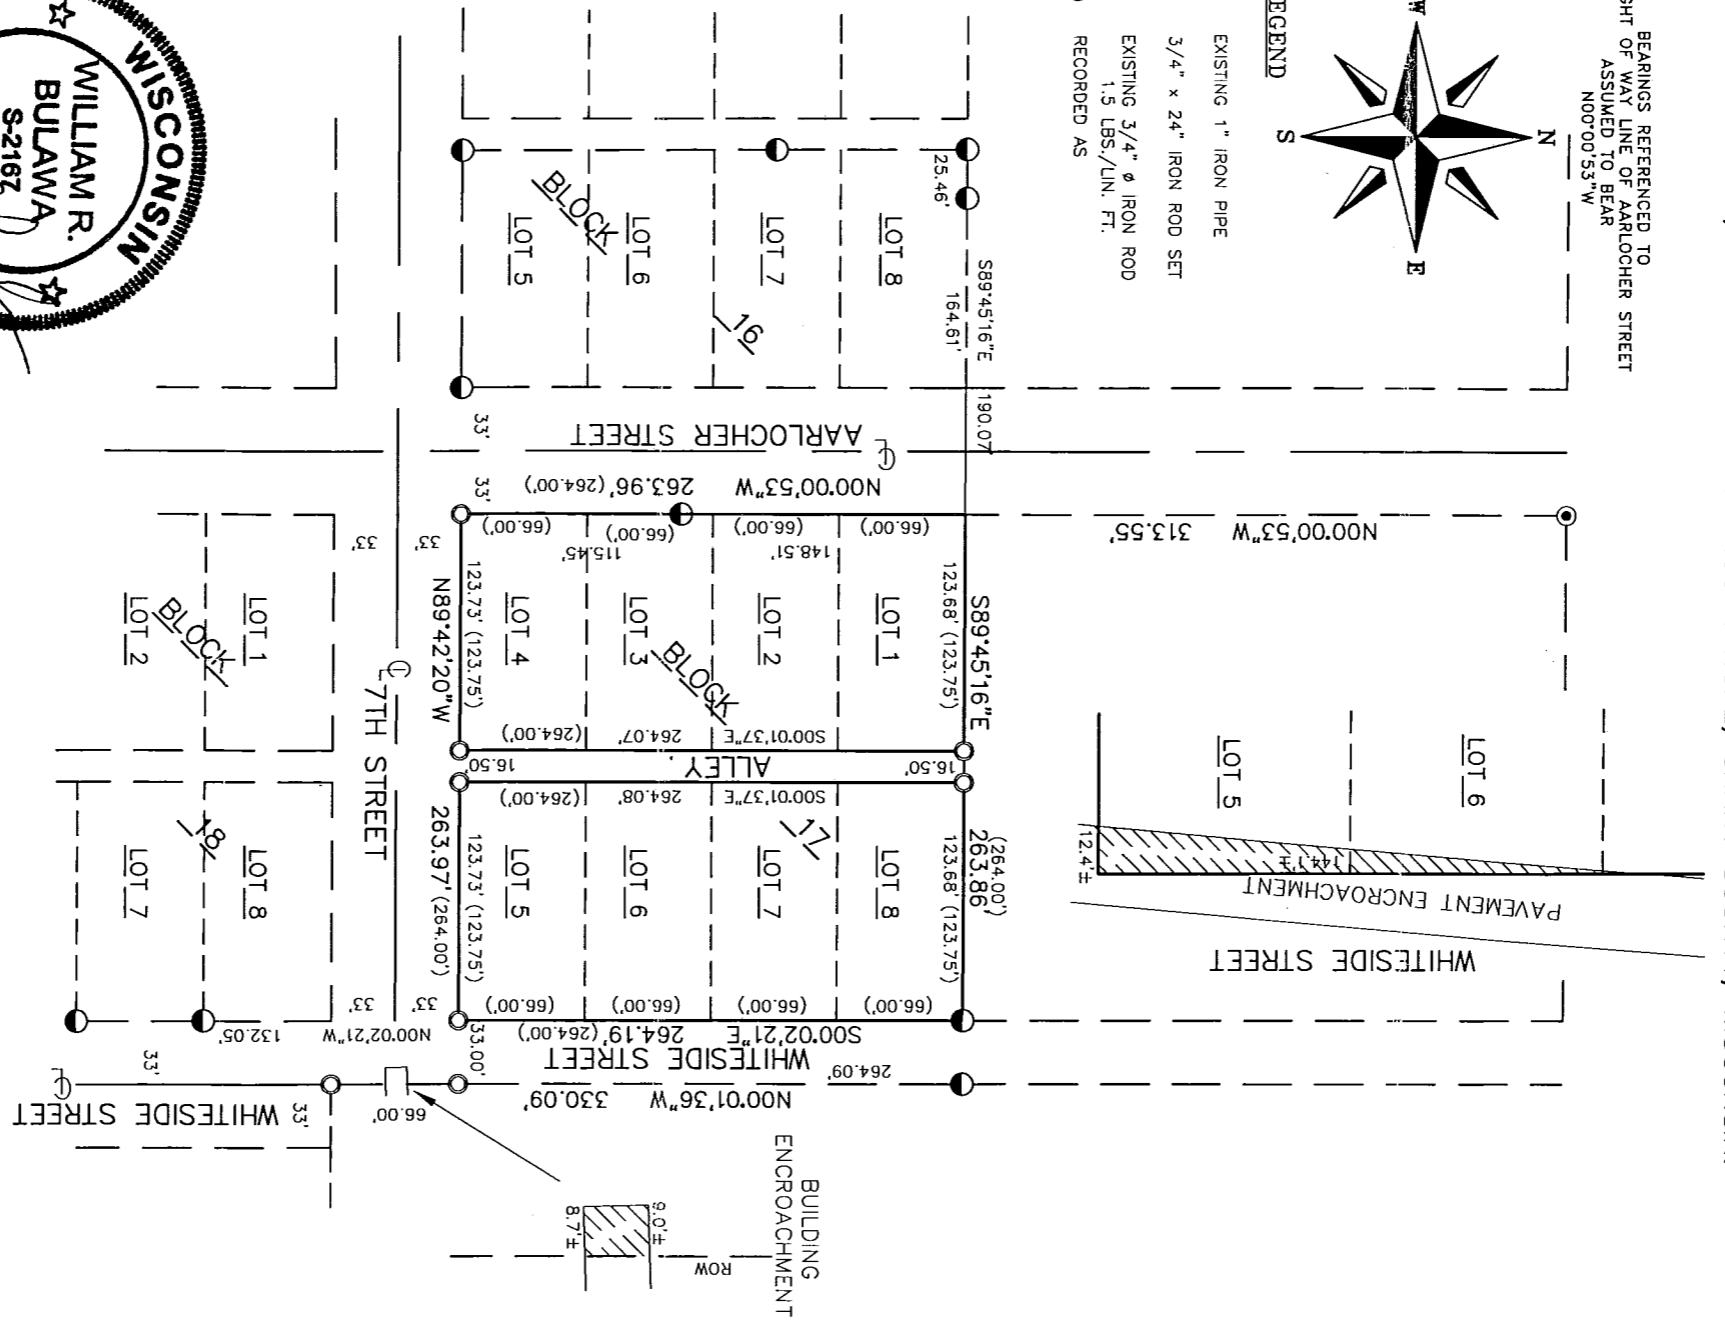

W.R. Bulawa
10-16-2000



OWNERS :
VILLAGE OF MT. HOPE
MT. HOPE, WI 53816

SURVEYOR'S CERTIFICATE: I, WILLIAM R. BULAWA, WISCONSIN REGISTERED LAND SURVEYOR HEREBY CERTIFY THAT I HAVE SURVEYED THE LANDS SHOWN ON THIS PLAT UNDER THE DIRECTION OF THE CLIENT AND THAT SAID SURVEY AND PLAT ARE CORRECT TO THE BEST OF MY KNOWLEDGE AND BELIEF.

DATED THIS 16TH DAY OF OCTOBER, 2000

THIS INSTRUMENT DRAFTED BY WILLIAM R. BULAWA

SHEET 1 OF 1