

# PLAT OF SURVEY

**DESCRIPTION:** LOTS 9 & 10 OF BLOCK 56 OF THE ORIGINAL PLAT OF THE VILLAGE OF MUSCODA AND THE EAST HALF OF THE VACATED ALLEY ADJACENT THERETO LOCATED IN SECTION 1, T8N, R1W, GRANT COUNTY, WISCONSIN.

**SURVEYED FOR:** KEVIN BECKER  
325 E. DIVISION STREET  
MUSCODA, WI. 53573


**SURVEY BY:** TODD T. RUMMLER, R.L.S. - 2443  
JEWELL & ASSOCIATES, INC.  
P.O. BOX 995  
SPRING GREEN, WI. 53588

DWG FILE: 2490POS.dwg

JOB NO. 2490

NORTH


BEARINGS REFERENCED TO THE NORTH LINE OF BLOCK 56 OF THE ORIGINAL PLAT OF THE VILLAGE OF MUSCODA ASSUMED TO BEAR N88°52'01"E

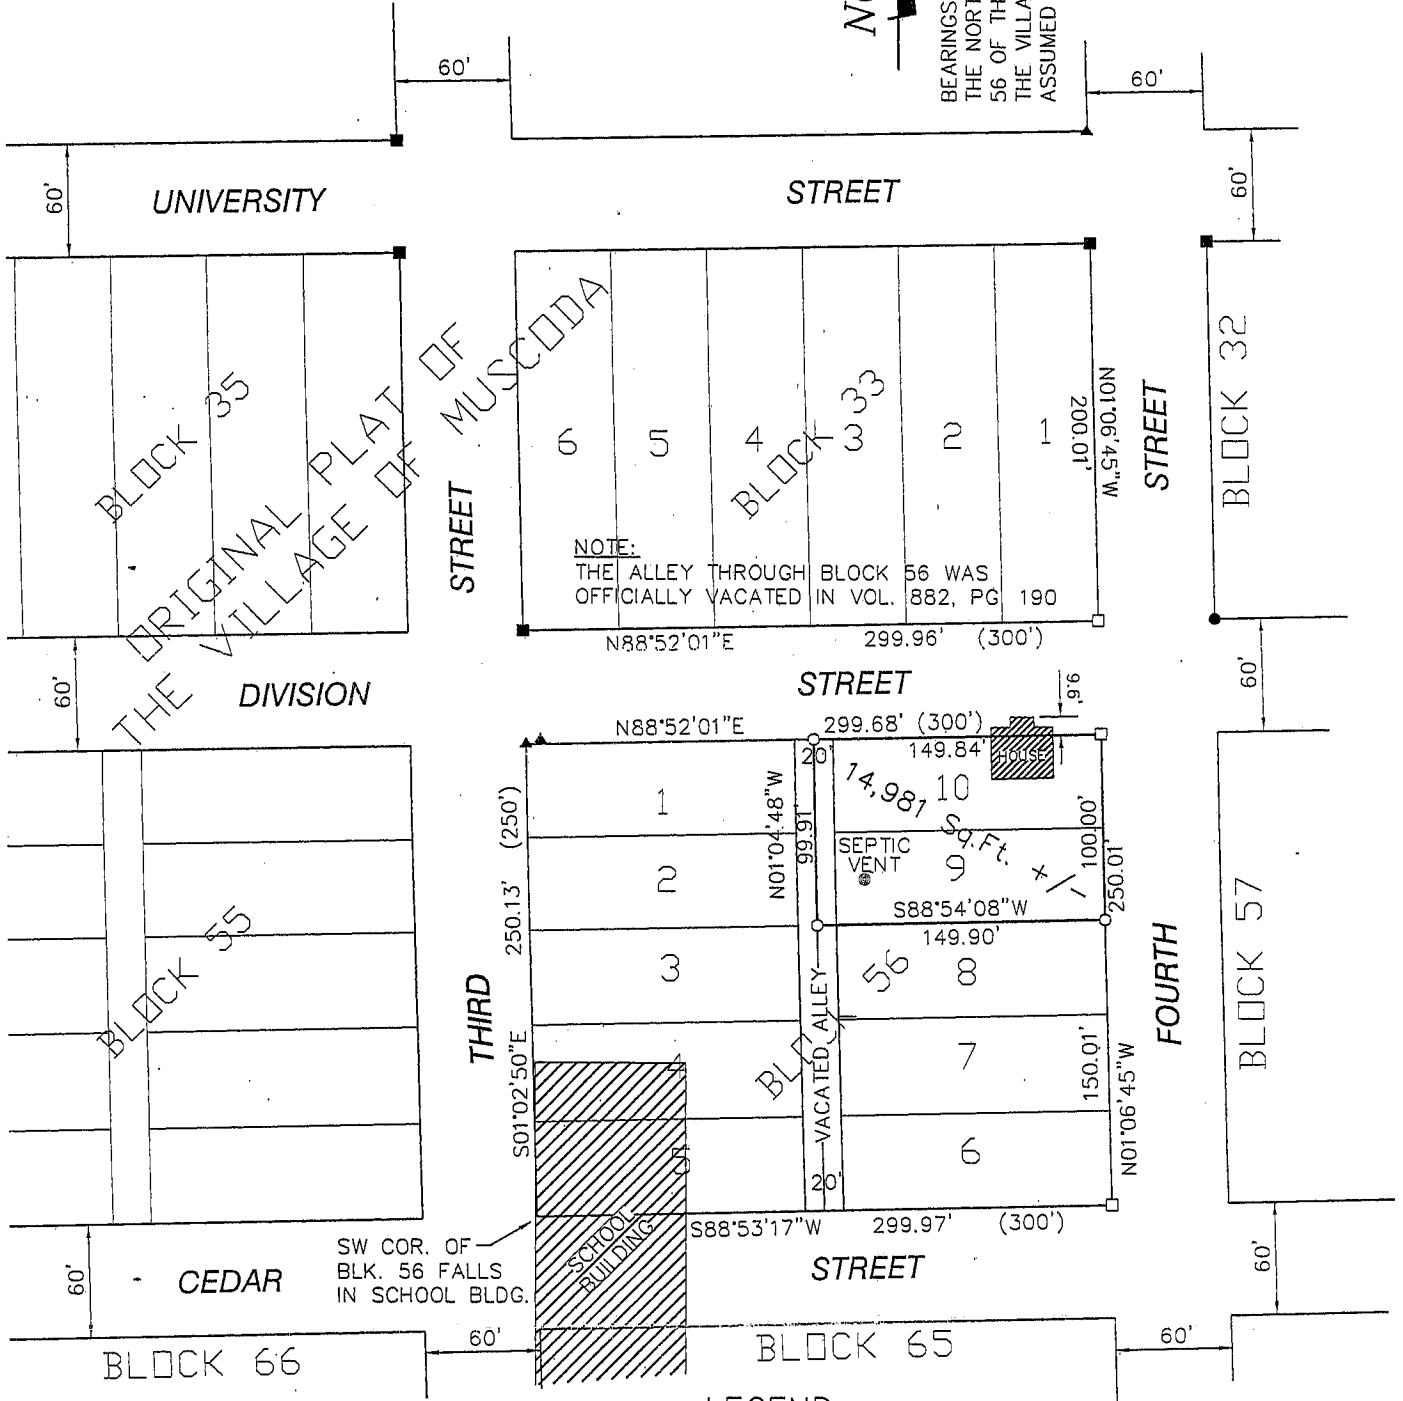

NOTE: THE ALLEY THROUGH BLOCK 56 WAS OFFICIALLY VACATED IN VOL. 882, PG 190

**LEGEND**

- 1 1/4" Ø REBAR FOUND
- ▲ 1 1/2" Ø IRON PIPE FOUND
- 1/2" Ø CONDUIT FOUND
- 3/4" Ø x 24" REBAR SET  
WT. = 1.502lbs./ln. ft.
- 1 1/4" Ø x 30" REBAR SET  
WT. = 4.30lbs./ln. ft.
- ( ) RECORDED AS

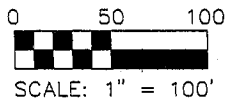

*Todd T. Rummeler*  
Apr 130, 2002  
SHEET 1 OF 1

**JEWELL & Associates, Inc.**

CONSULTING ENGINEERS & SURVEYORS  
SPRING GREEN, WISCONSIN www.jewellassoc.com