

# PLAT OF RESURVEY


Book 13 PAGE 80

**DESCRIPTION PROVIDED:**

"The West 17 feet of Lot Twelve (12) and all of Lot Thirteen (13) of Block Two (2) of Maryville Heights Subdivision, Jamestown Township, being a part of the Southeast Quarter (S.E.1/4) of the Northeast Quarter (N.E.1/4) of Section Twenty-eight (28), Township One (1) North, Range Two (2) West of the 4th P.M., Grant County, Wisconsin according to the recorded map or plat thereof."

**SURVEYOR'S CERTIFICATE:**

I, Larry L. Austin, Registered Wisconsin Land Surveyor, hereby certify:  
 That the above description was surveyed, mapped and monumented as shown on this plat by me or under my direct supervision.  
 That conformance with local ordinances are not guaranteed with this survey.  
 That this survey was prepared under the instructions of Diane Daleo.  
 That to the best of my knowledge and belief, this plat is an accurate representation thereof.  
 That all plans that do not show a seal imprint in red ink may contain unauthorized alterations.  
 The certification contained on this plat shall not apply to any copies.

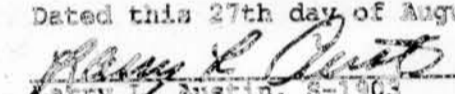Dated this 27th day of August, 2008.  
  
 LARRY L. AUSTIN  
 S-1900  
 LANCASTER  
 WI  
 LAND SURVEYOR


**SURVEYOR'S NOTE:**

Surveyor has made no investigation of record, encumbrances, restrictive covenants, ownership title or easements except as specifically shown on this plat. No distance should be assumed by scaling. No underground improvements have been located unless shown and noted. No representation as to ownership, use or possession should be herein implied. Refer to abstract, title or local ordinances for any additional restriction, easements or building setback lines. No abstract, nor title commitment, nor results of title searches were furnished the surveyor. There may exist documents of record which would affect this parcel.


**LEGEND**

- No. 6 x 24" rebar set with cap - wt=1.50 #/l.f.
- No. 10 x 30" rebar set - wt=4.30#/l.f.
- ⊙ 1/4" diameter drill hole placed in concrete
- ( ) Recorded as
- Approximate location of existing fence
- ▲ 1" Iron pipe found

Approximate fence location. Fences shown on this survey were measured at random locations. The fence may meander between fence corners and are shown for reference only. Possession and occupational rights MAY have been acquired to the fence and it is not known if the fence is a fence of convenience or if it is intended to mark the boundary. This survey was prepared with the intent of following the lines shown and described hereon.

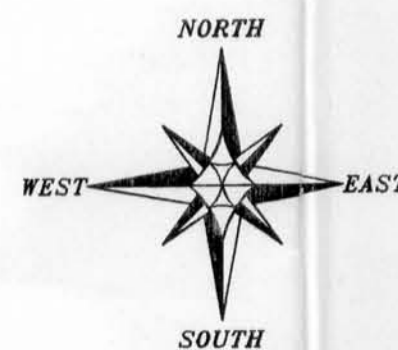

0' 50' 100' 150'  
 SCALE: 1" = 50'

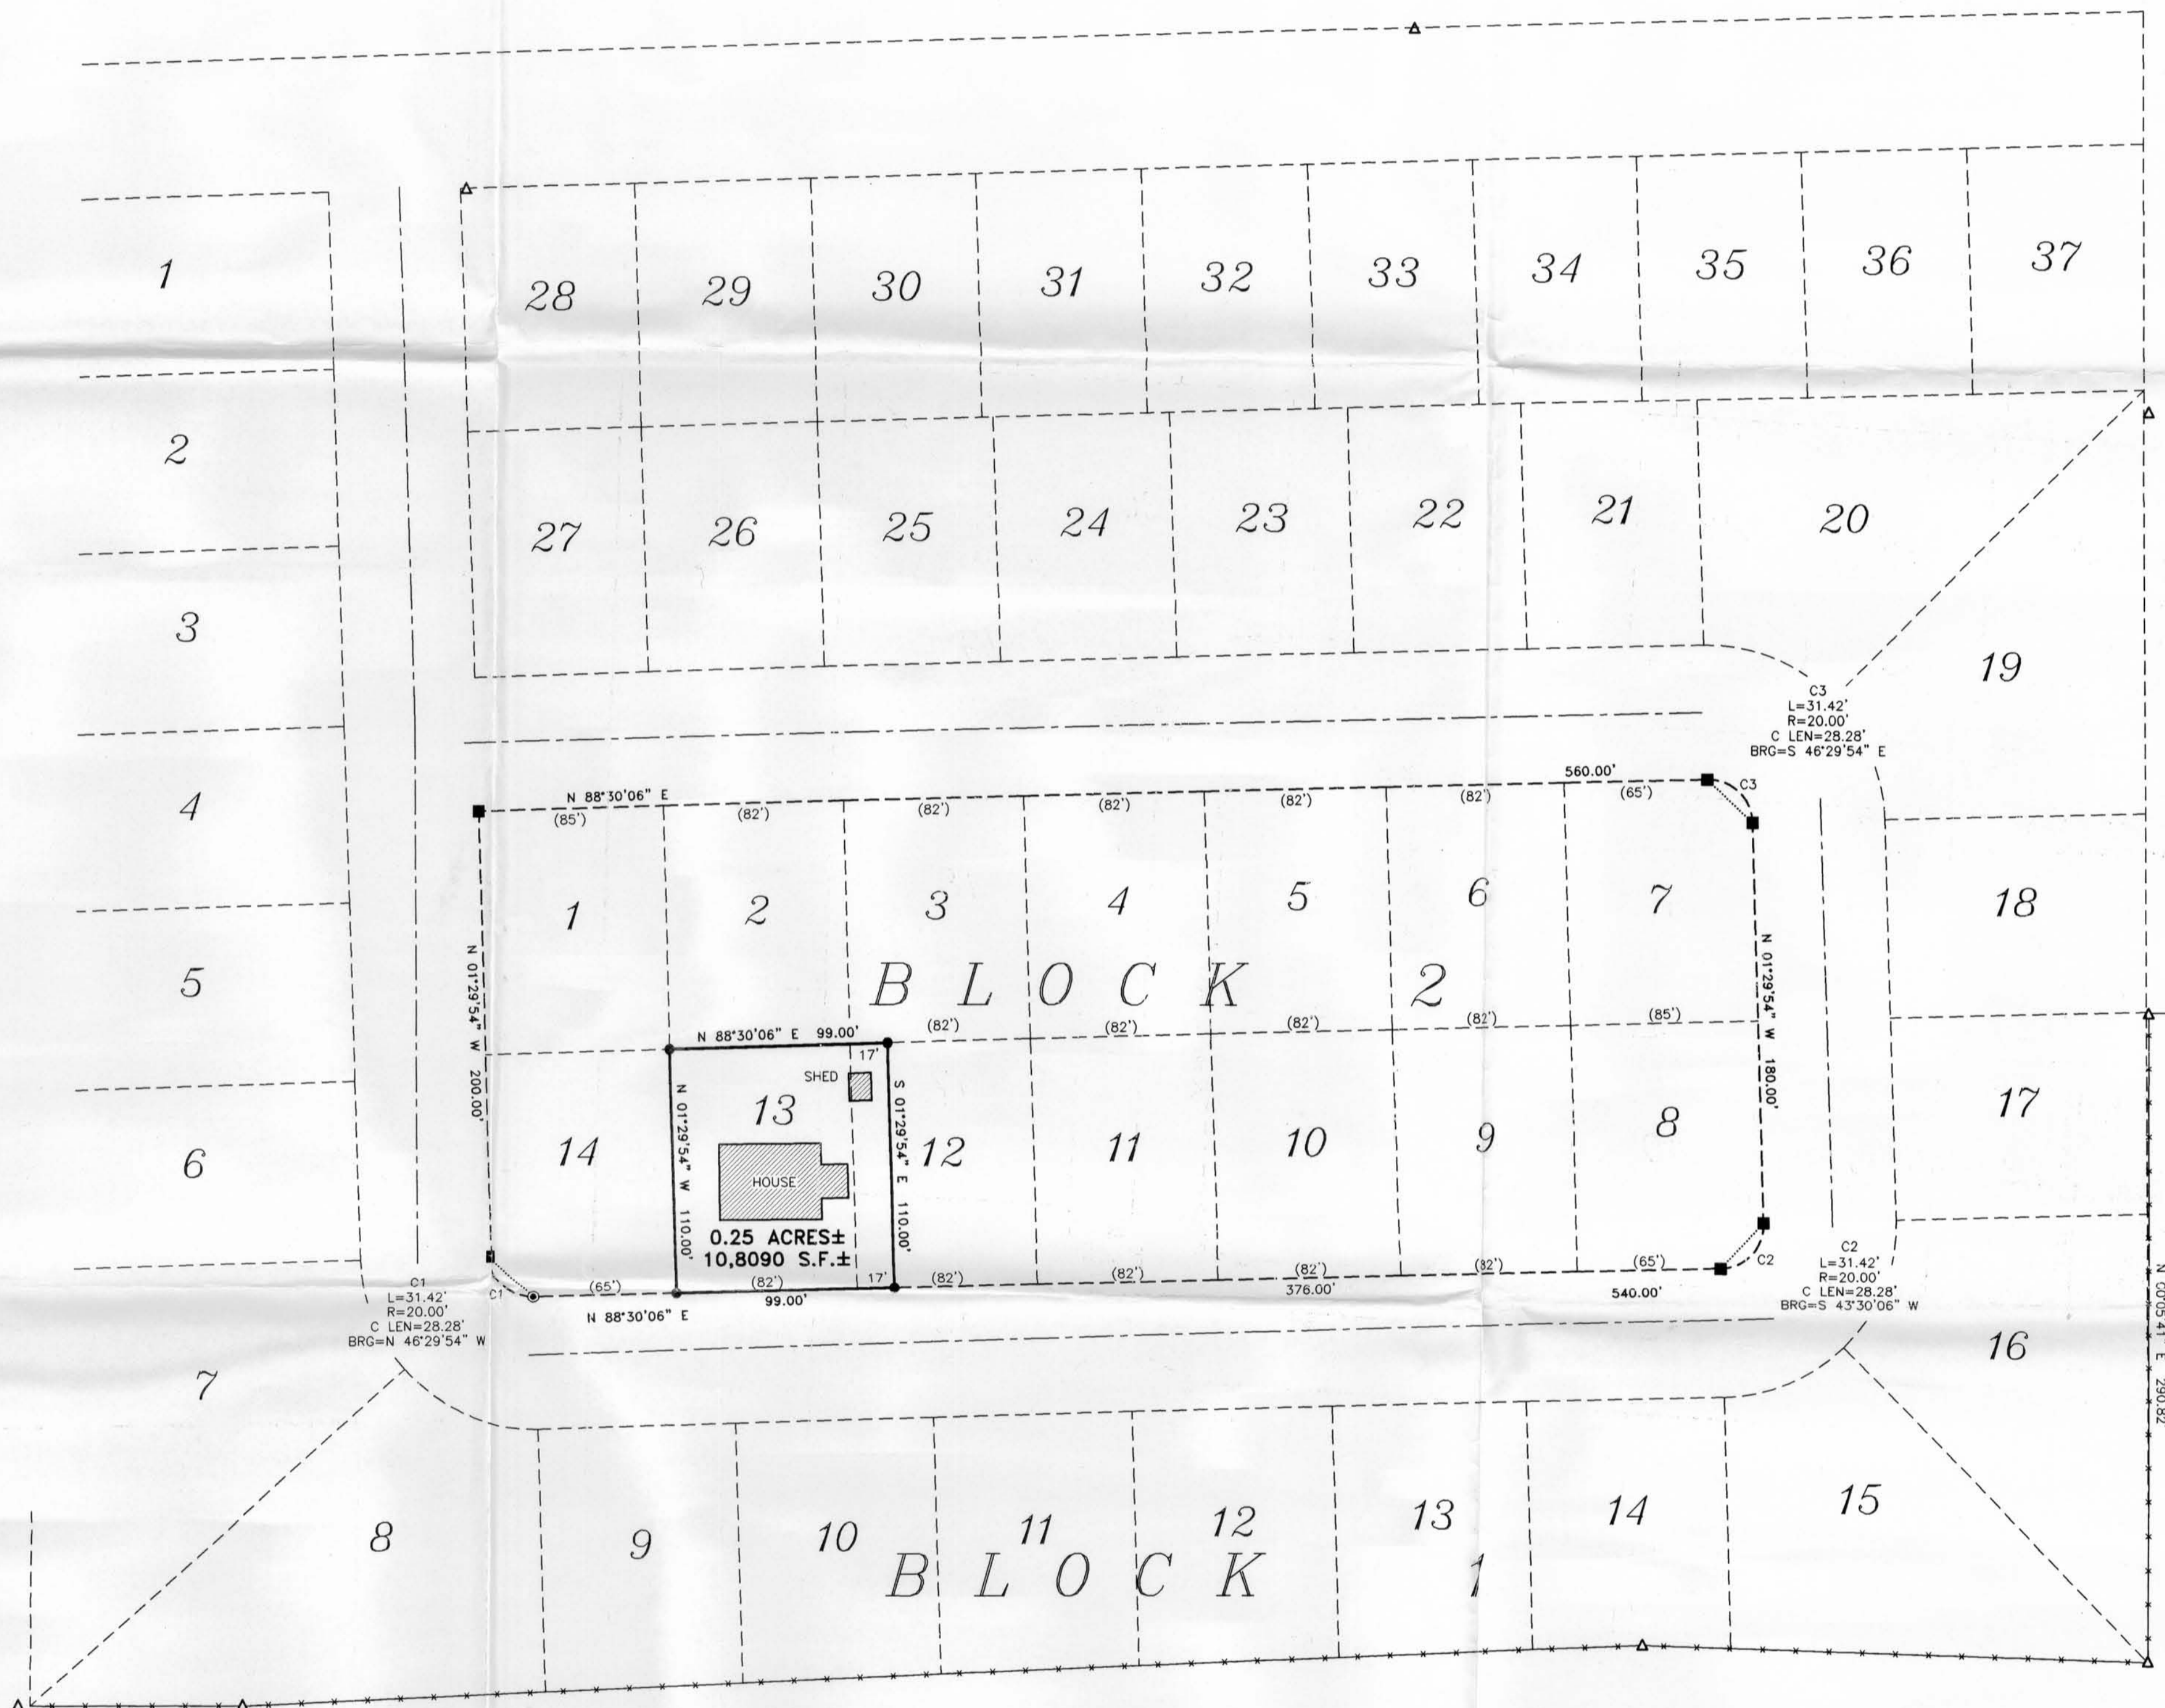

**SURVEYOR'S NOTE**  
 VARIOUS MONUMENTS WERE FOUND THROUGHOUT THE SUBDIVISION. THE MONUMENTS ALONG THE SOUTH LINE OF MARYVILLE HEIGHTS SUBDIVISION WERE USED FOR THE RE-ESTABLISHMENT OF THE LOCATION OF BLOCK 2.

**PLAT OF RESURVEY for DIANE DALEO**  
 BLOCK 2, MARYVILLE HEIGHTS  
 LOCATED IN MARYVILLE HEIGHTS SUBDIVISION  
 SECTION 28, TOWN 1 NORTH, RANGE 2 WEST,  
 JAMESTOWN TOWNSHIP, GRANT COUNTY, WISCONSIN

**AUSTIN ENGINEERING, LLC**  
 4311 HWY. 81 E. LANCASTER, WI 53813  
 PHONE 608-723-6363 FAX 608-723-6702

JOB NO: 035157 DRAWN BY: SW AUSTIN  
 FIELDBOOK: 2202 A APPROVED: LL AUSTIN  
 C:\T11R2W\MARYVILLE\035157 DALEO  
 H:\PLAT\T11R2W\MARYVILLE\035157 DALEO