
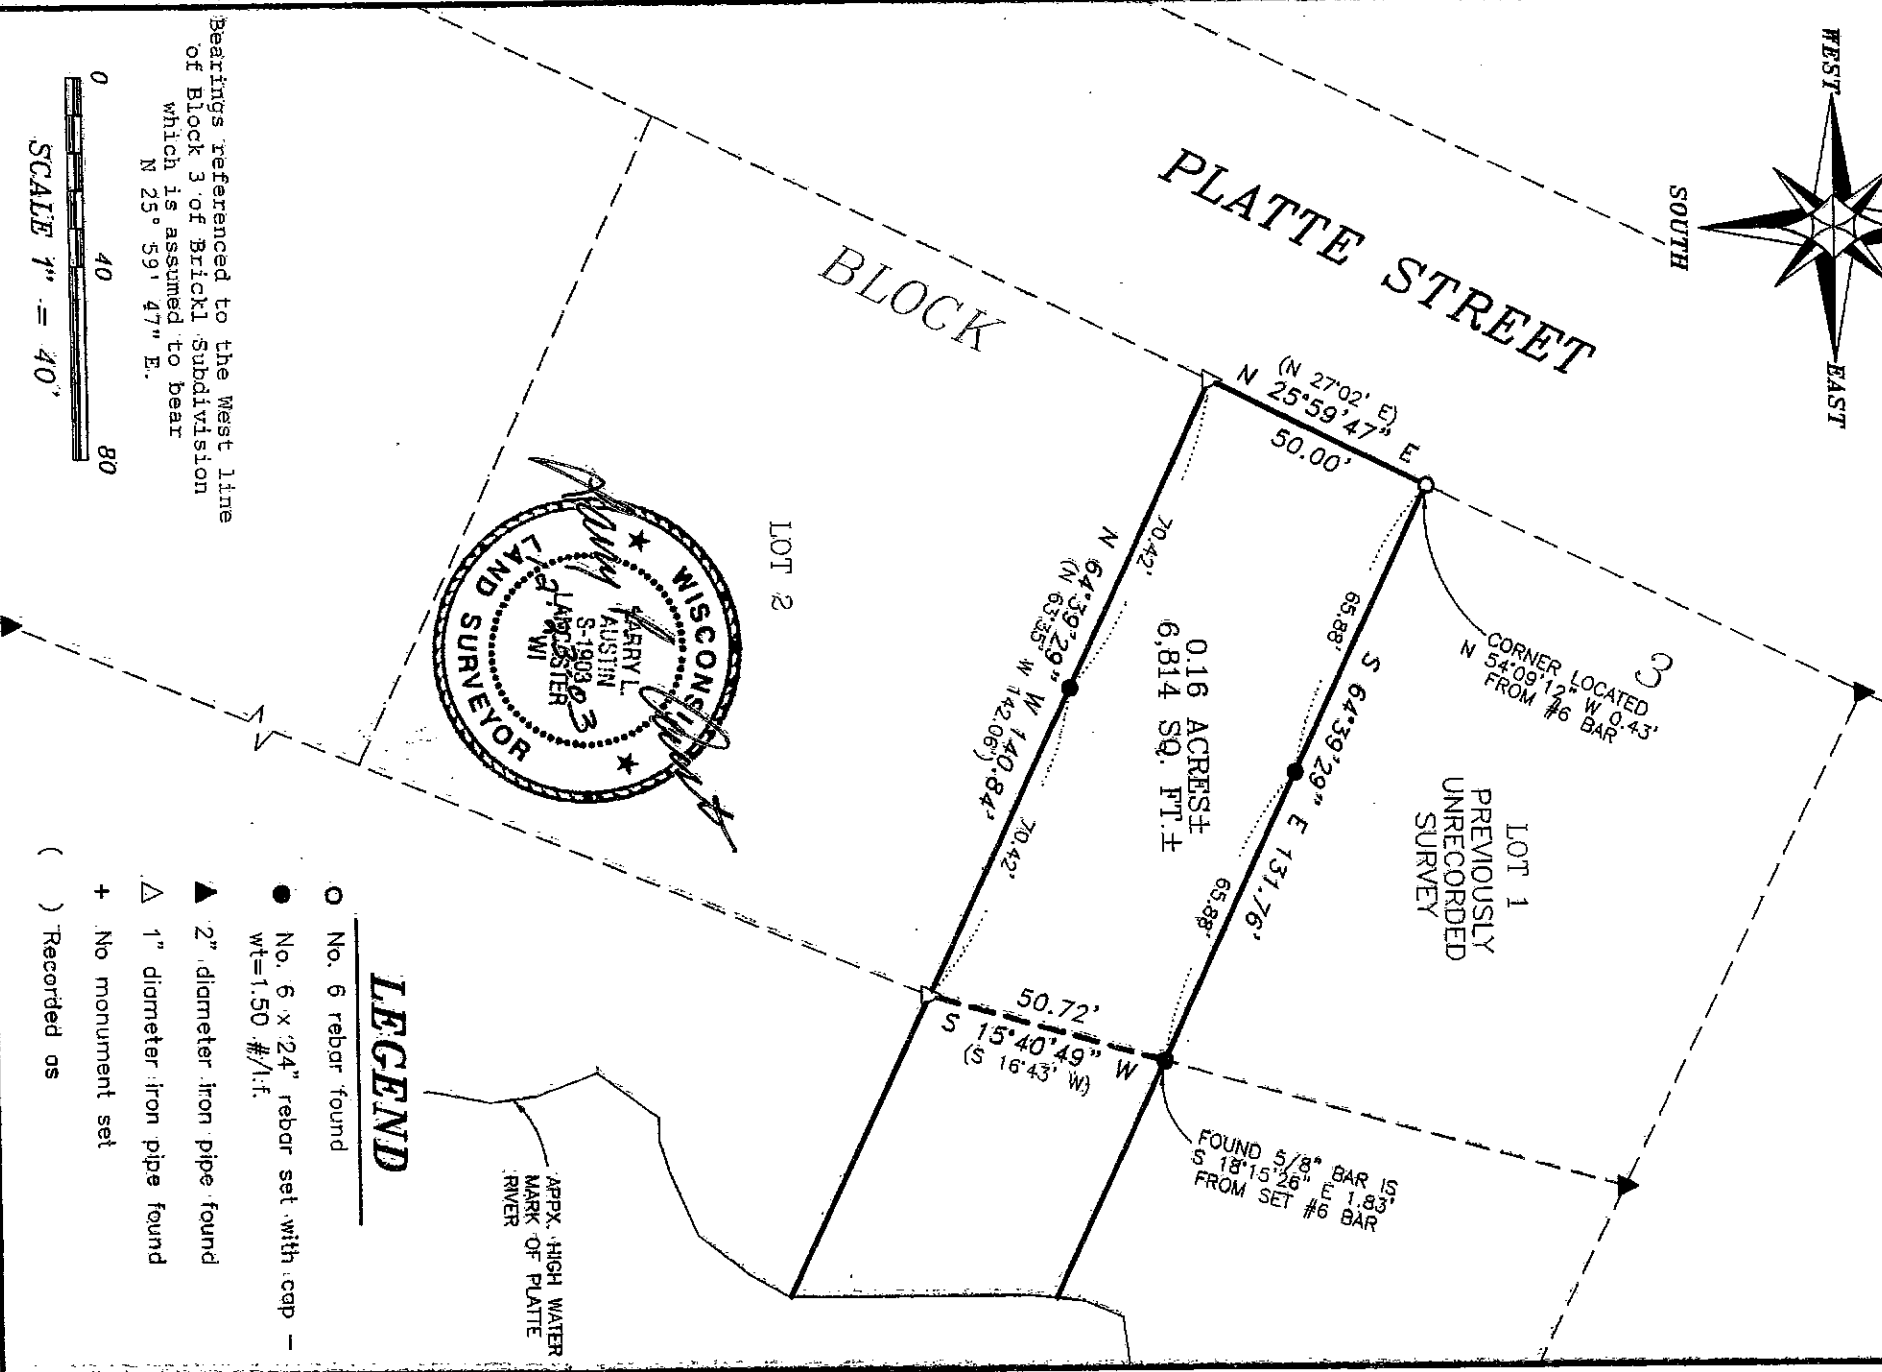


# PLAY OF RESURVEY

PART OF LOT 1 OF BLOCK 3 OF BRICKL SUBDIVISION

ALL PLANS THAT DO NOT SHOW A SEAL  
IMPRINT IN RED INK MAY CONTAIN  
UNAUTHORIZED ALTERATIONS. THE  
CERTIFICATION CONTAINED ON THIS  
DOCUMENT SHALL NOT APPLY TO ANY  
COPIES. DATED: DECEMBER 23RD, 2003

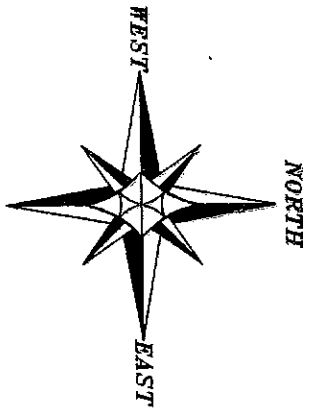

ustlin  
Engineering, Inc.

Prepared For: JEANNE COLLETTE

JOB NO: 03S126  
FIELDBOOK: TDS RANGER  
G:\T2NR2W\19  
H:\PLAT\T2NR2W\19\03S126-COLLETTE

DRAWN BY: C. RUTTER  
APPROVED: LL AUSTIN  
CREW: BS - SB

4211 HWY 81 E, LANCASTER, WI 53813  
PHONE 608-723-6363 FAX 608-723-6702

SHEET 1 OF 2

# PLAT OF RESURVEY

## DESCRIPTION PROVIDED:


The South 50 feet of Lot One (1) in Block Three (3) of Brickl1 Subdivision of a part of Section Nineteen (19) of the Town of Paris, Grant County, Wisconsin, according to the recorded map and plat thereof, more particularly described as follows: Commencing at a point on the Westerly boundary line of said Lot 1, along the street platted on said Subdivision, which point is 50 feet Northerly from the Southwesterly corner of said lot; thence Southerly along said boundary line and street 50 feet to said Southwesterly corner; thence along the boundary line dividing said Lot 1 and Lot 2 in said block to the Southeastly corner of said Lot 1; thence along the Easterly side of said Lot 1, said side being that facing the river, 50 feet more or less to a point thereon which is situated South 63° 35' East from the point of beginning; thence North 63° 35' West to the point of beginning. Also, any and all land lying between the Easterly boundary of the above described property and the Platte River running past or near said tract.

## SURVEYOR'S CERTIFICATE:

I, Larry L. Austin, Registered Wisconsin Land Surveyor, hereby certify:

That the above description was surveyed, mapped and monumented as shown on this plat by me or under my direct supervision.  
That conformance with local ordinances are not guaranteed with this survey.  
That this survey was prepared under the instructions of Jeanne Collette.  
That to the best of my knowledge and belief, this plat is an accurate representation thereof.  
That all plans that do not show a seal imprint in red ink may contain unauthorized alterations.  
The certification contained on this document shall not apply to any copies.

Dated this 23rd day of December, 2003.

  
Larry L. Austin, S-1903

## SURVEYOR'S NOTES:

Surveyor has made no investigation for easements of record, encumbrances, restrictive covenants, ownership title evidence except as specifically shown on this plat. No distance should be assumed by scaling. No underground improvements have been located unless shown and noted. No representation as to ownership, use or possession should be hereon implied. Refer to abstract, title or local ordinances for any additional restriction, easements or building setback lines. No abstract, nor title commitment, nor results of title searches were furnished the surveyor. There may exist documents of record which would affect this parcel.

